


SECTION

4

TOWNSHIP 3 S, RANGE 38 E, W. M.

North

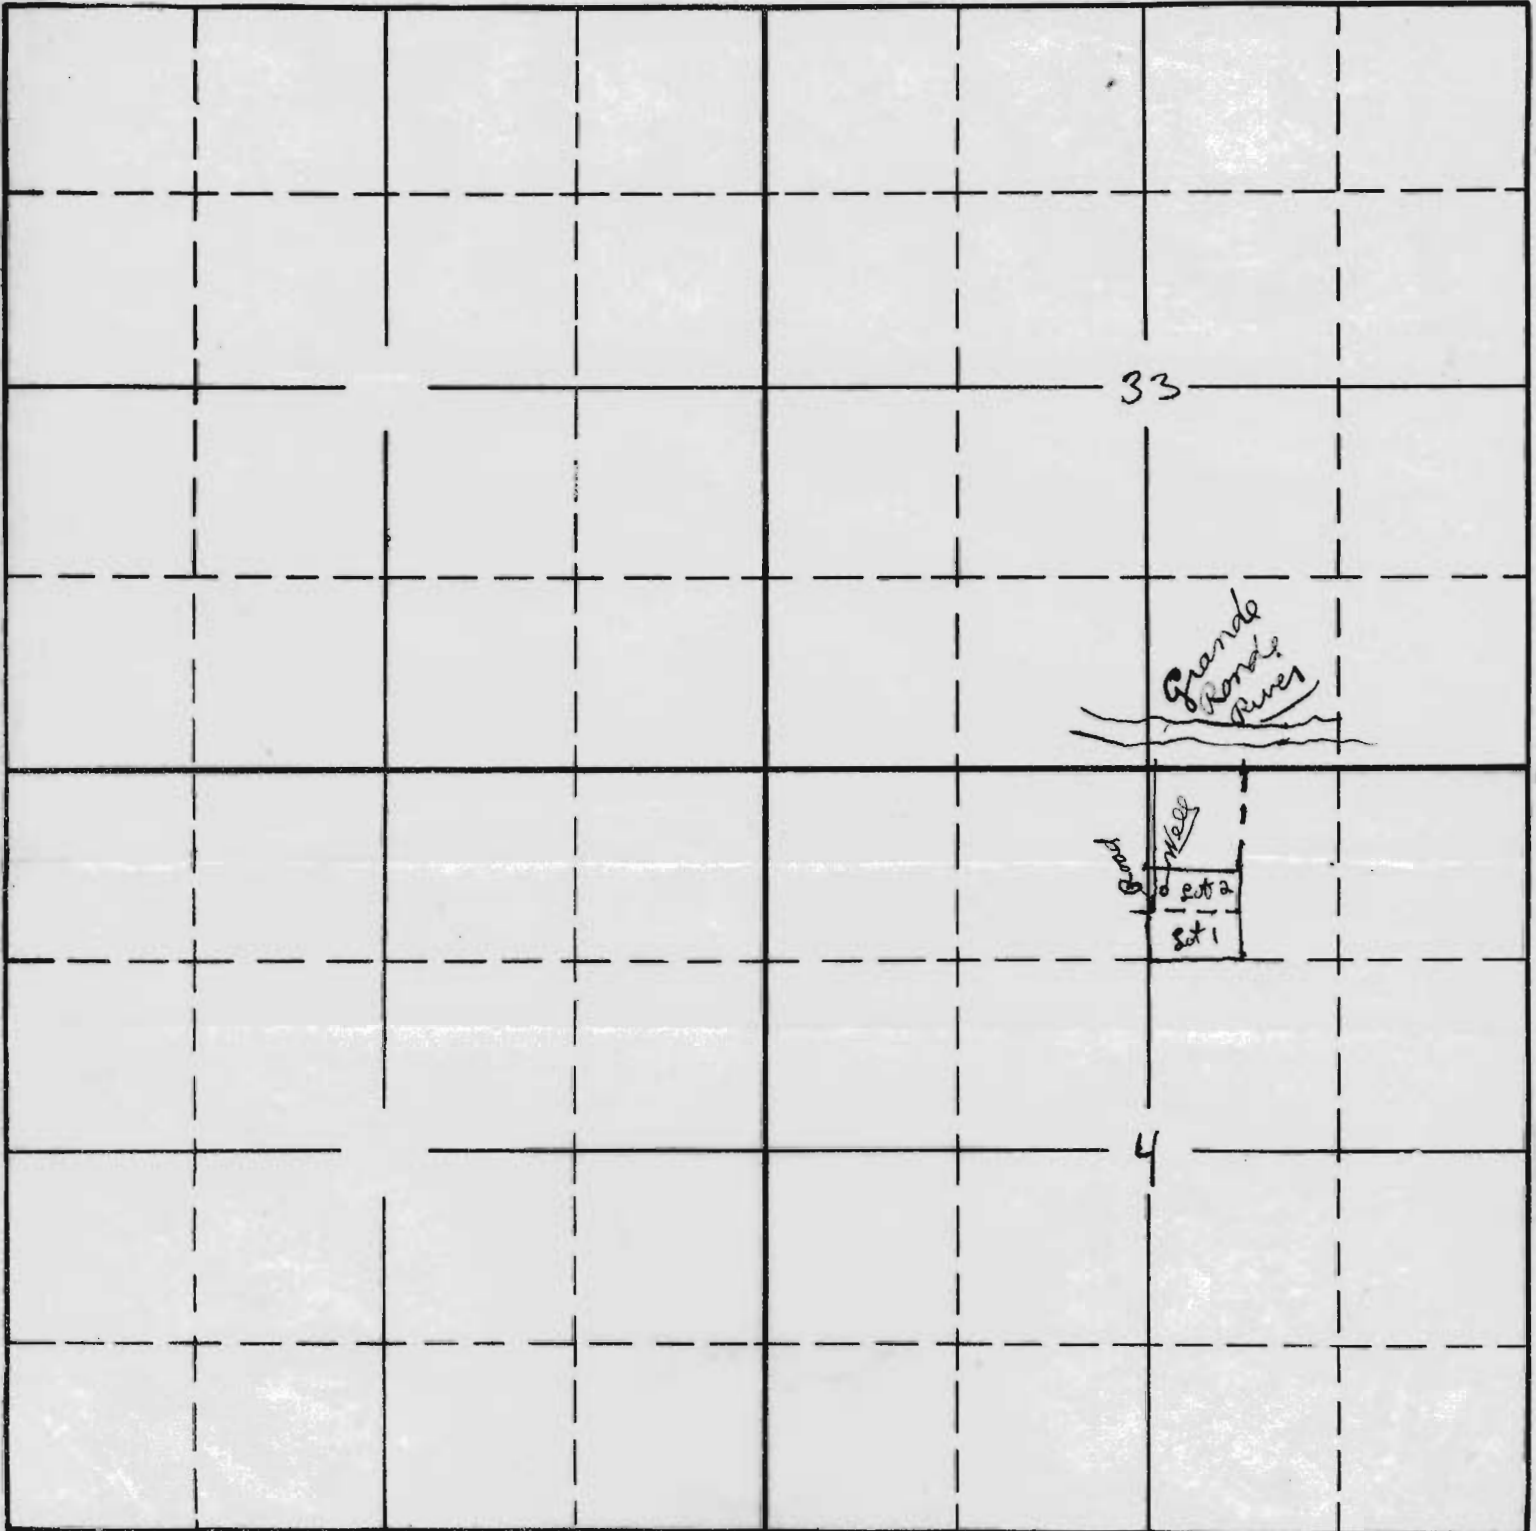

South

U 117 OK
8-18

APPLICATION No. 21-117

PERMIT No. 2-110

RECEIVED

SEP 1 1938

STATE ENGINEER
SALEM, OREGON