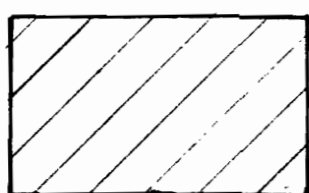


LEGEND

 **IRRIGABLE AREA**

MAP SHOWING
EXISTING WATER SYSTEM
 AT
NEW BURNS INDIAN VILLAGE
 SEC. 1
 T. 23 S. - R. 30 E. - W.M.
BURNS OREGON
 HARNEY COUNTY
 1936

JURISDICTION OF
 UMATILLA AGENCY

SCALE
 1" = 200'
 ACRES 159

U.S. DEPARTMENT OF THE INTERIOR OFFICE OF INDIAN AFFAIRS IRRIGATION DIVISION A.L. WATHEN DIRECTOR H.V. GLOTT'S ASST. DIRECTOR E.C. FORTIER DISTRICT ENGR.	
UMATILLA AGENCY OREGON	
APPROVED:	<i>E.C. Fortier</i> 9/20/46 District Engineer

Application No. U-134
 Permit No. - U-126

Existing System added and Traced by W.V., San Francisco, March 2, 1940, From a blueprint which accompanied report dated December 29, 1936
 Irrigable Area Added Aug. 21, 1940 by W.V.

COMMUNITY PASTURE

IRRIGATION DITCH

U-134
 43