


75223  
T4703

T.14~~3~~5S.R.16E.W.M.

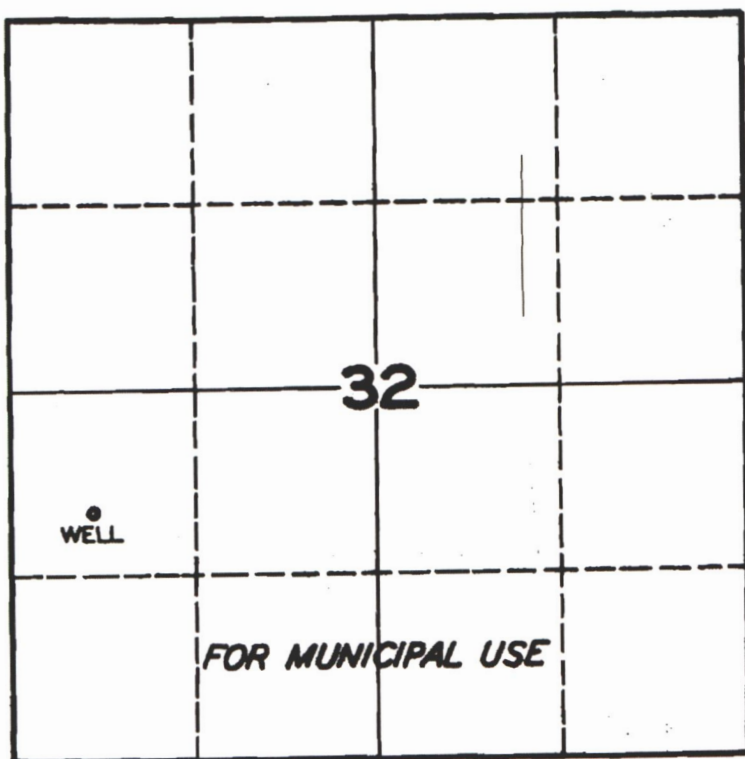

**FINAL PROOF SURVEY**  
**UNDER**

Application No. U-147 Permit No. U-140

IN NAME OF

PACIFIC POWER & LIGHT CO.

Surveyed APR. 30 1946 by [Signature]