


TOWNSHIP 34 S, RANGE 6 W

Permit: S 15550
Volume: 5B
Strm: GRAVE CR
Trib: ROGUE R
Priority: 7/21/43

Permit: S 15550
Volume: 5B
Strm: MACKIN G
Trib: GRAVE CR
Priority: 7/21/43

*See FM
Proof
Trans. B-4*

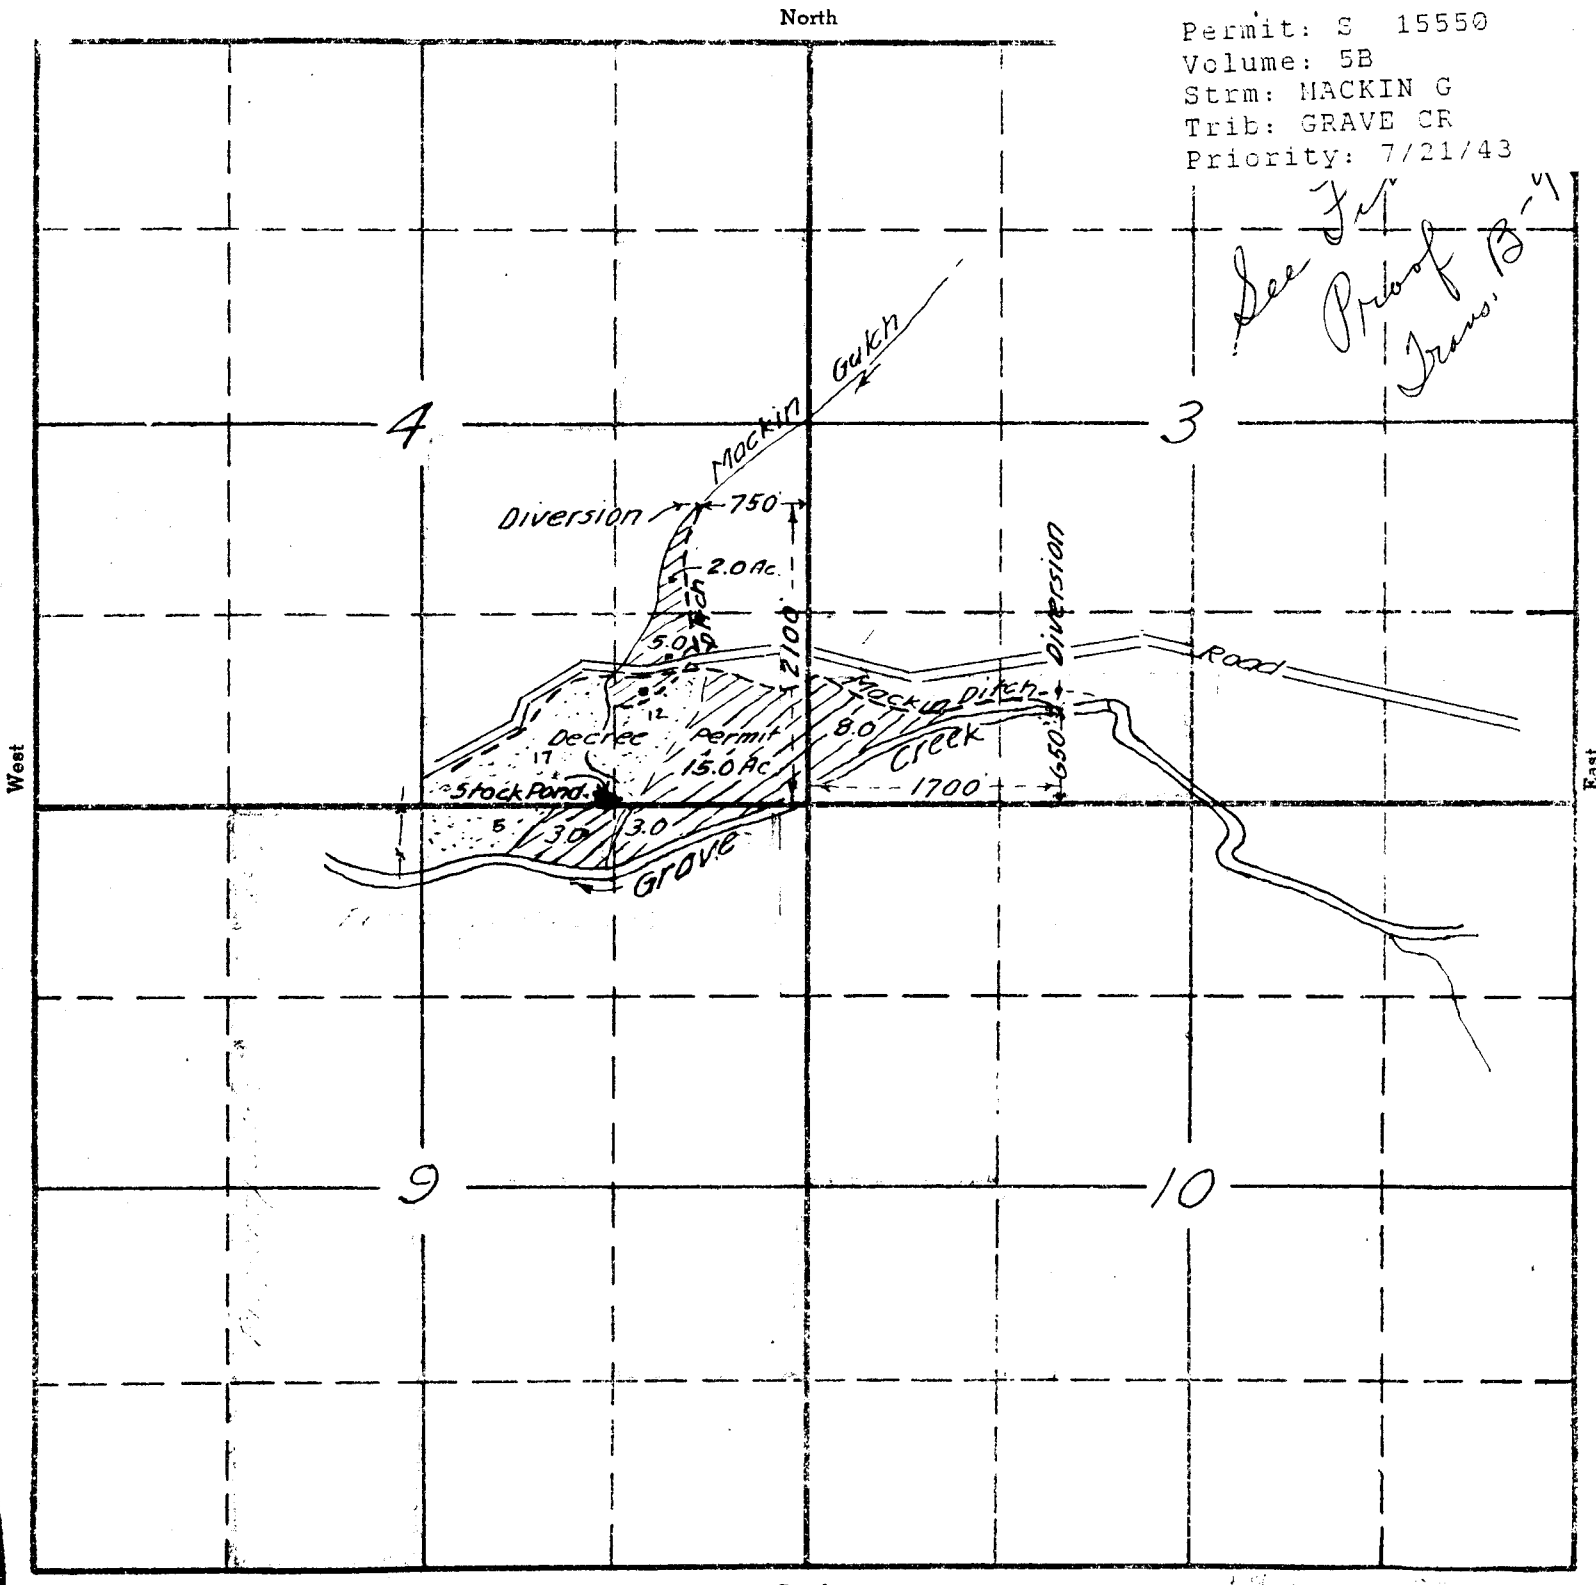


South

*C. J. Moser
July 1943.*

APPLICATION No. 19986
PERMIT No. 15550

34-6-3,4
9,10

TWP 34 S R 6 WWM

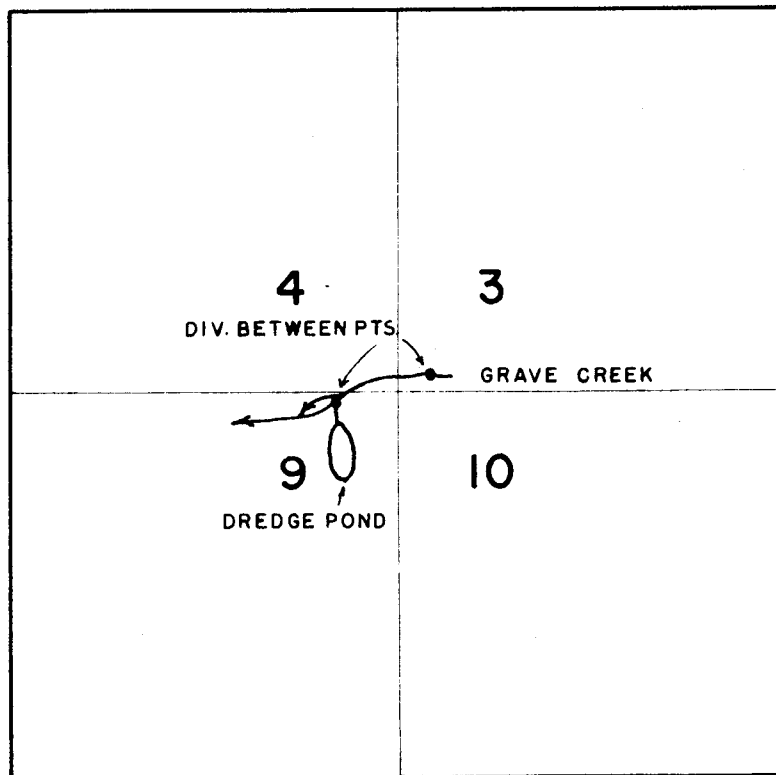

CHANGE OF POINT OF DIVERSION
UNDER

Transfere No. B-94
In Name Of JOHN M BIENCOURT
Surveyed September 22 1961 By Steimer