


Sec. 1

Tp. 24

R. 30

Silvie's River

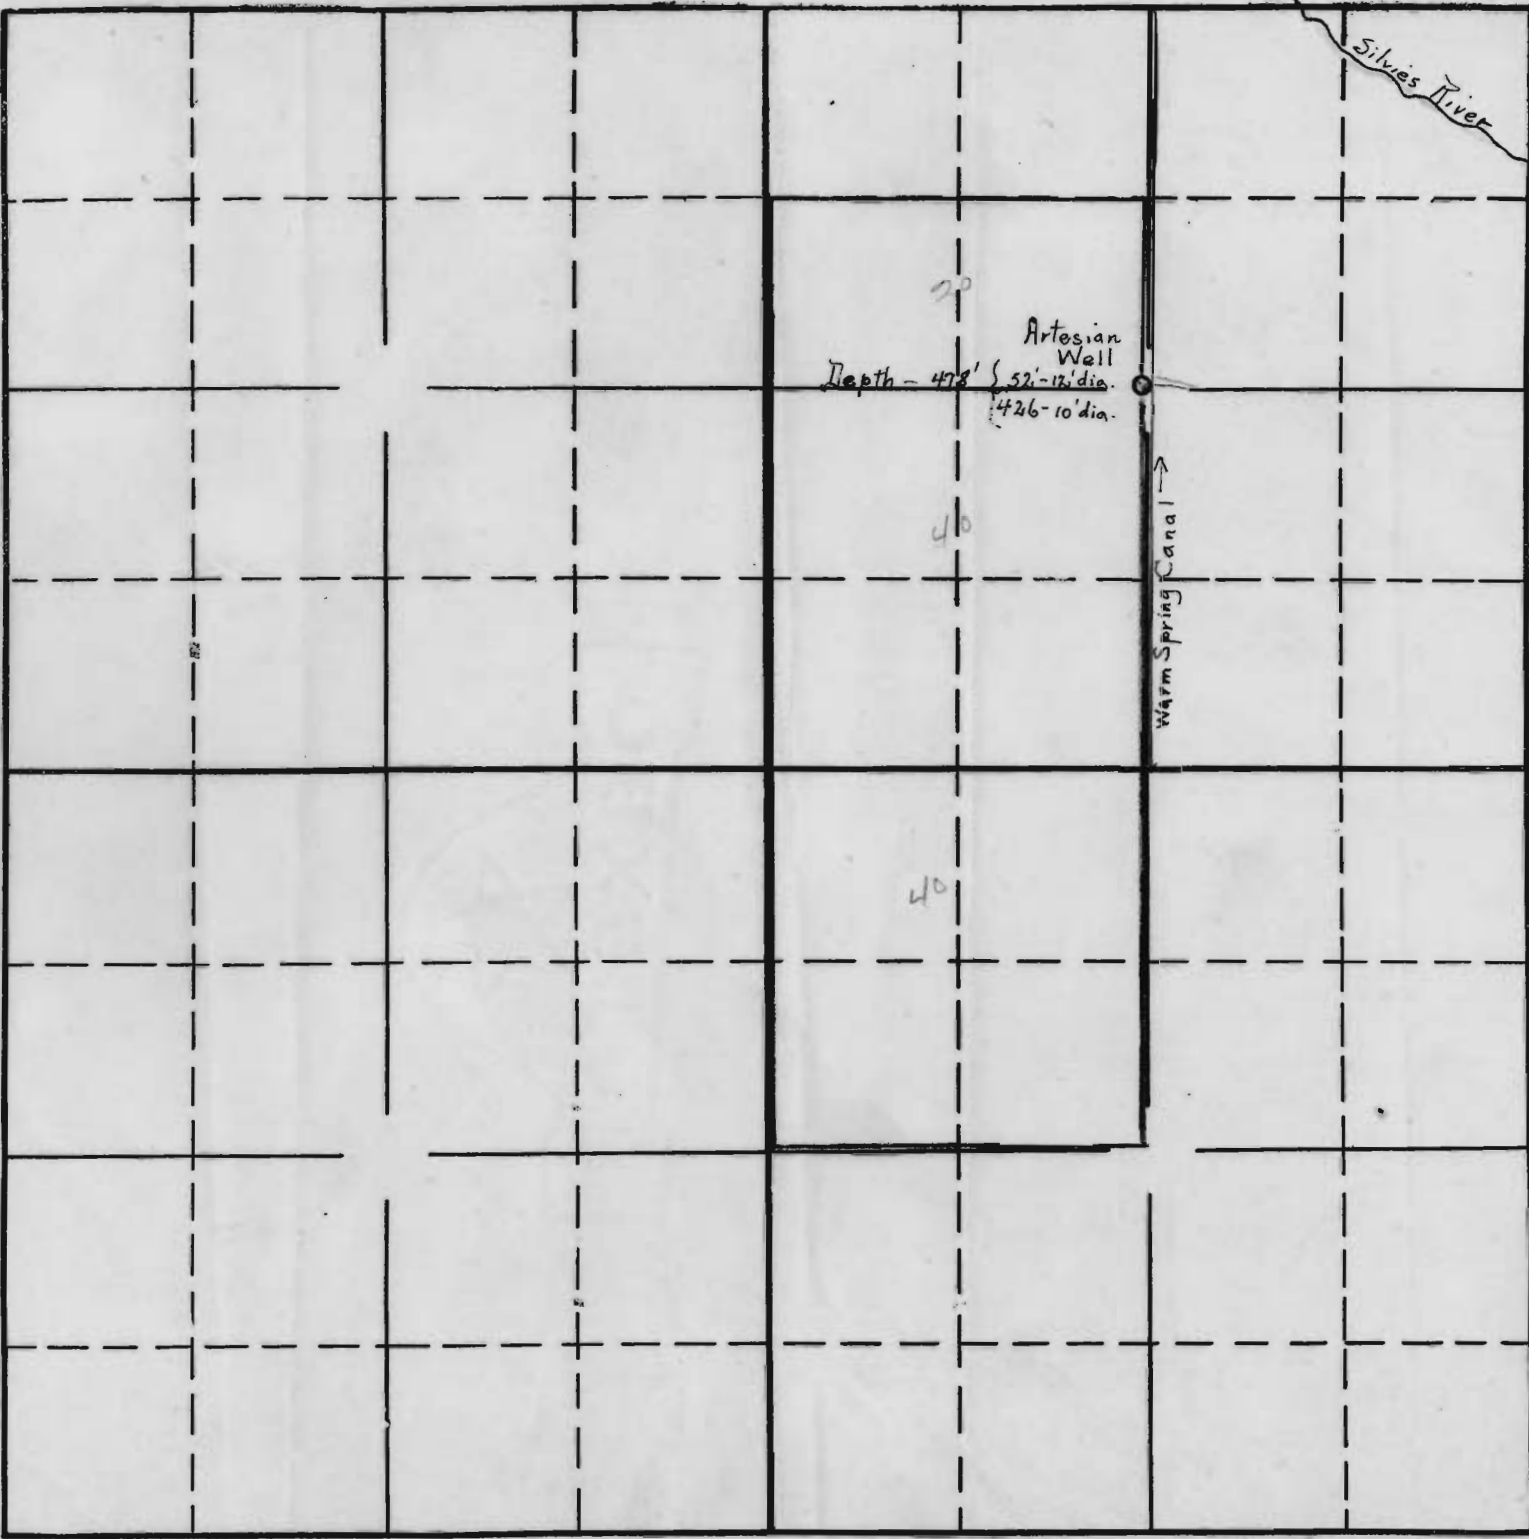

Artesian Well  
 Depth - 478' } 52'-12" dia.  
 426'-10" dia.

Warm Spring Canal

20

40

40

Application No. 21-38  
 Permit No. 21-32