


SECTION

TOWNSHIP 35, RANGE 38 E, W. M.

North

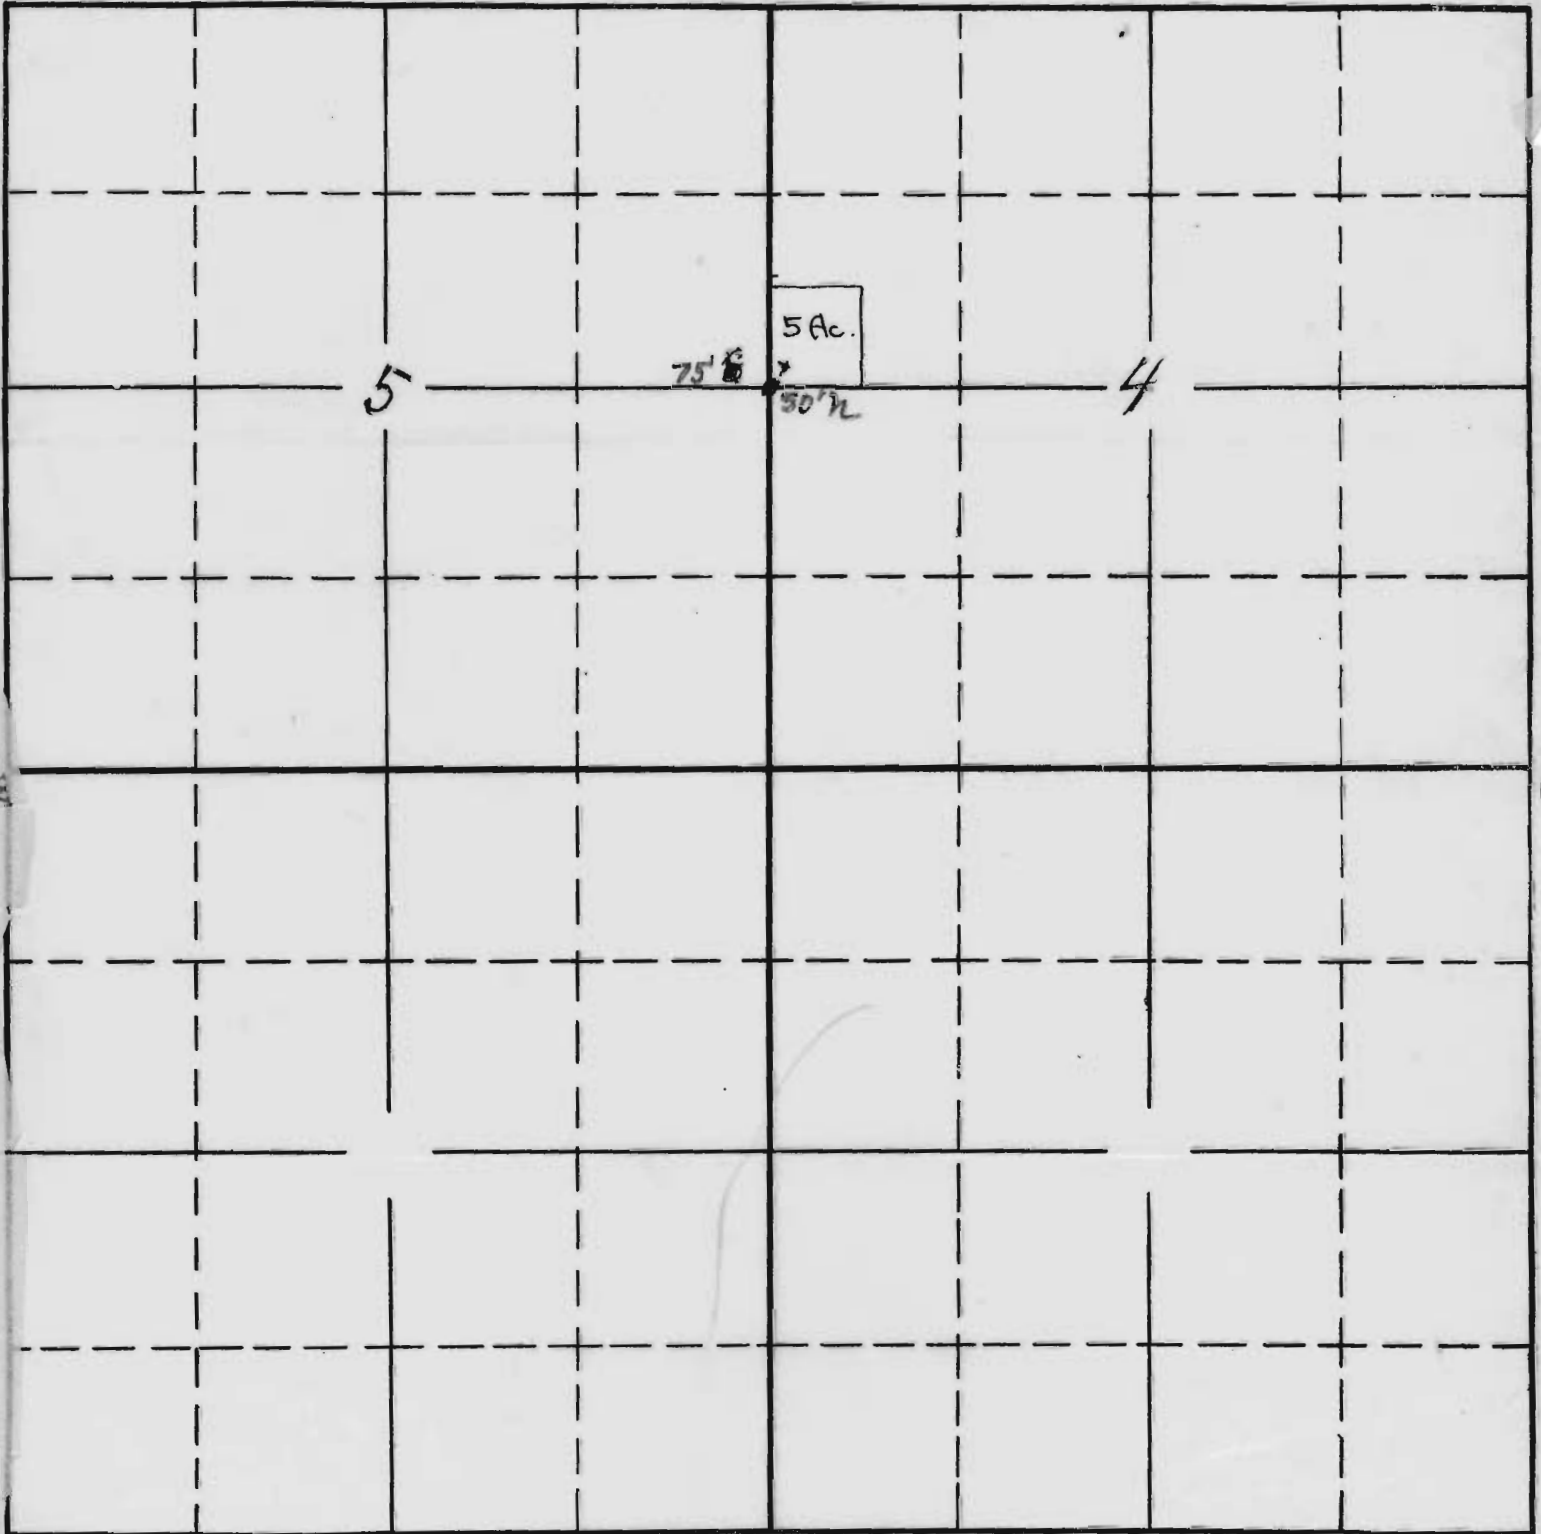

South

APPLICATION No. 21-42  
PERMIT No. 21-39