


SECTION 14
TOWNSHIP 15 SOUTH
RANGE 40 E.W.M.

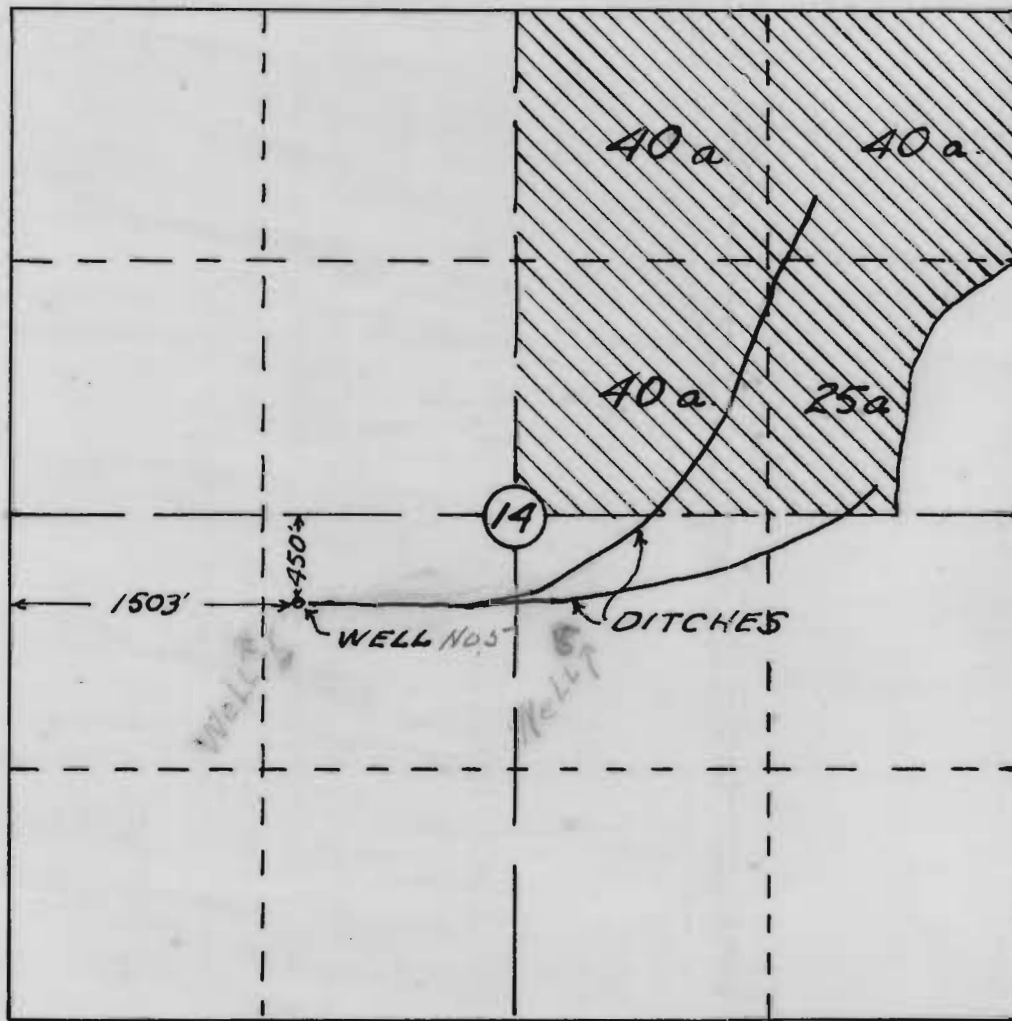

Application No. U-422
Permit No. U-392

SCALE 1" = 1000'
RANKIN CROW
MALHEUR COUNTY, OREGON

