


GLENN E. TYLER
 COUNTY SURVEYOR
 LAKE COUNTY
 LAKEVIEW, OREGON

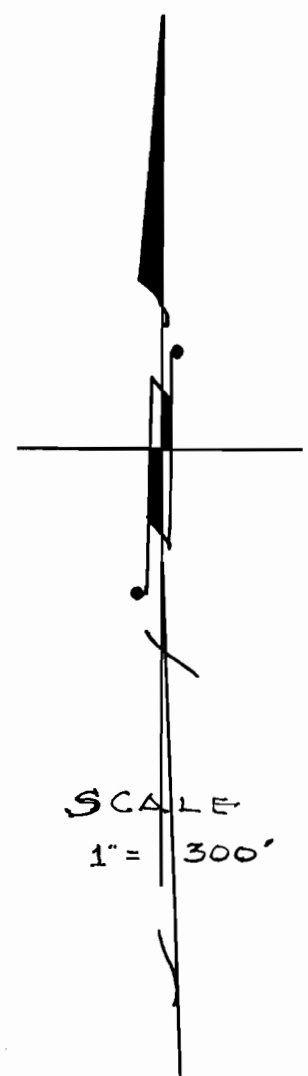

SCALE
 1" = 300'

Application No. U-425
 Permit No. U-393

RECEIVED
 STATE ENGINEER
 SALEM, OREGON

MAP TO ACCOMPANY THE APPLICATION OF
 FAVELL-LITLEY REALTY CO. OF LAKEVIEW
 OREGON, TO APPROPRIATE UNDERGROUND
 WATERS, BY PUMPING, FOR IRRIGATION
 PURPOSES. LOCATED IN SEC. 17-T39-S
 R-20E.W.M. LAKE COUNTY, OREGON.

I, GLENN E. TYLER OF LAKEVIEW OREGON DO
 HEREBY CERTIFY THAT THE ABOVE MAP WAS
 MADE FROM FIELD NOTES TAKEN DURING
 AN ACTUAL SURVEY MADE BY ME ON MARCH
 17 1949. THE MONUMENT SET FOR THE WELL
 TIE CONSISTS OF A 3" X 30" IRON PIPE DRIVEN
 24" IN THE GROUND. SAID PIPE IS APPROX.
 30' NORTH OF THE WELL AND IS S 78° 16' E
 FROM THE NW CORNER OF SEC. 17-T39-S
 R-20E.W.M. DISTANCE 367.90'

Glenn E. Tyler

REGISTERED
 OREGON
 LAND SURVEYOR
Glenn E. Tyler
 NOV. 9 1948
 GLENN E. TYLER
 250