


Sec. 27

Tp. 6 N

R. 35 E

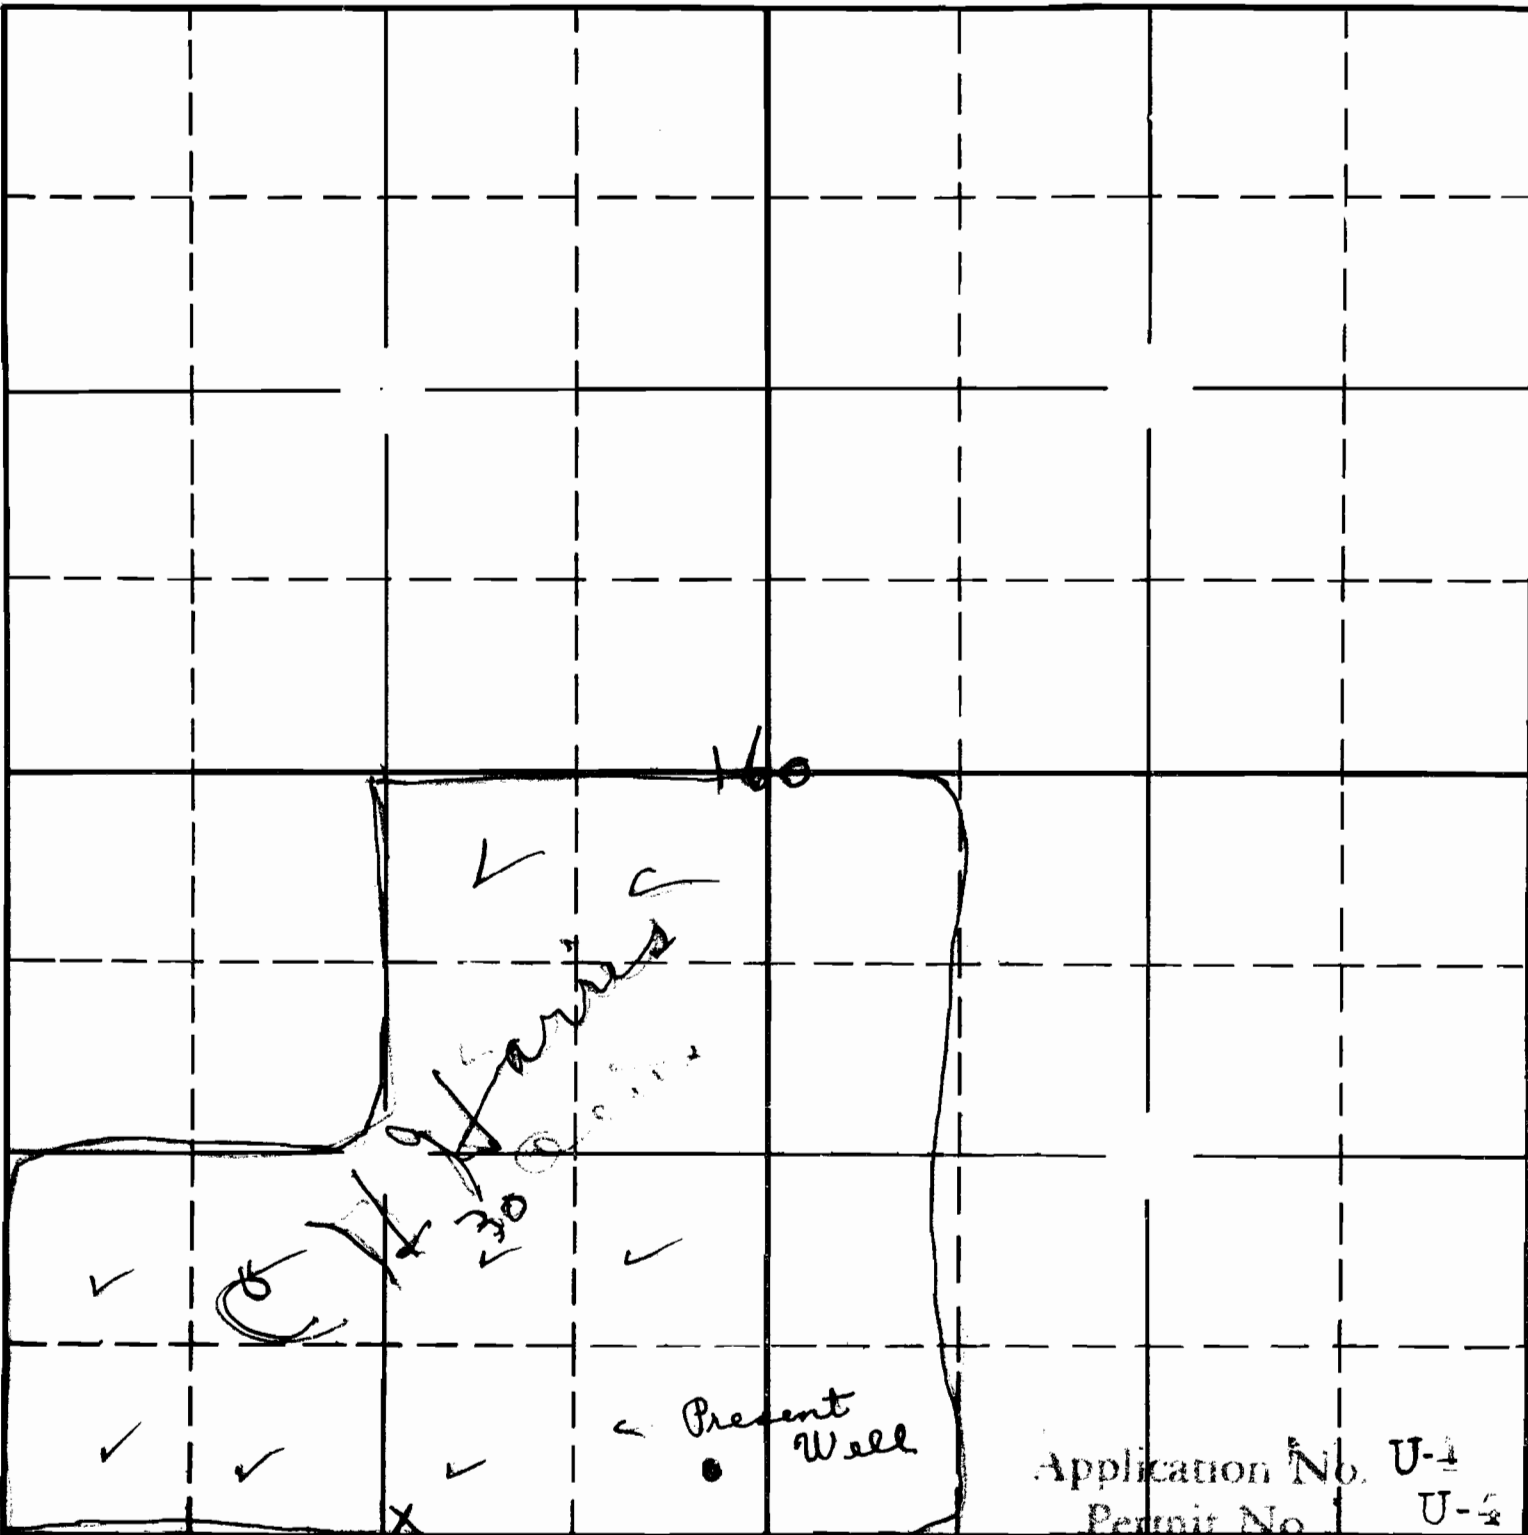

Present Well

new Well

