


Application No. U-443  
Permit No. U-414

SECTION 2, TOWNSHIP 15 SOUTH, RANGE 40 E. W. M.

Scale 800' equals 1"

NORTH

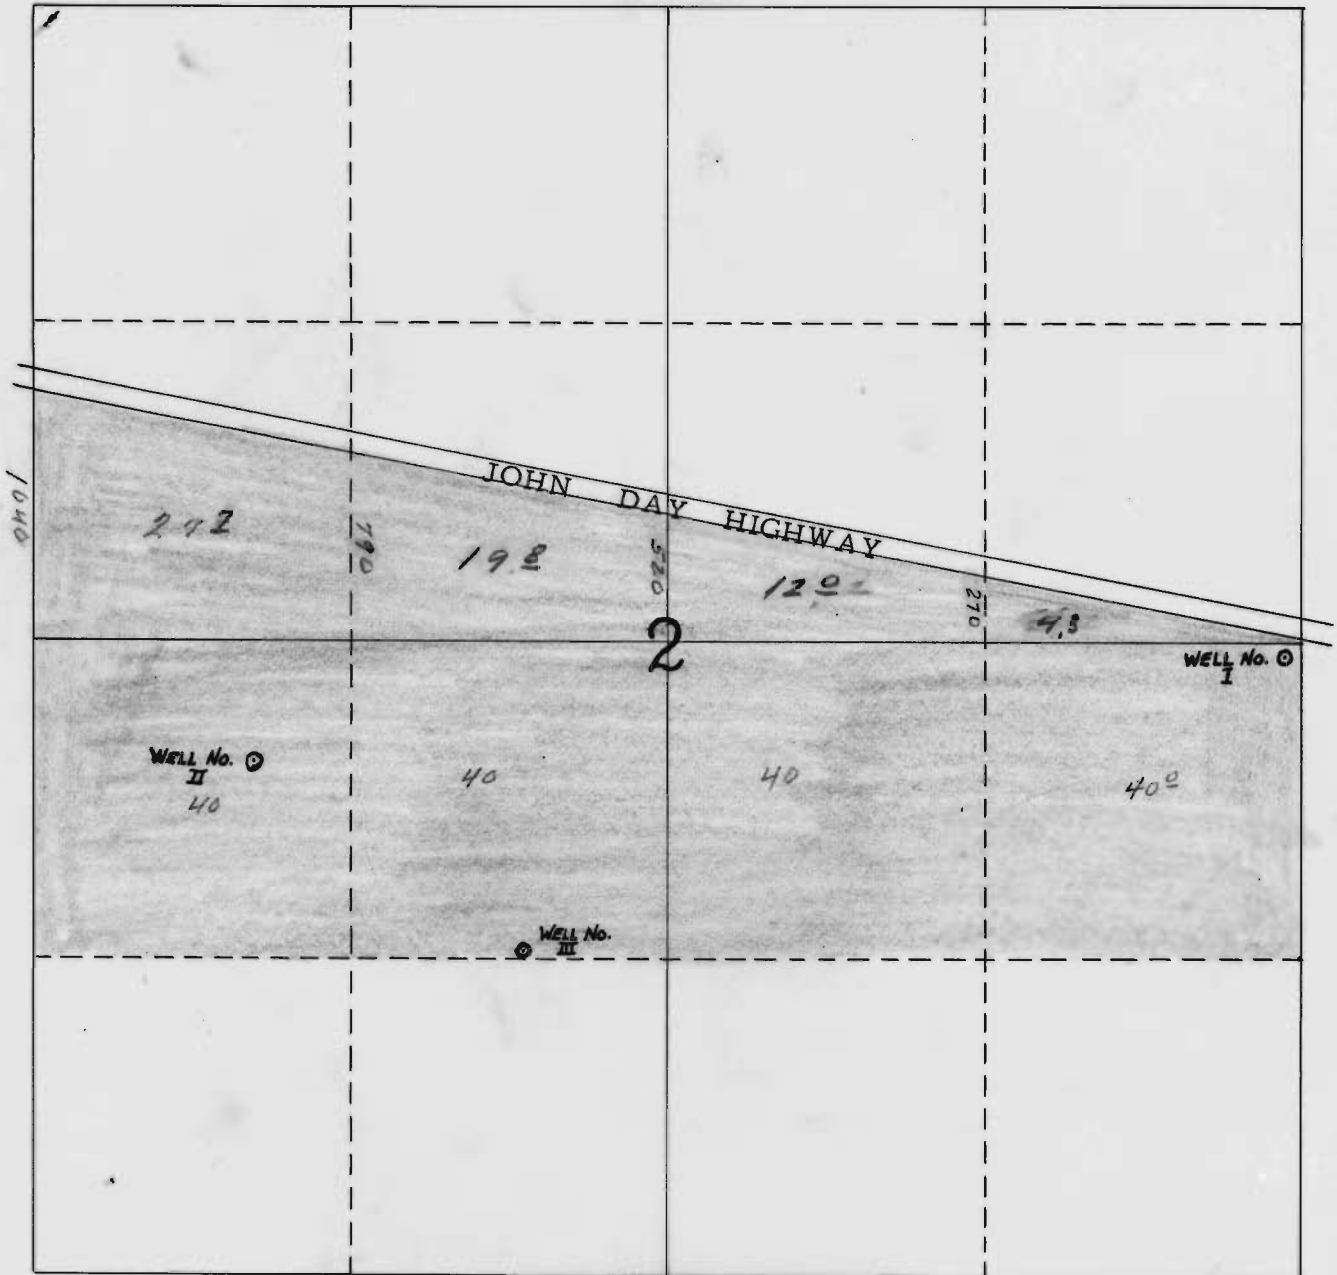

SOUTH

- WELL No. 1 - 2702 feet South and 73 feet West of the Northeast Corner of Section 2, Township 15 South, Range 40 E. W. M.
- WELL No. 2 - 2130 feet North and 920 feet East of the Southwest Corner of Section 2, Township 15 South, Range 40 E. W. M.
- WELL No. 3 - 1348 feet North and 2048 feet East of the Southwest Corner of Section 2, Township 15 South, Range 40 E. W. M.