


THIS MAP IS PART OF:  
TWP. 9 SOUTH, RANGE 40 EAST, WILL. MERIDIAN

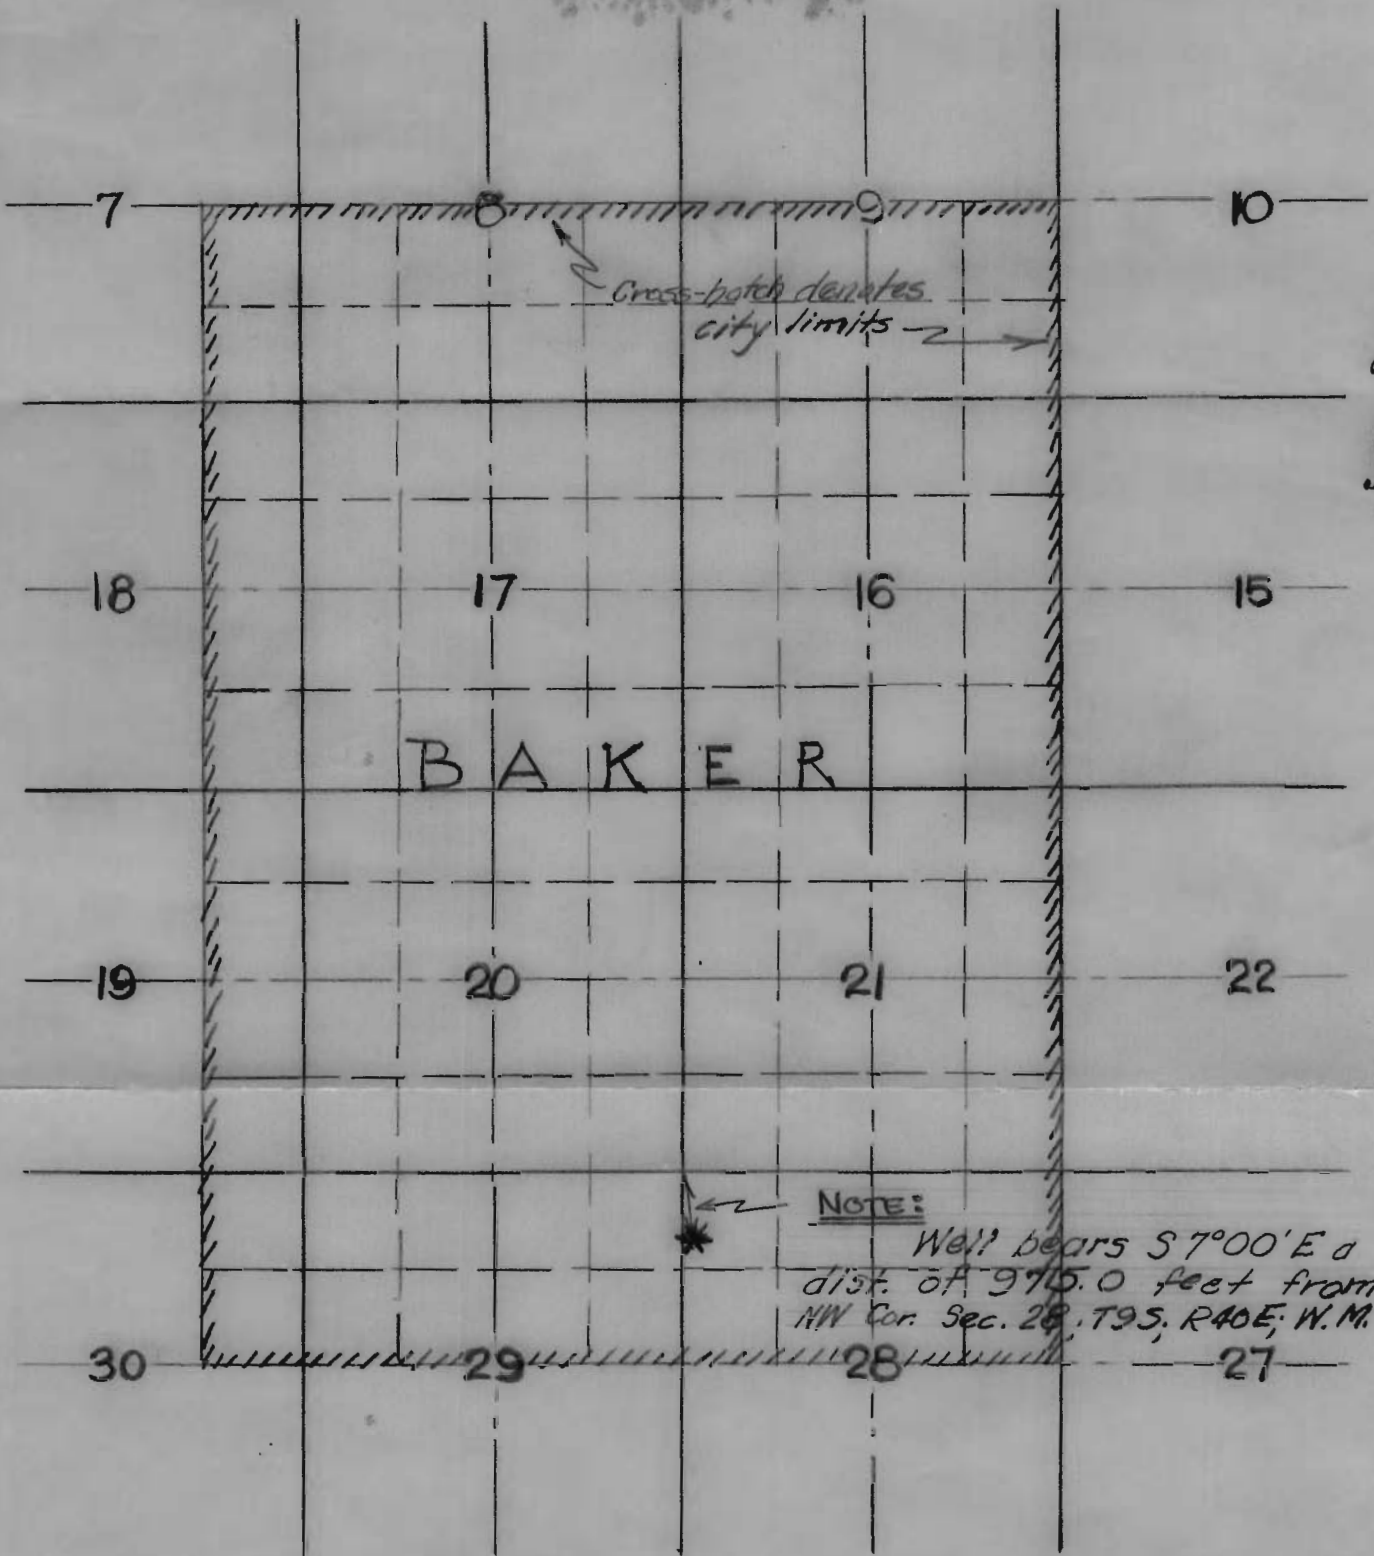

LOCATION OF WELL TO BE USED  
JOINTLY BY CALIFORNIA-PACIFIC UTILITIES CO.  
AND THE CITY OF BAKER, BAKER COUNTY, ORE.

SCALE: 2" = 1 MILE      DATE: 11-12-53      TRACED BY: JRG

NOTE:  
Asterisk denotes well &  
pump location.

RECEIVED  
NOV 16 1953  
STATE ENGINEER  
SALEM, OREGON

U-639  
U-584