


N.

SE⁴ of Sec. 27, Tp. 6, N. R. 35 E. W. M.

Appleton Road.

27

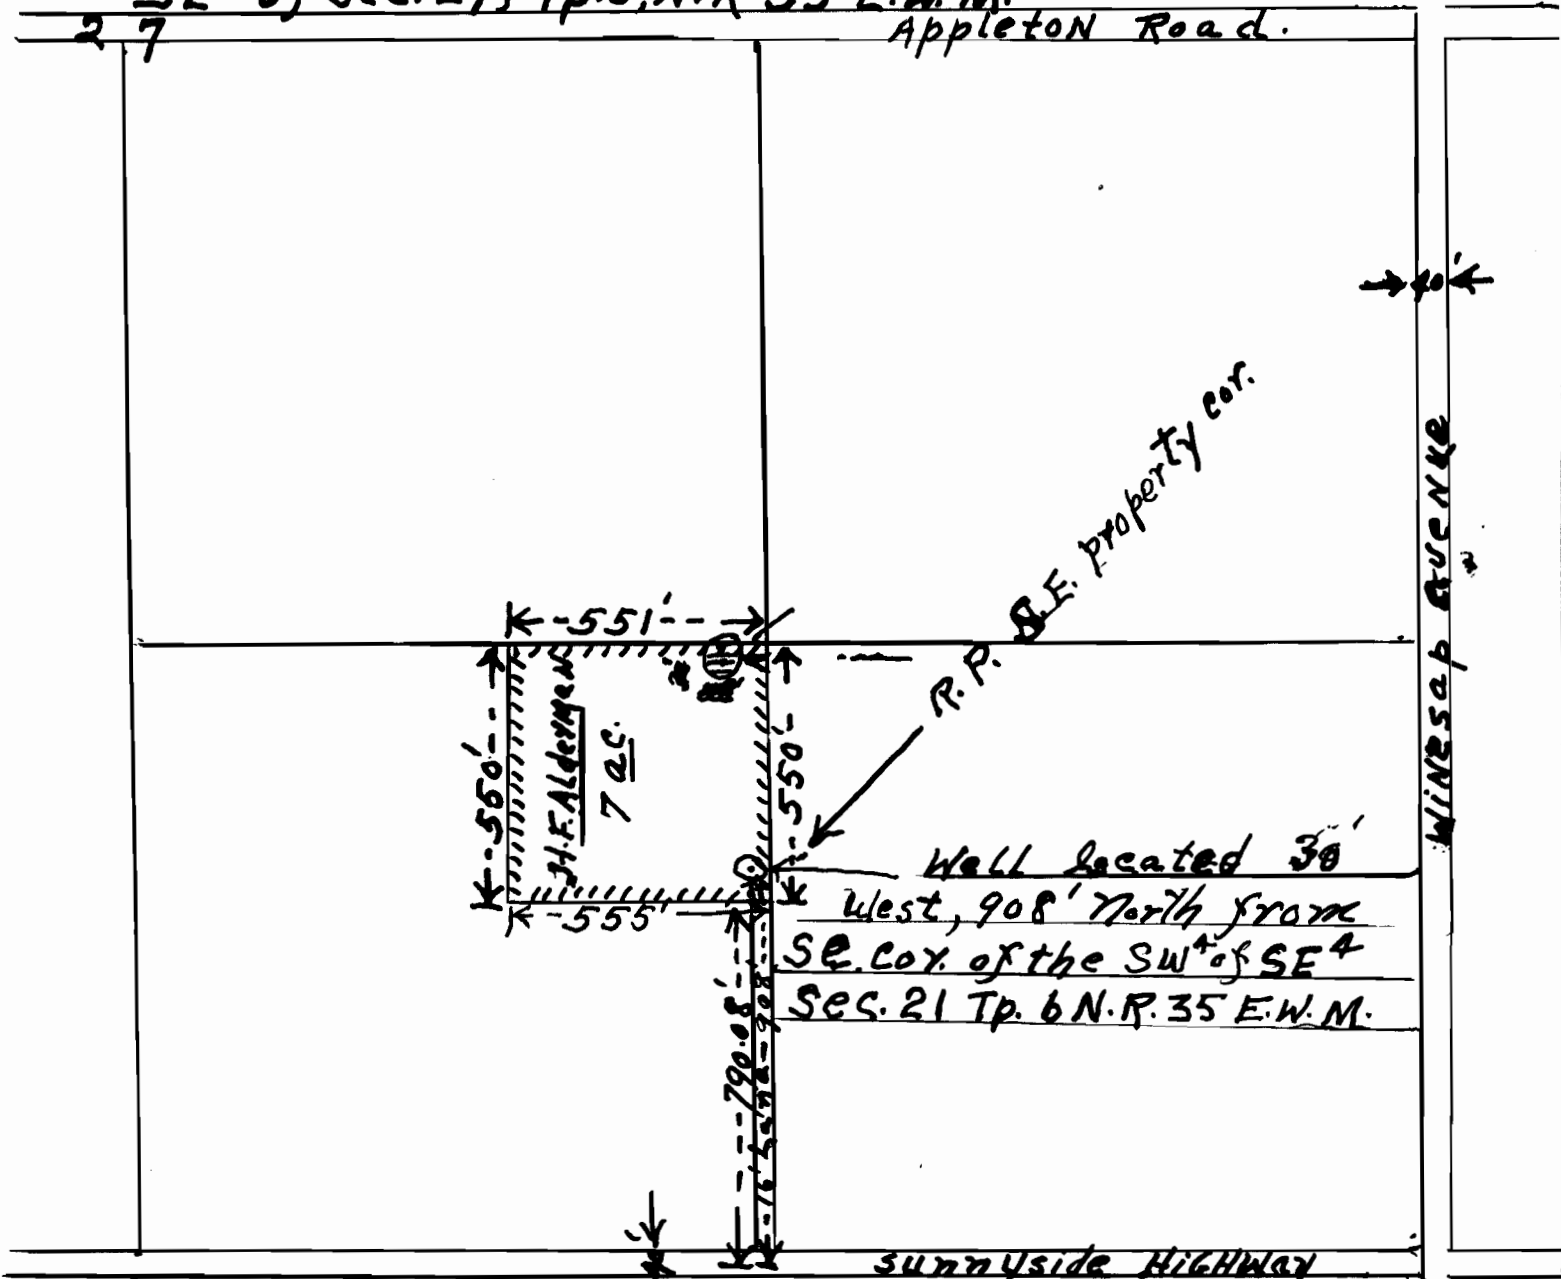

Scale 1" = 400'

Map to accompany Application of Hayden F. Alderman for Well permit for Irrigation.

Application No. U-817
Permit No. U-736