


JN

25

TOWNSHIP 6 S, RANGE 41 E, W. M.

North

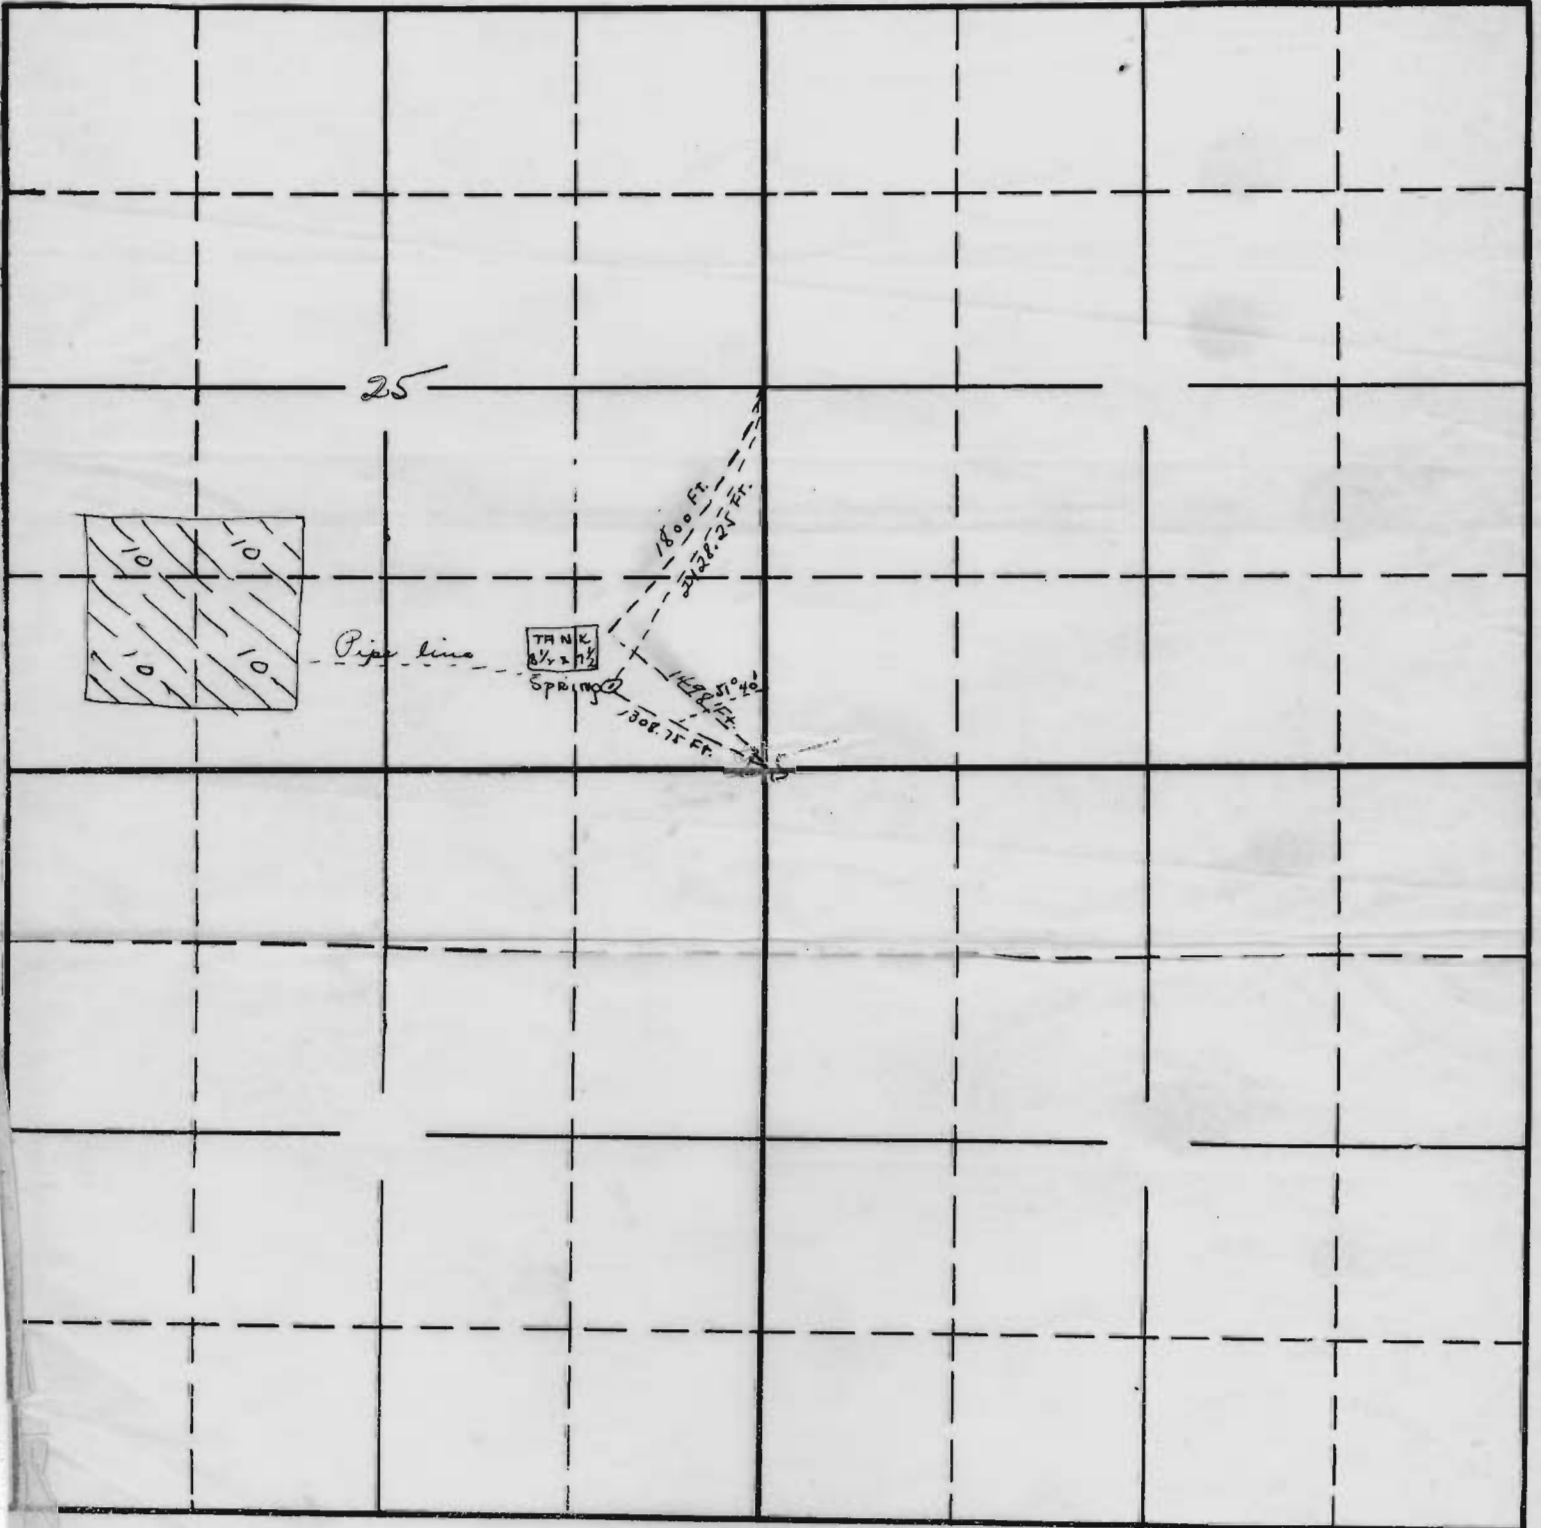

East

South

APPLICATION No. 21-79
 PERMIT No. 26-76