

TO

EXISTING - 22135

FROM

1" = 800'

RECEIVED  
 APR 29 2009  
 WATER RESOURCES DEPT  
 SALEM, OREGON

2410<sup>00</sup>

Young X-fer

11113




4 3 08

SECTION 8 T4S R3W W.M.  
YAMHILL COUNTY

SECTION 7 T4S R3W W.M.  
YAMHILL COUNTY

THIS MAP WAS PREPARED FOR  
ASSESSMENT PURPOSES ONLY

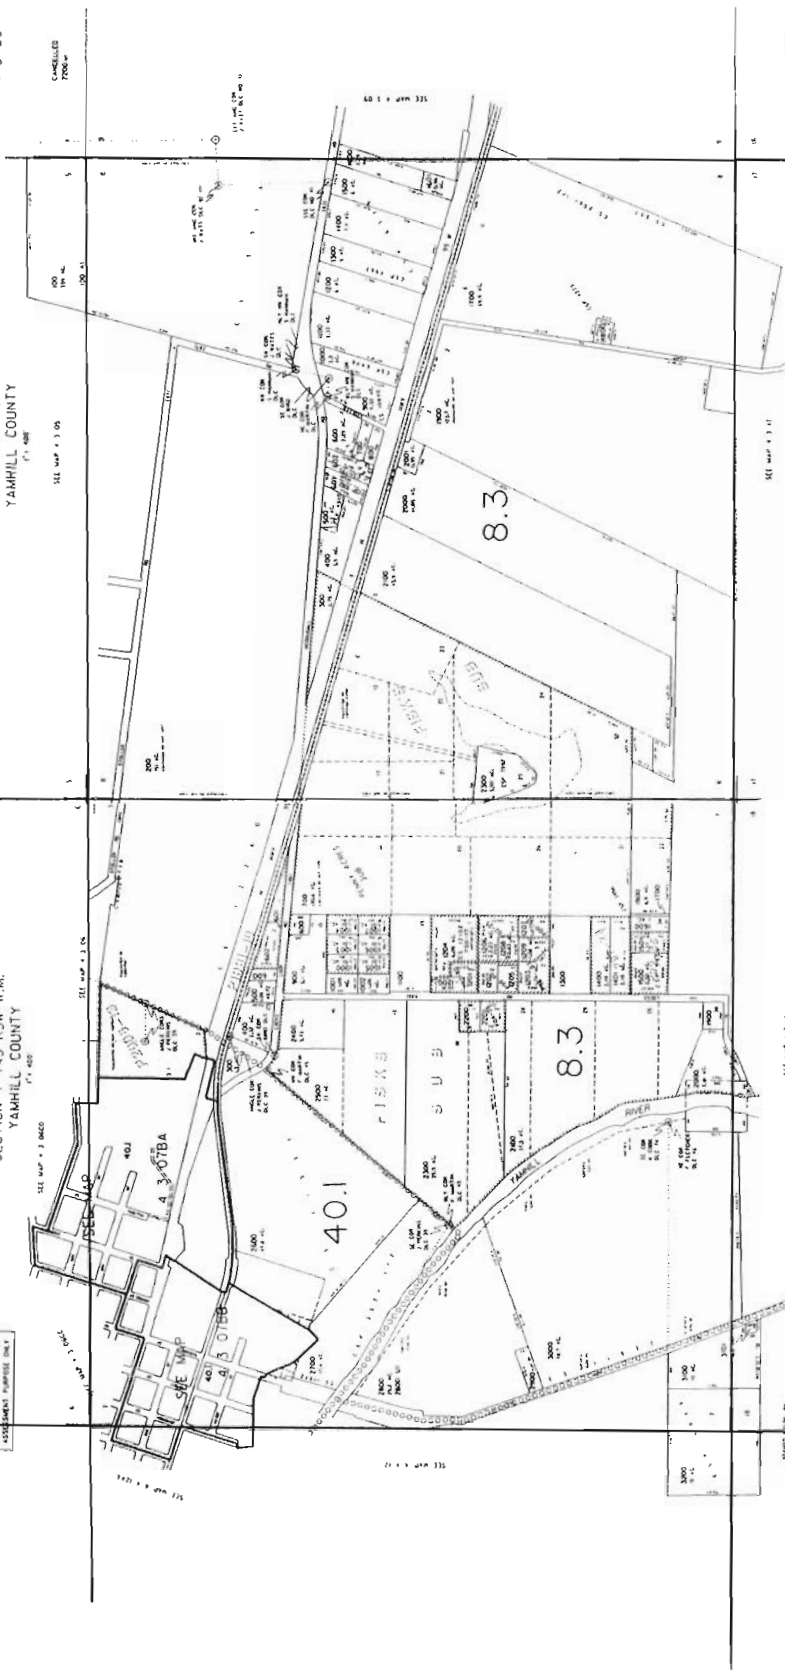

4 3 08

SEE MAP 4 3 08

SEE MAP 4 3 08

SEE MAP 4 3 08

SEE MAP 4 3 08

T 11113

**RECEIVED**

APR 29 2009

WATER RESOURCES DEPT  
SALEM, OREGON