



Attachment 2
Short - Term Water Right Lease Agreement
Leased Right Map

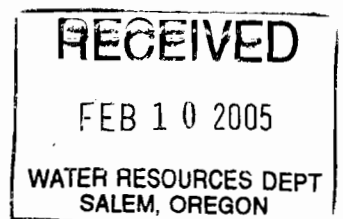

3334
T-4063

T.28 S. R.4 W. W.M.

Scale: 4" = 1 mile

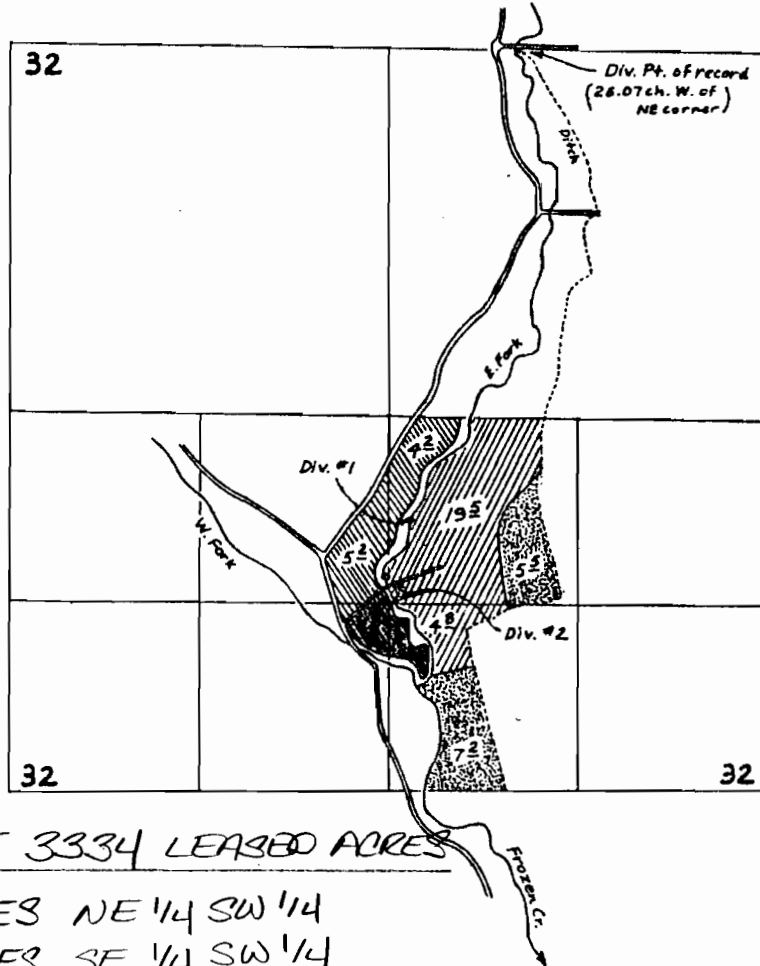

PERMIT 3334 LEASED ACRES

.50 ACRES NE 1/4 SW 1/4
1.40 ACRES SE 1/4 SW 1/4
1.40 ACRES SW 1/4 SE 1/4

A# 5430

P# 3334

RECEIVED

FEB 10 2005

WATER RESOURCES DEPT
SALEM, OREGON

RECEIVED

OCT 13 1978

WATER RESOURCES DEPT.
SALEM, OREGON

RECEIVED

OCT 4 1978

WATER RESOURCES DEPT.
SALEM, OREGON



Change in Div. Pt. only



Transfer from




Transfer to and change in Div. Pt.

Div. #1 located 1840' N. and 2430' E from SE cor. sec. 32

Div. #2 located ~~1290' N~~ 1450' N and ~~2540' E~~ 2600' E from SE cor sec. 32

T.28S. R.4W. W.M.

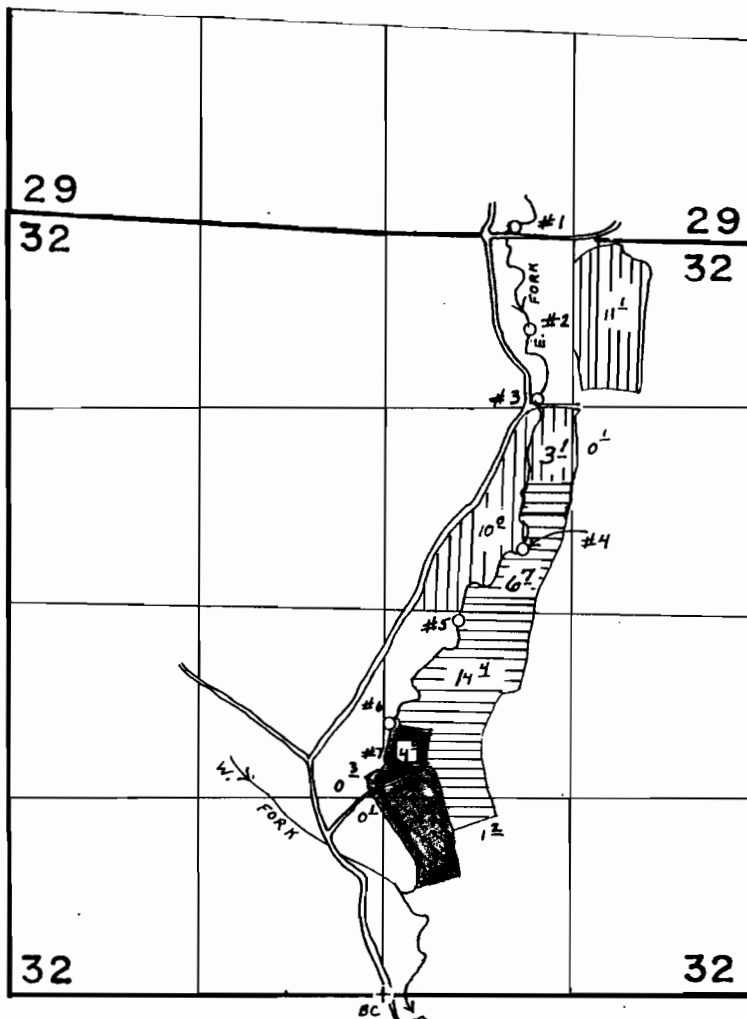

DIV. PTS. LOCATED:

#1	5210'N	E	890'E
2	4510'N	E	1000'E
3	4040'N	E	1050'E
4	3020'N	E	950'E
5	2540'N	E	510'E
6	1830'N	E	40'E
7	1510'N	E	30'E

All from S 1/4 corner of Sec. 32.

PERMIT 9758
TO BE LEASED

- T-4801
- T-4802
- T-4803
- o DIV. PT. 1-7

SCALE: 4" = 1 mile

FINAL PROOF SURVEY
UNDER

TRANSFER: T-4801

T-4802

Application No. T-4803 Permit No.
IN NAME OF

DUANE L. SMITH

Surveyed SEPT. 28 1983, by L. E. Cushman

RECEIVED

FEB 10 2005

WATER RESOURCES DEPT
SALEM, OREGON


T28 f 295. R4W.

FROZEN CK


RECEIVED

FEB 10 2005

WATER RESOURCES DEPT
SALEM, OREGON

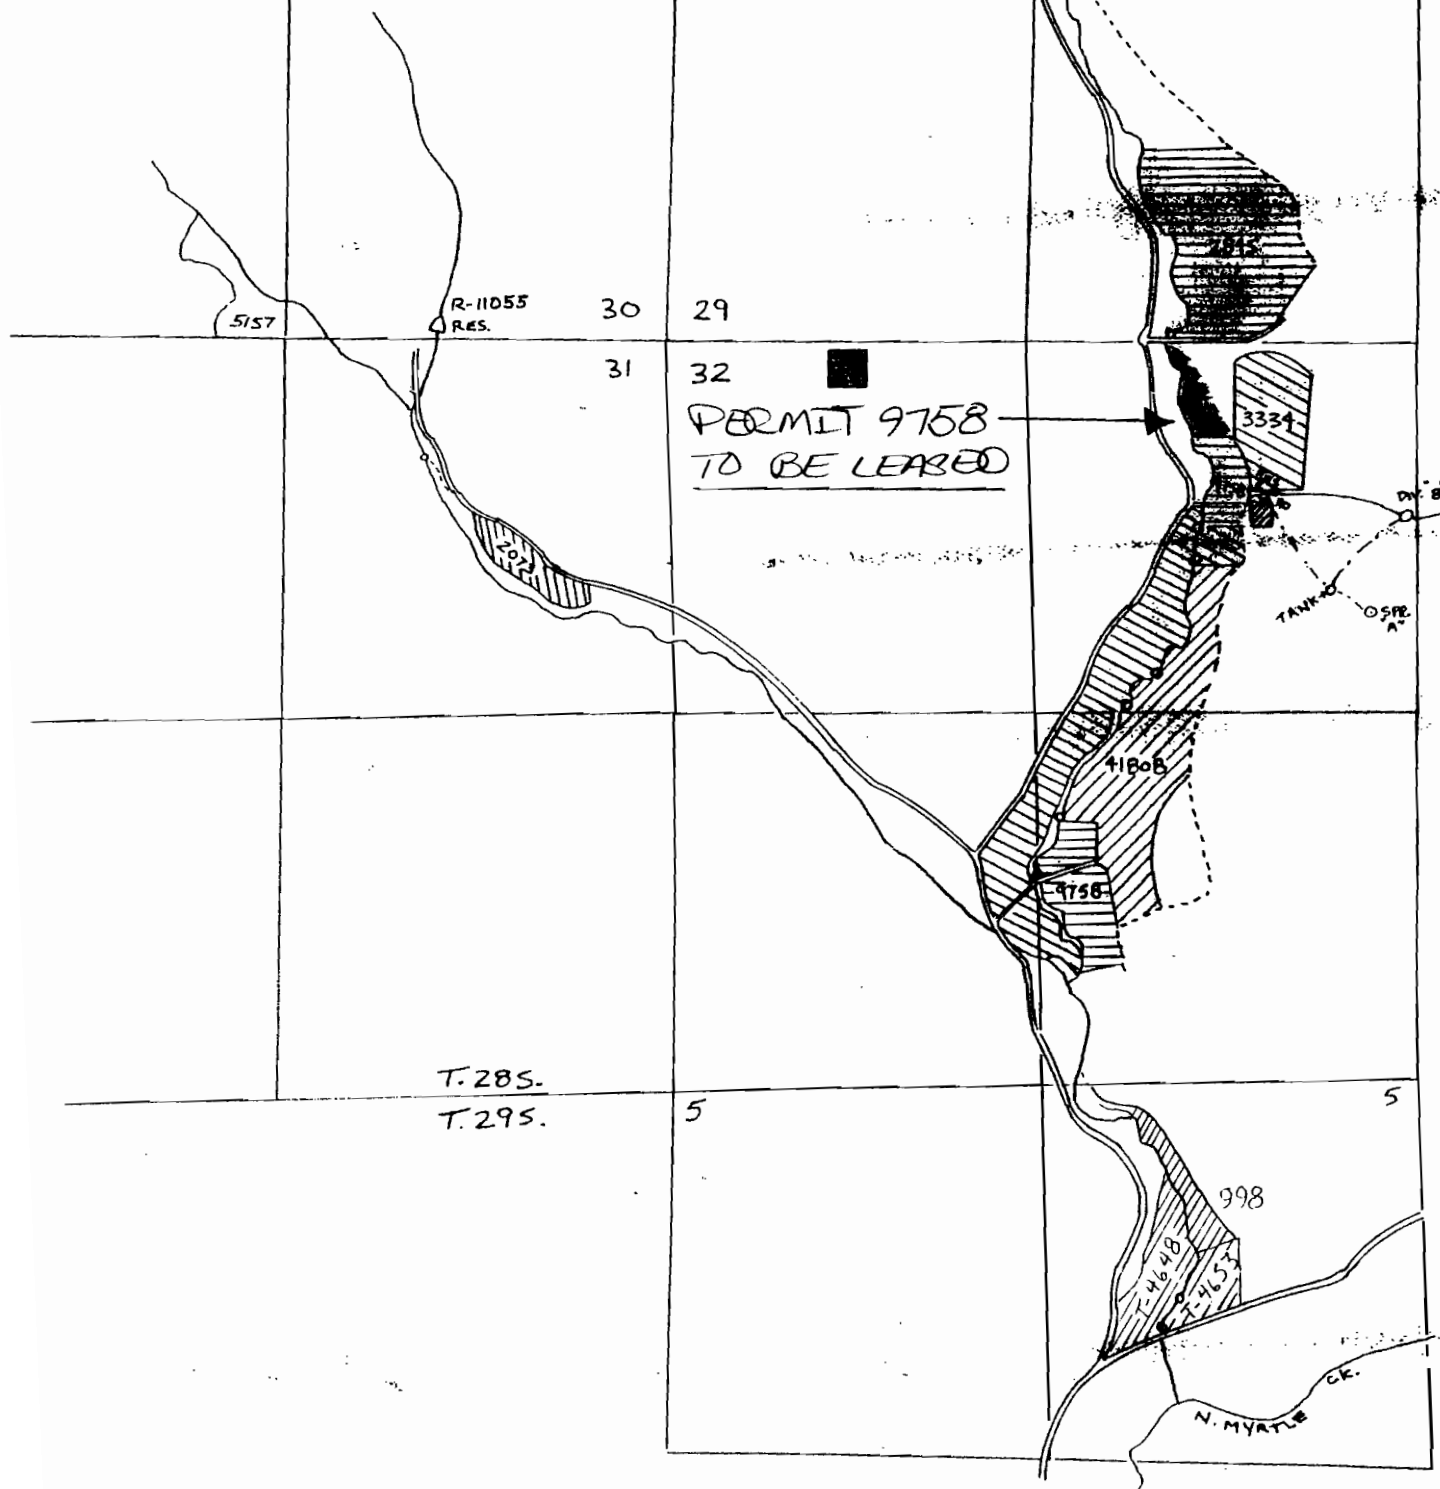

T.28S. R.4W. W.M.

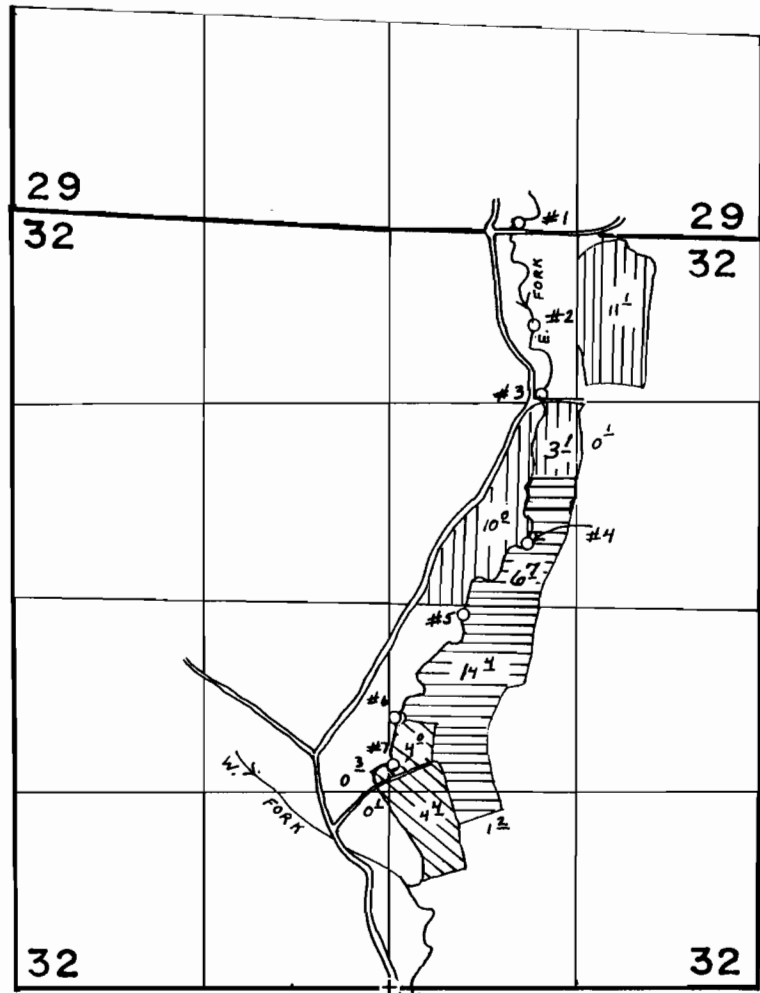

DIV. PTS. LOCATED:

#1	5210'N	E	890'E
2	4510'N	E	1000'E
3	4040'N	E	1050'E
4	3020'N	E	950'E
5	2540'N	E	510'E
6	1830'N	E	40'E
7	1510'N	E	30'E

All from S 1/4 corner of Sec 32.

□ - PERMIT 41808
TO BE LEASED

- ▨ T-4801
- ▨ T-4802
- ▨ T-4803
- DIV. PT. 1-7

SCALE: 4" = 1 mile

FINAL PROOF SURVEY
UNDER

TRANSFER: T-4801
T-4802
Application No. T-4803 Permit No.
IN NAME OF

DUANE L. SMITH


Surveyed SEPT. 28 1983, by L. E. Cashion

RECEIVED
FEB 10 2005
WATER RESOURCES DEPT
SALEM, OREGON

41808

T.28S. R.4W. W.M.

PERMIT 41808
TO BE LEASED (5.2 ACRES)

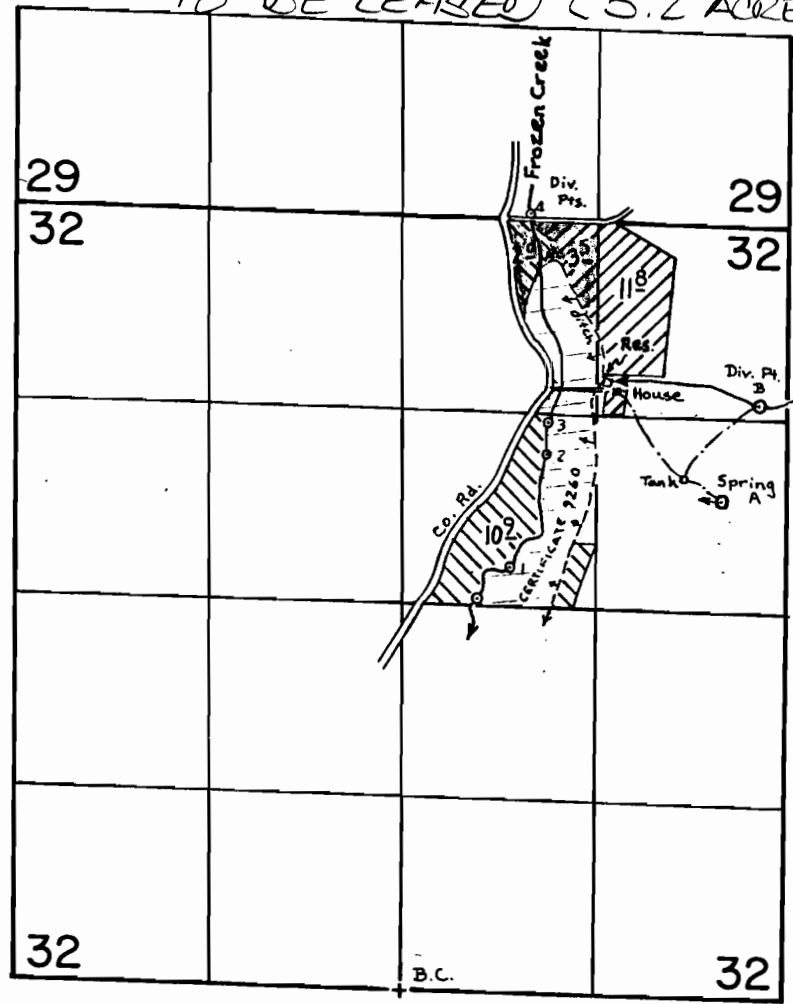

Spring & Div. Pts. Located:

- A 1980' S & 450' W
- B 1230' S & 200' W
- 4 30' N & 1770' W
- 3 1400' S & 1640' W
- 2 1600' S & 1650' W
- 1 2400' S & 1900' W

Res. 1100' S & 1250' W

all from the NE corner of Section 32

SCALE: 4" = 1 mile

FINAL PROOF SURVEY
UNDER

R-55405 R-6616
Application No. 55406 Permit No. 41808
IN NAME OF
DUANE SMITH

Surveyed March 2, 1979, by S. Donaldson...

RECEIVED
FEB 10 2005
WATER RESOURCES DEPT
SALEM, OREGON