

COBU MAP 0407

EAGLE CREST DESTINATION RESORT


WATER RIGHTS MAP
FINAL PROOF SURVEY
JUNE, 2004

(UPDATED JULY, 2008)

LOCATED WITHIN TOWNSHIP 15 SOUTH, RANGE 12 EAST, W.M.




SCALE

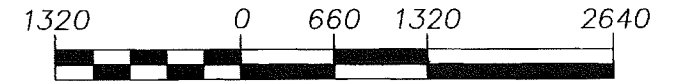

(FEET)
1 INCH = 1320 FT

NOTE: THIS MAP WAS PREPARED FOR THE PURPOSE OF IDENTIFYING THE LOCATION OF WATER RIGHTS. THIS MAP IS NOT INTENDED TO PROVIDE DIMENSIONS OR THE LOCATION OF PROPERTY OWNERSHIP LINES.

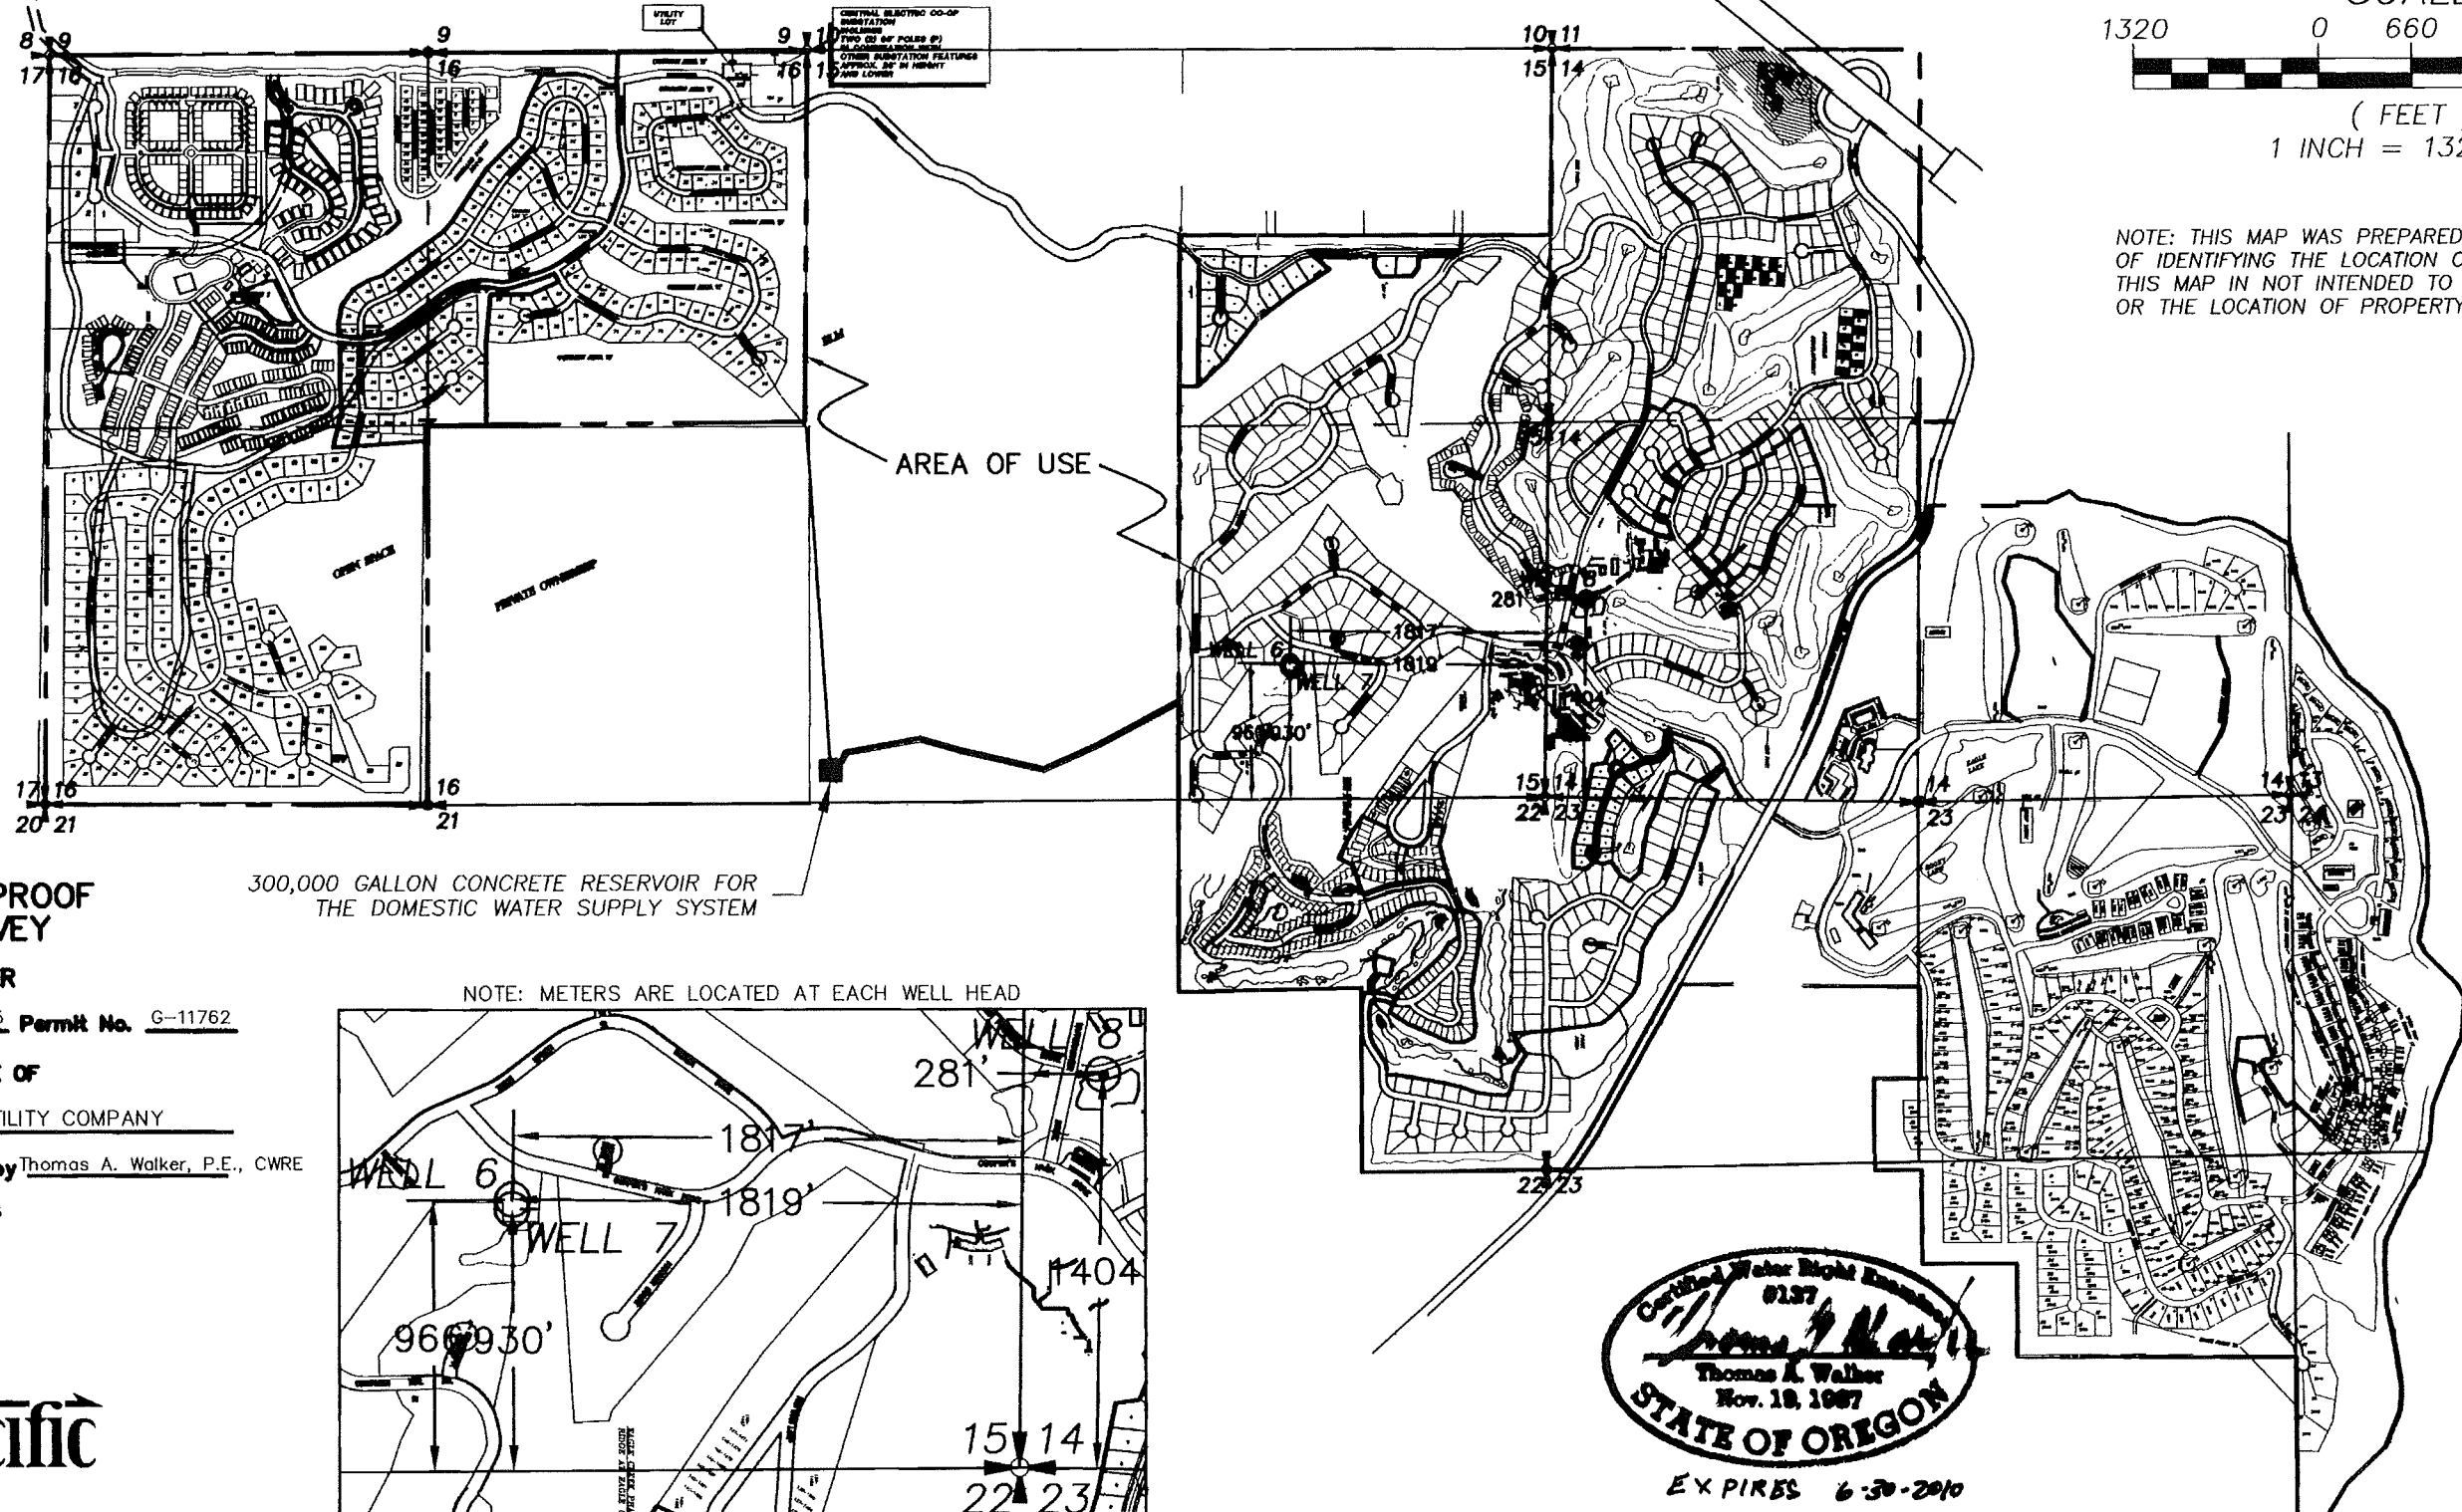

RECORDED
AUG 2 - 2008
WATER RIGHTS DIVISION
SALES DIVISION

FINAL PROOF SURVEY

UNDER

Application No. G-12905 Permit No. G-11762

IN NAME OF

CLINE BUTTE UTILITY COMPANY


Surveyed JUNE, 2004, by Thomas A. Walker, P.E., CWRE

UPDATED JULY 14, 2008


7/14/2008
EC04FPS.DWG

WHPacific

920 SW Emkay Dr
Bend, OR 97702
541-388-4265 Fax 541-388-4229
www.whpacific.com

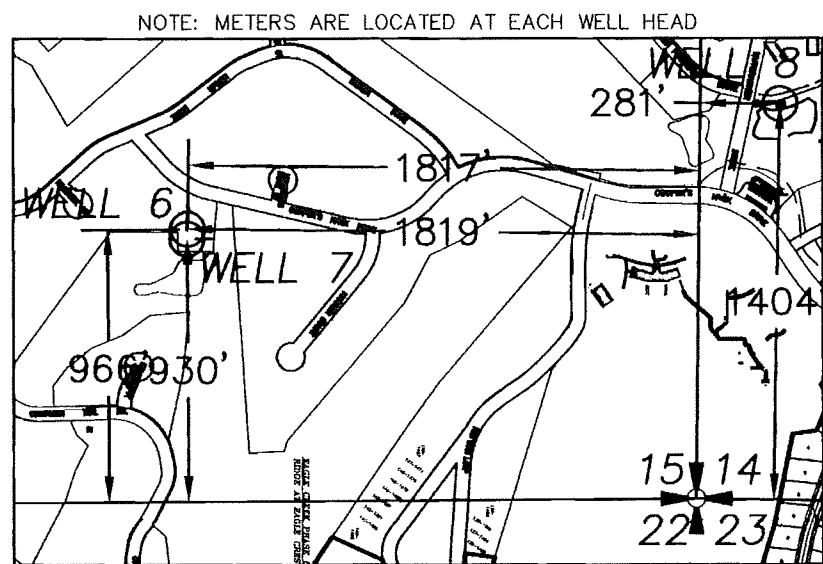


DETAIL

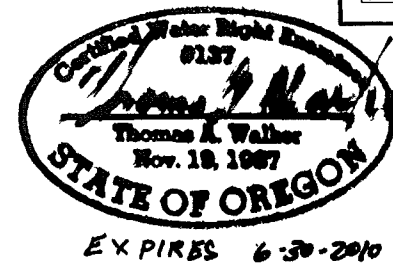

CLINE BUTTE UTILITY COMPANY

CLAIM OF BENEFICIAL USE MAP
TRANSFER APPLICATION T-10929
JULY, 2010

LOCATED WITHIN TOWNSHIP 15 SOUTH, RANGE 12 EAST, W.M.

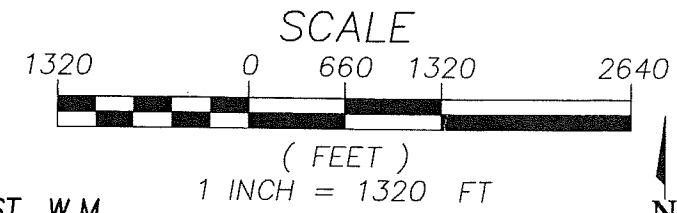

LEGEND


- EXISTING WELL LOCATION
- AREA OF USE




NOTE: THIS MAP WAS PREPARED FOR THE PURPOSE OF IDENTIFYING THE LOCATION OF WATER RIGHTS. THIS MAP IS NOT INTENDED TO PROVIDE DIMENSIONS OR THE LOCATION OF PROPERTY OWNERSHIP LINES.

- NOTES:
1. METERS ARE LOCATED AT EACH WELL HEAD
 2. 8", 10", OR 12" MAINS ARE GENERALLY LOCATED IN THE STREETS TO SERVE INDIVIDUAL LOTS AND OPEN SPACE TRACTS.
 3. GOLF COURSE IRRIGATION MAINS ARE GENERALLY LOCATED IN THE FAIRWAYS

0529
AUG 5 - 5 00W
01064-2010

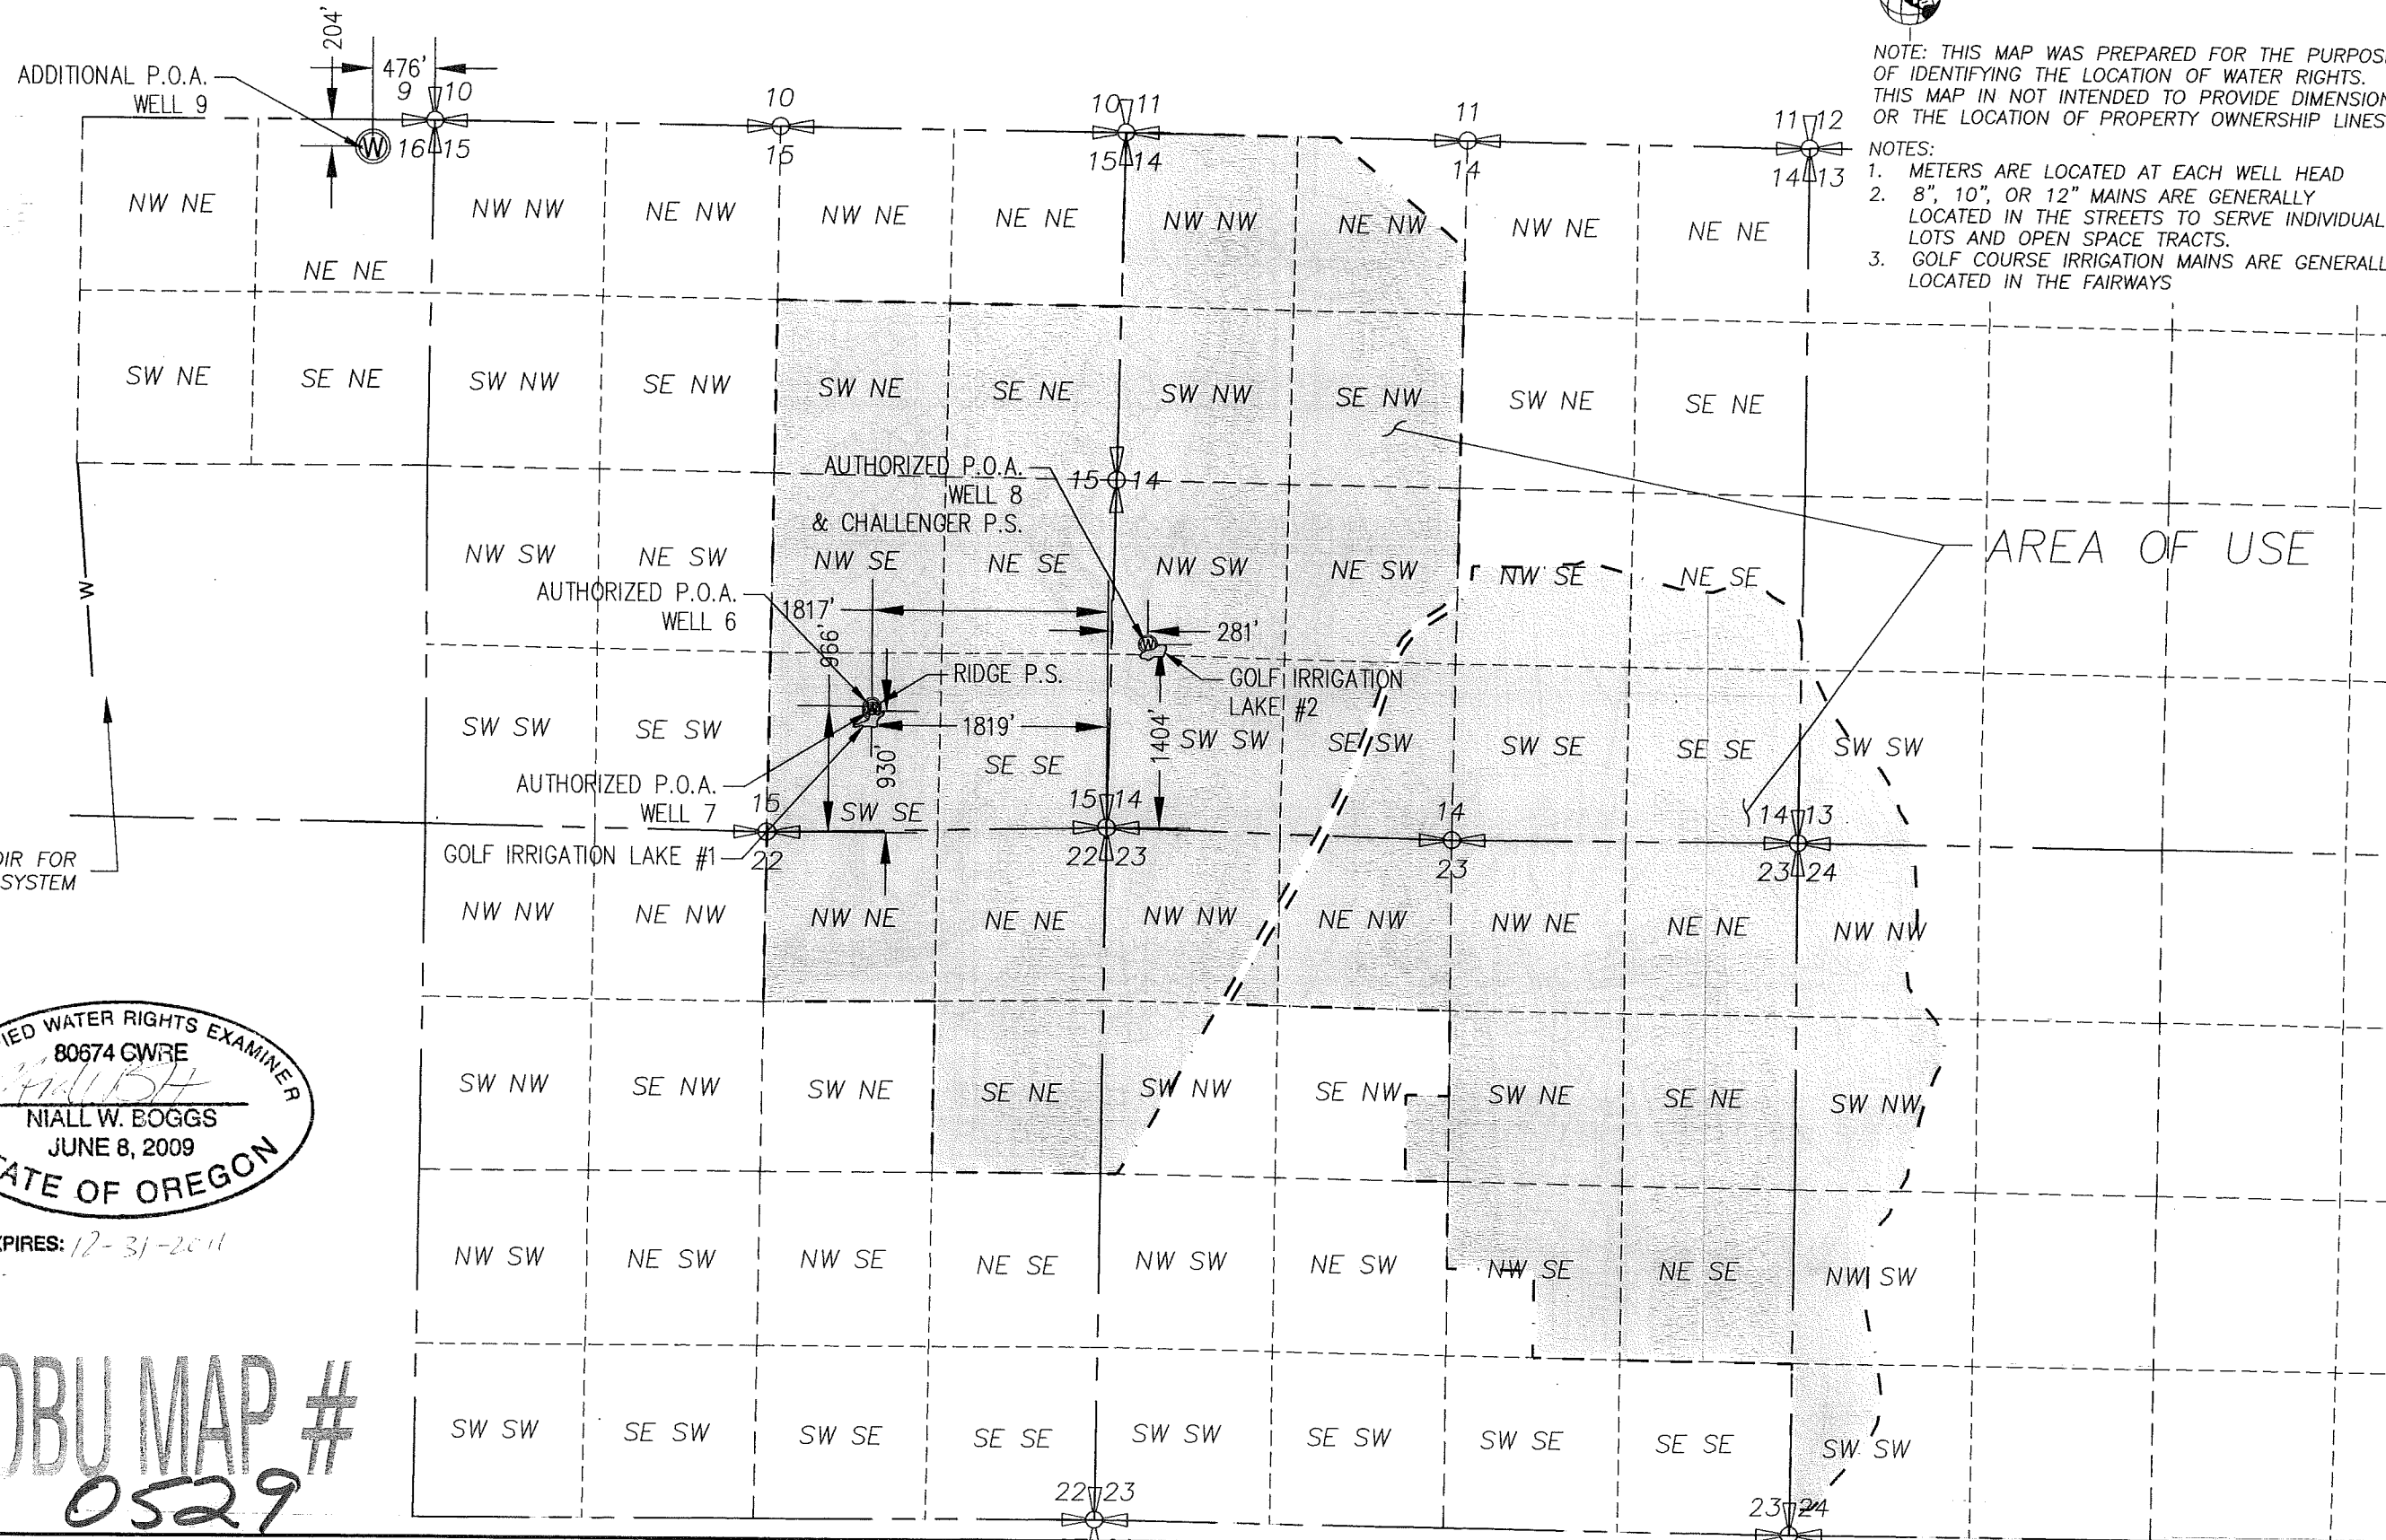

300,000 GALLON CONCRETE RESERVOIR FOR THE DOMESTIC WATER SUPPLY SYSTEM

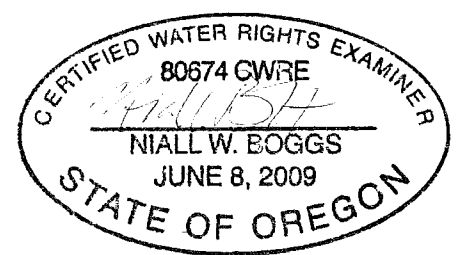

EXPIRES: 12-31-2011

WHPacific COBU MAP # 0529
123 SW Columbia Street
Bend, OR 97702
541-388-4255 Fax 541-388-4229
www.whpacific.com