

WATER RIGHTS PROOF MAP

for T-9599


IN NAME OF

PORT OF MORROW/WESTLAND ENTERPRISES, LLC

Morrow County

Scale 1" = 1320 Ft.

TOWNSHIP 4 NORTH, RANGE 25, EAST W.M.

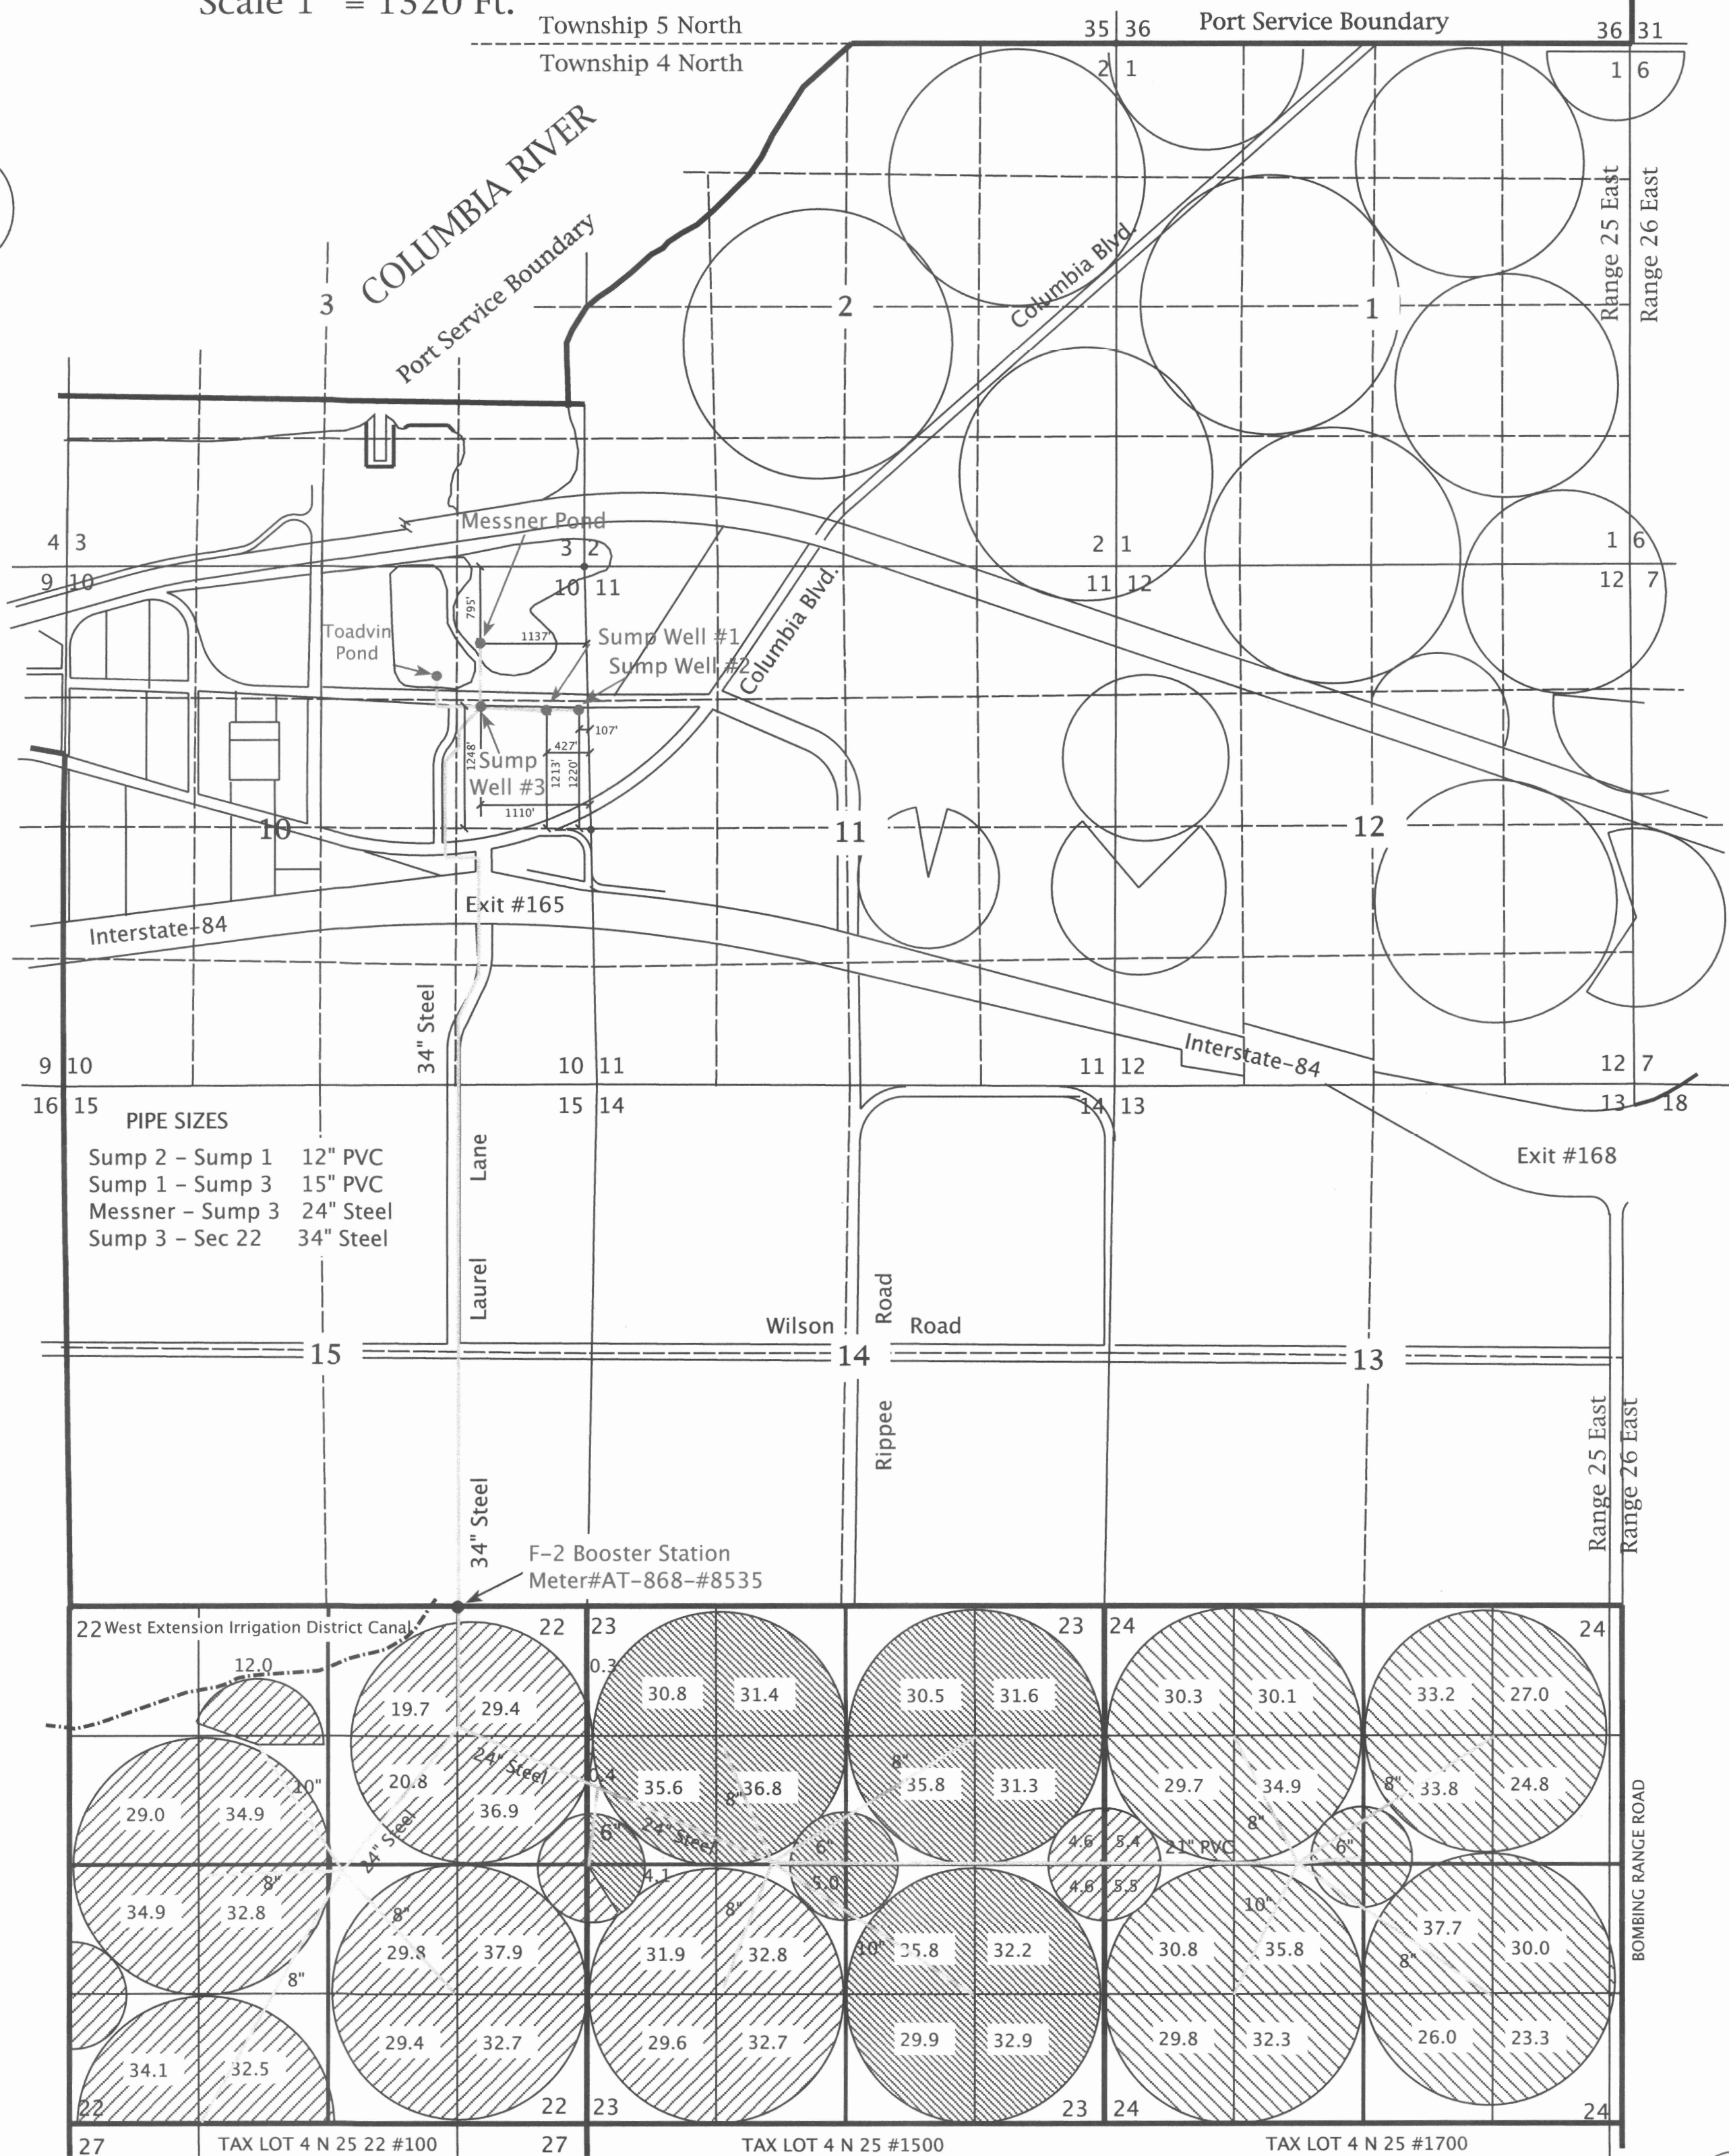

PIPE SIZES

Sump 2 - Sump 1	12" PVC
Sump 1 - Sump 3	15" PVC
Messner - Sump 3	24" Steel
Sump 3 - Sec 22	34" Steel

COBU MAP # 0550

- WATER RIGHTS FOUND IN THIS LOCATIONS for Permit #G-6876/S-43606 (594.6 Acres)
- WATER RIGHTS FOUND IN THIS LOCATIONS for Permit #G-10550 (489.5 Acres)
- WATER RIGHTS FOUND IN THIS LOCATIONS for Permit #35694 (403.2 Acres)


AUTHORIZED POA'S/POD

Sump Well #1 - 1213' N. & 427' W of East 1/4 Cor. Section 10, Lat. 45°50'45.36138" N, Lon. 119°39'59.47975" W - W/Meter AT-868-#7521
 Sump Well #2 - 1220' N. & 107' W of East 1/4 Cor. Section 10, Lat. 45°50'45.45505" N, Lon. 119°39'54.96093" W - W/Meter #95-02096-10
 Sump Well #3 - 1248' N. & 1110' W of East 1/4 Cor. Section 10, Lat. 45°50'45.67019" N, Lon. 119°40'09.13900" W - Meter @ F-2 Booster Station
 Messner Pond POD - 795' S. & 1137' W of Northeast Cor. Section 10, Lat. 45°50'51.73571" N, Lon. 119°40'09.68938" W W/Approved Fish Screen

THIS MAP IS FOR THE PURPOSE OF IDENTIFYING THE LOCATION OF WATER RIGHTS ONLY AND IS NOT INTENDED TO PROVIDE THE LEGAL DIMENSIONS OR LOCATIONS OF PROPERTY OWNERSHIP LINES.

Rev. 09-21-10

ENGINEERING - LAND SURVEYING - WATER RIGHTS
R. V. MCKINNIS ENGINEERING
 79980 Prindle Loop Road
 Hermiston, Oregon 97838
 (541) -567-2017

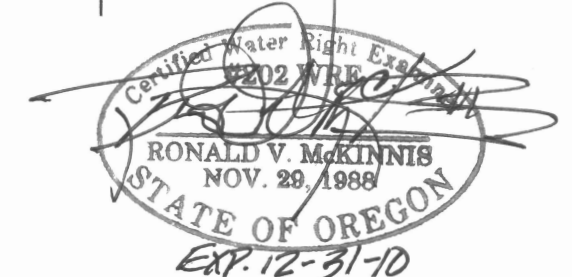

OCT 14 2010