

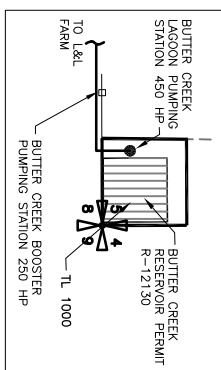


# L & L FARMS DELIVERY SYSTEM

## MAP T. 2N & 3N. R. 28E.W.M.

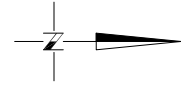

P.O.D. LOCATED 440'N AND 1170'W FROM THE SE CORNER SEC 5

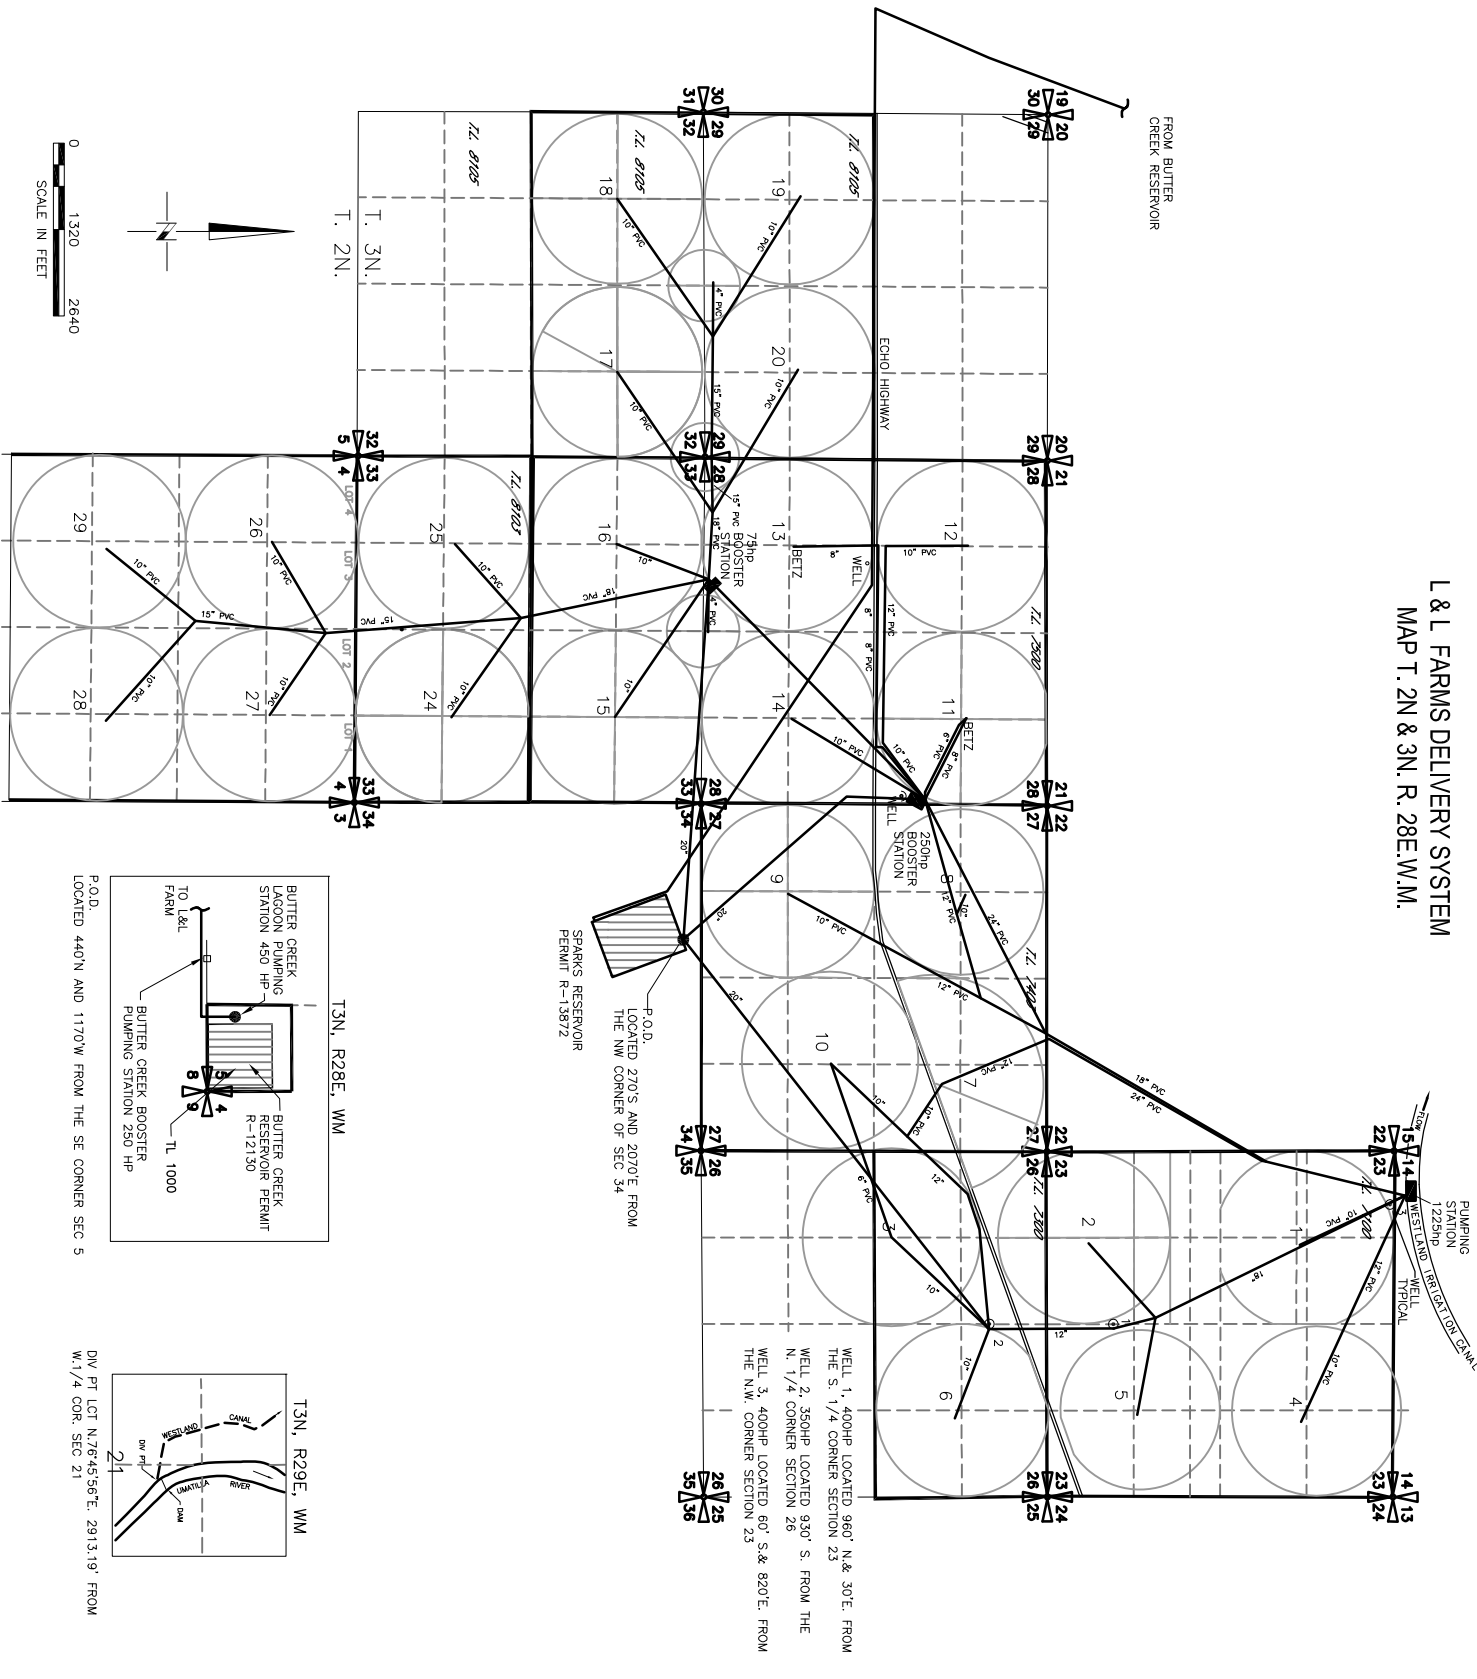

D.V. PT. LOC. N. 76°45'56"E 2913.19' FROM W. 1/4 COR. SEC 21

WELL 1, 400HP LOCATED 960' N. & 30'E. FROM THE S. 1/4 CORNER SECTION 23  
WELL 2, 350HP LOCATED 930' S. FROM THE N. 1/4 CORNER SECTION 26  
WELL 3, 400HP LOCATED 60' S. & 820'E. FROM THE N.W. CORNER SECTION 23

P.O.D. LOCATED 270'S. AND 2070'E. FROM THE NW CORNER OF SEC 34  
SPARKS RESERVOIR PERMIT R-13872

PUMPING STATION 1225HP  
