


T. 2S., R. 26E., W.M.

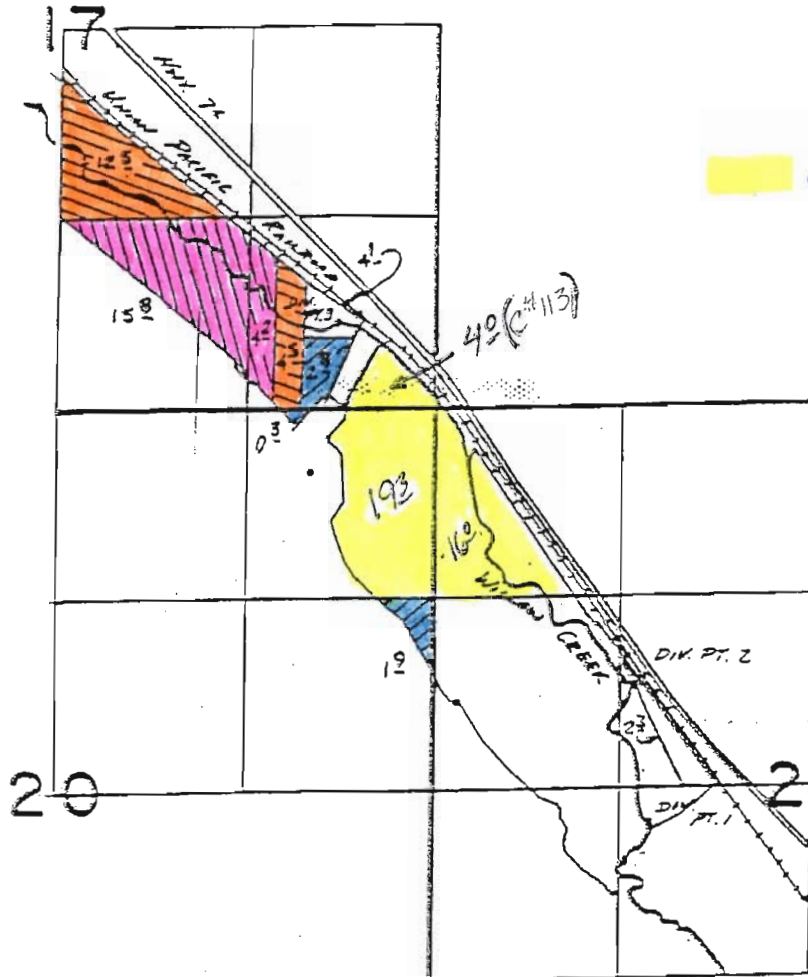




CERT. #113

DIX PT. 1 240'S & 1120'W FROM CENTER SEC. 21
 DIX PT. 2 1920'S & 1420'E FROM NW COR. SEC. 21
 DIX PT. 3 600'N. & 630'W. FROM SE COR. SEC. 17

CERTIFICATE #

FINAL PROOF SURVEY
UNDER

TRANSFER 3207

-  1891 (52224)
-  1884 (52223)
-  1889 (52224)

IN NAME OF

MRS. ANNA GRAHAM

Surveyed Oct. 11, 1982, by V.L. Cooney

1029

WORK COPY

PLACE OF USE PER CERTIFICATE # AND ACTUAL USE

C 113

- SE SE SEC 17 - 4.0 AC
- NE NE SEC 20 - 19 AC
- NW NW SEC 21 - 16 AC

C 52223

- SW SE SEC 17 - 15.8 AC
- SE SE SEC 17 - 4.2 AC
- SW NW SEC 21 - 32.0 AC
- SE NW SEC 21 - 4.5 AC
- NE SW SEC 21 - 4.0 AC
- NW SW SEC 21 - 3.0 AC

C 52224

- NW SE SEC 17 - 12.5 AC
- SE SE SEC 17 - 7.3 AC
- NE NE SEC 20 - 0.3 AC
- SE NE SEC 20 - 1.9 AC



ADDITIONAL POINT OF DIVERSION

FOR

BERNARD & JEAN DAMON
 2315 ROCKY LANE
 EUGENE, OR, 97401
 541-686-2590

BY

H. TIMOTHY FASSBENDER, PLS, CWRE
 28796 SARAH LANE
 EUGENE, OR 97408
 541-485-3136

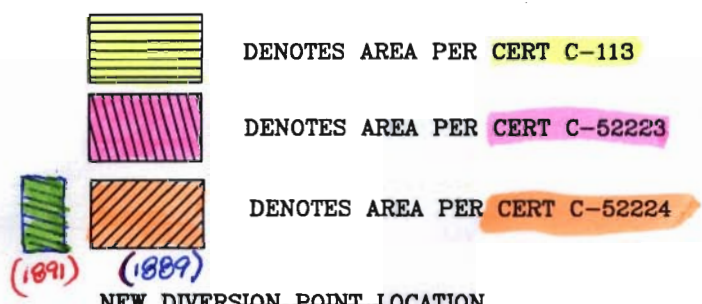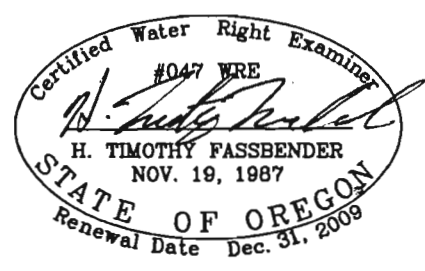

SCALE
 1" = 1320'

NEW DIVERSION POINT LOCATION
 1215 FEET SOUTH & 815 FEET EAST
 FROM THE NW CORNER OF SECTION 21


EXISTING DIVERSION POINT LOCATION

- POD #1 240 FEET SOUTH & 1120 FEET WEST OF CENTER OF SECTION 21
- POD #2 1950 FEET SOUTH & 1490 FEET WEST EAST FROM THE SE CORNER OF SEC. 17
- POD #3 600 FEET NORTH & 680 FEET WEST OF THE SW CORNER OF THE SE CORNER SEC. 17

NOTE:

THIS MAP IS NOT INTENDED TO PROVIDE LEGAL DIMENSIONS OR LOCATION OF OWNERSHIP LINES.

TOWNSHIP 2 SOUTH, RANGE 26 EAST, W.M.

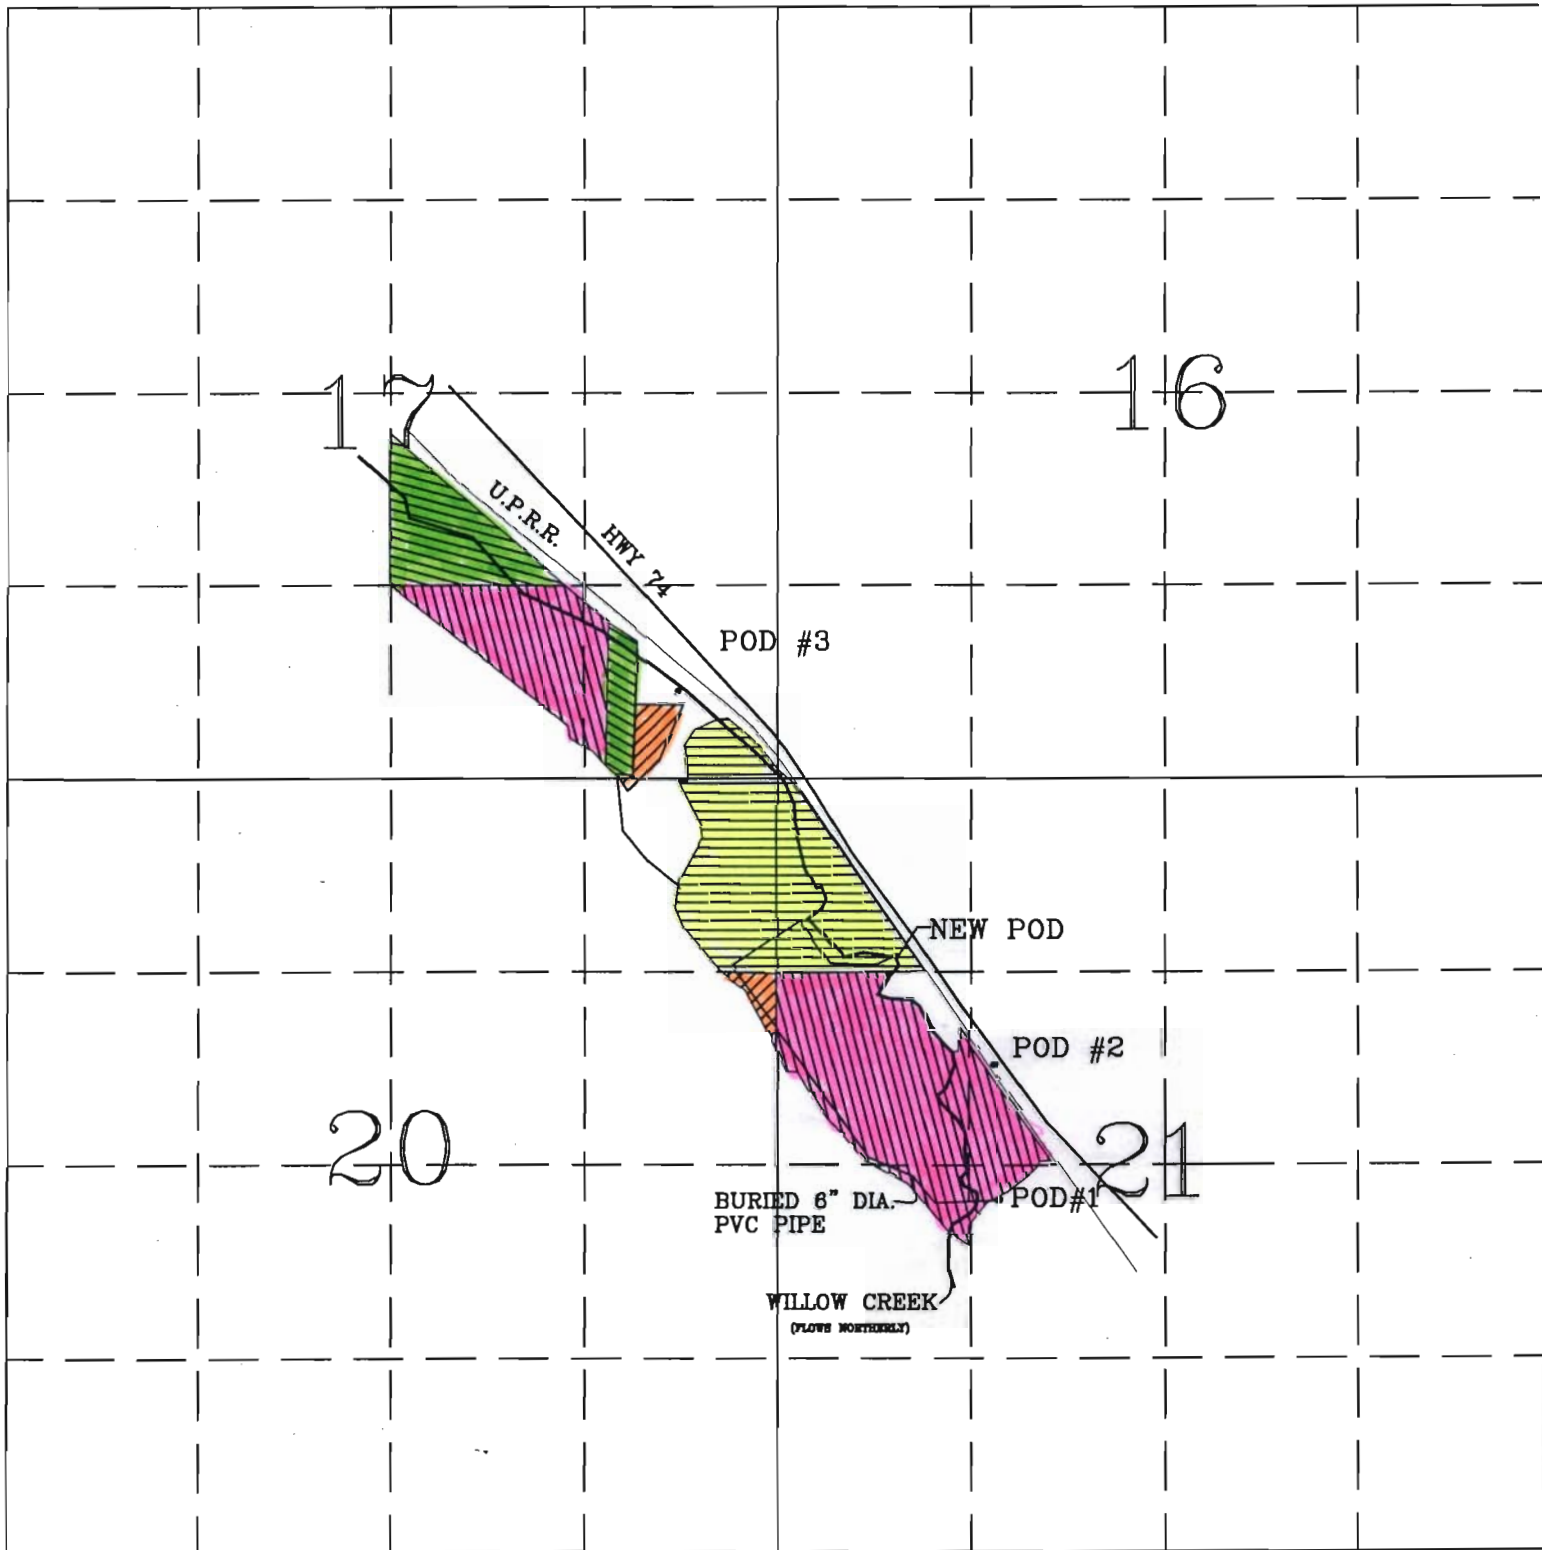

AFFECTED PROPERTY WITHIN TAX LOT 2200, TAX MAP NO. 2S 26E

EXISTING SURFACE WATER RIGHT PER PERMITS C-113, C-52223 & C-52224