

MAR... 1260

WELL "A"

RECEIVED

NOTICE TO WATER WELL CONTRACTOR

The original and first copy of this report are to be filed with the

JUL 20 1967 WATER WELL REPORT

State Well No. 4/2w-22k

STATE ENGINEER, SALEM, OREGON within 30 days from the date of well completion.

STATE ENGINEER SALEM, OREGON (Please type or print) GR-2514

State Permit No.

(1) OWNER:

Name A. D. Spada Farms, Inc. Address Rt 1 Box 378 Woodburn, OR 97149 8439 NE Columbia Portland Ore 97220

(2) LOCATION OF WELL:

County Marion Driller's well number 22 1/4 Section 22 T. 4S R. 2W W.M. Bearing and distance from section or subdivision corner

Originally drilled for Herb Kelsa

(3) TYPE OF WORK (check):

New Well [] Deepening [] Reconditioning [x] Abandon [] If abandonment, describe material and procedure in Item 12.

(4) PROPOSED USE (check):

Domestic [] Industrial [] Municipal [] Irrigation [x] Test Well [] Other [] Rotary [] Driven [] Cable [] Jetted [] Dug [] Bored []

(5) TYPE OF WELL:

(6) CASING INSTALLED:

12" Diam. from 0 ft. to 186'-10" ft. Gage 250 16" Diam. from 186'-10" ft. to 187'-10" ft. Gage 375

(7) PERFORATIONS:

Perforated? [x] Yes [] No Type of perforator used Size of perforations in. by in. 7/32 perforations from 186'-10" ft. to 187'-10" ft.

(8) SCREENS:

Well screen installed? [] Yes [x] No Manufacturer's Name Model No. Diam. Slot size Set from ft. to ft.

(9) CONSTRUCTION:

Well seal—Material used in seal none Depth of seal ft. Was a packer used? Diameter of well bore to bottom of seal in. Were any loose strata cemented off? [] Yes [x] No Depth Was a drive shoe used? [] Yes [x] No Was well gravel packed? [x] Yes [] No Size of gravel: 78-3/4 Gravel placed from ft. to ft. Did any strata contain unusable water? [] Yes [] No Type of water? depth of strata Method of sealing strata off 11257

(10) WATER LEVELS:

Static level 30' ft. below land surface Date 4-1-67 Artesian pressure lbs. per square inch Date

(11) WELL TESTS:

Drawdown is amount water level is lowered below static level. Was a pump test made? [x] Yes [] No If yes, by whom Driller Yield: 1870 gal./min. with 94 ft. drawdown after 8 hrs.

(12) WELL LOG:

Diameter of well below casing 0 Depth drilled 186 ft. Depth of completed well 186 ft. Formation: Describe by color, character, size of material and structure, and show thickness of aquifers and the kind and nature of the material in each stratum penetrated, with at least one entry for each change of formation.

Table with columns MATERIAL, FROM, TO. Entries: Well was 18" diameter, gravel 128 to 145, gravel & sand 145-148, Clay & sand layers 148-181, Blue Clay 181-186

Se-attached copy of original well RECEIVED

JUN 01 2011

WATER RESOURCES DEPT SALEM, OREGON

Work started 5-2-67 Completed 7-3-67 Date well drilling machine moved off of well 7-3-67 19

(13) PUMP:

Manufacturer's Name Foyne & Bowler Type: Justice H.P. 52

Water Well Contractor's Certification:

This well was drilled under my jurisdiction and this report is true to the best of my knowledge and belief.

NAME Mitch Schneider (Person, firm or corporation) Address 1309 97th St. SE, Salem, Ore.

Drilling Machine Operator's License No. 212

[Signed] Mitch Schneider (Water Well Contractor)

Contractor's License No. 387 Date 7-3-67, 19

John T. (Pink) Miller

DRILLING CONTRACTOR

4/26-22K
Marion

Well drilled for Herb and Louise Kelso by J T Miller, Aurora, Oregon
Rte 1 Box 378
Woodburn, Oregon

January 10, 1955

- 0- 3 Surface
- 3- 20 Yellow clay
- 20- 60 Broken sand & clay, little water
- 60- 63 Blue clay
- 63- 79 Red clay
- 79- 80 Soft blue clay
- 80-106 Red sand & soft muddy clay
- 106-108 Clean blue clay
- 108-118 Grey clay bottom 3 ft. very soft
- 118-123 Red sand some small gravel
- 123-124 Green clay, drove pipe to 115 and tested well
cleaned up @ 300 gpm, pulled pump and deepened
- 124-129 Green clay
- 129-130 Blue clay tough and clean
- 130-135 Fine black sand
- 135-139 Soft grey clay
- 139-145 Broken sand and clay, drove 18 inch pipe to 129 ft
Filled hole with gravel from 145 to 129 ft 6 in
Used 1 1/2 yards of gravel. Pumped well, cleaned up @ 380 gpm
Pulled pump and perforated 18 inch pipe at 114 to 115 ft with 45 holes
Ran pump back in well cleaned up @ 680 gpm
Static water level 30 ft
500 gpm drawdown at 72 ft
600 gpm drawdown at 85 ft
680 gpm drawdown at 115 ft
Recommend setting pump at 95 ft. Be sure to install valve on discharge
line at pump, hold pump down to 500 gpm at all times.

FORN
JUL 20 1955
TE EM
EM. G.

1966 well pump approx 200 gpm from 90'

RECEIVED

JUN 01 2011

WATER RESOURCES DEPT.
SALEM, OREGON

STATE ENGINEER
Salem, Oregon

1261
MAR 1955

Well Record

STATE WELL NO. 4/2W-22K
COUNTY MARION
APPLICATION NO. GR-2514

OWNER: Herb Kelson


MAILING ADDRESS: Rt 1, Box 378

LOCATION OF WELL: Owner's No.

CITY AND STATE: Woodburn, Oregon

NW 1/4 NE 1/4 Sec. 22 T. 4 S., R. 2 W., W.M.

Bearing and distance from section or subdivision corner 1660' W & 1050' S from NE corner Section 22

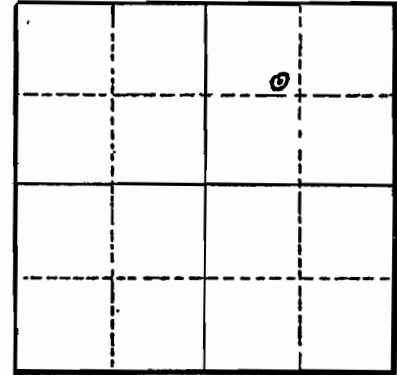

Section 22

Altitude at well

TYPE OF WELL: Drilled Date Constructed 1955

Depth drilled 145' Depth cased 145'

CASING RECORD:

18-inch

FINISH:

45 holes perforated 114' to 115'
Gravel Pac: 129 1/2' to 145'

AQUIFERS:

WATER LEVEL:

30'

PUMPING EQUIPMENT: Type Multi-Stage Turbine H.P. 40
Capacity 800 G.P.M.

WELL TESTS:

Drawdown 60 ft. after hours 600 G.P.M.
Drawdown 85 ft. after hours 680 G.P.M.

USE OF WATER Irrigation Temp. °F., 19

SOURCE OF INFORMATION GR-3833

DRILLER or DIGGER J. T. Miller

ADDITIONAL DATA:

Log Water Level Measurements Chemical Analysis Aquifer Test

REMARKS:

RECEIVED

JUN 01 2011

WATER RESOURCES DEPT
SALEM, OREGON

T 11257

PRACTICE TO WATER WELL CONTRACTOR
 The original and first copy of this report
 are to be filed with the
WATER RESOURCES DEPARTMENT,
 SALEM, OREGON 97310
 within 30 days from the date
 of well completion.

WATER WELL REPORT

STATE OF OREGON

(Please type or print)

(Do not write above this line)

WELL "B"

State Well No. 45/2w-22ad

State Permit No. _____

1254
 MARI.

(1) OWNER:

Name A & R Spada Farms
 Address 7251 St. Paul Hwy NE
St. Paul, Oregon 97137

(2) TYPE OF WORK (check):

New Well Deepening Reconditioning Abandon

If abandonment, describe material and procedure in Item 12.

(3) TYPE OF WELL:

Rotary Cable Driven Jetted Bored

(4) PROPOSED USE (check):

Domestic Industrial Municipal Irrigation Test Well Other

(5) CASING INSTALLED:

Threaded Welded

See Diam. from Sheet ft. to Attached Gage
 " Diam. from _____ ft. to _____ ft. Gage
 " Diam. from _____ ft. to _____ ft. Gage

(6) PERFORATIONS:

Perforated? Yes No.

Type of perforator used Mill cut
 Size of perforations 3/8 in. by 2 1/2 in.
272 perforations from 133'11" ft. to 150'11" ft.
552 perforations from 170'11" ft. to 207'5" ft.
 _____ perforations from _____ ft. to _____ ft.

(7) SCREENS:

Well screen installed? Yes No

Manufacturer's Name _____ Type _____ Model No. _____
 Diam. _____ Slot size _____ Set from _____ ft. to _____ ft.
 Diam. _____ Slot size _____ Set from _____ ft. to _____ ft.

(8) WELL TESTS:

Drawdown is amount water level is lowered below static level

Was a pump test made? Yes No If yes, by whom? SEI
 1: 630 gal./min. with 33 ft. drawdown after 8 hrs.
 " 355 " " 13 " " 8 1/2 "
 " 230 " " 6 " " 9 "
 Baller test gal./min. with ft. drawdown after hrs.
 _____ slant flow _____ g.p.m.
 Temperature of water _____ Depth artesian flow encountered _____ ft.

(9) CONSTRUCTION:

Well seal—Material used 6 yds of # 5 sk readi-mix
 Well sealed from land surface to 25 ft.
 Diameter of well bore to bottom of seal 24 in.
 Diameter of well bore below seal 18 in.
 Number of sacks of cement used in well seal 30 sacks
 How was cement grout placed? See attached Dept. of Water Resources letter regarding special standard
 Was a drive shoe used? Yes No Plug _____ Size: location _____ ft.
 Did any strata contain unusable water? Yes No
 Type of water? _____ depth of strata 11257
 Method of sealing strata off _____
 Was well gravel packed? Yes No Size of gravel: 3/4 minus
 Gravel placed from 25 ft. to bottom ft.

(10) LOCATION OF WELL:

County Marion Driller's well number 7910
SE 1/4 NE 1/4 Section 22 T. 4S R. 2W W.M.
 Bearing and distance from section or subdivision corner _____

(11) WATER LEVEL: Completed well.

Depth at which water was first found 6A ft.
 Static level 45 ft. below land surface. Date 9-19-79
 Artesian pressure _____ lbs. per square inch. Date _____

(12) WELL LOG:

Diameter of well below casing _____ ft.
 Depth drilled 235 ft. Depth of completed well 212 ft.

Formation: Describe color, texture, grain size and structure of materials; and show thickness and nature of each stratum and aquifer penetrated, with at least one entry for each change of formation. Report each change in position of Static Water Level and indicate principal water-bearing strata.

MATERIAL	From	To	SWL
See Sheet Attached			
RECEIVED			
JUN 01 2011			
WATER RESOURCES DEPT SALEM, OREGON			
RECEIVED			
MAY 11 1980			
WATER RESOURCES DEPT SALEM, OREGON			

Work started 8-14 19 79 Completed 11-29 19 79
 Date well drilling machine moved off of well 11-29 19 79

Drilling Machine Operator's Certification:

This well was constructed under my direct supervision. Materials used and information reported above are true to my best knowledge and belief.

[Signed] Donald G. Davis Date 12-18, 19 79
 (Drilling Machine Operator)

Drilling Machine Operator's License No. 1085

Water Well Contractor's Certification:

This well was drilled under my jurisdiction and this report is true to the best of my knowledge and belief.

Name Schneider Equipment, Inc.
 (Person, firm or corporation) (Type or print)
 Address 2781 River Rd NE St. Paul, Or 9713

[Signed] Stephen J. Schneider
 (Water Well Contractor)

Contractor's License No. 649 Date 12-18, 19 79

(12)

Material	From	To
Top soil	0	6
Clay, brown silty	6	47
Clay, light brown soft	47	68
Sand, black fine	68	72
Sand, black fine-medium	72	76
Gravel w/ clay, gray up to 3/4"	76	77
Clay, gray medium	77	82
Clay, dark gray, fine sandy	82	89
Sand, fine black	89	92
Sand, medium-coarse black	92	95
Clay, hard gray	95	98
Gravel up to 3/4 w/ clay, green	98	99
Clay, gray	99	103
Clay, brownish green dry	103	107
Clay, green fine sandy	107	111
Clay, greenish-gray	111	114
Clay, gray fine sandy	114	118
Sand, fine-medium, black	118	119
Sand, cemented fine-medium w/ wood	119	121
Clay, gray	121	123
Clay, green, medium hard	123	127
Clay, green, fine sandy w/ wood	127	132
Pea gravel w/ some clay	132	133
Gravel pea size to 3/4"	133	139
Gravel pea size up to 1" w/ wood	139	141
Clay, greenish gray	141	147
Clay, blue gray	147	154
Clay, blue gray fine sandy	154	162
Clay, dark gray, medium sandy w/ wood	162	164
Clay, dark greenish gray, hard fine sandy dry	164	171
Gravel w/ some clay	171	174
Sand, black medium-coarse w/ some gravel	174	182
Clay, green medium hard	182	189
Clay, green medium sandy	189	193
Sand, black fine-medium	193	197
Gravel, pea up to 1"	197	198
Clay, green medium sandy	198	202
Clay, gray fine sandy w/ some wood	202	207
Sand, black fine	207	211
Clay, green & gray, hard	211	214
Clay, green hard	214	218
Clay, blue gray w/ wood	218	223
Clay, blue green, sandy	223	232
Clay, gray, sandy	232	235

(5) Casing Installed


8" diam. from +2'8" to 133'1"	Gage.250
8" diam. from 133'1" to 150'11"	Gage.330
8" diam from 150'11" to 170'11"	Gage.250
8" diam from 170'11" to 207'5"	Gage.330
8" diam from 207'5" to 232'5"	Gage.250
4" diam from +1' to 26'6"	Gage.237

RECEIVED
 JUN 4 1980
 WATER RESOURCES DEPT
 SALEM, OREGON

RECEIVED

JUN 01 2011

WATER RESOURCES DEPT
 SALEM, OREGON

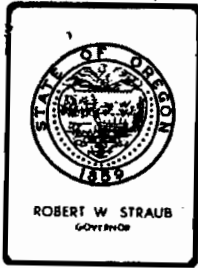

Water Resources Department
MILL CREEK OFFICE PARK

555 13th STREET N.E., SALEM, OREGON 97310

PHONE 378-8455

May 24, 1978

RECEIVED

MAR 4 1980

WATER RESOURCES DEPT
SALEM, OREGON

Milo Schneider
Schneider Equipment, Inc.
21881 River Road N.E.
St. Paul, Oregon 97137

Dear Mr. Schneider:

Please accept my apologies for the delay in responding to your recent letter requesting special standards for the use of concrete instead of cement grout as a sealing material in large diameter wells that provide excessive space between the drill hole wall and the outside casing of the well. You are hereby granted special permission to use concrete instead of neat cement with the following provisions and conditions:

- 1) Concrete shall consist of clean, hard, durable aggregate, and not less than five sacks of Portland cement per cubic yard of concrete. Maximum diameter of the aggregate shall not exceed 3/4 of an inch in diameter.
- 2) If the well bore hole to be sealed is not dry, concrete shall be pumped from the bottom of the seal zone upward in one continuous operation to land surface.
- 3) In the event that the well bore annular space to be sealed is dry, concrete shall be placed through a tremie pipe to prevent segregation of the aggregate and cement mixture and to prevent bridging.
- 4) The space between the sealing surfaces of all casings and between all casings and the bore hole shall exceed 3-inches or more.

Special standards to construct a well as described above shall be considered to apply to all wells constructed in such a manner. Please refer to these special standards on the well reports of all well constructed in this manner.

Sincerely,

RECEIVED

JUN 01 2011

WILLIAM B. MCCALL
Hydrogeologist
WATER RESOURCES DEPT
SALEM, OREGON

WBM:clh

cc: Clifton R. King, Watermaster, District #16

T 11257

STATE OF OREGON
WATER WELL REPORT
 (as required by ORS 537.765)

MARI 1258

RECEIVED

WELL C

4/24/22 ad

MAR 23 1989

(START CARD) # 7001

(1) OWNER:
 Name A & R Spada Nursery Well Number: WATER RESOURCES
 Address 7251 St. Paul Hwy NE SALE 4, OFFERON
 City St. Paul State OR Zip 97137

(2) TYPE OF WORK:
 New Well Deepen Recondition Abandon

(3) DRILL METHOD
 Rotary Air Rotary Mud Cable
 Other

(4) PROPOSED USE:
 Domestic Community Industrial Thermal
 Injection Other

(5) BORE HOLE CONSTRUCTION:
 Special Construction approval Yes No Depth of Completed Well 305 ft.
 Explosives used Yes No Type _____ Amount _____

HOLE			SEAL			Amount sacks or pounds
Diameter	From	To	Material	From	To	
20"	0	20	Bentonite	0	20	116 sacks
16"	20	305				

How was seal placed: Method A B C D E
 Other Granular bentonite OAR 690-210-340
 Backfill placed from _____ ft. to _____ ft. Material _____
 Gravel placed from 237 ft. to 305 ft. Size of gravel 1/2 - 3/8

(6) CASING/LINER:

Diameter	From	To	Gauge	Steel	Plastic	Welded	Threaded
Casing: 16"	+2	268'	8"	<input type="checkbox"/>	<input type="checkbox"/>	<input type="checkbox"/>	<input type="checkbox"/>
			375	<input checked="" type="checkbox"/>	<input type="checkbox"/>	<input checked="" type="checkbox"/>	<input type="checkbox"/>
Liner:				<input type="checkbox"/>	<input type="checkbox"/>	<input type="checkbox"/>	<input type="checkbox"/>

Final location of shoe(s) 268'8"

(7) PERFORATIONS/SCREENS:
 Perforations Method _____
 Screens Type 10 3/4od Material stainless

From	To	Slot size	Number	Diameter	Tele/pipe size	Casing	Liner
235	272		pipe	10"x	250	<input type="checkbox"/>	<input type="checkbox"/>
272	300	140		10"		<input type="checkbox"/>	<input type="checkbox"/>
300	305		pipe	10"x	250	<input type="checkbox"/>	<input type="checkbox"/>
305	Bottom plate & bail					<input type="checkbox"/>	<input type="checkbox"/>

(8) WELL TESTS: Minimum testing time is 1 hour
 Pump Bailer Air Flowing Artesian

Yield gal/min	Drawdown	Drill stem at	Time
630	12'		1 hr.
1025	36'		8hrs
1200	45'		10hrs

Temperature of water _____ Depth Artesian Flow Found _____
 Was a water analysis done? Yes By whom _____
 Did any strata contain water not suitable for intended use? Too little
 Salty Muddy Odor Colored Other _____
 Depth of strata: _____

(9) LOCATION OF WELL by legal description:
 Township 4S N or S, Range 2W E or W, WM.
 Section 22 SE 1/4 NE 1/4
 Tax Lot _____ Lot _____ Block _____ Subdivision _____
 Street Address of Well (or nearest address) 7251 St. Paul Hwy
St. Paul, OR

(10) STATIC WATER LEVEL:
24 ft. below land surface. Date 3/4/89
 Artesian pressure _____ lb. per square inch. Date _____

(11) WATER BEARING ZONES:
 Depth at which water was first found 91'

From	To	Estimated Flow Rate	SWL
270	300	1200	24'

(12) WELL LOG: Ground elevation _____

Material	From	To	SWL
Clay brown	1	55	
Clay grey	55	70	
Sand, silt, clay	70	82	
Clay grey	82	91	
Sand, silt black	91	98	
Clay grey	98	104	
Clay sandy brown	104	120	
Clay green sticky	120	134	
Sand, silt black	134	138	
Clay grey	138	158	
Clay sandy	158	175	
Clay green sticky	175	194	
Clay sandy	194	205	
Clay blue	205	226	
Clay sandy	226	254	
Clay grey	254	270	
Sand, silt	270	278	
Sand	278	300	
Gravel, clay	300	304	
Clay, sticky grey	304	306	

Date started 1/6/89 Completed 3/5/89

(unbonded) Water Well Constructor Certification:
 I certify that the work I performed on the construction, alteration, or abandonment of this well is in compliance with Oregon well construction standards. Materials used and information reported above are true to my best knowledge and belief.
 WWC Number _____
 Signed _____ Date _____

(bonded) Water Well Constructor Certification:
 I accept responsibility for the construction, alteration, or abandonment work performed on this well during the construction dates reported above. All work performed during this time is in compliance with Oregon well construction standards. This report is true to the best of my knowledge and belief.
 WWC Number 783
 Signed Juan Gossen Date 3/15/89

11257

WELL D

STATE OF OREGON
WATER SUPPLY WELL REPORT
(as required by ORS 537.765)

JUN 17 1999

MARI WELL I.D.# 130601
54046

WATER RESOURCES DEPT.
SALEM, OREGON

(START CARD) # 101534

Instructions for completing this report are on the last page of this form.

(1) OWNER: Well Number _____

Name A&R Spada Farms
Address 7251 St. Paul HWY NE
City St. Paul State OR Zip 97137

(2) TYPE OF WORK
 New Well Deepening Alteration (repair/recondition) Abandonment

(3) DRILL METHOD:
 Rotary Air Rotary Mud Cable Auger
 Other _____

(4) PROPOSED USE:
 Domestic Community Industrial Irrigation
 Thermal Injection Livestock Other _____

(5) BORE HOLE CONSTRUCTION:
Special Construction approval Yes No Depth of Completed Well 324 ft.
Explosives used Yes No Type _____ Amount _____

HOLE			SEAL			Sacks or pounds
Diameter	From	To	Material	From	To	
20"	0	150	cement & 5 Bentonite	0	150	118 sacks
16"	150	324				

How was seal placed: Method A B C D E
 Other _____

Backfill placed from _____ ft. to _____ ft. Material _____
Gravel placed from _____ ft. to _____ ft. Size of gravel _____

(6) CASING/LINER:

Diameter	From	To	Gauge	Steel	Plastic	Welded	Threaded
Casing: 16"	+2	166	37.5	<input checked="" type="checkbox"/>	<input type="checkbox"/>	<input checked="" type="checkbox"/>	<input type="checkbox"/>
Liner:				<input type="checkbox"/>	<input type="checkbox"/>	<input type="checkbox"/>	<input type="checkbox"/>

Final location of shoe(s) 166

(7) PERFORATIONS/SCREENS:
 Perforations Method _____
 Screens Type _____ Material stainless

From	To	Slot size	Number	Diameter	Tele/pipe size	Casing	Liner
+3	166			12"	pipe	<input checked="" type="checkbox"/>	<input type="checkbox"/>
166	180	4" .080		12"	p.s.	<input type="checkbox"/>	<input type="checkbox"/>
180	191	10"		12"	pipe	<input checked="" type="checkbox"/>	<input type="checkbox"/>
191	210	1" .080		12"	p.s.	<input type="checkbox"/>	<input type="checkbox"/>
210	235	6"		12"	pipe	<input checked="" type="checkbox"/>	<input type="checkbox"/>

CONTINUED

(8) WELL TESTS: Minimum testing time is 1 hour

<input checked="" type="checkbox"/> Pump	<input type="checkbox"/> Bailer	<input type="checkbox"/> Air	<input type="checkbox"/> Flowing Artesian
Yield gal/min	Drawdown	Drill stem at	Time
1125	110.5"		1 hr.
1100	113		4hrs

Temperature of water 53 Depth Artesian Flow Found _____
Was a water analysis done? Yes By whom 01 2011

Did any strata contain water not suitable for intended use? Too little
 Salty Muddy Odor Colored Other _____
Depth of strata: _____

(9) LOCATION OF WELL by legal description:

County Marion Latitude _____ Longitude _____
Township 4S N or S Range 2W E or W. WM.
Section 22 SE 1/4 NE 1/4
Tax Lot 00100 Lot _____ Block _____ Subdivision _____
Street Address of Well (or nearest address) 7251 St. Paul HWY NE
St. Paul, OR 97137

(10) STATIC WATER LEVEL:
37 ft. below land surface. Date 4/28/99
Artesian pressure _____ lb. per square inch. Date _____

(11) WATER BEARING ZONES:
Depth at which water was first found 94

From	To	Estimated Flow Rate	SWL
94	98		18
98	104		18
113	124		18
168	183		37
186	189		37

(12) WELL LOG:
Ground Elevation _____

Material	From	To	SWL
Topsoil	0	1	
Clay brown	1	18	
Clay brown silty	18	55	
Clay brown sandy	55	58	
Sand & clay brown	58	87	
Clay brown, sandy	87	89	
Clay gray, silty	89	94	
Sand & clay gray	94	98	18
Silty sand, gravel	98	104	18
Clay green sticky	104	113	
Sand brown, gravel	113	118	18
Sand & clay gray	118	124	
Clay green sticky	124	136	
Clay green sandy	136	140	
Sand & gravel	140	141	
Clay gray/blue sticky	141	156	
Clay blue/gray silty	156	168	
Sand black	168	183	37
Clay green sticky	183	186	
Sand black & clay--Con't	186	189	37

Date started 2/12/99 Completed 5/14/99

(unbonded) Water Well Constructor Certification:
I certify that the work I performed on the construction, alteration, or abandonment of this well is in compliance with Oregon water supply well construction standards. Materials used and information reported above are true to the best of my knowledge and belief.

Signed [Signature] WWC Number 1704 Date 6/8/99

(bonded) Water Well Constructor Certification:
I accept responsibility for the construction, alteration, or abandonment work performed on this well during the construction dates reported above. All work performed during this time is in compliance with Oregon water supply well construction standards. This report is true to the best of my knowledge and belief.

Signed [Signature] WWC Number 783 Date 6/8/99

JUN 17 1999

MARI 54046 WELL I.D.# 130601

STATE OF OREGON WATER SUPPLY WELL REPORT WATER RESOURCES DEPT. SALEM, OREGON (as required by ORS 537.765)

(START CARD) # 101534

Instructions for completing this report are on the last page of this form.

(1) OWNER: Well Number Name A&R Spada Farms Address City State Zip

(2) TYPE OF WORK [] New Well [] Deepening [] Alteration (repair/recondition) [] Abandonment

(3) DRILL METHOD: [] Rotary Air [] Rotary Mud [] Cable [] Auger [] Other

(4) PROPOSED USE: [] Domestic [] Community [] Industrial [] Irrigation [] Thermal [] Injection [] Livestock [] Other

(5) BORE HOLE CONSTRUCTION: Special Construction approval [] Yes [] No Depth of Completed Well ft. Explosives used [] Yes [] No Type Amount

Table with columns: HOLE Diameter, From, To, SEAL Material, From, To, Sacks or pounds

How was seal placed: Method [] A [] B [] C [] D [] E [] Other Backfill placed from ft. to ft. Material Gravel placed from ft. to ft. Size of gravel

(6) CASING/LINER: Table with columns: Diameter, From, To, Gauge, Steel, Plastic, Welded, Threaded

Final location of shoe(s)

(7) PERFORATIONS/SCREENS: Table with columns: From, To, Slot size, Number, Diameter, Tele/pipe size, Casing, Liner

(8) WELL TESTS: Minimum testing time is 1 hour [] Pump [] Bailer [] Air [] Flowing Artesian Yield gal/min Drawdown Drill stem at Time 1 hr.

Temperature of water Depth Artesian Flow Found Was a water analysis done? [] Yes By whom Did any strata contain water not suitable for intended use? [] Too little [] Salty [] Muddy [] Odor [] Colored [] Other Depth of strata:

(9) LOCATION OF WELL by legal description: County Latitude Longitude Township N or S Range E or W. WM. Section 1/4 1/4 Tax Lot Lot Block Subdivision Street Address of Well (or nearest address) 7251 St. Paul Hwy NE St. Paul, OR 97137

(10) STATIC WATER LEVEL: ft. below land surface. Date Artesian pressure lb. per square inch. Date

(11) WATER BEARING ZONES: Table with columns: From, To, Estimated Flow Rate, SWL

(12) WELL LOG: Ground Elevation

Table with columns: Material, From, To, SWL. Includes entries like Clay gray sandy, Silty sand, clay, Sand black, Clay green sticky, Sand green, Clay green, Sand clay, Clay gray, Sand, silt, clay, Sand, Gravel, silty sand, Gravel, Clay gray sticky.

RECEIVED JUN 01 2011

Date started 2/12/99 SALEM, OREGON Completed 5/14/99

(unbonded) Water Well Constructor Certification: I certify that the work I performed on the construction, alteration, or abandonment of this well is in compliance with Oregon water supply well construction standards. Materials used and information reported above are true to the best of my knowledge and belief.

Signed [Signature] WWC Number 1704 Date 6/8/99

(bonded) Water Well Constructor Certification: I accept responsibility for the construction, alteration, or abandonment work performed on this well during the construction dates reported above. All work performed during this time is in compliance with Oregon water supply well construction standards. This report is true to the best of my knowledge and belief.

Signed [Signature] WWC Number 783 Date 6/8/99