

**FINAL PROOF SITE REPORT**  
**Claim of Beneficial Use**

Petition #: P-2006-008<sup>9</sup>  
State #: T-10278  
Transfer #: T-2006-029

Property Owner (Applicant): COID  
Current Owner:  
Property Description: 18-13-03 SW SW 01000      Acres: 5.90

Canal: COC  
Head Gate: COC-23  
Type of Use: IRRIG

- Person interviewed (if any) \_\_\_\_\_
- Method of irrigation (pump, flood, etc) Pump
- Use: crops produced Cereal crop
- Method used to calculate area irrigated GPS
- Is beneficial use achieved in areas mapped (YES or NO) Yes

**IF NO,**

- If not proved up, what measures have been completed \_\_\_\_\_

- If not irrigated as mapped, indicate changes on map \_\_\_\_\_

- What measures are now needed?

Talk with water right user \_\_\_\_\_

Follow up in \_\_\_\_\_ weeks/days

Re-visit site on \_\_\_\_\_

NOTES: Mapping changes

**RECEIVED**  
AUG 18 2011  
WATER RESOURCES DEPT  
SALEM, OREGON

Inspected by: Cary Penhallow + Allen Goodman Date: 10/08/10  
by AW


# DESCHUTES COUNTY SEC.03 T18S R13E

SCALE - 1" = 400'



SW 1/4 OF THE SW 1/4


OWRD TRANSFER #: T-10278

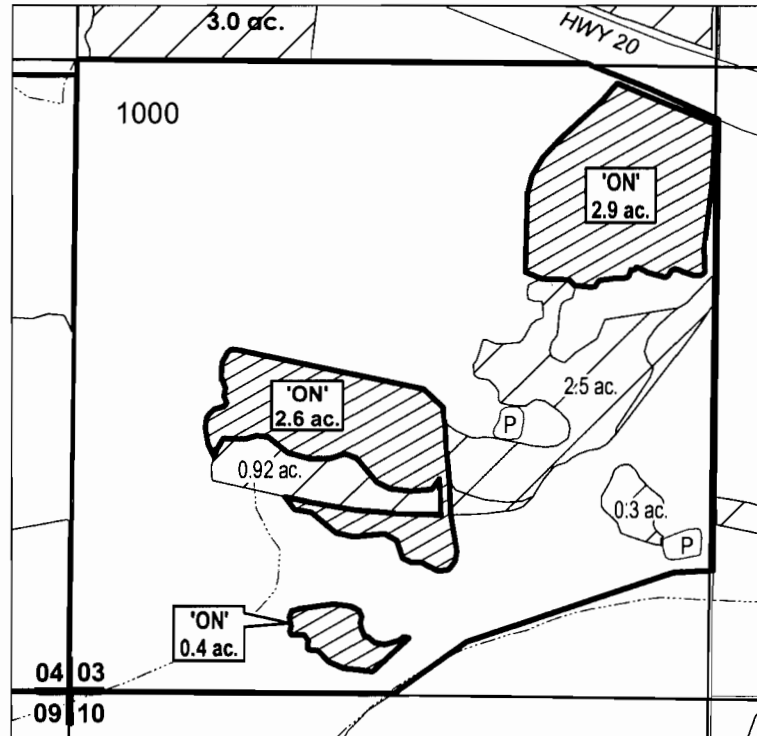

**RECEIVED**

AUG 18 2011

WATER RESOURCES DEPT  
SALEM, OREGON

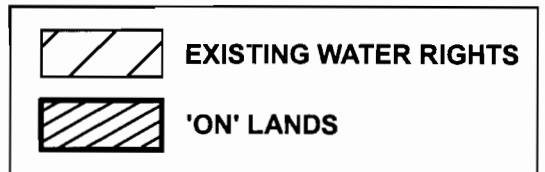

**FINAL PROOF MAP**

**NAME: COID**

**TAXLOT #: 1000**

**5.9 ACRES**

DATE: 07-20-11

FILE: I:\TRANSFER\FINALPRFP-2006-009\181303\_SWSW