

NOTICE TO WATER WELL CONTRACTOR
The original and first copy of this report
are to be filed with the

WATER RESOURCES DEPARTMENT
SALEM, OREGON 97310
within 30 days from the date
of well completion.

Lake
449

WATER WELL REPORT

STATE OF OREGON

(Please type or print)

(Do not write above this line)

Per T. #5
DWM: let
should be
265.
265-DWM
27615E-28d
State Well No. _____
State Permit No. _____

(1) OWNER:

Name The Poplars Ranch
Address 1024 LAKE SHORE Rd.
LAKE OSWEGO, Ore 97034

(2) TYPE OF WORK (check):

New Well Deepening Reconditioning Abandon

If abandonment, describe material and procedure in Item 12.

(3) TYPE OF WELL:

Rotary Driven
Cable Jetted
Dug Bored

(4) PROPOSED USE (check):

Domestic Industrial Municipal
Irrigation Test Well Other

CASING INSTALLED:

Threaded Welded
14" Diam. from 0 ft. to 100 ft. Gage 250
" Diam. from ft. to ft. Gage
" Diam. from ft. to ft. Gage

PERFORATIONS:

Perforated? Yes No.

Type of perforator used _____
Size of perforations in. by in.
perforations from ft. to ft.
perforations from ft. to ft.
perforations from ft. to ft.

(7) SCREENS:

Well screen installed? Yes No

Manufacturer's Name _____
Type _____ Model No. _____
Diam. Slot size Set from ft. to ft.
Diam. Slot size Set from ft. to ft.

(8) WELL TESTS:

Drawdown is amount water level is lowered below static level

Was a pump test made? Yes No If yes, by whom? Ren Johnson

Yield: 1500 + gal./min. with 40 ft. drawdown after 8 hrs.

Baller test 50 gal./min. with 0 ft. drawdown after 2 hrs.

Artesian flow g.p.m. _____

Temperature of water 54 Depth artesian flow encountered _____ ft.

(9) CONSTRUCTION:

Well seal—Material used Cement

Well sealed from land surface to _____ ft.

Diameter of well bore to bottom of seal 2.0 in.

Diameter of well bore below seal 14 in.

Number of sacks of cement used in well seal 45 sacks

How was cement grout placed? pumped

Was a drive shoe used? Yes No Plugs _____ Size: location _____ ft.

Did any strata contain unusable water? Yes No

Type of water? _____ depth of strata _____

Method of sealing strata off _____

Was well gravel packed? Yes No Size of gravel: _____

Gravel placed from _____ ft. to _____ ft.

(10) LOCATION OF WELL:

County LAKE Driller's well number _____
SE 1/4 1/4 Section 28 T. 27S R. 15E W.M.
Bearing and distance from section or subdivision corner
CENTER SEY4 FOR PIVOT IRR.

(11) WATER LEVEL: Completed well.

Depth at which water was first found 526 ft.
Static level 22'7" ft. below land surface. Date 4-18-80
Artesian pressure _____ lbs. per square inch. Date _____

(12) WELL LOG:

Diameter of well below casing 8"
Depth drilled 660 ft. Depth of completed well 660 ft.

Formation: Describe color, texture, grain size and structure of materials; and show thickness and nature of each stratum and aquifer penetrated, with at least one entry for each change of formation. Report each change in position of Static Water Level and indicate principal water-bearing strata.

MATERIAL	From	To	SWL
Top Soil Sandy Brown	0	2	
CLAY BROWN	2	50	
CLAY GRAY	50	505	
ROCK BLACK	505	525	
Cinders BLACK	525	660	22'7"

6" hole From 505 - 660'

RECEIVED

DEC 0 8 2011

DEPT WATER RESOURCES DEPT
SALEM, OREGON

Work started 3-24 1980 Completed 4-18 1980

Date well drilling machine moved off of well 4-18 1980

Drilling Machine Operator's Certification:

This well was constructed under my direct supervision. Materials used and information reported above are true to my best knowledge and belief.

[Signed] Claude Blackman Date 4-20, 1980
(Drilling Machine Operator)

Drilling Machine Operator's License No. 1003

Water Well Contractor's Certification:

This well was drilled under my jurisdiction and this report is true to the best of my knowledge and belief.

Name Claude Blackman
(Person, firm or corporation) (Type or print)

Address P.O. Box 100 Xmas Valley Ore 97638

[Signed] Claude Blackman
(Water Well Contractor)

Contractor's License No. 657 Date 4-20, 1980

(1) OWNER:
Name C. W. Boley Lake 481
Address _____

(2) LOCATION OF WELL:
County Lake Owner's number, if any— #2
R. F. D. or Street No. _____
Bearing and distance from section or subdivision corner
N 26° 41' W 729.50' from 1/4 Sec. Cor.
Common to Sect. 34-85
266 Rise

(3) TYPE OF WORK (check):
New well Deepening Reconditioning Abandon
Abandonment, describe material and procedure in Item 11.

(4) PROPOSED USE (check):
Domestic Industrial Municipal
Irrigation Test Well Other
(5) EQUIPMENT:
Rotary
Cable
Dug Well

(6) CASING INSTALLED:
Threaded Welded none
Gage or Wall _____
Type and size of shoe or well ring _____
Describe joint _____

FROM	ft. to	ft.	Diam.	Gage or Wall	Diameter of Bore	from	to

If gravel packed none
Size of gravel: _____

(7) PERFORATIONS:
Type of perforator used _____

FROM	ft. to	ft.	in., length, by	in.
			perf per foot	No. of rows

(8) SCREENS:
Give Manufacturer's Name, Model No. and Size _____

(9) CONSTRUCTION:
Was a surface sanitary seal provided? Yes No To what depth _____ ft.
Were any strata sealed against pollution? Yes No
If yes, note depth of strata _____
FROM _____ ft. to _____ ft.
METHOD OF SEALING _____

(9) WATER LEVELS:
Depth at which water was first found - Water to drill 5.5 ft.
Standing level before perforating 15 ft. ft.
Standing level after perforating _____ ft.
Log Accepted by: _____
[Signed] _____, 19____
Owner

(10) WELL TESTS:
Was a pump test made? Yes No If yes, by whom?
Yield: _____ gal./min. with _____ ft. draw down after _____ hrs.
Artesian flow _____ g.p.m.
Shut-in pressure _____ lbs. per square inch.
Bailer test _____ g.p.m. with _____ ft. drawdown
Temperature of water _____ Was a chemical analysis made? Yes No
Was electric log made of well? Yes No

(11) WELL LOG:
Diameter of well, 12 inches.
Total depth 145 ft. Depth of completed well _____ ft.
Formation: Describe by color, character, size of material and structure, and show thickness of aquifers and the kind and nature of the material in each stratum penetrated, with at least one entry for each change of formation.

ft. to	ft.	Description
		<u>top soil</u>
<u>8</u>	<u>55</u>	<u>whitish gray - white specks</u>
<u>55</u>	<u>82</u>	<u>sand or cinders mixed with above.</u>
	<u>82</u>	<u>first strata water below</u>
		<u>amount to dig.</u>
<u>82</u>	<u>83 1/2</u>	<u>coarse strata</u>
<u>83 1/2</u>	<u>85</u>	<u>coarse gray sand</u>
<u>85</u>	<u>97</u>	<u>Black clay</u>
<u>97</u>	<u>99</u>	<u>Cinders or black gravel</u>
<u>99</u>	<u>115</u>	<u>yellow clay</u>
<u>115</u>	<u>125</u>	<u>Clay cinders mixed</u>
<u>125</u>	<u>127</u>	<u>Clay</u>
<u>127</u>	<u>131</u>	<u>Cochae sand or fine gravel</u>
<u>131</u>	<u>138</u>	<u>yellow clay</u>
<u>138</u>	<u>145</u>	<u>Black sand & clay mixed</u>
		<u>some white sand.</u>
		<u>get down to 160 ft. but</u>
		<u>filled up to 145 ft.</u>
		<u>Will test as soon as possible.</u>
		<u>Test pump in another well.</u>

Ground elevation at well site 4230 ft - approx. feet above mean sea level.
Work started 7/17 — 1956 Completed _____ 19____
Well Driller's Statement:
This well was drilled under my jurisdiction and this report is true to the best of my knowledge and belief.
NAME C. W. Boley (Person, firm, or corporation) (Typed or printed)
Address Font Rock, Ore.
Driller's well number _____
[Signed] C. W. Boley (Well Driller)
License No. 125 Dated _____, 19____

RECEIVED

DEC 9 2 2011

STATE ENGINEER
Salem, Oregon

Lake
491

Well Record

STATE WELL NO. 26/15-34Q(1)
COUNTY Lake
APPLICATION NO. U-796

OWNER: C. W. Boley

MAILING
ADDRESS:

LOCATION OF WELL: Owner's No. 1


CITY AND
STATE:

Fort Rock, Oregon

SW ¼ SE ¼ Sec. 34 T. 26 S., R. 15 E., W.M.

Bearing and distance from section or subdivision

corner N. 24° 53' E. - 110½ ft. from S¼ cor. Sec. 34

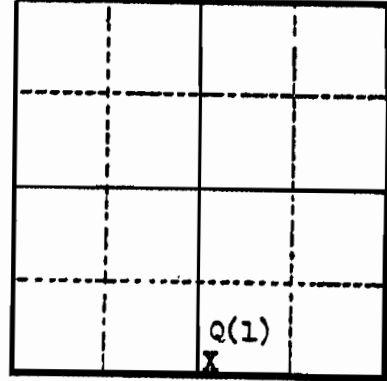

Altitude at well

TYPE OF WELL: Date Constructed 1953

Depth drilled 193 Depth cased

Section 34

CASING RECORD:

FINISH:

AQUIFERS:

WATER LEVEL: 21 feet

PUMPING EQUIPMENT: Type H.P. 25
Capacity 1800 G.P.M.

WELL TESTS:

Drawdown ft. after hours G.P.M.

Drawdown ft. after hours G.P.M.

USE OF WATER Irrigation 100 acres Temp. °F. 19

SOURCE OF INFORMATION U-796

DRILLER or DIGGER

ADDITIONAL DATA:

Log X Water Level Measurements Chemical Analysis Aquifer Test

REMARKS: Permit U-712

RECEIVED

DEC 02 2011

WATER RESOURCES DEPT
SALEM, OREGON

T 11322

STATE ENGINEER
 Salem, Oregon

State Well No. 26/15-340(1)
 County Lake
 Application No. U-796

Well Log

Owner: C. W. Boley Owner's No. 1

Driller: _____ Date Drilled 1953

CHARACTER OF MATERIAL	(Feet below 'and surface)		Thickness (feet)
	From	To	
Surface dirt	0	3	3
Form of potter's caly	3	45	42
Sandstone	45	48	3
Clay	48	65	17
Sandstone	65	68	3
Soft porous volcanic rock and water	68	96	28
Gravel and rock mixture	96	135	39
Volcanic formation and big flow of water	135	145	10
Clay	145	178	33
Pumice formation	178	193	15

RECEIVED

DEC 02 2011

WATER RESOURCES DEPT
 SALEM, OREGON

T 11322

STATE ENGINEER
SALEM, OREGON

State Well No. 2415-2722

County Lake

Application No.

Water Level Record

OWNER'S NO.

*Top of 4 1/2" Timber used to cover well hole
about 2.5 feet above 15.0*

Date	Time	Reading	Remarks
8-1-57	15.7	M.S.	
8-1-57	14.79	"	
8-1-57	14.59	"	
8-1-57	14.56	M.S.	
8-24-57	14.11	M.S.	
10-24-57	14.11	M.S.	
4-25-59	13.18	M.S.	
12-14-59	13.62	M.S.	
8-15-59	14.17	M.S.	
10-14-59	13.14	M.S.	
4-27-60	13.85	M.S.	
8-26-60	13.85	M.S.	
8-27-61	13.30	M.S.	
12-17-61	13.30	M.S.	

RECEIVED

DEC 02 2011

WATER RESOURCES DEPT
SALEM, OREGON

REMARKS: See hydrograph

STATE ENGINEER #4
Salem, Oregon

OBSERVATION WELL
Well Record

STATE WELL NO. 26/15-33G(1)
COUNTY Lake
APPLICATION NO. U-773


Lake
480

OWNER: Merritt Parks MAILING ADDRESS:

LOCATION OF WELL: Owner's No. CITY AND STATE: Fort Rock, Oregon

SW 1/4 NE 1/4 Sec. 33 T. 26 N. E. S., R. 15 W., W.M.

Bearing and distance from section or subdivision corner S. 44 E. 1826.7 ft. from N. cor. Sec. 33

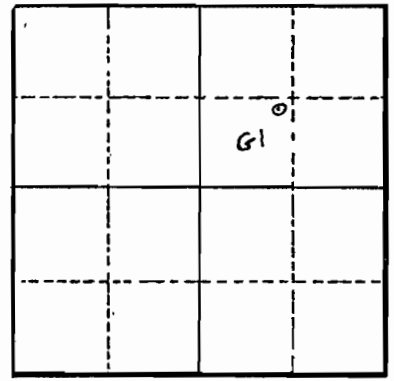

Section 33

Altitude at well

TYPE OF WELL: Date Constructed

Depth drilled 250' Depth cased

CASING RECORD:

FINISH:

AQUIFERS:

WATER LEVEL:
25.39' (7-11-62)

PUMPING EQUIPMENT: Type H.P.
Capacity G.P.M.

WELL TESTS:
Drawdown ft. after hours G.P.M.
Drawdown ft. after hours G.P.M.

USE OF WATER Irrigation 156 acres Temp. °F., 19

SOURCE OF INFORMATION
DRILLER or DIGGER

ADDITIONAL DATA:
Log Water Level Measurements Chemical Analysis Aquifer Test

REMARKS: Permit U-690

RECEIVED

DEC 02 2011

WATER RESOURCES DEPT
SALEM, OREGON

NOTICE TO WATER WELL CONTRACTOR

The original and first copy of this report are to be filed with the

STATE ENGINEER, SALEM, OREGON 97310 within 30 days from the date of well completion.

RECEIVED

WATER WELL REPORT

STATE OF OREGON JUN 13 1975

State Well No. 265/15E-33a

(Please type or print)

STATE ENGINEER SALEM, OREGON

State Permit No.

Lake 482

(1) OWNER:

Name O.R. Heavilin (Merritt Parks) Address Fort Rock, Oregon

(2) TYPE OF WORK (check):

New Well [] Deepening [X] Reconditioning [] Abandon []

If abandonment, describe material and procedure in Item 12.

(3) TYPE OF WELL:

Rotary [X] Cable [] Dug [] Driven [] Jetted [] Bored []

(4) PROPOSED USE (check):

Domestic [] Industrial [] Municipal [] Irrigation [X] Test Well [] Other []

(5) CASING INSTALLED:

Threaded [] Welded [] Diam. from ft. to ft. Gage

(6) PERFORATIONS:

Perforated? [] Yes [] No. Type of perforator used Size of perforations in. by in.

(7) SCREENS:

Well screen installed? [] Yes [] No Manufacturer's Name Type Model No.

(8) WELL TESTS:

Drawdown is amount water level is lowered below static level Was a pump test made? [] Yes [] No. Yield: gal./min. with ft. drawdown after hrs.

(9) CONSTRUCTION:

Well seal—Material used grout undisturbed Well sealed from land surface to ft. Diameter of well bore to bottom of seal in.

(10) LOCATION OF WELL:

County Lake Driller's well number 1/4 NE 1/4 Section 33 T. 26S R. 15E W.M. Bearing and distance from section or subdivision corner 1320' West & 1320' South of NE corner Sec 33

(11) WATER LEVEL: Completed well.

Depth at which water was first found ft. Static level 22 ft. below land surface. Date 5/16/75 Artesian pressure lbs. per square inch. Date

(12) WELL LOG:

Diameter of well below casing 12. Depth drilled 300 ft. Depth of completed well 300 ft. Formation: Describe color, texture, grain size and structure of materials; and show thickness and nature of each stratum and aquifer penetrated.

Table with columns: MATERIAL, From, To, SWL. Rows include blk sand congl (wb), gray clay, blk sand congl (wb), gray clay Congl (water).

RECEIVED

DEC 02 2011

WATER RESOURCES DEPT SALEM, OREGON

Work started 5/15 1975 Completed 5/16 1975 Date well drilling machine moved off of well 5/16 1975

Drilling Machine Operator's Certification:

This well was constructed under my direct supervision. Materials used and information reported above are true to my best knowledge and belief. [Signed] W.D. Williams Date 6/6/1975

Water Well Contractor's Certification:

This well was drilled under my jurisdiction and this report is true to the best of my knowledge and belief. Name Crawford Well Drilling Address 3626 N.W. Coyner Redmond, Ore. [Signed] John Johnson Date 6/6/1975

T 11322

RECEIVED

WATER WELL REPORT
STATE OF OREGON

FEB 20 1987

Lake 483

State Well No. 265/15E-33

State Permit No. L

WATER RESOURCES DEPT.
SALEM, OREGON

(1) OWNER:

Name The Poplars Ranch
Address ST. RT.
City Silver Lake, OR 97138 State OR

(2) TYPE OF WORK (check):

New Well Deepening Reconditioning Abandon

If abandonment, describe material and procedure in Item 12.

(3) TYPE OF WELL:

Rotary Air Driven
Mud Dug
 Bored

(4) PROPOSED USE (check):

Domestic Industrial Municipal
Irrigation Test Well Other
Thermal: Withdrawal Reinjection

(5) CASING INSTALLED:

Steel Plastic
Threaded Welded
1.4" Diam. from 0 ft. to 6.9 ft. Gauge 250

LINER INSTALLED:

" Diam. from ft. to ft. Gauge

(6) PERFORATIONS:

Perforated? Yes No

Type of perforator used
Size of perforations in by in.
perforations from ft. to ft.
perforations from ft. to ft.
perforations from ft. to ft.

(7) SCREENS:

Well screen installed? Yes No

Manufacturer's Name
Type Model No.
Diam. Slot Size Set from ft. to ft.
Diam. Slot Size Set from ft. to ft.

(8) WELL TESTS:

Drawdown is amount water level is lowered below static level

a pump test made? Yes No If yes, by whom?
Yield: gal/min. with ft. drawdown after hrs.
Air test gal./min. with drill stem at ft. hrs.
Bailer test 25 gal./min. with 0 ft. drawdown after 1 hrs.
Flow rate g.p.m.
Temperature of water 62 Depth artesian flow encountered ft.

(9) CONSTRUCTION:

Special standards: Yes No

Well seal—Material used Portland Cement
Well sealed from land surface to 6.9 ft.
Diameter of well bore to bottom of seal 1.8 in.
Diameter of well bore below seal 1.1 in.
Number of sacks of cement used in well seal 30 sacks
How was cement grout placed? pumped
Was pump installed? N.P. Type HP Depth ft.
Was a drive shoe used? Yes No Plugs Size: location ft.
Did any strata contain unusable water? Yes No
Type of Water? depth of strata
Method of sealing strata off
Was well gravel packed? Yes No Size of gravel: ft.
Gravel placed from ft. to ft.

(10) LOCATION OF WELL:

County Lake Driller's well number
Center $\frac{1}{4}$ S $\frac{1}{2}$ W $\frac{1}{4}$ Section 33 T 262 R 15E W.M.
Tax Lot # Lot Blk Subdivision
Address at well location:

(11) WATER LEVEL: Completed well.

Depth at which water was first found 90 ft.
Static level 24' 4" ft. below land surface. Date 2-10-87
Artesian pressure lbs. per square inch. Date

(12) WELL LOG:

Diameter of well below casing 11

Depth drilled 165 ft. Depth of completed well 165 ft.
Formation: Describe color, texture, grain size and structure of materials; and show thickness and nature of each stratum and aquifer penetrated, with at least one entry for each change of formation. Report each change in position of Static Water Level and indicate principal water-bearing strata.

MATERIAL	From	To	SWL
Top Soil	0	2	
Clay Brown	2	55	
Clay Gray	55	90	
Sand Black Fine	90	91	
Clay Gray	91	98	
Sand Brown Course	98	102	
Sand Stone	102	107	
Pumice Course	107	108	
Sandstone	108	130	
Rock Brown Broken	130	140	
Sandstone	140	150	
Rock Broken Brown	150	162	24' 4"
Rock Black	162	165	

70' 14" casing
70'-100' is 11" Hole
100-165 is 8" Hole

RECEIVED

DEC 0 2 2011

WATER RESOURCES DEPT.
SALEM, OREGON

Work started 1-24 1987 Completed 2-17 1987
Date well drilling machine moved off of well 2-18 1987

Drilling Machine Operator's Certification:

This well was constructed under my direct supervision. Materials used and information reported above are true to my best knowledge and belief.
[Signed] Charles Robinson Date 2-18, 1987
(Drilling Machine Operator)

Drilling Machine Operator's License No. 1003

Water Well Contractor's Certification:

This well was drilled under my jurisdiction and this report is true to the best of my knowledge and belief.
Name Charles Blackman (Type or print)
(Person, firm or corporation)

Address P.O. Box 100 Kings Valley OR 97641

[Signed] Charles Blackman (Water Well Contractor)

Contractor's License No. 657 Date 2-18 1987

NOTICE TO WATER WELL CONTRACTOR
The original and first copy of this report are to be filed with the

WATER RESOURCES DEPARTMENT,
SALEM, OREGON 97310
within 30 days from the date of well completion.

SP 12658-690

11322

RECEIVED

STATE OF OREGON
WATER WELL REPORT
(as required by ORS 537.765)

JUN 3 - 1987

PLEASE TYPE OR PRINT IN INK

Lake
484

265/15E-330
Deep.
(for official use only)

(1) OWNER: WATER RESOURCES DEPT.
SALEM, OREGON

Name The Poplars Ranch
Address ST. RT.
City SILVER LAKE 97038 State Ore

(2) TYPE OF WORK (check):
New Well Deepening Reconditioning Abandon
If abandonment, describe material and procedure in Item 12.

(3) TYPE OF WELL: Rotary Air Driven
Rotary Mud Dug
Cable Bored
(4) PROPOSED USE (check): Domestic Industrial Municipal
Irrigation Thermal: Withdrawal ReInjection
Other: Piezometric Grounding Test

CASING INSTALLED: Steel Plastic
Threaded Welded
Diam. from NONE ft. to _____ ft. Gauge _____

LINER INSTALLED: Steel Plastic
Threaded Welded
Diam. from _____ ft. to _____ ft. Gauge _____

(6) PERFORATIONS: Perforated? Yes No
Size of perforations _____ in. by _____ in.
_____ perforations from _____ ft. to _____ ft.

(7) SCREENS: Well screen installed? Yes No
Manufacturer's Name _____
Type _____ Model No. _____
Diam. _____ Slot Size _____ Set from _____ ft. to _____ ft.

(8) WELL TESTS: Drawdown is amount water level is lowered below static level
Was a pump test made? Yes No If yes, by whom? ALAN PARKS
Yield: 800 gal./min. with 21 ft. drawdown after 2 hrs.
Air test _____ gal./min. with drill stem at _____ ft. hrs.
Bailer test _____ gal./min. with _____ ft. drawdown after _____ hrs.
Artesian flow _____ g.p.m.
Temperature of water 120 Depth artesian flow encountered _____ ft.

(9) CONSTRUCTION: Special standards: Yes No
Well seal—Material used Seal NOT Disturbed
Well sealed from land surface to _____ ft.
Diameter of well bore to bottom of seal _____ in.
Diameter of well bore below seal _____ in.
Amount of sealing material _____ sacks pounds
How was cement grout placed? _____
Was pump installed? Yes Type WESTERN 6E HP 30 Depth 50 ft.
Was a drive shoe used? Yes No Plugs _____ Size: location _____ ft.
Did any strata contain unusable water? Yes No
Type of Water? _____ depth of strata _____
Method of sealing strata off _____
Was well gravel packed? Yes No Size of gravel: _____
Gravel placed from _____ ft. to _____ ft.

(10) LOCATION OF WELL by legal description:
County Lake Center SW 1/4 of Section 33 of
Township 26 (Township _____ South) Range 15 (Range is Eastern _____) WM.
Tax Lot _____ Lot _____ Block _____ Subdivision _____

MAILING ADDRESS OF WELL (or nearest address)
ST. RT. SILVER LAKE Ore 97038

(11) WATER LEVEL of COMPLETED WELL:
Depth at which water was first found 168 ft.
Static level 24" ft. below land surface. Date 5-17-87
Artesian pressure _____ lbs. per square inch. Date _____

(12) WELL LOG: Diameter of well below casing 8"
Depth drilled 115 ft. Depth of completed well 280 ft.
Formation: Describe color, texture, grain size and structure of materials; and show thickness and nature of each stratum and aquifer penetrated, with at least one entry for each change of formation. Report each change in position of Static Water Level and indicate principal water-bearing strata.

MATERIAL	From	To	SWL
Rock BLACK	165	168	
Rock BROWN + BROKEN WITH SEVERAL LAYERS OF BLACK ROCK	168	280	

8" Hole to 280'

RECEIVED

JUN 02 2011

WATER RESOURCES DEPT.
SALEM, OREGON

Date work started 5-14-87/completed 6-2-87
Date well drilling machine moved off of well 5-24 1987

(unbonded) Water Well Constructor Certification (if applicable):
This well was constructed under my direct supervision. Materials used and information reported above are true to my best knowledge and belief.
[Signed] Claude Blakeman Date 6-2-87 1987

(bonded) Water Well Constructor Certification:
Bond 9497438A Issued by Fidelity & Deposit Co. of Maryland
(number) (Surety Company Name)
On behalf of Claude Blakeman
(type or print name of Water Well Constructor)

This well was drilled under my jurisdiction and this report is true to the best of my knowledge and belief.
[Signed] Claude Blakeman
(Water Well Constructor)
(Dated) 6-2-87

NOTICE TO WATER WELL CONSTRUCTOR
The original and first copy of this report are to be filed with the

WATER RESOURCES DEPARTMENT,
SALEM, OREGON 97310
within 30 days from the date of well completion.

SP*46886-800

T 11322

#3

LAKE 51764

amended Lake 51764
























Date Started 4-10-06 Completed 4-13-06

(unbonded) Water Well Constructor Certification I certify that the work I performed on the construction, deepening, alteration, or abandonment of this well is in compliance with Oregon water supply well construction standards. Materials used and information reported above are true to the best of my knowledge and belief.

WWC Number Date 5-10-06 Signed Adam Parks

(bonded) Water Well Constructor Certification I accept responsibility for the construction, deepening, alteration, or abandonment work performed on this well during the construction dates reported above. All work performed during this time is in compliance with Oregon water supply well construction standards. This report is true to the best of my knowledge and belief.

WWC Number Date Signature

ORIGINAL WATER RESOURCES DEPARTMENT

OCT 11 2007

WATER RESOURCES DEPT. SALEM, OREGON

RECEIVED MAY 30 2008 COPY - CONSTRUCTOR WATER RESOURCES DEPT SALEM, OREGON

SECOND COPY - CUSTOMER 06/16/2004

RECEIVED

DEC 02 2011

WATER RESOURCES DEPT SALEM, OREGON

T 11322

STATE OF OREGON
 WATER SUPPLY WELL REPORT
 (as required by ORS 537.765)

LAKE 51764

Lake 51764

WELL I.D. # L 87845

START CARD # W187193

Instructions for completing this report are on the last page of this form.

(1) LAND OWNER Well Number
 Name The Poplars Ranch, Inc - ALAN PARKS
 Address 59234 Font Rock Rd
 City SILVER LAKE State OR Zip 97638

(2) TYPE OF WORK New Well
 Deepening Alteration (repair/recondition) Abandonment Conversion

(3) DRILL METHOD
 Rotary Air Rotary Mud Cable Auger Cable Mud
 Other

(4) PROPOSED USE
 Domestic Community Industrial Irrigation
 Thermal Injection Livestock Other

(5) BORE HOLE CONSTRUCTION Special Construction: Yes No
 Depth of Completed Well 460 ft.
 Explosives used: Yes No Type _____ Amount _____

BORE HOLE			SEAL			
Diameter	From	To	Material	From	To	Sacks or Pounds
24	Surface	38	Hide Plug Top	38		45
15 1/4	38	335				
10 1/2	235	460				

How was seal placed: Method A B C D E
 Other _____

Backfill placed from _____ ft. to _____ ft. Material _____
 Gravel placed from _____ ft. to _____ ft. Size of gravel _____

(6) CASING/LINER

Diameter	From	To	Gauge	Steel	Plastic	Welded	Threaded
Casing: 18	Top	38	1/4"	<input checked="" type="checkbox"/>	<input type="checkbox"/>	<input type="checkbox"/>	<input type="checkbox"/>
Liner:				<input type="checkbox"/>	<input type="checkbox"/>	<input type="checkbox"/>	<input type="checkbox"/>

Drive Shoe used Inside Outside None
 Final location of shoe(s) _____

(7) PERFORATIONS/SCREENS
 Perforations Method _____
 Screens Type _____ Material _____

From	To	Slot Size	Number	Diameter	Tele/pipe size	Casing	Liner
						<input type="checkbox"/>	<input type="checkbox"/>
						<input type="checkbox"/>	<input type="checkbox"/>
						<input type="checkbox"/>	<input type="checkbox"/>
						<input type="checkbox"/>	<input type="checkbox"/>

(8) WELL TESTS: Minimum testing time is 1 hour
 Pump Bailer Air Flowing Artesian

Yield gal/min	Drawdown	Drill stem at	Time
2000+	-	400	2 hrs

Temperature of water _____ Depth Artesian Flow Found _____
 Was a water analysis done? Yes By whom _____
 Did any strata contain water not suitable for intended use? Too little
 Salty Muddy Odor Colored Other _____
 Depth of strata: _____

(9) LOCATION OF WELL (legal description)
 County LAKE
 Tax Lot 4400 Lot _____
 Township 26 S N or S Range 15 E E or W WM
 Section 33 NW 1/4 NW 1/4

Lat _____ " or _____ (degrees or decimal)
 Long _____ " or _____ (degrees or decimal)

Street Address of Well (or nearest address) Plainview Rd

(10) STATIC WATER LEVEL
31 1/2 ft. below land surface. Date 4-12-06
31 ft. below land surface. Date 4-13-06
 Artesian pressure _____ lb. per square inch Date _____

(11) WATER BEARING ZONES
 Depth at which water was first found 95

From	To	Estimated Flow Rate	SWL
95	115		
212	388		
438	460		

(12) WELL LOG Ground Elevation _____

Material	From	To	SWL
Topsoil	Surface	3	
Hardpan Clay	3	115	
HARD CLAY	115	161	
ROCK	161	212	
Black Sand, Pumice and Green Clay	212	388	
HARD ROCK	388	410	
CLAY	410	438	
BLACK LAVA ROCK	438	460	

Date Started 4-10-06 Completed 4-13-06

(unbonded) Water Well Constructor Certification
 I certify that the work I performed on the construction, deepening, alteration, or abandonment of this well is in compliance with Oregon water supply well construction standards. Materials used and information reported above are true to the best of my knowledge and belief.

WWC Number _____ Date 5-10-06

Signed Alan Parks

(bonded) Water Well Constructor Certification
 I accept responsibility for the construction, deepening, alteration, or abandonment work performed on this well during the construction dates reported above. All work performed during this time is in compliance with Oregon water supply well construction standards. This report is true to the best of my knowledge and belief.

WWC Number _____ Date _____

RECEIVED

MAY 30 2006
 WATER RESOURCES DEPT
 SALEM, OREGON

ORIGINAL - WATER RESOURCES DEPARTMENT
 FIRST COPY - CONSTRUCTOR
 SECOND COPY - CUSTOMER
 06/16/2004
 DEC 02 2011
 WATER RESOURCES DEPT
 SALEM, OREGON
 T 11322

STATE ENGINEER
Salem, Oregon

OBSERVATION WELL
Well Record

STATE WELL NO. 27/15-4G(1)
COUNTY Lake
APPLICATION NO. GR-347
6-10917

OWNER: M. Y. Parks

MAILING ADDRESS:


LOCATION OF WELL: Owner's No.

CITY AND STATE:

Fort Rock, Oregon

SW 1/4 NE 1/4 Sec. 4 T. 27 N. S., R. 15 E. W., W.M.

Bearing and distance from section or subdivision corner

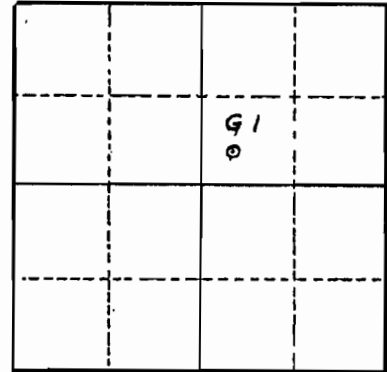

Section 4

Altitude at well 4.335

TYPE OF WELL: drilled Date Constructed 1922

Depth drilled 257 Depth cased 14

CASING RECORD:

FINISH: Open hole below casing

AQUIFERS: coarse agglomerate

WATER LEVEL: 38.70 ft. below land surface, Sept. 4, 1932

PUMPING EQUIPMENT: Type turbine H.P.
Capacity 1500 G.P.M.

WELL TESTS:
Drawdown 3.45 ft. after 50 min. hours pumping 1100 G.P.M.
Drawdown ft. after hours G.P.M.

USE OF WATER Irrigation Temp. 62 °F. October 24, 1948

SOURCE OF INFORMATION USGS Report

DRILLER or DIGGER

ADDITIONAL DATA:

Log Water Level Measurements X Chemical Analysis X Aquifer Test

REMARKS: Test well constructed by State in 1922.

RECEIVED

DEC 02 2011

WATER RESOURCES DEPT
SALEM, OREGON

#12

MAY 10 1991

LAKE 4100

11.6

265/15E/28 CC

STATE OF OREGON
WATER WELL REPORT
(as required by ORS 537.785)

WATER RESOURCES DEPT
SALEM, OREGON

(START CARD) # 18263

(1) OWNER: Well Number: _____
Name The Poplars Ranch INC.
Address HC-61 BOX 118
City SILVER LAKE State ORE Zip 97138

(2) TYPE OF WORK:
 New Well Deepen Recondition Abandon

(3) DRILL METHOD
 Rotary Air Rotary Mud Cable
 Other _____

(4) PROPOSED USE:
 Domestic Community Industrial Irrigation
 Thermal Injection Other _____

(5) BORE HOLE CONSTRUCTION:
Special Construction approval Yes No Depth of Completed Well 430 ft.
Explosives used Yes No Type _____ Amount _____

HOLE			SEAL			Amount
Diameter	From	To	Material	From	To	sacks or pounds
18"	0	61	PORTLAND CEMENT	0	61	27 SACKS
14"	61	100				
8 3/4"	100	430				

How was seal placed: Method A B C D E
 Other _____
Backfill placed from _____ ft. to _____ ft. Material _____
Gravel placed from _____ ft. to _____ ft. Size of gravel _____

(6) CASING/LINER:

Diameter	From	To	Gauge	Steel	Plastic	Welded	Threaded
Casing: 14"	0	61	250	<input checked="" type="checkbox"/>	<input type="checkbox"/>	<input checked="" type="checkbox"/>	<input type="checkbox"/>
Liner: NONE				<input type="checkbox"/>	<input type="checkbox"/>	<input type="checkbox"/>	<input type="checkbox"/>

Final location of shoe(s) _____

(7) PERFORATIONS/SCREENS:
 Perforations Method _____
 Screens Type _____ Material _____

From	To	Slot size	Number	Diameter	Tele/pipe size	Casing	Liner
NONE							

(8) WELL TESTS: Minimum testing time is 1 hour
 Pump Bailor Air Flowing Artesian
Yield gal/min 25 Drawdown 0 Drill stem at _____ Time 1 hr.

Temperature of water 55° Depth Artesian Flow Found _____
Was a water analysis done? NO Yes By whom _____
Did any strata contain water not suitable for intended use? Too little
 Salty Muddy Odor Colored Other NONE
Depth of strata: 430'

(9) LOCATION OF WELL by legal description:
County LAKE Latitude _____ Longitude _____
Township 26 Nor S, Range 15 E 4 W, WM.
Section 28 SW 1/4 SW 1/4
Tax Lot 4800 Lot _____ Block _____ Subdivision _____
Street Address of Well (or nearest address) HC 61 BOX 118 SILVER LAKE ORE

(10) STATIC WATER LEVEL:
30 ft. below land surface. Date 5-8-91
Artesian pressure _____ lb. per square inch. Date _____

(11) WATER BEARING ZONES:

Depth at which water was first found 370

From	To	Estimated Flow Rate	SWL
370	430	1500 gal min	30'

(12) WELL LOG: Ground elevation _____

Material	From	To	SWL
TOP SOIL SANDY BRN	0	3	
DIAZONITE	3	30	
CLAY GRAY	30	245	
ROCK BLACK	245	310	
CLAY BRN	310	370	
CLAY BRN - FAIRLY LAYERS	370	430	30'
COURSE + BLACK SAND FINE LAYERS			

Date started 4-13-91 Completed 5-8-91

(unbonded) Water Well Constructor Certification:
I certify that the work I performed on the construction, alteration, or abandonment of this well is in compliance with Oregon well construction standards. Materials used and information reported above are true to my best knowledge and belief.
Signed Claude Blackburn WWC Number 657 Date 5-8-91

(bonded) Water Well Constructor Certification:
I accept responsibility for the construction, alteration, or abandonment work performed on this well during the construction dates reported above. All work performed during this time is in compliance with Oregon well construction standards. This report is true to the best of my knowledge and belief.
Signed Claude Blackburn WWC Number 657 Date 5-8-91

T T 1322

RECEIVED
MAY 8 1962
STATE ENGINEER
SALEM, OREGON

WATER WELL REPORT
STATE OF OREGON

Lake
485

26/15-33H

File Original and First Copy with the STATE ENGINEER, SALEM, OREGON

State Well No. _____
State Permit No. _____

(1) OWNER:

Name *Merritt Parks*
Address *Fort Rock, Oreg.*

(2) LOCATION OF WELL:

County *Lake* Owner's number, if any—
SE 1/4 NE 1/4 Section 33 T. 26 S. R. 15 E W.M.
Bearing and distance from section or subdivision corner
Exact distance and bearing shown on water right application.

(3) TYPE OF WORK (check):

New Well Deepening Reconditioning Abandon
If abandonment, describe material and procedure in Item 11.

PROPOSED USE (check):

Domestic Industrial Municipal
Irrigation Test Well Other

(5) TYPE OF WELL:

Rotary Driven
Cable Jetted
Dug Bored

(6) CASING INSTALLED:

Threaded Welded
14" Diam. from *0* ft. to *16* ft. Gage *188*
" Diam. from _____ ft. to _____ ft. Gage _____
" Diam. from _____ ft. to _____ ft. Gage _____

(7) PERFORATIONS:

Perforated? Yes No
Type of perforator used _____
SIZE of perforations in. by _____ in.
perforations from _____ ft. to _____ ft.
perforations from _____ ft. to _____ ft.
perforations from _____ ft. to _____ ft.
perforations from _____ ft. to _____ ft.
perforations from _____ ft. to _____ ft.

(8) SCREENS:

Well screen installed Yes No
Manufacturer's Name _____
Type _____ Model No. _____
Slot size _____ Set from _____ ft. to _____ ft.
Slot size _____ Set from _____ ft. to _____ ft.

(9) CONSTRUCTION:

Was well gravel packed? Yes No Size of gravel: _____
Gravel placed from _____ ft. to _____ ft.
Was a surface seal provided? Yes No To what depth? _____ ft.
Material used in seal—
Did any strata contain unusable water? Yes No
Type of water? _____ Depth of strata _____
Method of sealing strata off _____

(10) WATER LEVELS:

Static level *21.7* ft. below land surface Date _____
Artesian pressure _____ lbs. per square inch Date _____

Log Accepted by:

[Signed] *Merritt Parks* _____, 19____
(Owner)

(11) WELL TESTS:

Drawdown is amount water level is lowered below static level
Was a pump test made? Yes No If yes, by whom?
Yield: *12.50* gal./min. with *27.3* ft. drawdown after *24* hrs.
" " " "
" " " "
Bailer test gal./min. with _____ ft. drawdown after _____ hrs.
Artesian flow _____ g.p.m. Date _____
Temperature of water *52°* Was a chemical analysis made? Yes No

(12) WELL LOG:

Diameter of well *14" to 20" feet*
Depth drilled *250* ft. Depth of completed well *250* ft.
Formation: Describe by color, character, size of material and structure, and show thickness of aquifers and the kind and nature of the material in each stratum penetrated, with at least one entry for each change of formation.

MATERIAL	FROM	TO
<i>Sandy Soil</i>	<i>0'</i>	<i>32'</i>
<i>Sandstone</i>	<i>32'</i>	<i>40'</i>
<i>Black cinders, water-bearing</i>	<i>40'</i>	<i>46'</i>
<i>Soft gray material, bedding on soapstone</i>	<i>46'</i>	<i>60'</i>
<i>Cinders</i>	<i>60'</i>	<i>64'</i>
<i>Hard clay with white flakes</i>	<i>64'</i>	<i>112'</i>
<i>Clay</i>	<i>112'</i>	<i>130'</i>
<i>Coarse, gravel-like material with thin layers of hard clay, with water</i>	<i>130'</i>	<i>142'</i>
<i>Coarse, white, wash sand</i>	<i>142'</i>	<i>152'</i>
<i>Fine gravel with 2" to 3" layers of clay, every 8' to 10'</i>	<i>152'</i>	<i>205'</i>
<i>Clay, white, firmish</i>	<i>205'</i>	<i>215'</i>
<i>Surface</i>	<i>215'</i>	<i>250'</i>

RECEIVED

DEC 2 2011

WATER RESOURCES DEPT
SALEM, OREGON

Work started *Nov. 1957* Completed *April 14 1962*

(13) PUMP:

Manufacturer's Name *Rebuilt Johnson*
Type: *Turbine* H.P. *20HP*

Well Driller's Statement:

This well was drilled under my jurisdiction and this report is true to the best of my knowledge and belief.

NAME *C. W. Boley*
(Person, firm, or corporation) (Type or print)

Address *Fort Rock, Oreg.*

Driller's well number *4*

[Signed] *C. W. Boley*
(Well Driller)

License No. *12.5* Date _____, 19____