



Oregon Water Resources Department  
 725 Summer Street NE, Suite A  
 Salem, Oregon 97301-1266  
 (503) 986-0900  
 www.wrd.state.or.us

# District Permanent Water Right Transfer Claim of Beneficial Use

**RECEIVED**

FEB 22 2012

WATER RESOURCES DEPT  
 SALEM, OREGON

## 1. APPLICANT INFORMATION

District: Farmers Irrigation District

Contact Person: Rick Brock

Phone: 541-387-5263

Mailing Address: 1985 Country Club Road

City: Hood River

State: OR

Zip: 97031

E-Mail address:

rick@fidhr.org

Transfer Number: T - 9587

## 2. WATER RIGHT(S)

Pursuant to OAR Chapter 690, Division 385, the district is submitting to the Water Resources Department this claim of beneficial use for the following water right(s):

PERMIT NUMBER	CERTIFICATE NUMBER	DECREE (name, volume, and page)	PRIMARY (P) OR SUPP (S)
-	74306	Farmers Irrigation District, Volume 17 page 333	<input checked="" type="checkbox"/> P <input type="checkbox"/> S
-			<input type="checkbox"/> P <input type="checkbox"/> S
-			<input type="checkbox"/> P <input type="checkbox"/> S
-			<input type="checkbox"/> P <input type="checkbox"/> S

## 3. AUTHORIZED POINT(S) OF DIVERSION (POD) / APPROPRIATION (POA)


The authorized point(s) of diversion / appropriation for the water right modified by the transfer are as follows:


PERMIT NUMBER	DECREE or CERTIFICATE	POD / POA #	SOURCE	LOCATION – MEASURED DISTANCES
-	74306	161129	Hood River	NW 1/4 of SW 1/4, Section 31, T. 2N., R. 10E., W.M. , being 2250 feet North and 470 feet East from the SW corner, of Section 31.
-				
-				
-				




**6. SIGNATURES**

The district certifies that it has inspected the place of use listed in Table I, and confirms the change in place of use has been completed consistent with the terms and conditions of the final order approving the transfer.

  
\_\_\_\_\_  
Signature of District Manager  
or District Board Chairperson

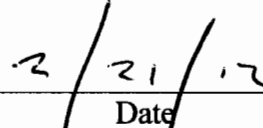  
\_\_\_\_\_  
Date

  
\_\_\_\_\_  
Type or Print Name of District Manager  
or District Board Chairperson

**RECEIVED**

FEB 22 2012

WATER RESOURCES DEPT  
SALEM, OREGON

**AUTHORIZED PLACE OF USE** Farmers Irrigation District **T-9587 Claim of Beneficial Use**  
**LEGAL DESCRIPTION** 1985 Country Club Road  
Hood River Oregon 97031

WATER RIGHT Certificate	PRIMARY	Certificate SUPP	PRIORITY DATE	USE	POD#	TWP	RNG	SEC	QQ	TAXLOT	USER NAME	Acres	CBU Report	
													#	MAP #
74306	IRR	IRR	5/7/1906	IRR	16129	2N	10E	2	NW/NW	100	HRV CHRISTIAN / AKIN	1.35	1	1
74306	IRR	IRR	5/7/1906	IRR	16129	2N	10E	2	SE/SW	1701	HURLEY	0.05	2	2
74306	IRR	IRR	5/7/1906	IRR	16129	2N	10E	3	NWNE	1900	MARCHESI	5.35	3	3
74306	IRR	IRR	5/7/1906	IRR	16129	3N	10E	33	SE/NE	2800	SMITH	0.25	4	4
74306	IRR	IRR	5/7/1906	IRR	16129	3N	10E	34	NW/NE	1607	GERDE	0.50	5	5
74306	IRR	IRR	5/7/1906	IRR	16129	3N	10E	34	SW/NE	100	BARONE	0.15	6	6
74306	IRR	IRR	5/7/1906	IRR	16129	3N	10E	34	SW/NE	200	BARONE	0.10	7	7
74306	IRR	IRR	5/7/1906	IRR	16129	3N	10E	34	SW/NE	400	BARONE	0.20	8	8
74306	IRR	IRR	5/7/1906	IRR	16129	3N	10E	34	SW/NE	500	BARONE	0.15	9	9
74306	IRR	IRR	5/7/1906	IRR	16129	3N	10E	34	SW/NE	700	BARONE	0.25	10	10
74306	IRR	IRR	5/7/1906	IRR	16129	3N	10E	34	SW/NE	800	WASSON	0.15	11	11
74306	IRR	IRR	5/7/1906	IRR	16129	3N	10E	34	SW/NE	900	WASSON	0.10	12	12
74306	IRR	IRR	5/7/1906	IRR	16129	3N	10E	34	SW/NE	1000	BARONE	0.15	13	13
74306	IRR	IRR	5/7/1906	IRR	16129	3N	10E	34	SW/NE	1100	BARONE	0.15	14	14
74306	IRR	IRR	5/7/1906	IRR	16129	3N	10E	34	SW/NE	1200	BARONE	0.10	15	15
74306	IRR	IRR	5/7/1906	IRR	16129	3N	10E	34	SW/NE	1300	BARONE	0.10	16	16
74306	IRR	IRR	5/7/1906	IRR	16129	3N	10E	34	SW/NE	1400	BARONE	0.15	17	17
74306	IRR	IRR	5/7/1906	IRR	16129	3N	10E	34	SW/NE	1500	BARONE	0.10	18	18
74306	IRR	IRR	5/7/1906	IRR	16129	3N	10E	34	SW/NE	1600	BARONE	0.25	19	19
74306	IRR	IRR	5/7/1906	IRR	16129	3N	10E	34	SW/NE	2100	BARONE	13.00	20	20
74306	IRR	IRR	5/7/1906	IRR	16129	3N	10E	34	NW/NW	1200	LOZOWSKI	1.50	21	21
74306	IRR	IRR	5/7/1906	IRR	16129	3N	10E	34	SW/NW	1511	FLERCHINGER	1.80	22	22
74306	IRR	IRR	5/7/1906	IRR	16129	3N	10E	34	NW/SE	901	BEAMAN	0.15	23	23
74306	IRR	IRR	5/7/1906	IRR	16129	3N	10E	34	SW/SE	1900	GUTHRIE	0.30	24	24
74306	IRR	IRR	5/7/1906	IRR	16129	3N	10E	34	SW/SE	1907	GUTHRIE	0.15	25	25
74306	IRR	IRR	5/7/1906	IRR	16129	3N	10E	34	SE/SE	2000	HENDERSON	0.75	26	26
74306	IRR	IRR	5/7/1906	IRR	16129	3N	10E	34	SE/SE	2600	SMITH	0.60	27	27
74306	IRR	IRR	5/7/1906	IRR	16129	3N	10E	35	NE/SW	100	HENDERSON (lot 93)	0.20	28	28
74306	IRR	IRR	5/7/1906	IRR	16129	3N	10E	35	NE/SW	168	MARQUEZ (lot 94)	0.10	29	29
74306	IRR	IRR	5/7/1906	IRR	16129	3N	10E	35	SW/SE	2200	MARSHALL	0.15	30	30
<b>Total</b>												<b>28.30</b>		

**RECEIVED**  
FEB 22 2012  
WATER RESOURCES DEPT  
SALEM, OREGON

RECEIVED

FEB 22 2012

WATER RESOURCES DEPT  
SALEM, OREGON



---

• 1985 Country Club Road, Hood River, OR 97031 Phone (541)-386-3115 Fax (541)-386-9103 www.fidhr.org •

---

2/20/2012

Oregon Water Resources Department  
Attention: Susan Douthit  
725 Summer Street NE, Suite A  
Salem OR 97301

RE: Farmers Irrigation District Claim of Beneficial Use for T-9587.

Dear Ms. Douthit,

As we discussed earlier this month I am sending you the Claim of Beneficial Use for transfer 9587. This package includes a list of properties, CBU site reports and maps. Some of the maps are labeled application for water right transfer because they were the ON maps from the transfer work in 2006, I penciled in that they are now CBU maps.

The primary irrigation certificate is 74306, there is no supplemental irrigation rights involved.

Please contact me with any questions.

Sincerely,

A handwritten signature in black ink that reads "Rick Brock". The signature is written in a cursive style.

Rick Brock  
Water Rights Specialist  
rick@fidhr.org  
541-387-5263

**CLAIM OF BENEFICIAL USE  
Site Report**

Transfer Number: T -9587

District Internal Notice Number (DINN): 5826

Landowner Name: HRV CHRISTIAN / AKIN

# 1

Property Address: NEAR INDIAN CREEK ROAD, HOOD RIVER OR 97031

**Place of Use:**

*Enter one record for each portion of the taxlot that falls within a unique quarter-quarter. A single taxlot may have more than one legal description but may not if it falls entirely in a single quarter-quarter.*

USE	POD #	TWP	RNG	SEC	QQ	DLC	GOV'T LOT	TAX LOT	ACRES
IR	29	2M	10	2	NW/NW			100	1.35

**District Conveyance System:**

Description of Delivery System:

Served by pressurized pipe 1.5" from the Avalon line at Westside school.

Headgate Number: AV003

Canal Name: Avalon

**Beneficial Use:**

Description of Beneficial Use: Grass

Method Used to Apply Water: Sprinklers,

Method Used to Calculate Beneficial Use: Tax lot #0101,#0102,#0103 is the 1.35 acres ON, 0101 is drip/sprinkler at .55 water right acre. #0102 is grass at .50 wra and 0103 is .30 wra grass.

- The water right user has been interviewed
- The water right in question has been beneficially used as authorized

Please describe the beneficial use if less than authorized under the transfer:

O101 & 0102 are grass Use is evident. O103 is landscaping & grass Use is evident.

Inspected by: Rick Brock

Date: 8/17/2006

Company: Farmers Irrigation District

***Instructions: Attach and label the corresponding final proof map***

**RECEIVED**


FEB 22 2012

WATER RESOURCES DEPT  
SALEM, OREGON

# CLAIM OF BENEFICIAL USE

## T2N. R10 SECTION 2 NWNW

# 1

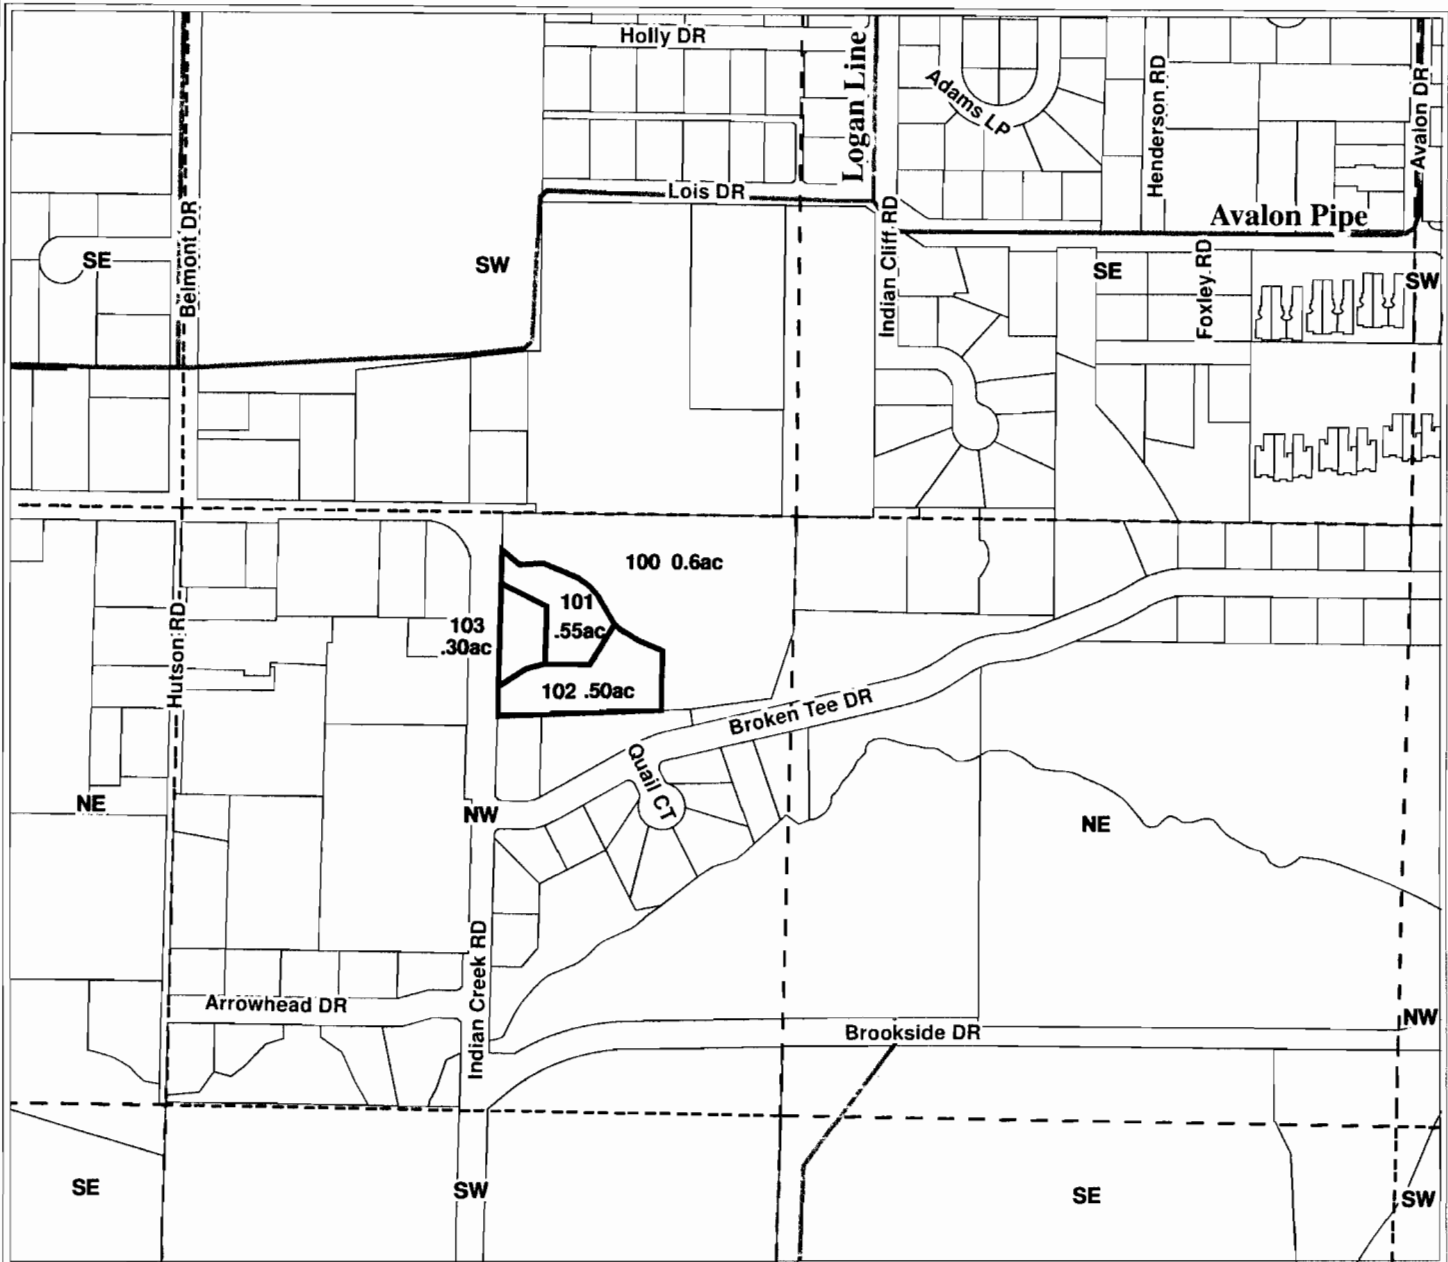

### UNMAPPED CLAIM OF BENEFICIAL USE FOR DISTRICT PERMANENT WATER RIGHT TRANSFER

for

**Hood River Valley Christian Church / Akin**

**Tax Lot 100 - 1.35 Acres**


**(Lot has since been subdivided into 101, 102, 103)**

**0.6 Existing Acres remain on Lot 100**

**1.95 Total Acres for Lots 100, 101, 102, and 103**



**UnMapped Water Right**

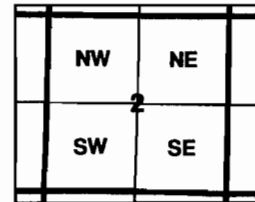

1 inch equals 400 feet

**RECEIVED**

FEB 22 2012

WATER RESOURCES DEPT  
SALEM, OREGON



**Geo-Spatial Solutions, Inc.**

[www.geospatialolutions.com](http://www.geospatialolutions.com)

Date Created: August, 2006

**CLAIM OF BENEFICIAL USE  
Site Report**

Transfer Number: T -9587

District Internal Notice Number (DINN): 5820

# 2

Landowner Name: HURLEY

Property Address: 1500 TUCKER ROAD, HOOD RIVER OR 97031

**Place of Use:**

*Enter one record for each portion of the taxlot that falls within a unique quarter-quarter. A single taxlot may have more than one legal description but may not if it falls entirely in a single quarter-quarter.*

USE	POD #	TWP	RNG	SEC	QQ	DLC	GOV'T LOT	TAX LOT	ACRES
IR	29	2N	10	2	SE/SW			1701	.05

**District Conveyance System:**

Description of Delivery System:

Served by pressurized 2" pipe, part of the Mt View user group

Headgate Number: DI3

Canal Name: DILLON

**Beneficial Use:**

Description of Beneficial Use: Pasture grass

Method Used to Apply Water: Sprinkler

Method Used to Calculate Beneficial Use: On site inspection, past use is evident. Overlaid with aerial imagery and verified irrigated area.

- The water right user has been interviewed
- The water right in question has been beneficially used as authorized

Please describe the beneficial use if less than authorized under the transfer:

Inspected by: Rick Brock

Date: 3/15/2006

Company: Farmers Irrigation District

***Instructions:*** Attach and label the corresponding final proof map

**RECEIVED**

FEB 22 2012

WATER RESOURCES DEPT  
SALEM, OREGON



# APPLICATION FOR WATER RIGHT TRANSFER

## T2N. R10 SECTION 2

#2



### APPLICATION FOR DISTRICT PERMANENT WATER RIGHT TRANSFER

for  
Hurley  
Tax Lot 1701 - 0.05 Acres

**RECEIVED**

FEB 22 2012

WATER RESOURCES DEPT  
SALEM, OREGON



**Geo-Spatial Solutions, Inc.**

[www.geospatialolutions.com](http://www.geospatialolutions.com)

Date Created: April 27, 2004



1 inch equals 400 feet

**CLAIM OF BENEFICIAL USE  
Site Report**

Transfer Number: T -9587

District Internal Notice Number (DINN): 5817

Landowner Name: MARCHESI

#3

Property Address: 2600 BELMONT DRIVE, HOOD RIVER OR 97031

**Place of Use:**

*Enter one record for each portion of the taxlot that falls within a unique quarter-quarter. A single taxlot may have more than one legal description but may not if it falls entirely in a single quarter-quarter.*

USE	POD #	TWP	RNG	SEC	QQ	DLC	GOV'T LOT	TAX LOT	ACRES
IR	29	2N	10E	3	NWNE			1900	5.35

**District Conveyance System:**

Description of Delivery System:

Served by pressurized pipe 3" from the Belmont line

Headgate Number: BE5

Canal Name: Belmont

**Beneficial Use:**

Description of Beneficial Use: Vineyard

Method Used to Apply Water: Sprinkler, drip

Method Used to Calculate Beneficial Use: On site inspection of irrigable areas. Use is evident.

- The water right user has been interviewed
- The water right in question has been beneficially used as authorized

Please describe the beneficial use if less than authorized under the transfer:

Inspected by: Rick Brock

Date: 8/15/2006

Company: Farmers Irrigation District

***Instructions: Attach and label the corresponding final proof map***


**RECEIVED**

FEB 22 2012

WATER RESOURCES DEPT  
SALEM, OREGON

**CLAIM OF BENEFICIAL USE**  
**T2N. R10 SECTION 3 NWNE**

# 3

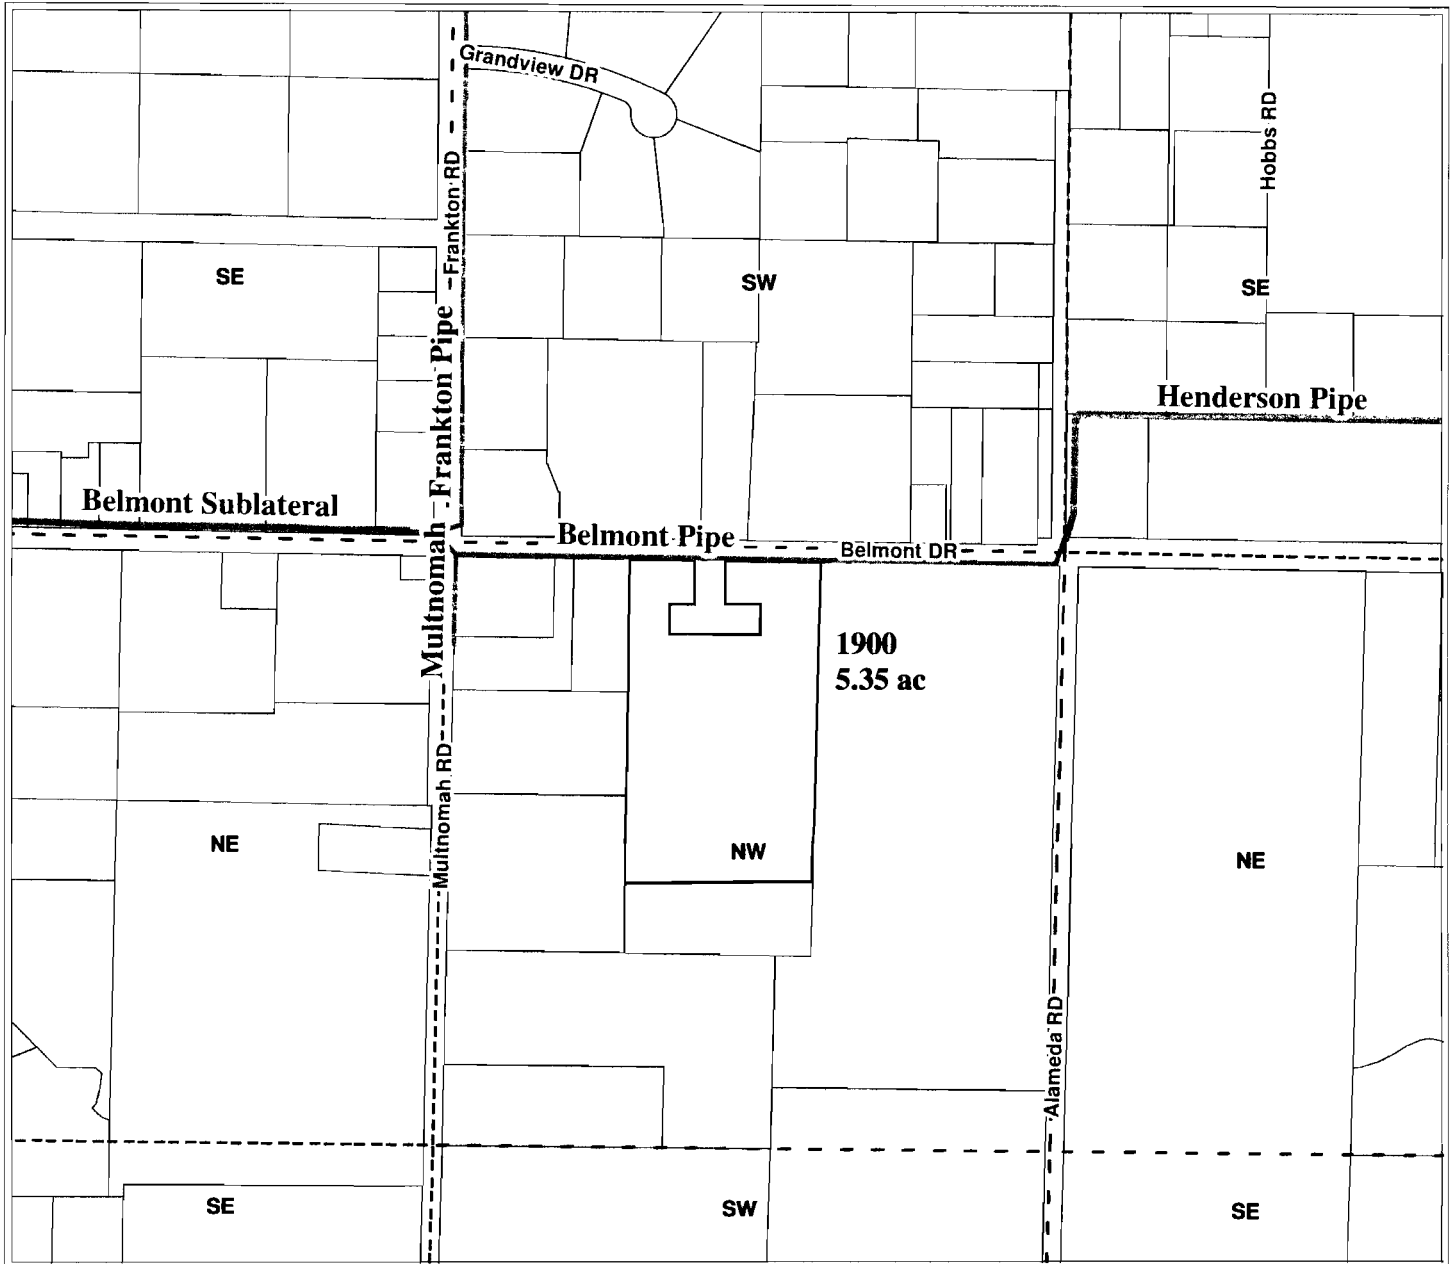

**CLAIM OF BENEFICIAL USE**  
**FOR DISTRICT PERMANENT WATER RIGHT TRANSFER**

**RECEIVED**

FEB 22 2012

WATER RESOURCES DEPT  
 SALEM, OREGON




**Geo-Spatial Solutions, Inc.**  
[www.geospatialolutions.com](http://www.geospatialolutions.com)

for  
 Marchesi

**Tax Lot 1900 - 5.35 Acres**  
**(Certificate 74306)**

 **Mapped Water Right**

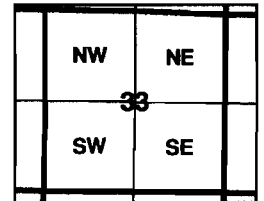

1 inch equals 400 feet

Date Created: August, 2006

**CLAIM OF BENEFICIAL USE  
Site Report**

# 4

Transfer Number: T -9587

District Internal Notice Number (DINN): 5822

Landowner Name: SMITH

Property Address: 4340 POST CANYON ROAD, HOOD RIVER OR 97031

**Place of Use:**

*Enter one record for each portion of the taxlot that falls within a unique quarter-quarter. A single taxlot may have more than one legal description but may not if it falls entirely in a single quarter-quarter.*

USE	POD #	TWP	RNG	SEC	QQ	DLC	GOV'T LOT	TAX LOT	ACRES
IR	29	3N	10	33	SE/NE			2800	.25

**District Conveyance System:**

Description of Delivery System:

Property has a tap from neighbor to the North tax lot 2402,

Headgate Number: MU035

Canal Name: Muddy Pipe

**Beneficial Use:**

Description of Beneficial Use: Lawn

Method Used to Apply Water: 1.5 gallon per minute sprinkler

Method Used to Calculate Beneficial Use: On-site inspection of irrigable area. Measured area.

- The water right user has been interviewed
- The water right in question has been beneficially used as authorized

Please describe the beneficial use if less than authorized under the transfer:

Use is evident and on-going new owner is Trey Hendricks

Inspected by: Rick Brock

Date: 8/23/2006

Company: Farmers Irrigation District

***Instructions: Attach and label the corresponding final proof map***


**RECEIVED**

FEB 22 2012

WATER RESOURCES DEPT  
SALEM, OREGON

**CLAIM OF BENEFICIAL USE**  
**T3N. R10 SECTION 33 SENE**

# 4

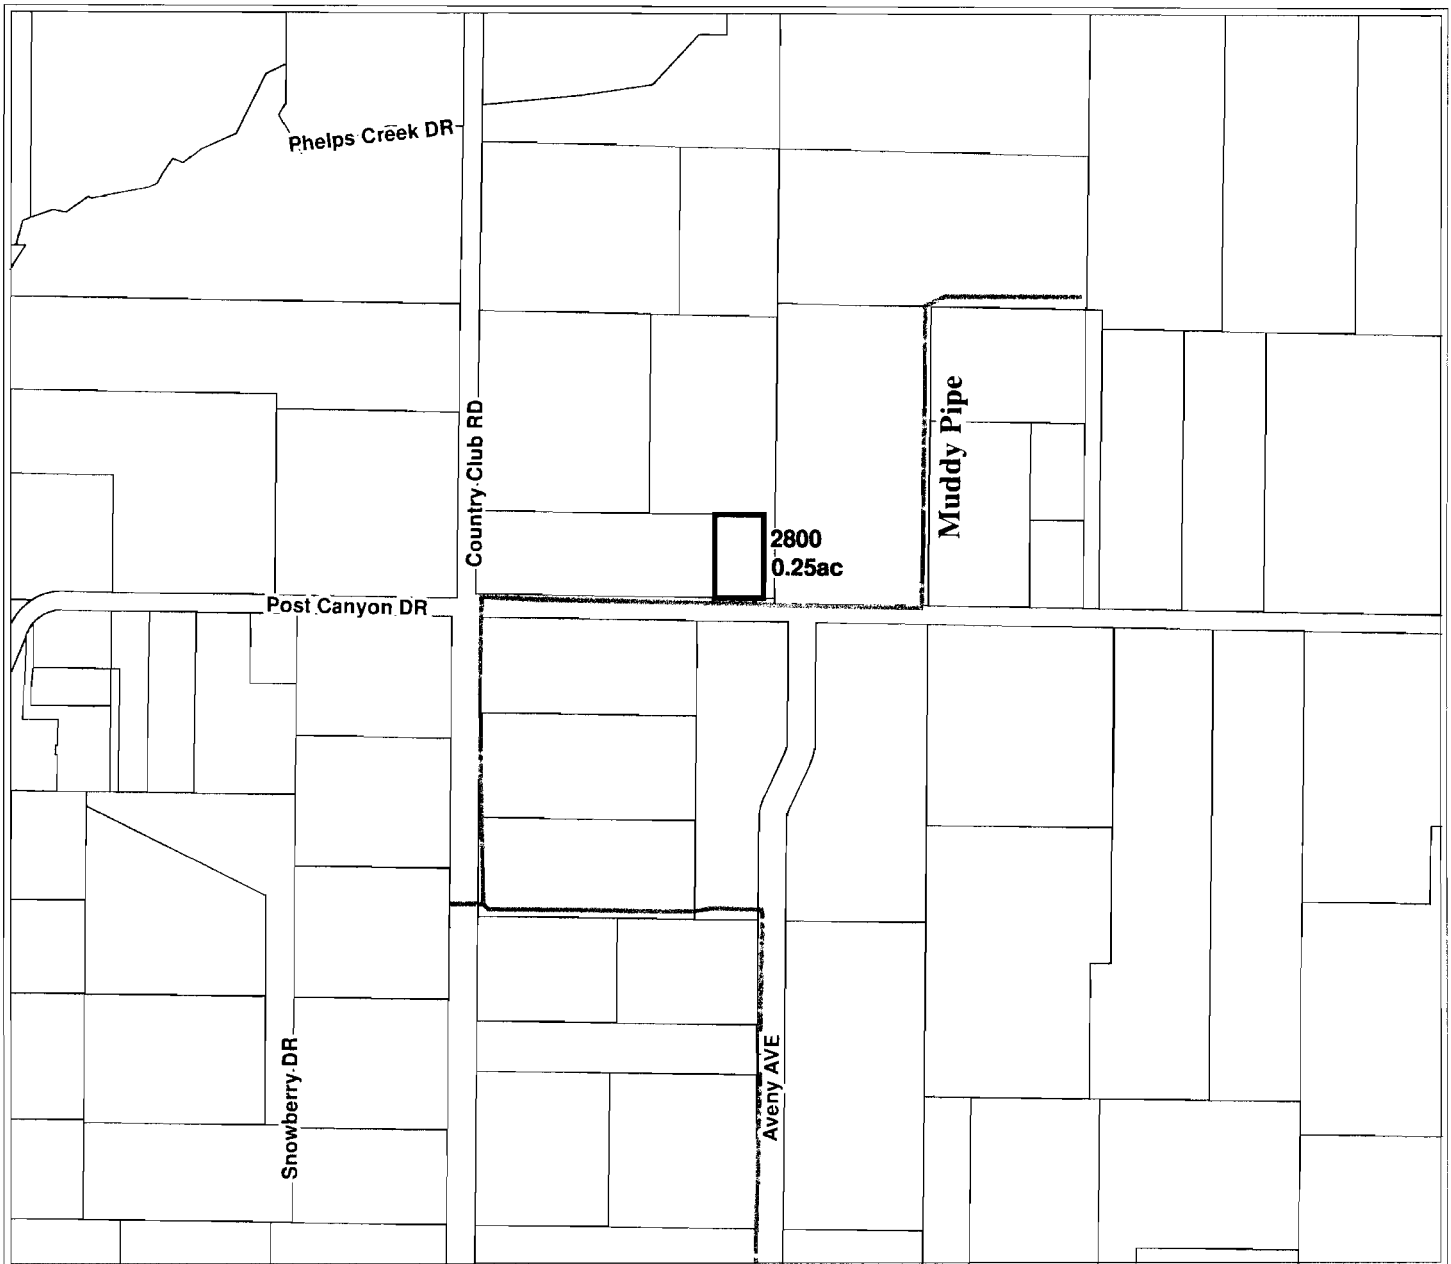

**UNMAPPED CLAIM OF BENEFICIAL USE**  
**FOR DISTRICT PERMANENT WATER RIGHT TRANSFER**

**RECEIVED**

FEB 22 2012

WATER RESOURCES DEPT  
SALEM, OREGON



**Geo-Spatial Solutions, Inc.**  
[www.geospatialolutions.com](http://www.geospatialolutions.com)


for  
**Smith**

**Tax Lot 2800 - 0.25 Acres**



**UnMapped Water Right**

Date Created: August, 2006

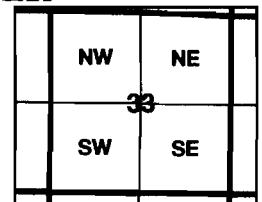

1 inch equals 400 feet

# CLAIM OF BENEFICIAL USE

## Site Report

Transfer Number: T -9587

District Internal Notice Number (DINN): 6013

Landowner Name: GERDE

# 5

Property Address: MAY STREET

**Place of Use:**

*Enter one record for each portion of the taxlot that falls within a unique quarter-quarter. A single taxlot may have more than one legal description but may not if it falls entirely in a single quarter-quarter.*

USE	POD #	TWP	RNG	SEC	QQ	DLC	GOV'T LOT	TAX LOT	ACRES
IR	29	3N	10	34	NW/NE			1607	.5

**District Conveyance System:**

Description of Delivery System:

Served by private pressurized 2" line coming from the Frankton Line.

Headgate Number: FRA21

Canal Name: Frankton

**Beneficial Use:**

Description of Beneficial Use: Pasture, grass.

Method Used to Apply Water: Sprinkler

Method Used to Calculate Beneficial Use: Overlaid with aerial imagery and verified irrigated area. Taxlot is not the original area submitted.

- The water right user has been interviewed
- The water right in question has been beneficially used as authorized

Please describe the beneficial use if less than authorized under the transfer:

Inspected by: Rick Brock

Date: 3/13/2006

Company: Farmers Irrigation District

***Instructions:*** Attach and label the corresponding final proof map

**RECEIVED**

FEB 22 2012

WATER RESOURCES DEPT  
SALEM, OREGON

# APPLICATION FOR WATER RIGHT TRANSFER

T3N. R10 SECTION 34

CB4 #5



## APPLICATION FOR DISTRICT PERMANENT WATER RIGHT TRANSFER

for  
Gerde

Tax Lot 1607 - .50 Acres **RECEIVED**

FEB 22 2012

WATER RESOURCES DEPT  
SALEM, OREGON



**Geo-Spatial Solutions, Inc.**

[www.geospatialsolutions.com](http://www.geospatialsolutions.com)

Date Created: August 03, 2004



1 inch equals 400 feet

**CLAIM OF BENEFICIAL USE  
Site Report**

Transfer Number: T -9587

District Internal Notice #: 5853

# 6

User Name: BARONE

Property Address: Willow Ponds Subdivision, no street address.

**Place of Use:**

*Enter one record for each portion of the taxlot that falls within a unique quarter-quarter. A single taxlot may have more than one legal description but may not if it falls entirely in a single quarter-quarter.*

USE	POD #	TWP	RNG	SEC	QQ	DLC	GOV'T LOT	TAX LOT	ACRES
IR	29	3N	10	34	SW/NE			100	.15

**District Conveyance System:**

Description of Delivery System:

Served by 4-inch pressurized mainline from Frankton Road at Intersection with Post Canyon Road.

Headgate Number: FRA015

Canal Name: Frankton

**Beneficial Use:**

Description of Beneficial Use: Landscaping & Lawn

Method Used to Apply Water: Sprinklers

Method Used to Calculate Beneficial Use: Owner has .06 acres of landscaping served by pop up irrigation system, and .09 acres with hose and sprinkler.

- The water right user has been interviewed
- The water right in question has been beneficially used as authorized

Please describe the beneficial use if less than authorized under the transfer:

Use is evident.

Inspected by: Rick Brock

Date: 8/9/2006

Company: Farmers Irrigation District

**RECEIVED**  
FEB 22 2012  
WATER RESOURCES DEPT  
SALEM, OREGON


***Instructions: Attach and label the corresponding final proof map***



# CLAIM OF BENEFICIAL USE

## T3N. R10 SECTION 34 SWNE

# 6

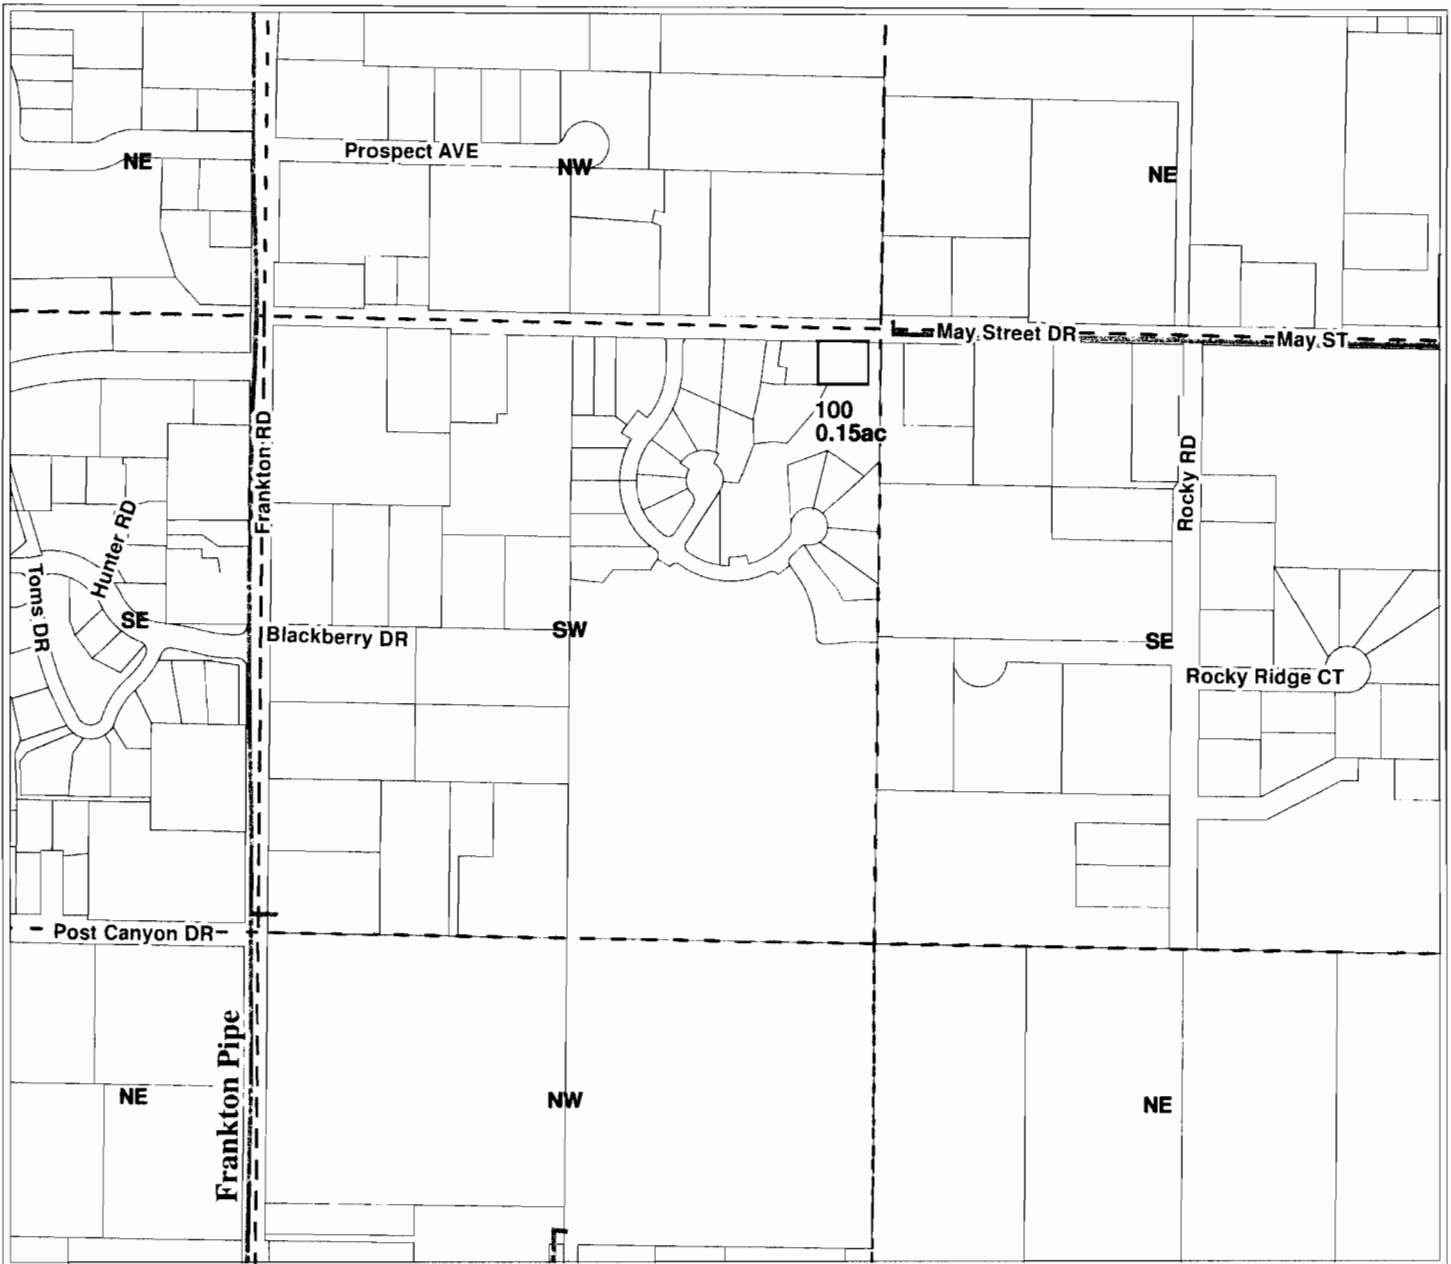

### UNMAPPED CLAIM OF BENEFICIAL USE

**FOR DISTRICT PERMANENT WATER RIGHT TRANSFER**

**RECEIVED**


FEB 22 2012

WATER RESOURCES DEPT  
SALEM, OREGON

for

**Barone**

**Tax Lot 100 - 0.15 Acres**

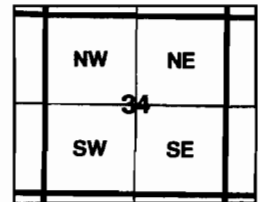

**Geo-Spatial Solutions, Inc.**

[www.geospatialolutions.com](http://www.geospatialolutions.com)



**UnMapped Water Right**



Date Created: August, 2006

1 inch equals 400 feet

# CLAIM OF BENEFICIAL USE Site Report

Transfer Number: T -9587

District Internal Notice Number (DINN): 5854

User Name: BARONE

Property Address: 3867 MAY DRIVE, HOOD RIVER OR 97031

#7

**Place of Use:**

*Enter one record for each portion of the taxlot that falls within a unique quarter-quarter. A single taxlot may have more than one legal description but may not if it falls entirely in a single quarter-quarter.*

USE	POD #	TWP	RNG	SEC	QQ	DLC	GOVT LOT	TAX LOT	ACRES
IR	29	3N	10	34	SW/NE			200	.1

**District Conveyance System:**

Description of Delivery System:

Served by pressurized pipe 4" from the intersection of Frankton Road & Post Canyon Road.

Headgate Number: FRA15

Canal Name: Frankton

**Beneficial Use:**

Description of Beneficial Use: Landscaping & Lawn use

Method Used to Apply Water: Sprinkler & Drip

Method Used to Calculate Beneficial Use: On site inspection of Irrigable areas. Overlaid aerial imagery and calculated irrigated area.

- The water right user has been interviewed
- The water right in question has been beneficially used as authorized

Please describe the beneficial use if less than authorized under the transfer:

Inspected by: Rick Brock

Date: 3/13/2006

Company: Farmers Irrigation District

***Instructions:*** Attach and label the corresponding final proof map

RECEIVED


FEB 22 2012

WATER RESOURCES DEPT  
SALEM, OREGON

# APPLICATION FOR WATER RIGHT TRANSFER

T3N. R10 SECTION 34

CB4 # 7

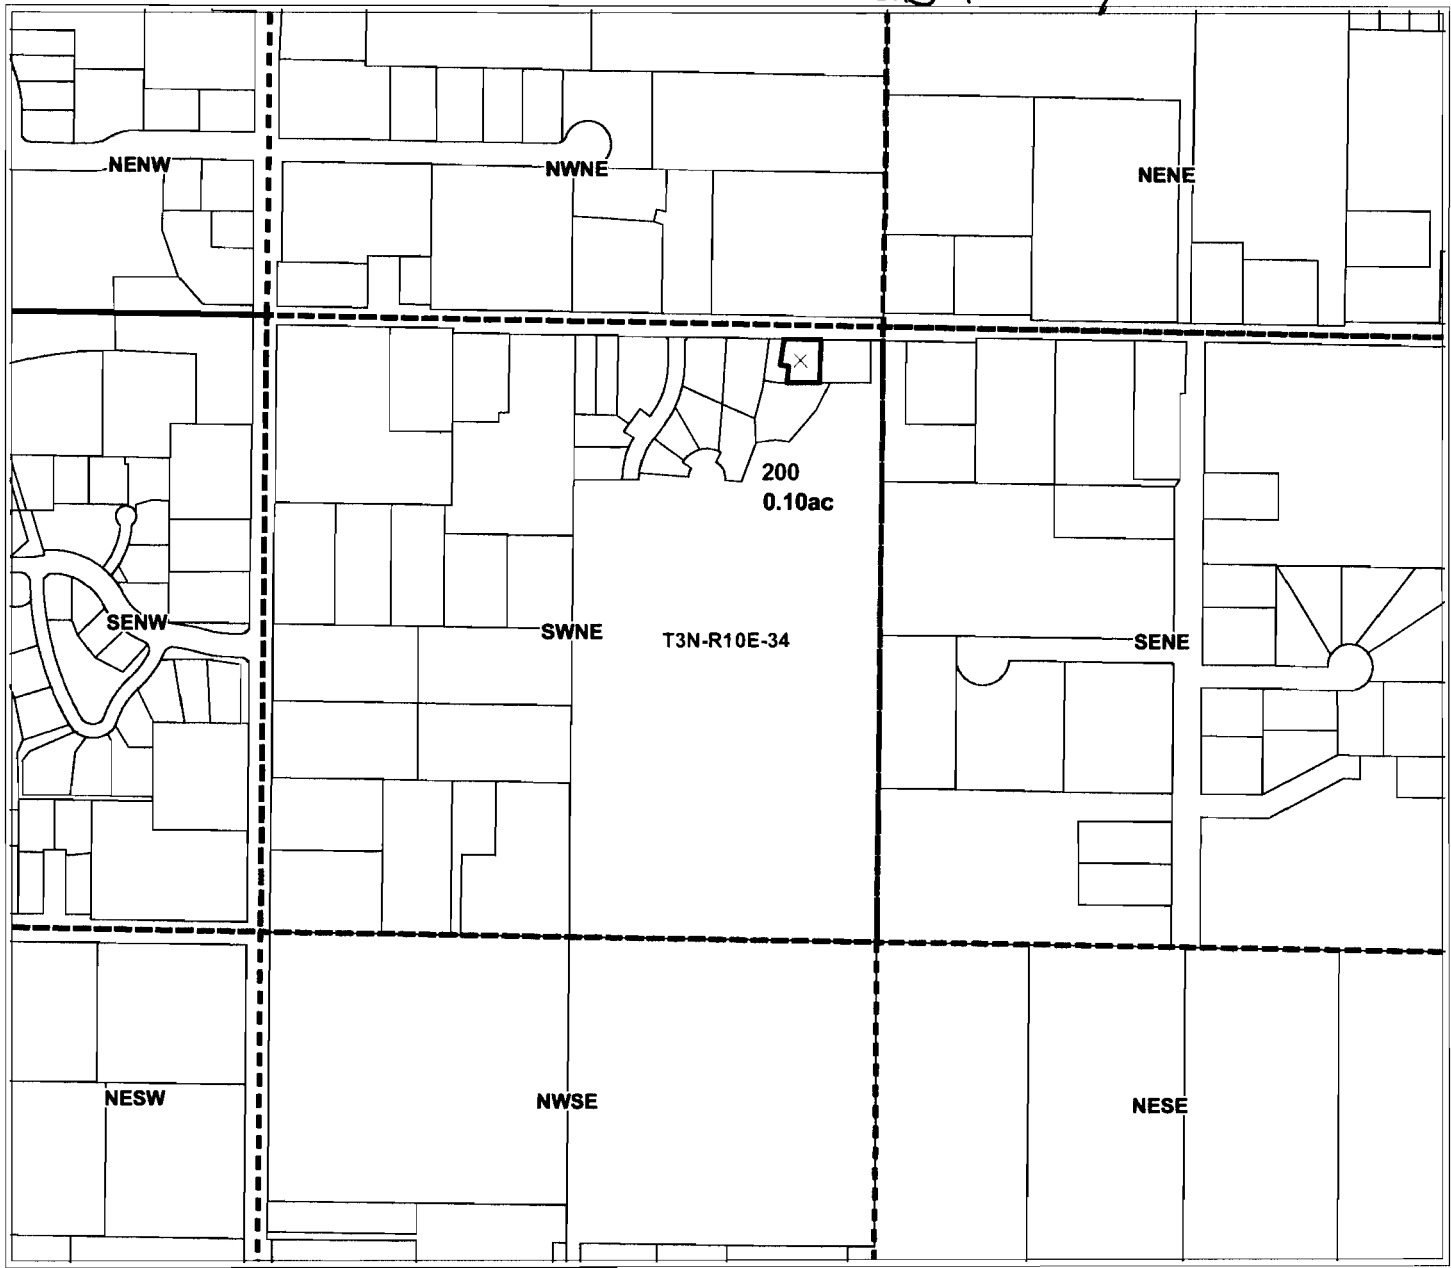

## APPLICATION FOR DISTRICT PERMANENT WATER RIGHT TRANSFER

for

Barone

Tax Lot 200 - 0.10 Acres

**RECEIVED**

FEB 22 2012

WATER RESOURCES DEPT  
SALEM, OREGON



**Geo-Spatial Solutions, Inc.**

[www.geospatialolutions.com](http://www.geospatialolutions.com)

Date Created: July 20, 2004



1 inch equals 400 feet

# CLAIM OF BENEFICIAL USE

## Site Report

Transfer Number: T -9587

District Internal Notice Number (DINN): 5855

#18

Landowner Name: BARONE

Property Address: 3875 MAY DRIVE, HOOD RIVER OR 97031

**Place of Use:**

*Enter one record for each portion of the taxlot that falls within a unique quarter-quarter. A single taxlot may have more than one legal description but may not if it falls entirely in a single quarter-quarter.*

USE	POD #	TWP	RNG	SEC	QQ	DLC	GOV'T LOT	TAX LOT	ACRES
IR	29	3N	10	34	SW/NE			400	.2

**District Conveyance System:**

Description of Delivery System:

Served by pressurized pipe 4" lateral from the intersection of Frankton Road and Post Canyon Road.

Headgate Number: FRA15

Canal Name: Frankton

**Beneficial Use:**

Description of Beneficial Use: Lawn Irrigation

Method Used to Apply Water: Sprinkler, Drip

Method Used to Calculate Beneficial Use: On site inspection, activity indicates past beneficial use. Overlaid aerial imagery and calculated irrigated area.

- The water right user has been interviewed
- The water right in question has been beneficially used as authorized

Please describe the beneficial use if less than authorized under the transfer:

Planting and or landscaping the lot is ongoing. New home.

Inspected by: Rick Brock

Date: 3/13/2006

Company: Farmers Irrigation District

RECEIVED


FEB 22 2012

WATER RESOURCES DEPT  
SALEM, OREGON

***Instructions:*** Attach and label the corresponding final proof map

# APPLICATION FOR WATER RIGHT TRANSFER

T3N. R10 SECTION 34 CBU # 8

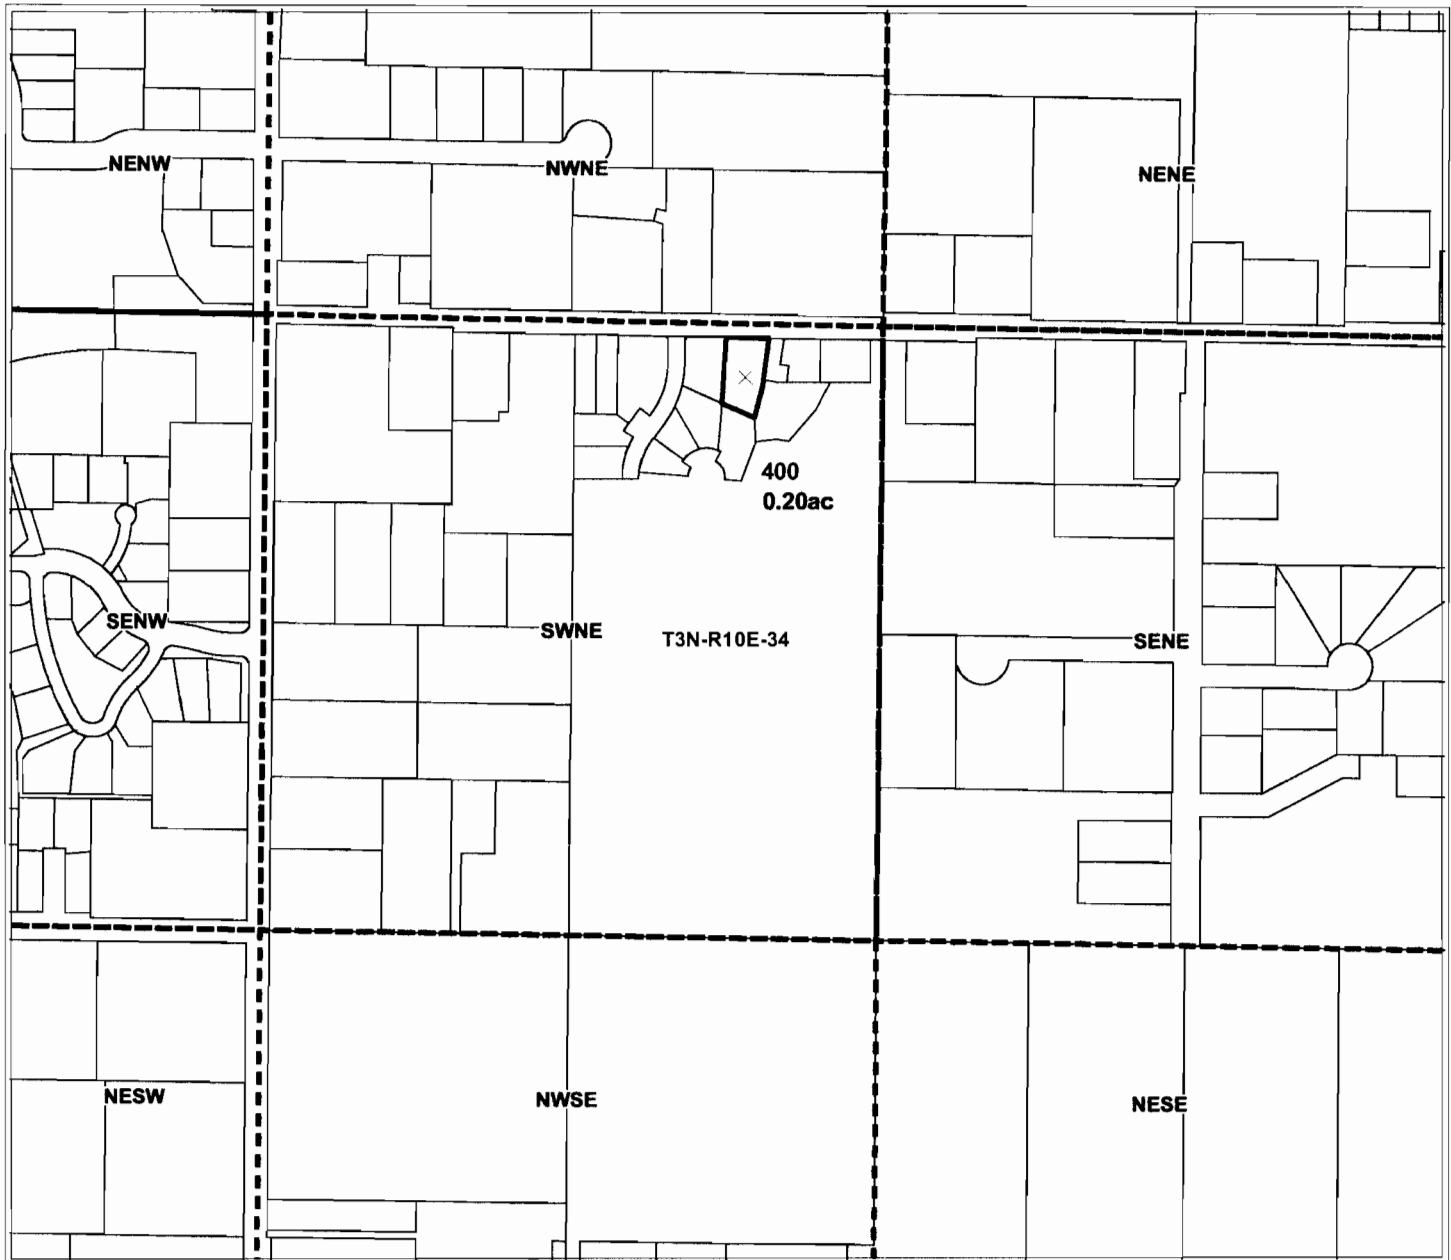

## APPLICATION FOR DISTRICT PERMANENT WATER RIGHT TRANSFER

for

Barone

Tax Lot 400 - 0.20 Acres

RECEIVED

FEB 22 2012

WATER RESOURCES DEPT  
SALEM, OREGON



Geo-Spatial Solutions, Inc.

[www.geospatialolutions.com](http://www.geospatialolutions.com)

Date Created: July 20, 2004



1 inch equals 400 feet

**CLAIM OF BENEFICIAL USE  
Site Report**

# 9

Transfer Number: T -9587

District Internal Notice Number (DINN): 5856

Landowner Name: BARONE

Property Address: WILLOW PONDS SUBDIVISION, NO ADDRESS.

**Place of Use:**

*Enter one record for each portion of the taxlot that falls within a unique quarter-quarter. A single taxlot may have more than one legal description but may not if it falls entirely in a single quarter-quarter.*

USE	POD #	TWP	RNG	SEC	QQ	DLC	GOV'T LOT	TAX LOT	ACRES
IR	29	3N	10	34	SW/NE			500	.15

**District Conveyance System:**

Description of Delivery System:

Served by pressurized pipe 4" lateral from intersection of Post Canyon Road and Frankton Road.

Headgate Number: FRA15

Canal Name: Frankton

**Beneficial Use:**

Description of Beneficial Use: Landscaping on .05 acres. Lawn .10 acres.

Method Used to Apply Water: sprinkler

Method Used to Calculate Beneficial Use: Measured landscaping along May Drive on this lot, and Lawn area.

- The water right user has been interviewed
- The water right in question has been beneficially used as authorized

Please describe the beneficial use if less than authorized under the transfer:  
Use is evident.

Inspected by: Rick Brock

Date: 8/09/2006

Company: Farmers Irrigation District

**RECEIVED**

FEB 22 2012


WATER RESOURCES DEPT  
SALEM, OREGON

***Instructions:*** Attach and label the corresponding final proof map

# CLAIM OF BENEFICIAL USE

## T3N. R10 SECTION 34 SWNE

# 9

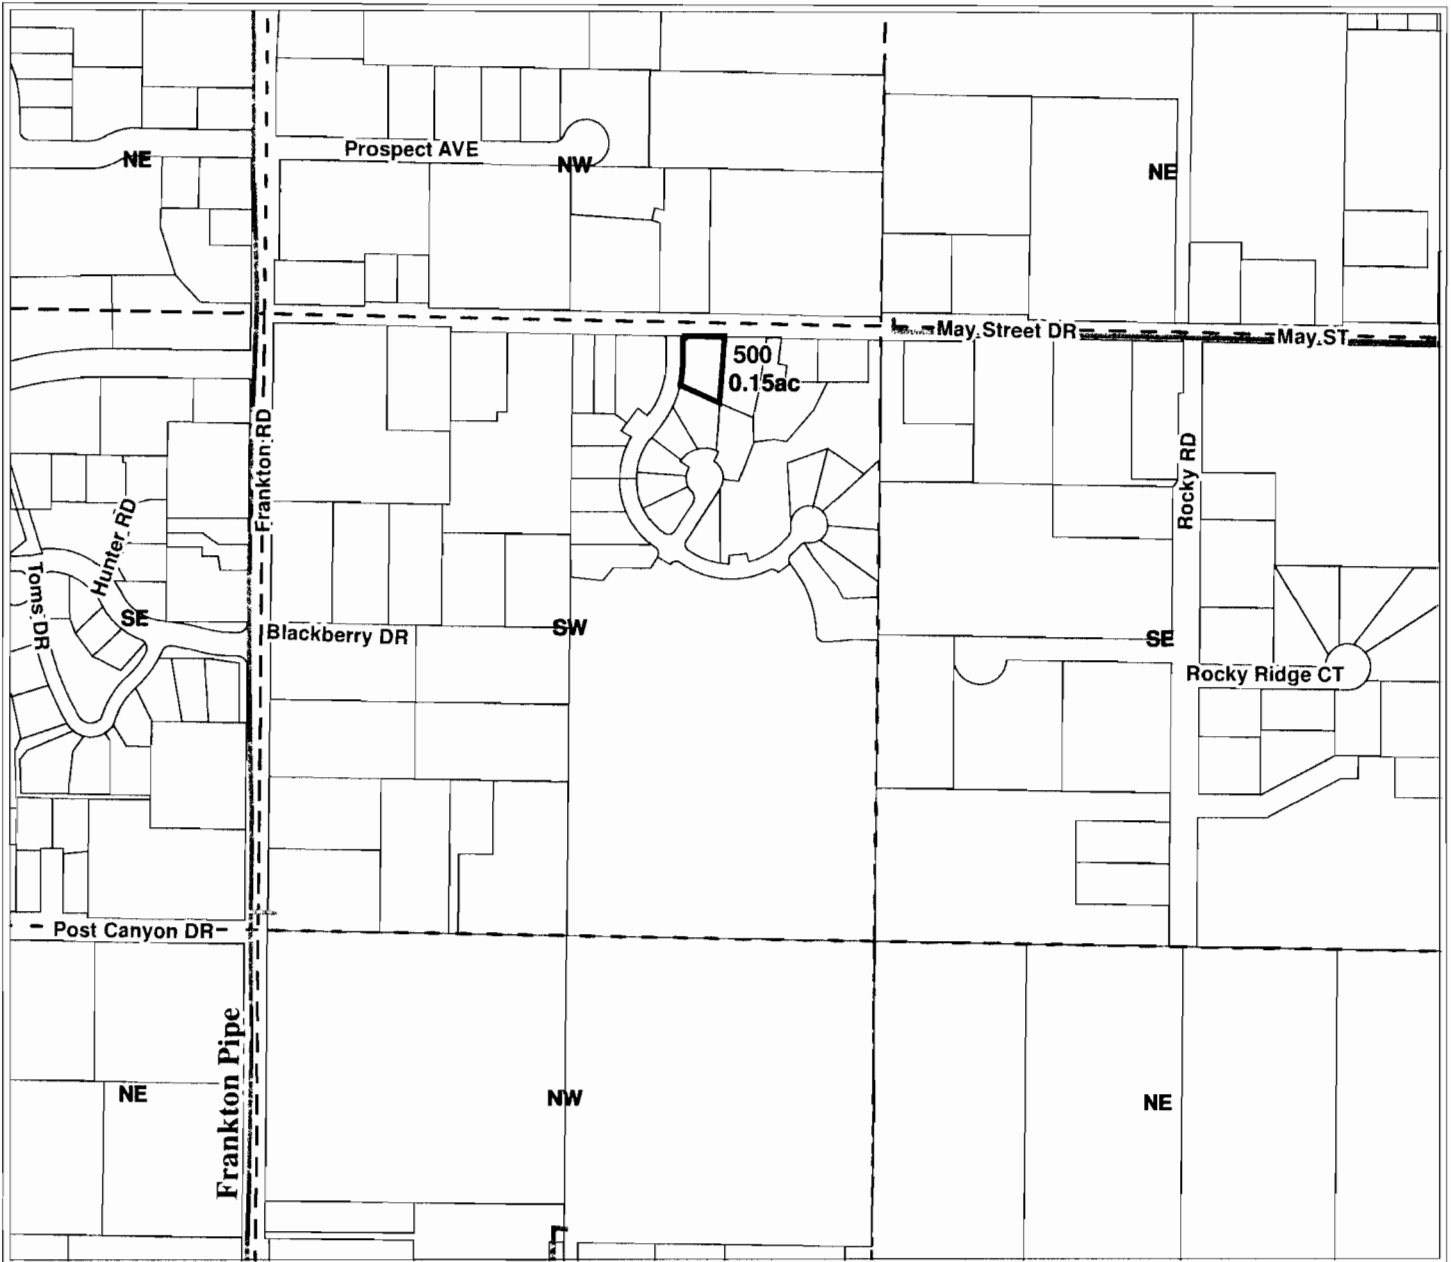

### UNMAPPED CLAIM OF BENEFICIAL USE FOR DISTRICT PERMANENT WATER RIGHT TRANSFER

**RECEIVED**

FEB 22 2012

WATER RESOURCES DEPT  
SALEM, OREGON




**Geo-Spatial Solutions, Inc.**

[www.geospatialolutions.com](http://www.geospatialolutions.com)

for  
**Barone**  
**Tax Lot 500 - 0.15 Acres**

**UnMapped Water Right**

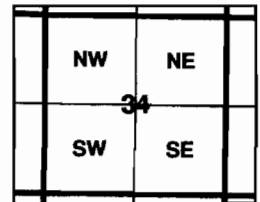

Date Created: August 1, 2005

1 inch equals 400 feet

**CLAIM OF BENEFICIAL USE  
Site Report**

Transfer Number: T -9587

District Internal Notice Number (DINN): 5857

#10

Landowner Name: BARONE

Property Address: 530 NINA LANE, HOOD RIVER OR 97031

**Place of Use:**

*Enter one record for each portion of the taxlot that falls within a unique quarter-quarter. A single taxlot may have more than one legal description but may not if it falls entirely in a single quarter-quarter.*

USE	POD #	TWP	RNG	SEC	QQ	DLC	GOV'T LOT	TAX LOT	ACRES
IR	29	3N	10	34	SW/NE			700	.25

**District Conveyance System:**

Description of Delivery System:

Served by pressurized pipe 4" lateral from the intersection of Frankton Road & Post Canyon Road.

Headgate Number: FRA15

Canal Name: Frankton

**Beneficial Use:**

Description of Beneficial Use: Lawn, Landscape

Method Used to Apply Water: Sprinkler, drip.

Method Used to Calculate Beneficial Use: On site inspection, Irrigation system and irrigable areas. Overlaid aerial imagery and calculated irrigated area.

- The water right user has been interviewed
- The water right in question has been beneficially used as authorized

Please describe the beneficial use if less than authorized under the transfer:

Inspected by: Rick Brock

Date: 3/13/2006

Company: Farmers Irrigation District

**RECEIVED**

FEB 22 2012

WATER RESOURCES DEPT  
SALEM, OREGON


***Instructions:*** Attach and label the corresponding final proof map



# APPLICATION FOR WATER RIGHT TRANSFER

T3N. R10 SECTION 34

CBU #10

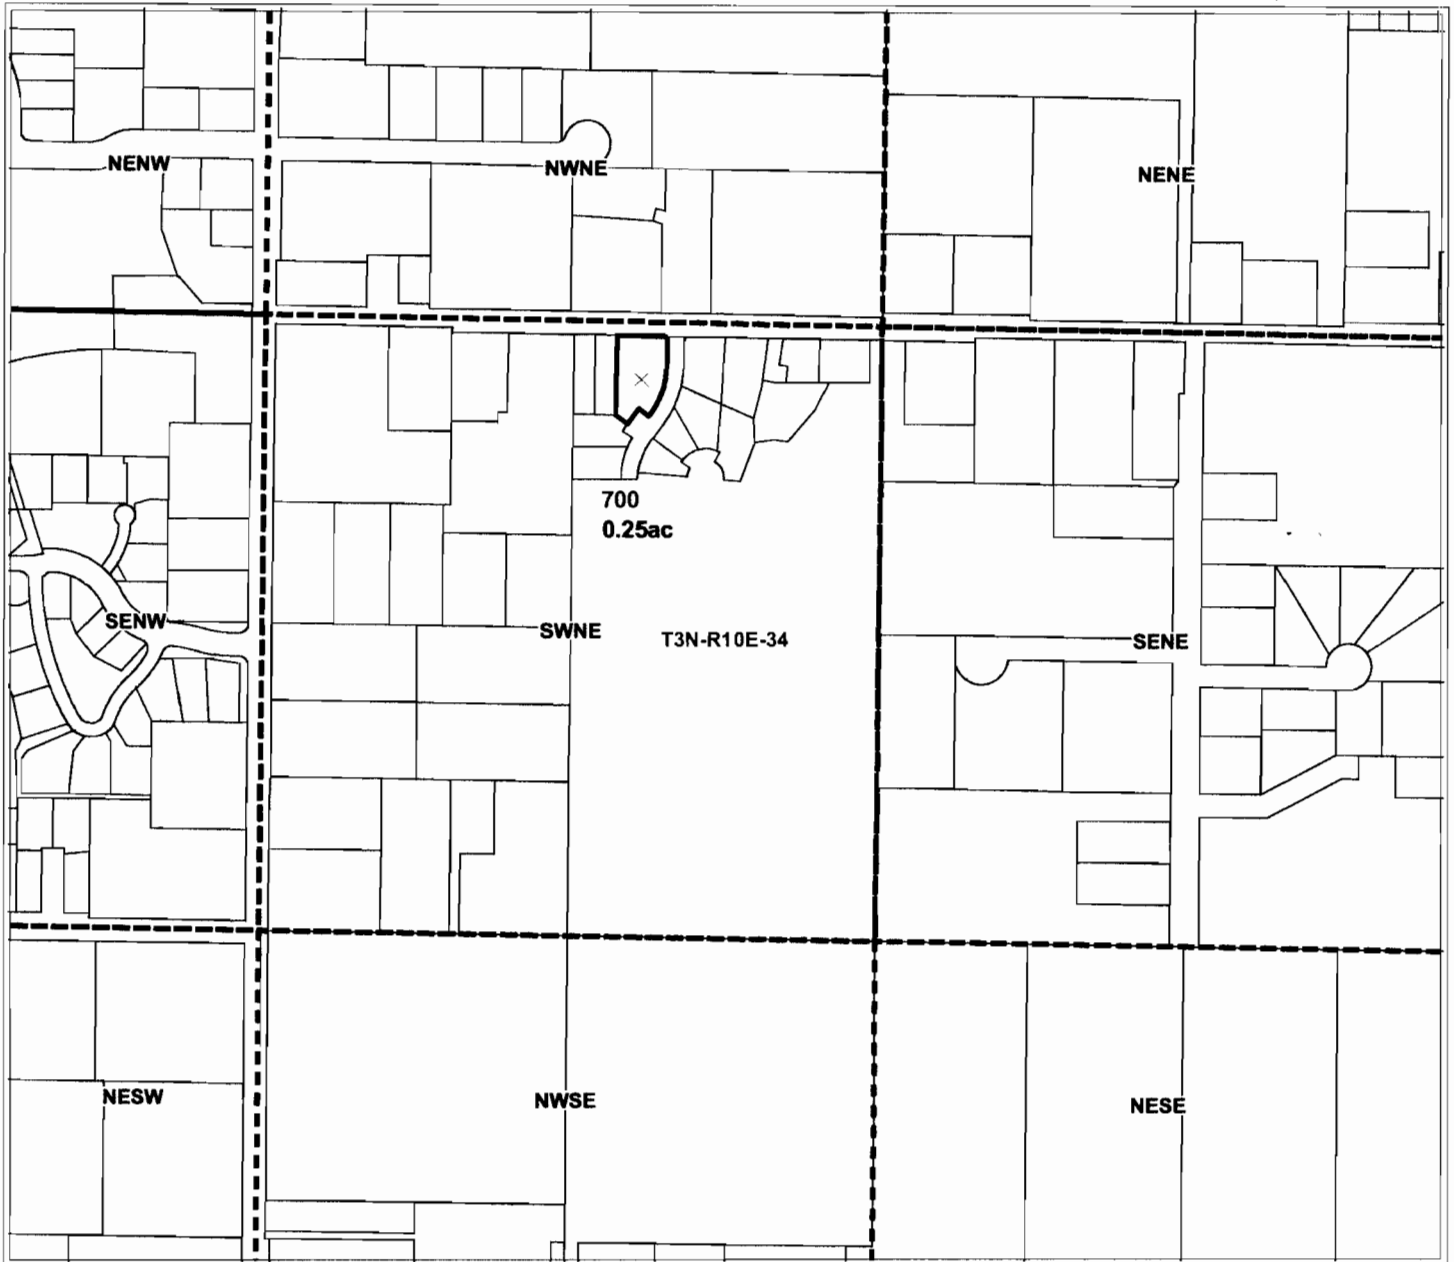

## APPLICATION FOR DISTRICT PERMANENT WATER RIGHT TRANSFER

for  
Barone  
Tax Lot 700 - 0.25 Acres

**RECEIVED**

FEB 22 2012

WATER RESOURCES DEPT  
SALEM, OREGON



**Geo-Spatial Solutions, Inc.**

[www.geospatialolutions.com](http://www.geospatialolutions.com)

Date Created: July 20, 2004



1 inch equals 400 feet

# CLAIM OF BENEFICIAL USE

## Site Report

Transfer Number: T -9587

District Internal Notice Number (DINN): 6011

Landowner Name: WASSON

# 11

Property Address: 3901 MAY STREET HOOD RIVER OR 97031

**Place of Use:**

*Enter one record for each portion of the taxlot that falls within a unique quarter-quarter. A single taxlot may have more than one legal description but may not if it falls entirely in a single quarter-quarter.*

USE	POD #	TWP	RNG	SEC	QQ	DLC	GOV'T LOT	TAX LOT	ACRES
IR	29	3N	10	34	SW/NE			800	.15

**District Conveyance System:**

Description of Delivery System:

Served by pressurized pipe 4" From intersection of Frankton Road & Post Canyon Road.

Headgate Number: FRA15

Canal Name: Frankton

**Beneficial Use:**

Description of Beneficial Use: Grass & Landscaping

Method Used to Apply Water: Sprinkler, drip

Method Used to Calculate Beneficial Use: On site inspection of irrigable areas, past use is evident. Overlaid with aerial imagery and verified irrigated area.

- The water right user has been interviewed
- The water right in question has been beneficially used as authorized

Please describe the beneficial use if less than authorized under the transfer:

Inspected by: Rick Brock

Date: 3/13/2006

Company: Farmers Irrigation District

RECEIVED

FEB 22 2012

WATER RESOURCES DEPT  
SALEM, OREGON

***Instructions:*** Attach and label the corresponding final proof map

# APPLICATION FOR WATER RIGHT TRANSFER

T3N. R10 SECTION 34 CBU #11



## APPLICATION FOR DISTRICT PERMANENT WATER RIGHT TRANSFER

for

Wasson

Tax Lot 800 - 0.15 Acres

**RECEIVED**

FEB 22 2012

WATER RESOURCES DEPT  
SALEM, OREGON



**Geo-Spatial Solutions, Inc.**

[www.geospatialolutions.com](http://www.geospatialolutions.com)

Date Created: August 03, 2004

1 inch equals 400 feet

**CLAIM OF BENEFICIAL USE  
Site Report**

Transfer Number: T -9587                      District Internal Notice Number (DINN): 6012

Landowner Name: WASSON

# 12

Property Address: 3901 MAY STREET HOOD RIVER OR 97031

**Place of Use:**

*Enter one record for each portion of the taxlot that falls within a unique quarter-quarter. A single taxlot may have more than one legal description but may not if it falls entirely in a single quarter-quarter.*

USE	POD #	TWP	RNG	SEC	QQ	DLC	GOV'T LOT	TAX LOT	ACRES
IR	29	3N	10	34	SW/NE			900	.1

**District Conveyance System:**

Description of Delivery System:

Served by pressurized pipe 4" lateral from intersection of Frankton Road & Post Canyon Road.

Headgate Number: FRA15

Canal Name: Frankton

**Beneficial Use:**

Description of Beneficial Use: Grass and landscaping

Method Used to Apply Water: Sprinkler

Method Used to Calculate Beneficial Use: Past use of irrigation water is evident on all irrigable areas. Overlaid with aerial imagery and verified irrigated area.

- The water right user has been interviewed
- The water right in question has been beneficially used as authorized

Please describe the beneficial use if less than authorized under the transfer:

Past use is evident

Inspected by: Rick Brock

Date: 3/13/2006

Company: Farmers Irrigation District

**RECEIVED**

FEB 22 2012

WATER RESOURCES DEPT  
SALEM, OREGON

***Instructions: Attach and label the corresponding final proof map***

# APPLICATION FOR WATER RIGHT TRANSFER

T3N. R10 SECTION 34 CBU # 12



## APPLICATION FOR DISTRICT PERMANENT WATER RIGHT TRANSFER

for

Wasson

Tax Lot 900 - 0.10 Acres

**RECEIVED**

FEB 22 2012

WATER RESOURCES DEPT  
SALEM, OREGON



**Geo-Spatial Solutions, Inc.**

[www.geospatialsolutions.com](http://www.geospatialsolutions.com)

Date Created: August 03, 2004



1 inch equals 400 feet

**CLAIM OF BENEFICIAL USE  
Site Report**

Transfer Number: T -9587

District Internal Notice Number (DINN): 5858

Landowner Name: BARONE

# 13

Property Address: WILLOW PONDS SUBDIVISION NO ADDRESS YET.

**Place of Use:**

*Enter one record for each portion of the taxlot that falls within a unique quarter-quarter. A single taxlot may have more than one legal description but may not if it falls entirely in a single quarter-quarter.*

USE	POD #	TWP	RNG	SEC	QQ	DLC	GOVT LOT	TAX LOT	ACRES
IR	29	3N	10	34	SW/NE			1000	.15

**District Conveyance System:**

Description of Delivery System:

Served by pressurized pipe 4" lateral from the intersection of Post Canyon Road and Frankton Road

Headgate Number: FRA15

Canal Name: Frankton

**Beneficial Use:**

Description of Beneficial Use: Lawn

Method Used to Apply Water: Hose and Sprinkler

Method Used to Calculate Beneficial Use: .85 gallon per minute sprinkler running, and has been moved over the .19 acre lot except where house is under construction.

- The water right user has been interviewed
- The water right in question has been beneficially used as authorized

Please describe the beneficial use if less than authorized under the transfer:  
Use is evident.

Inspected by: Rick Brock

Date: 8/9/2006

Company: Farmers Irrigation District

**RECEIVED**


FEB 22 2012

WATER RESOURCES DEPT  
SALEM, OREGON

***Instructions:*** Attach and label the corresponding final proof map

**CLAIM OF BENEFICIAL USE**  
**T3N. R10 SECTION 34 SWNE**

# 13

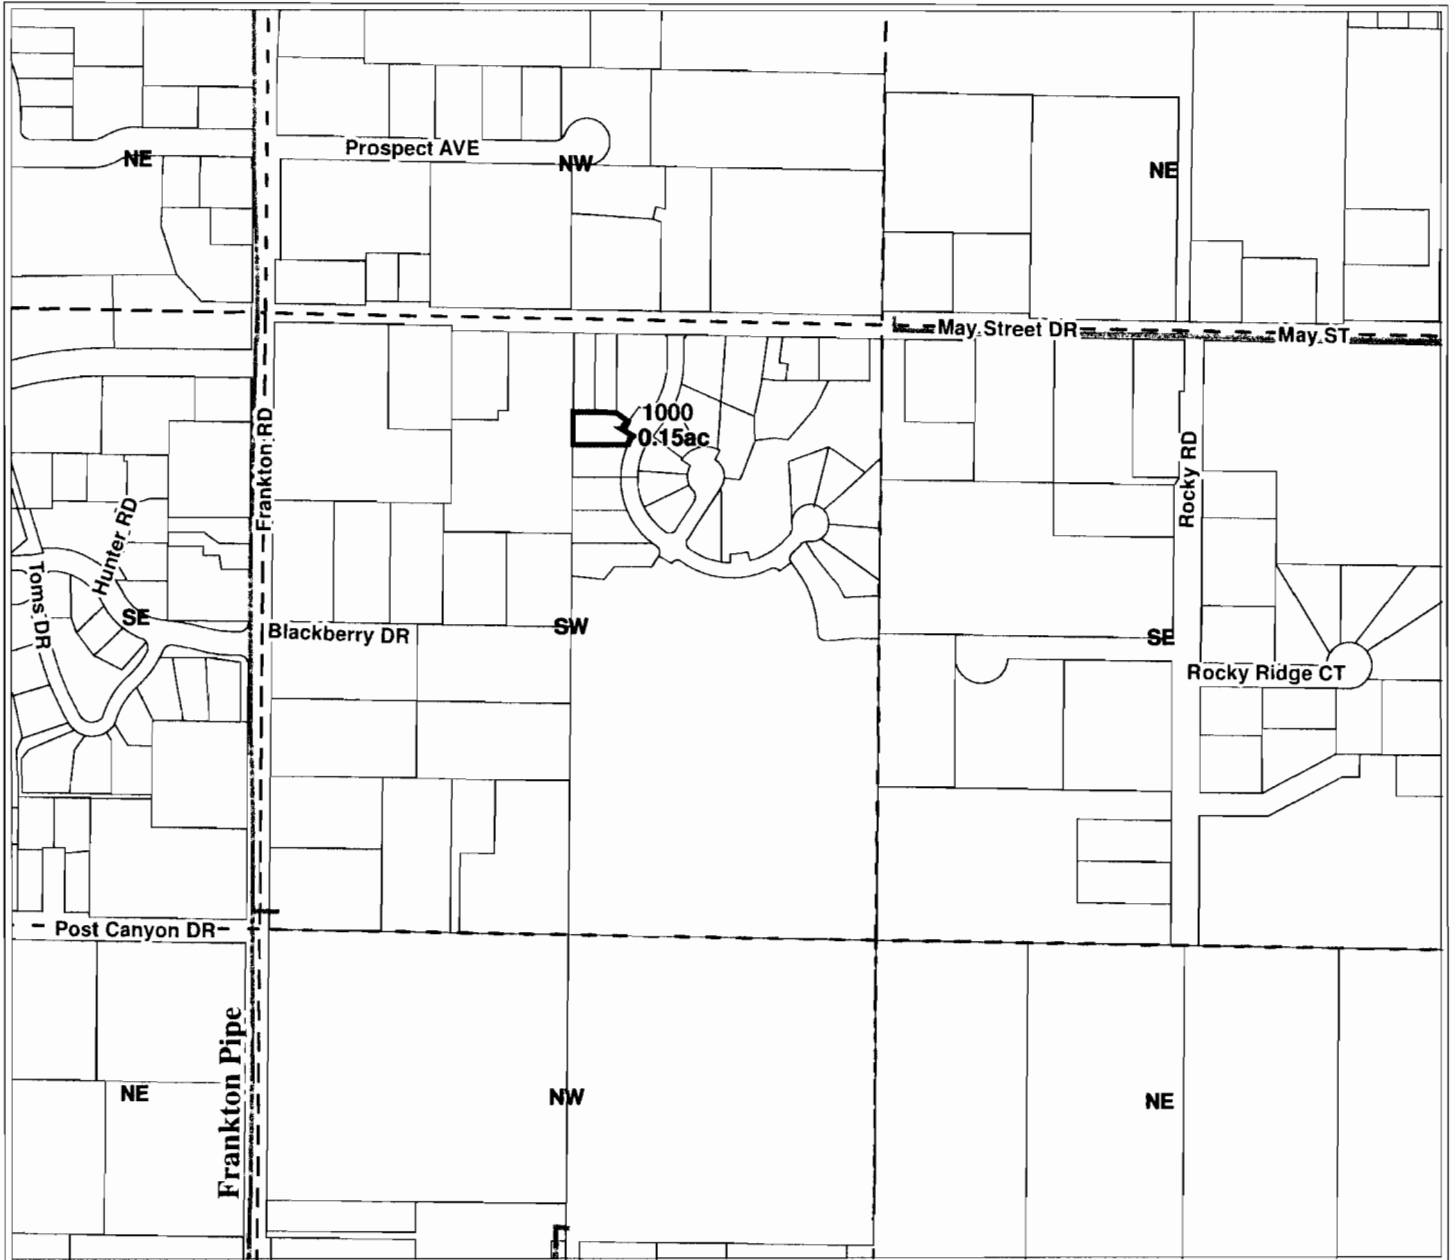

**UNMAPPED CLAIM OF BENEFICIAL USE**  
**FOR DISTRICT PERMANENT WATER RIGHT TRANSFER**

for  
**Barone**

**Tax Lot 1000 - 0.15 Acres**

**RECEIVED**

FEB 22 2012

WATER RESOURCES DEPT




**Geo-Spatial Solutions, Inc.**

[www.geospatialolutions.com](http://www.geospatialolutions.com)



**UnMapped Water Right**

Date Created: August, 2006

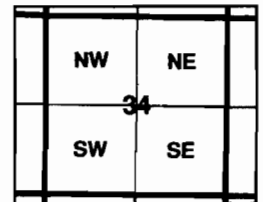

1 inch equals 400 feet

**CLAIM OF BENEFICIAL USE  
Site Report**

# 14

Transfer Number: T -9587

District Internal Notice Number (DINN): 5859

Landowner Name: BARONE

Property Address: P.O. BOX 1161 HOOD RIVER OR 97031 IN WILLOW PONDS

SUBDIVISION.

**Place of Use:**

*Enter one record for each portion of the taxlot that falls within a unique quarter-quarter. A single taxlot may have more than one legal description but may not if it falls entirely in a single quarter-quarter.*

USE	POD #	TWP	RNG	SEC	QQ	DLC	GOV'T LOT	TAX LOT	ACRES
IR	29	3N	10	34	SW/NE			1100	.15

**District Conveyance System:**

Description of Delivery System:

Served by pressurized pipe 4" lateral from intersection of Frankton Road & Post Canyon Drive.

Headgate Number: FRA15

Canal Name: Frankton

**Beneficial Use:**

Description of Beneficial Use: Lawn and landscaping

Method Used to Apply Water: Hose and Sprinkler.

Method Used to Calculate Beneficial Use: .85 gallon per minute sprinkler running and has been moved around this still vacant .20 acre lot.

- The water right user has been interviewed
- The water right in question has been beneficially used as authorized

Please describe the beneficial use if less than authorized under the transfer:

Use is evident

**RECEIVED**

FEB 22 2012

Inspected by: Rick Brock

Date: 8/9/2006

WATER RESOURCES DEPT  
SALEM, OREGON

Company: Farmers Irrigation District


***Instructions:*** Attach and label the corresponding final proof map



# CLAIM OF BENEFICIAL USE

## T3N. R10 SECTION 34 SWNE

# 14

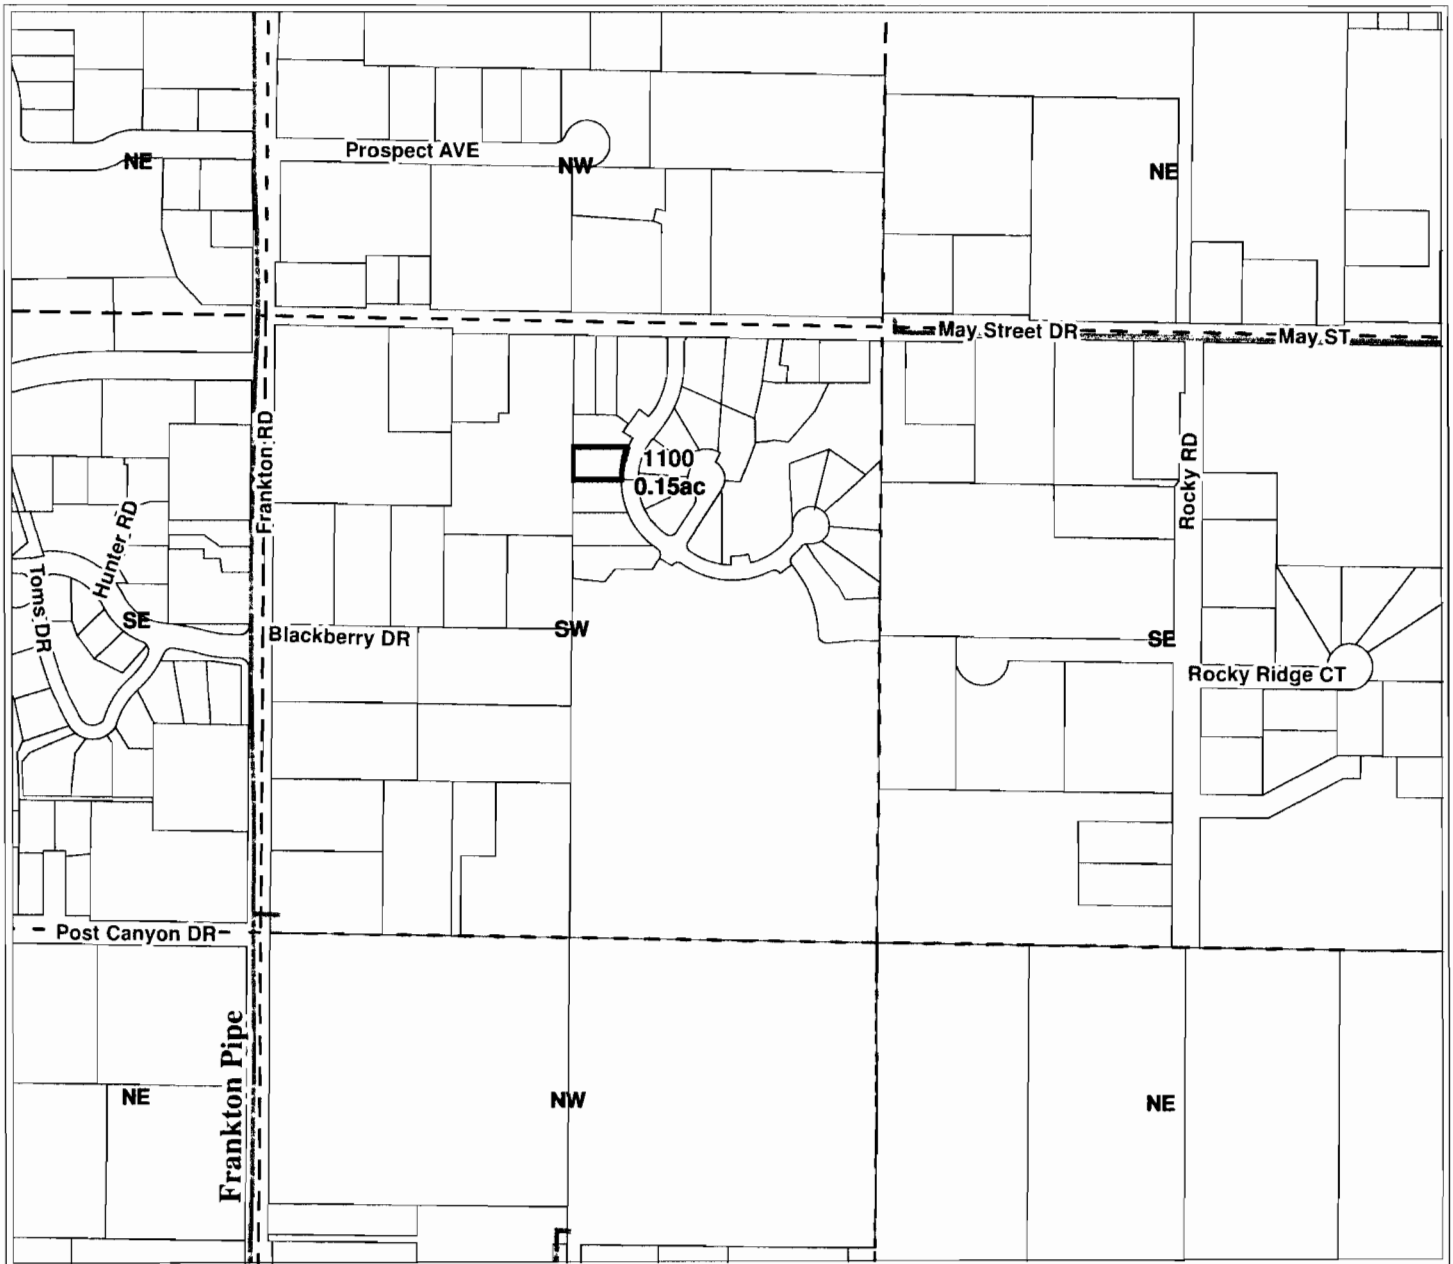

### UNMAPPED CLAIM OF BENEFICIAL USE FOR DISTRICT PERMANENT WATER RIGHT TRANSFER

**RECEIVED**

FEB 22 2012

WATER RESOURCES DEPT  
SALEM, OREGON



**Geo-Spatial Solutions, Inc.**


[www.geospatialolutions.com](http://www.geospatialolutions.com)

for  
**Barone**

**Tax Lot 1100 - 0.15 Acres**



**UnMapped Water Right**

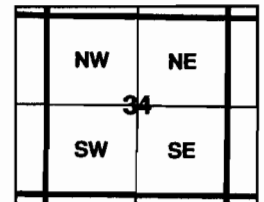

1 inch equals 400 feet

Date Created: August, 2006

**CLAIM OF BENEFICIAL USE  
Site Report**

# 15

Transfer Number: T -9587

District Internal Notice Number (DINN): 5860

Landowner Name: BARONE

Property Address: 549 NINA LANE HOOD RIVER OR 97031.

**Place of Use:**

*Enter one record for each portion of the taxlot that falls within a unique quarter-quarter. A single taxlot may have more than one legal description but may not if it falls entirely in a single quarter-quarter.*

USE	POD #	TWP	RNG	SEC	QQ	DLC	GOV'T LOT	TAX LOT	ACRES
IR	29	3N	10	34	SW/NE			1200	.1

**District Conveyance System:**

Description of Delivery System:

Served by pressurized pipe 4" lateral From intersection of Frankton Road & Post Canyon Road.

Headgate Number: FRA15

Canal Name: Frankton

**Beneficial Use:**

Description of Beneficial Use: Landscaping

Method Used to Apply Water: Underground system.

Method Used to Calculate Beneficial Use: Measured landscaping.

- The water right user has been interviewed
- The water right in question has been beneficially used as authorized

Please describe the beneficial use if less than authorized under the transfer:

Use is evident.

Inspected by: Rick Brock

Date: 8/09/2006

Company: Farmers Irrigation District

***Instructions:*** Attach and label the corresponding final proof map


**RECEIVED**

FEB 22 2012

WATER RESOURCES DEPT  
SALEM, OREGON

**CLAIM OF BENEFICIAL USE**  
**T3N. R10 SECTION 34 SWNE**

# 15

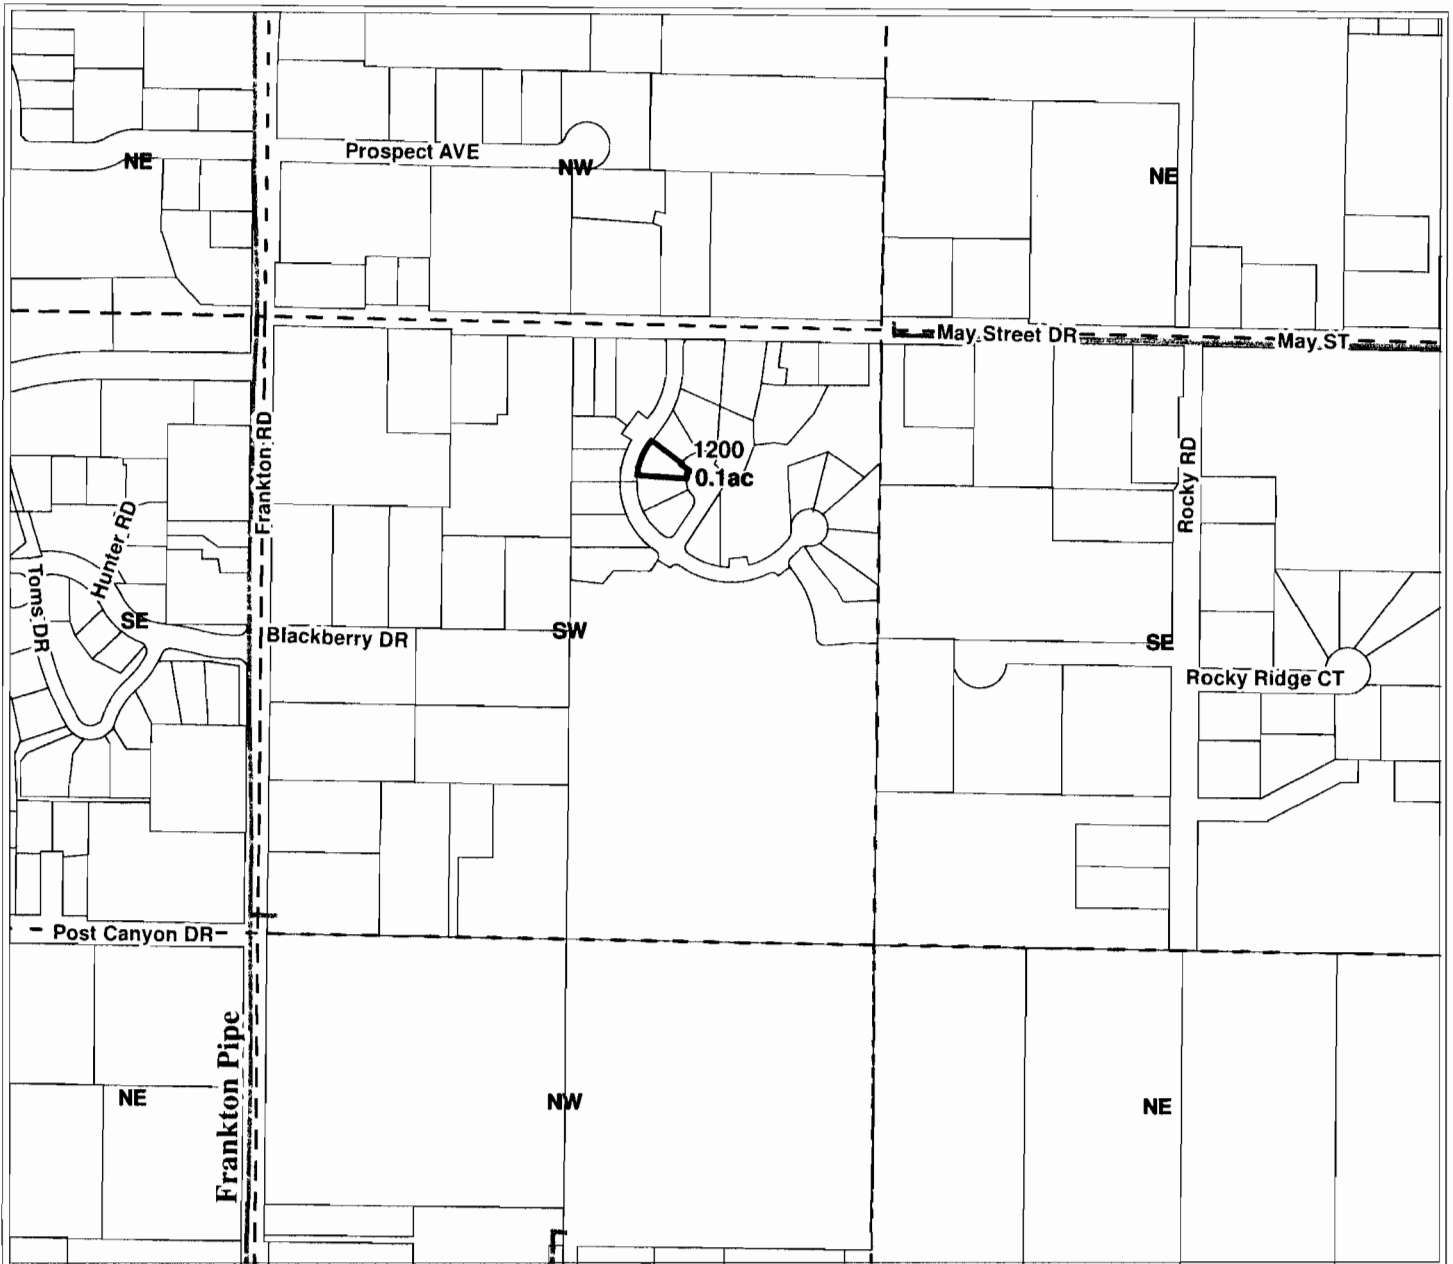

**UNMAPPED CLAIM OF BENEFICIAL USE**  
**FOR DISTRICT PERMANENT WATER RIGHT TRANSFER**  
**RECEIVED**

FEB 22 2012

WATER RESOURCES DEPT  
 SALEM, OREGON



**Geo-Spatial Solutions, Inc.**  
 www.geospatialsolutions.com

for  
**Barone**  
**Tax Lot 1200 - 0.1 Acres**

 **UnMapped Water Right**

NW	NE
34	
SW	SE



1 inch equals 400 feet

Date Created: August, 2006

**CLAIM OF BENEFICIAL USE  
Site Report**

#16

Transfer Number: T -9587

District Internal Notice Number (DINN): 5861

Landowner Name: BARONE

Property Address: WILLOW PONDS SUBDIVISION, NO ADDRESS YET.

**Place of Use:**

*Enter one record for each portion of the taxlot that falls within a unique quarter-quarter. A single taxlot may have more than one legal description but may not if it falls entirely in a single quarter-quarter.*

USE	POD #	TWP	RNG	SEC	QQ	DLC	GOV'T LOT	TAX LOT	ACRES
IR	29	3N	10	34	SW/NE			1300	.1

**District Conveyance System:**

Description of Delivery System:

Served by pressurized pipe 4" lateral from intersection of Frankton Road & Post Canyon.

Headgate Number: FRA15

Canal Name: Frankton

**Beneficial Use:**

Description of Beneficial Use: Grass & landscape

Method Used to Apply Water: Sprinkler, drip

Method Used to Calculate Beneficial Use: Measurement of lawn and landscaping.

- The water right user has been interviewed
- The water right in question has been beneficially used as authorized

Please describe the beneficial use if less than authorized under the transfer:

Use is evident.

Inspected by: Rick Brock

Date: 8/9/2006

Company: Farmers Irrigation District

***Instructions:*** Attach and label the corresponding final proof map


**RECEIVED**

FEB 22 2012

WATER RESOURCES DEPT  
SALEM, OREGON

**CLAIM OF BENEFICIAL USE**  
**T3N. R10 SECTION 34 SWNE**

# 16

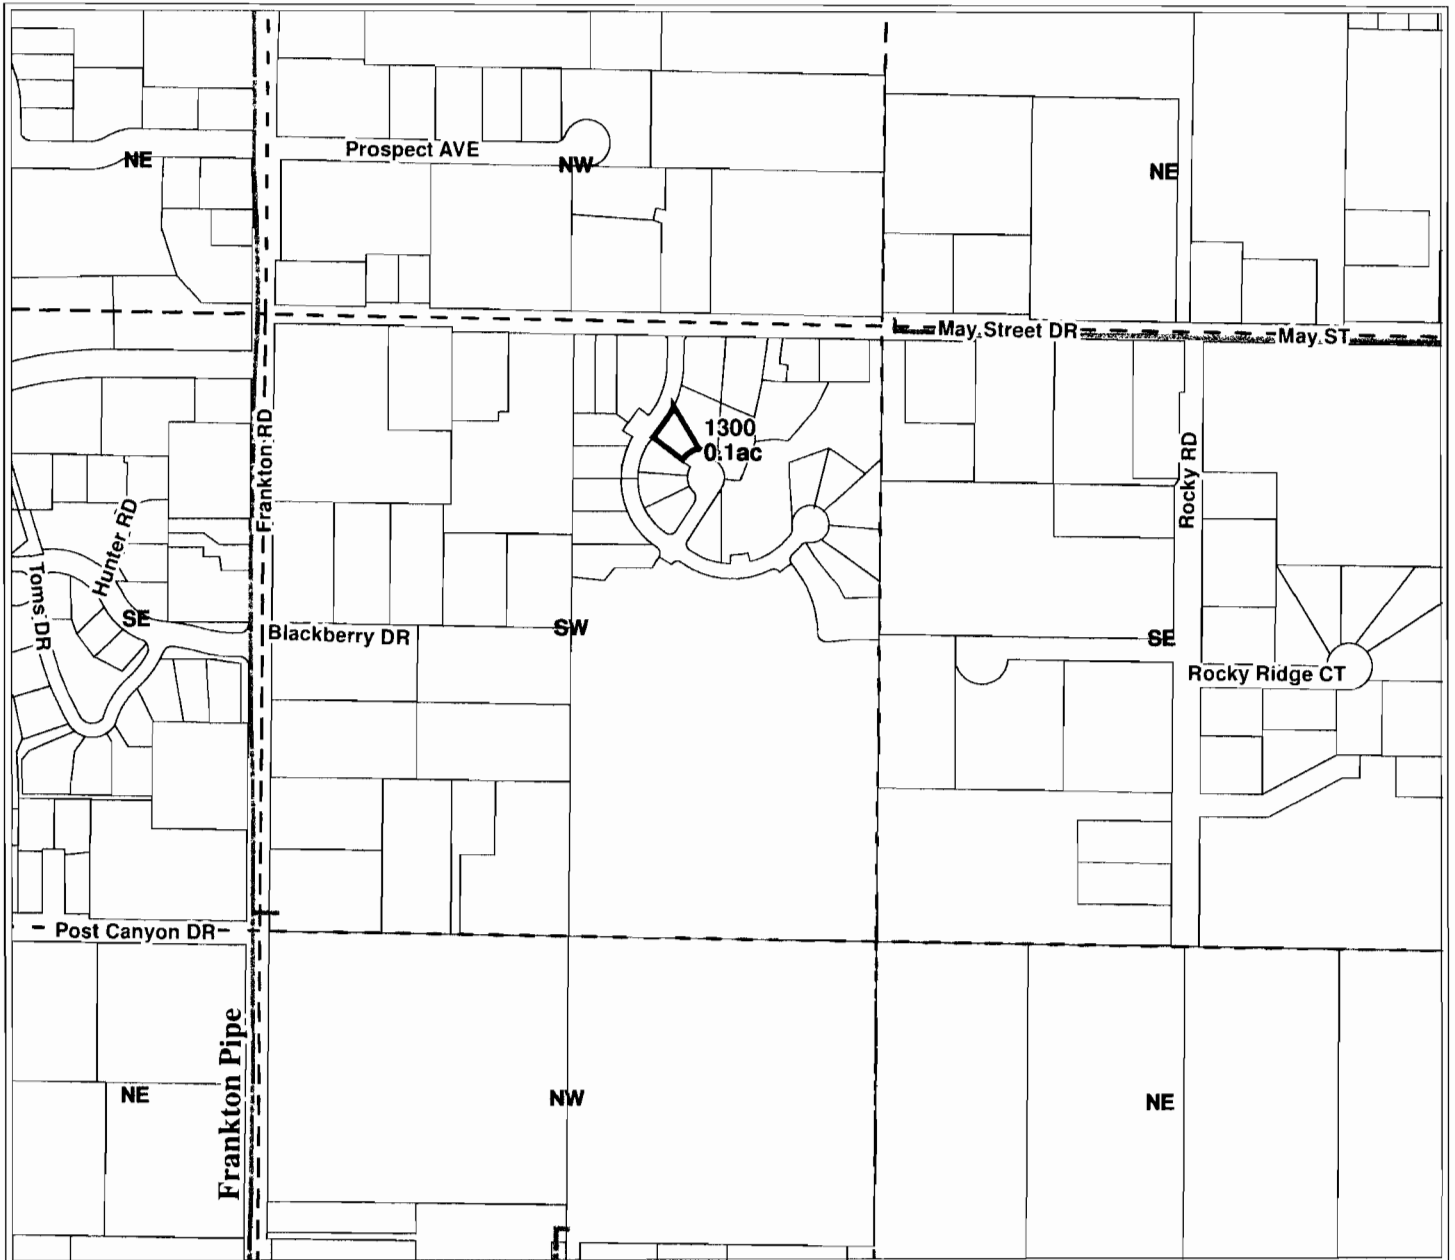

**UNMAPPED CLAIM OF BENEFICIAL USE**

**RECEIVED**

**FOR DISTRICT PERMANENT WATER RIGHT TRANSFER**

for

**Barone**

**Tax Lot 1300 - 0.1 Acres**

FEB 22 2012

WATER RESOURCES DEPT  
 SALEM, OREGON



**Geo-Spatial Solutions, Inc.**

[www.geospatialolutions.com](http://www.geospatialolutions.com)



**Un Mapped Water Right**

NW	NE
34	
SW	SE



1 inch equals 400 feet

Date Created: August, 2006

**CLAIM OF BENEFICIAL USE  
Site Report**

# 17

Transfer Number: T -9587

District Internal Notice Number (DINN): 5862

Landowner Name: BARONE

Property Address: WILLOW PONDS SUBDIVISION OWNER 684 PARSONS ROAD HOOD  
RIVER OR. 97031

**Place of Use:**

*Enter one record for each portion of the taxlot that falls within a unique quarter-quarter. A single taxlot may have more than one legal description but may not if it falls entirely in a single quarter-quarter.*

USE	POD #	TWP	RNG	SEC	QQ	DLC	GOV'T LOT	TAX LOT	ACRES
IR	29	3N	10	34	SW/NE			1400	.15

**District Conveyance System:**

Description of Delivery System:

Served by pressurized pipe 4" lateral From the intersection of Frankton Road & Post Canyon Drive.

Headgate Number: FRA15

Canal Name: Frankton

**Beneficial Use:**

Description of Beneficial Use: Grass and Landscaping

Method Used to Apply Water: Underground system.

Method Used to Calculate Beneficial Use: Measurement of grass and landscaping.

- The water right user has been interviewed
- The water right in question has been beneficially used as authorized

Please describe the beneficial use if less than authorized under the transfer:

Use is evident.

Inspected by: Rick Brock

Date: 8/13/2006

Company: Farmers Irrigation District

**RECEIVED**

FEB 22 2012


WATER RESOURCES DEPT  
SALEM, OREGON

***Instructions: Attach and label the corresponding final proof map***

# CLAIM OF BENEFICIAL USE

## T3N. R10 SECTION 34 SWNE

# 17

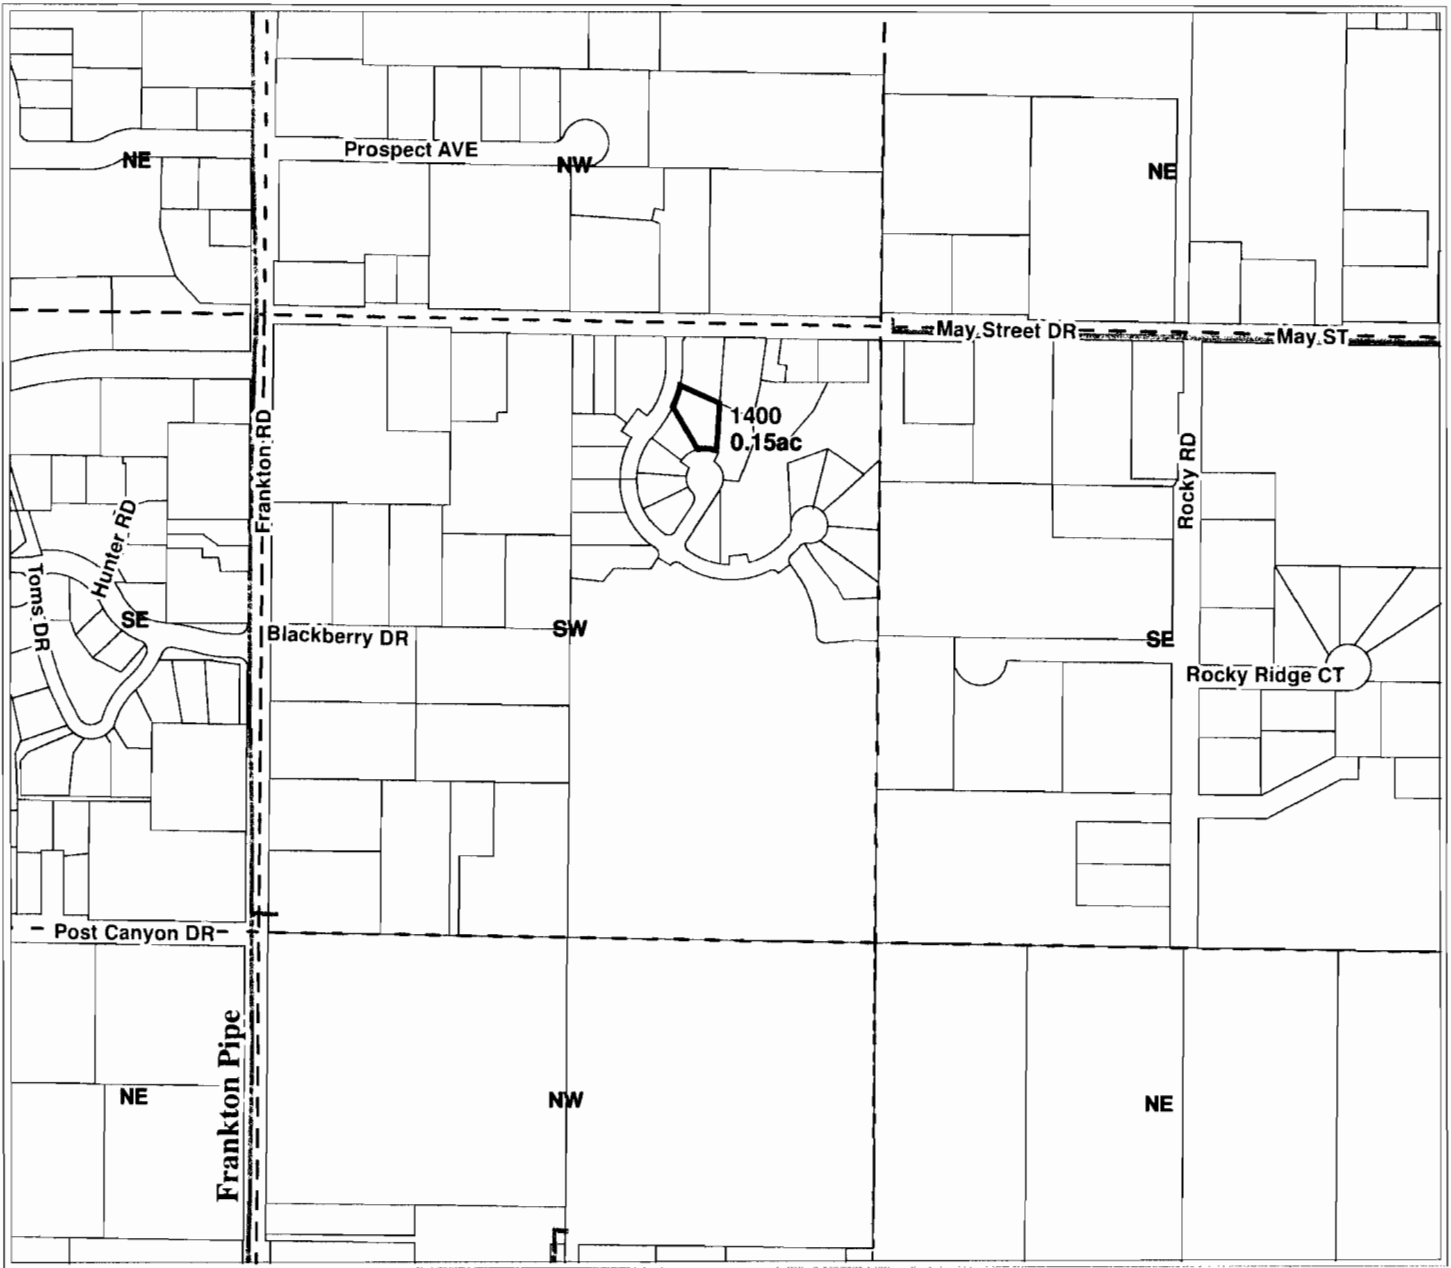

### UNMAPPED CLAIM OF BENEFICIAL USE FOR DISTRICT PERMANENT WATER RIGHT TRANSFER

**RECEIVED**

FEB 22 2012

WATER RESOURCES DEPT  
SALEM, OREGON




**Geo-Spatial Solutions, Inc.**

[www.geospatialolutions.com](http://www.geospatialolutions.com)

for  
**Barone**  
**Tax Lot 1400 - 0.15 Acres**

 **Un Mapped Water Right**

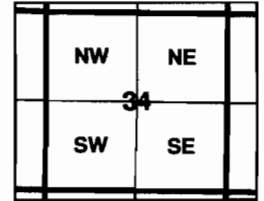

1 inch equals 400 feet

Date Created: August, 2006

**CLAIM OF BENEFICIAL USE  
Site Report**

# 18

Transfer Number: T -9587

District Internal Notice Number (DINN): 5863

Landowner Name: BARONE

Property Address: OWNER 19418 CARTMILL DRIVE BEND OR 97702, WILLOW PONDS  
SUBDIVISION.

**Place of Use:**

*Enter one record for each portion of the taxlot that falls within a unique quarter-quarter. A single taxlot may have more than one legal description but may not if it falls entirely in a single quarter-quarter.*

USE	POD #	TWP	RNG	SEC	QQ	DLC	GOV'T LOT	TAX LOT	ACRES
IR	29	3N	10	34	SW/NE			1500	.1

**District Conveyance System:**

Description of Delivery System:

Served by pressurized pipe 4" lateral from intersection of Frankton Road & Post Canyon Drive.

Headgate Number: FRA15

Canal Name: Frankton

**Beneficial Use:**

Description of Beneficial Use: Lawn, Landscaping

Method Used to Apply Water: Sprinkler, drip

Method Used to Calculate Beneficial Use: On site inspeciton, checked irrigable areas past use is evident. Overlaid with aerial imagery and calculated irrigated area.

- The water right user has been interviewed
- The water right in question has been beneficially used as authorized

Please describe the beneficial use if less than authorized under the transfer:

Inspected by: Rick Brock

Date: 3/13/2006

Company: Farmers Irrigation District

**RECEIVED**  
FEB 22 2012  
WATER RESOURCES DEPT  
SALEM, OREGON


***Instructions: Attach and label the corresponding final proof map***



# APPLICATION FOR WATER RIGHT TRANSFER

T3N. R10 SECTION 34

CBU #18

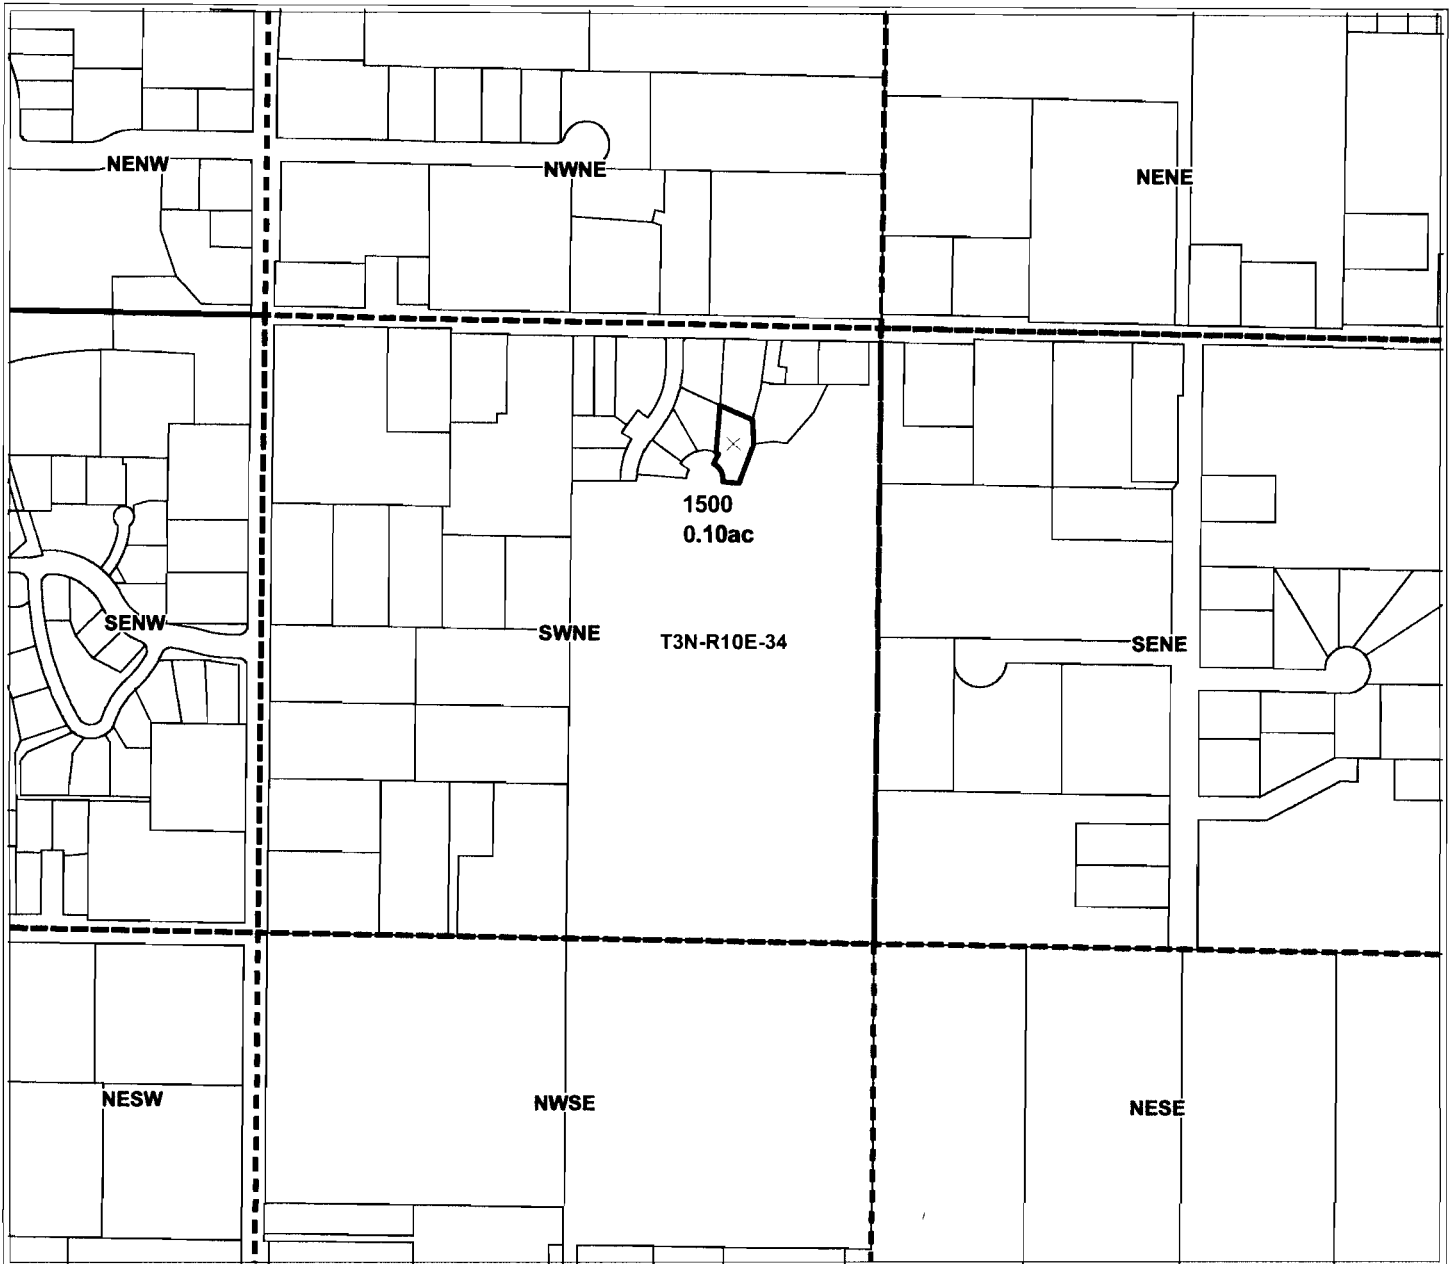

## APPLICATION FOR DISTRICT PERMANENT WATER RIGHT TRANSFER

**RECEIVED**

FEB 22 2012

WATER RESOURCES DEPT  
SALEM, OREGON



**Geo-Spatial Solutions, Inc.**

[www.geospatialolutions.com](http://www.geospatialolutions.com)

for

**Barone**

**Tax Lot 1500 - 0.10 Acres**

Date Created: July 20, 2004



1 inch equals 400 feet

**CLAIM OF BENEFICIAL USE  
Site Report**

# 19

Transfer Number: T -9587

District Internal Notice Number (DINN): 5852

Landowner Name: BARONE

Property Address: OWNER 3875 MAY STREET HOOD RIVER OR 97031, WILLOW PONDS

SUBDIVISION

**Place of Use:**

*Enter one record for each portion of the taxlot that falls within a unique quarter-quarter. A single taxlot may have more than one legal description but may not if it falls entirely in a single quarter-quarter.*

USE	POD #	TWP	RNG	SEC	QQ	DLC	GOV'T LOT	TAX LOT	ACRES
IR	29	3N	10	34	SW/NE			1600	.25

**District Conveyance System:**

Description of Delivery System:

Served by pressurized pipe 4" lateral from intersection of Frankton Road & Post Canyon Road

Headgate Number: FRA15

Canal Name: Frankton

**Beneficial Use:**

Description of Beneficial Use: Landscaping, yard

Method Used to Apply Water: Sprinkler, drip

Method Used to Calculate Beneficial Use: On site inspection of irrigable areas, use is evident. Overlaid with aerial imagery and calculated irrigated area.

- The water right user has been interviewed
- The water right in question has been beneficially used as authorized

Please describe the beneficial use if less than authorized under the transfer:

Past use is evident, more landscaping is on-going

Inspected by: Rick Brock

Date: 3/13/2006

Company: Farmers Irrigation District


**RECEIVED**  
 FEB 22 2012  
 WATER RESOURCES DEPT  
 SALEM, OREGON

**Instructions:** Attach and label the corresponding final proof map

# APPLICATION FOR WATER RIGHT TRANSFER

T3N. R10 SECTION 34

CBU # 19

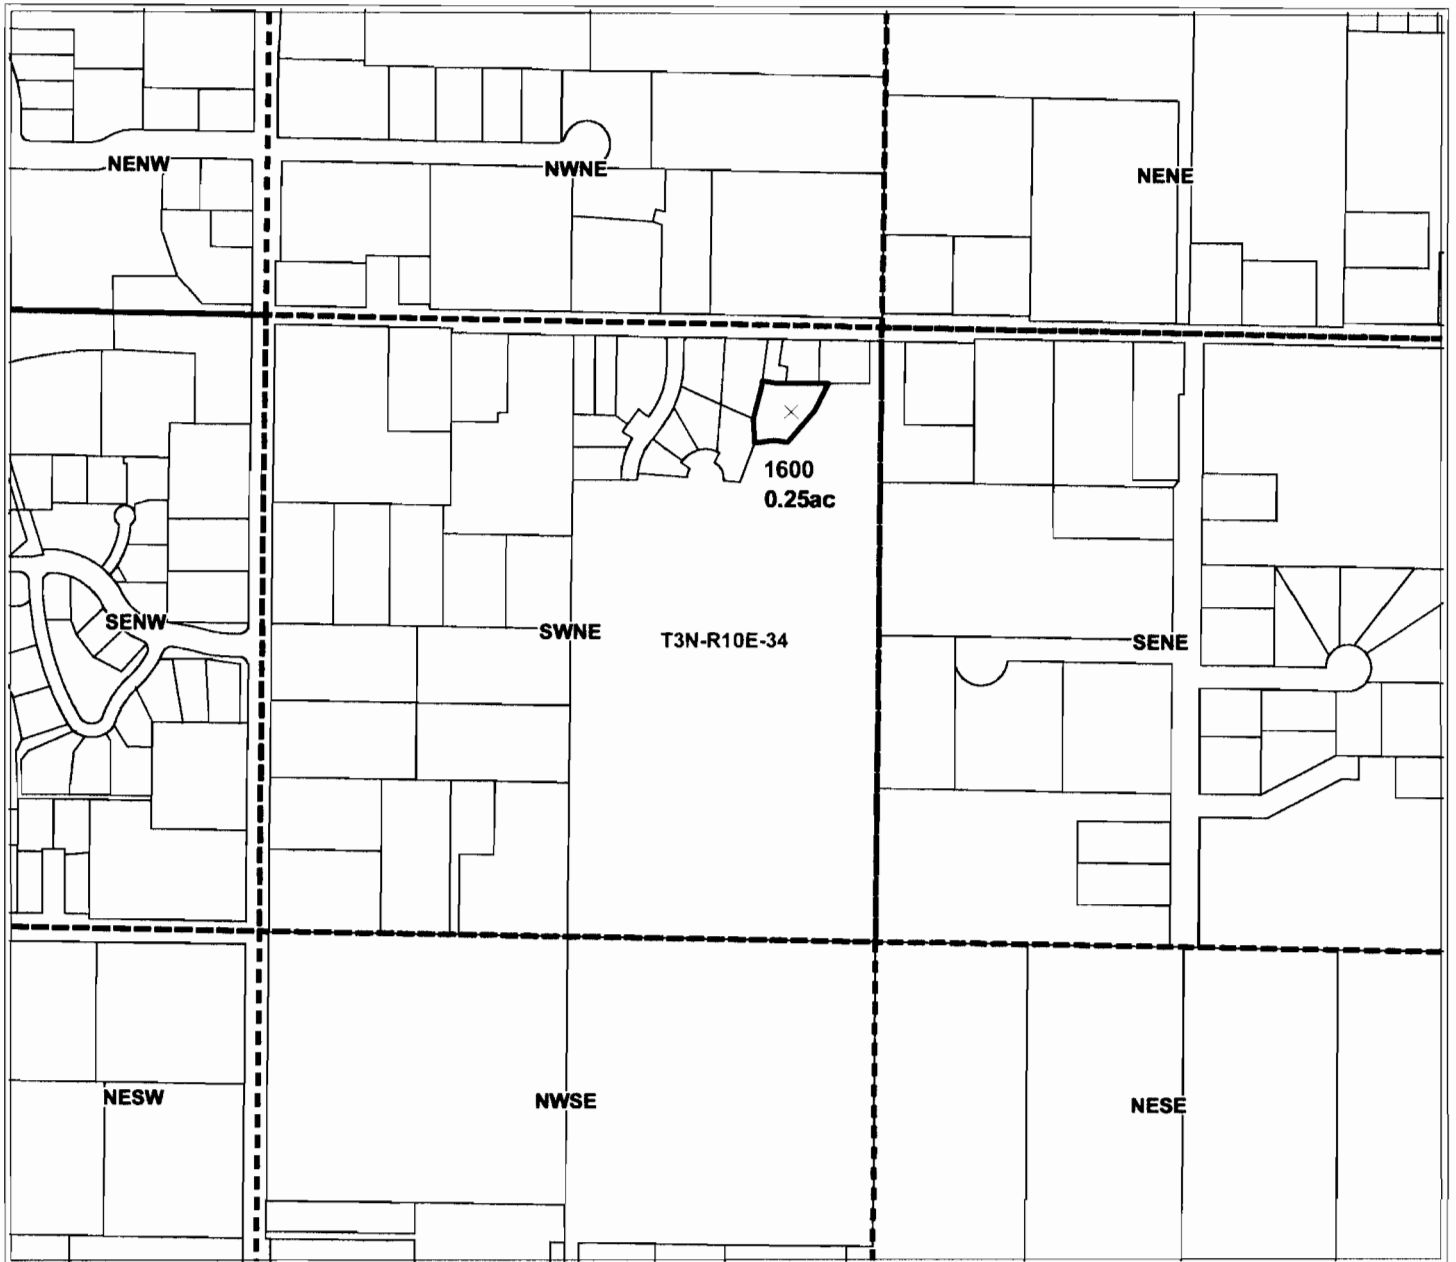

## APPLICATION FOR DISTRICT PERMANENT WATER RIGHT TRANSFER

for

Barone

Tax Lot 1600 - 0.25 Acres

**RECEIVED**

FEB 22 2012

WATER RESOURCES DEPT  
SALEM, OREGON



**Geo-Spatial Solutions, Inc.**

[www.geospatialsolutions.com](http://www.geospatialsolutions.com)

Date Created: July 20, 2004

1 inch equals 400 feet

**CLAIM OF BENEFICIAL USE  
Site Report**

Transfer Number: T -9587

District Internal Notice Number (DINN): 5852

Landowner Name: BARONE

#20

Property Address: WILLOW PONDS SUBDIVISION

**Place of Use:**

*Enter one record for each portion of the taxlot that falls within a unique quarter-quarter. A single taxlot may have more than one legal description but may not if it falls entirely in a single quarter-quarter.*

USE	POD #	TWP	RNG	SEC	QQ	DLC	GOV'T LOT	TAX LOT	ACRES
IR	29	3N	10	34	SW/NE			2100	13

**District Conveyance System:**

Description of Delivery System:

Served by pressurized pipe 4" lateral from intersection of Frankton Road & Post Canyon Drive.

Headgate Number: FRA15

Canal Name: Frankton

**Beneficial Use:**

Description of Beneficial Use: Grass

Method Used to Apply Water: 12, rainbird sprinklers running with 11/64 nozzle,

Method Used to Calculate Beneficial Use: On site visit measured nozzels and pressure, 50 psi, use is about 72.5 gallon per minute.

- The water right user has been interviewed
- The water right in question has been beneficially used as authorized

Please describe the beneficial use if less than authorized under the transfer:

Use is evident.

Inspected by: Rick Brock

Date: 8/9/2006

Company: Farmers Irrigation District

***Instructions:*** Attach and label the corresponding final proof map


**RECEIVED**

FEB 22 2012

WATER RESOURCES DEPT  
SALEM, OREGON

**CLAIM OF BENEFICIAL USE**  
**T3N. R10 SECTION 34 SWNE**

#20

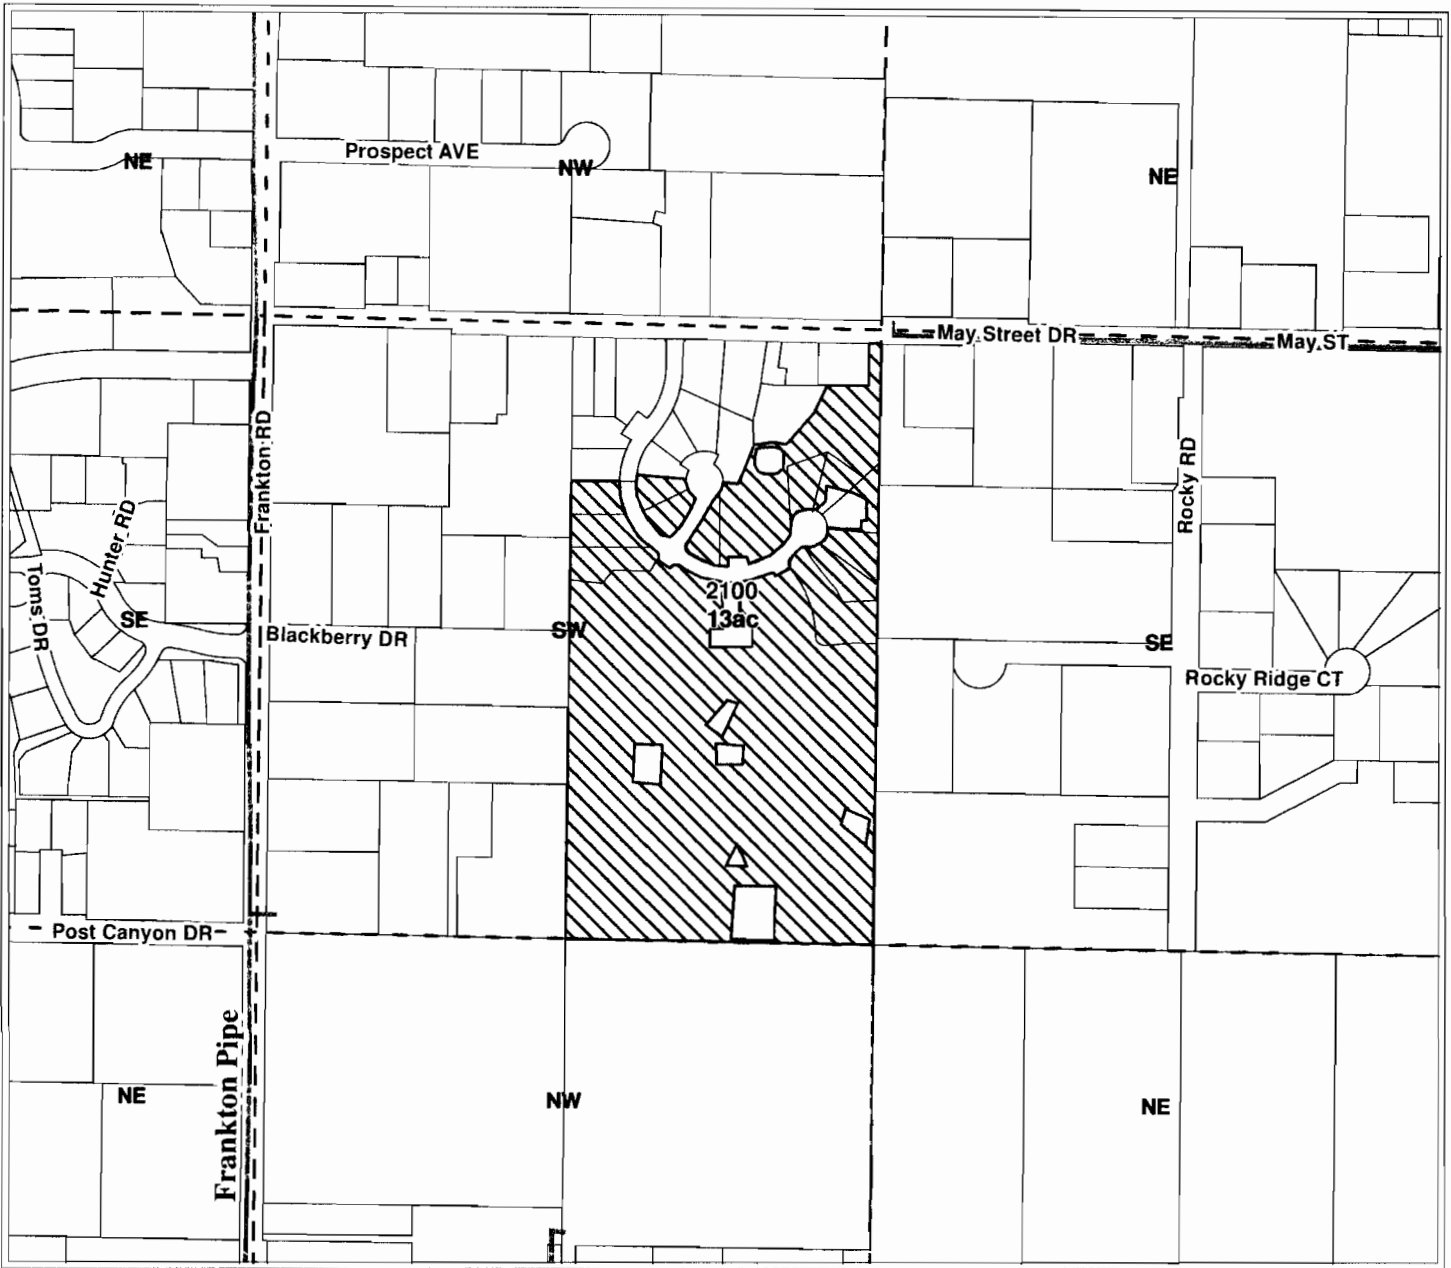

**CLAIM OF BENEFICIAL USE**

**RECEIVED**


**DISTRICT PERMANENT WATER RIGHT TRANSFER**

for

**Barone**

**Tax Lot 2100 - 13 Acres**  
**(Lot has been subdivided)**

FEB 22 2012  
 WATER RESOURCES DEPT  
 SALEM, OREGON

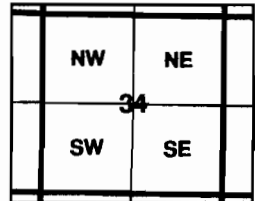

 **Mapped Water Right**



**Geo-Spatial Solutions, Inc.**  
[www.geospatialsolutions.com](http://www.geospatialsolutions.com)



Date Created: August, 2006

1 inch equals 400 feet

**CLAIM OF BENEFICIAL USE  
Site Report**

Transfer Number: T -9587

District Internal Notice Number (DINN): 5771

# 21

Landowner Name: LOZOWSKI

Property Address: 421 COUNTRY CLUB ROAD, HOOD RIVER OR 97031

**Place of Use:**

*Enter one record for each portion of the taxlot that falls within a unique quarter-quarter. A single taxlot may have more than one legal description but may not if it falls entirely in a single quarter-quarter.*

USE	POD #	TWP	RNG	SEC	QQ	DLC	GOV'T LOT	TAX LOT	ACRES
IR	29	3N	10	34	NW/NW			1200	1.5

**District Conveyance System:**

Description of Delivery System:

Served by pressurized pipe 3" lateral from Muddy Pipe

Headgate Number: MU25

Canal Name: MUDDY Pipe

**Beneficial Use:**

Description of Beneficial Use: Grass and a lot of landscaping

Method Used to Apply Water: Sprinkler, drip

Method Used to Calculate Beneficial Use: On site inspection, checked irrigable areas, a lot of landscaping under large trees & Lawns. Overlaid with aerial imagery to verify irrigated area.

- The water right user has been interviewed
- The water right in question has been beneficially used as authorized

Please describe the beneficial use if less than authorized under the transfer:

Inspected by: Rick Brock

Date: 3/15/2006

Company: Farmers Irrigation District


***Instructions: Attach and label the corresponding final proof map***

**RECEIVED**  
FEB 22 2012  
WATER RESOURCES DEPT  
SALEM, OREGON

# APPLICATION FOR WATER RIGHT TRANSFER

T3N. R10 SECTION 34

CBU #21

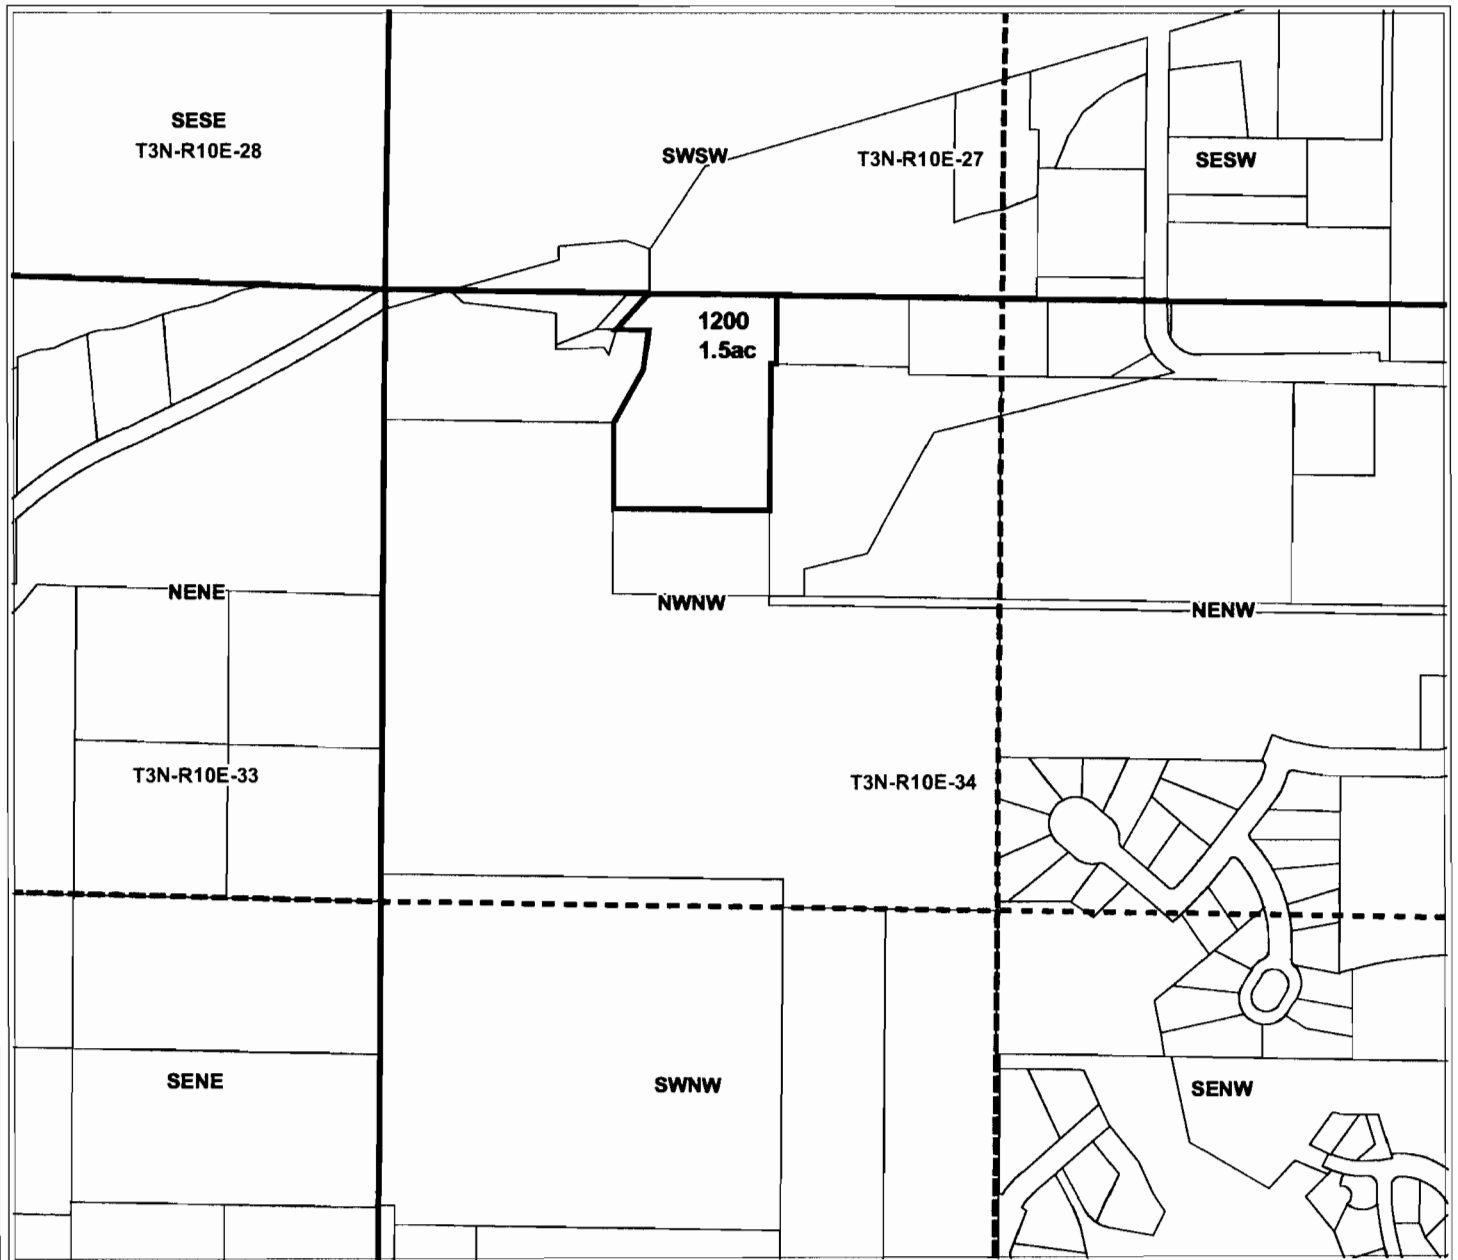

## APPLICATION FOR DISTRICT PERMANENT WATER RIGHT TRANSFER

for

Lozowski

Tax Lot 1200 - 1.5 Acres

**RECEIVED**

FEB 22 2012

WATER RESOURCES DEPT  
SALEM, OREGON



**Geo-Spatial Solutions, Inc.**

[www.geospatialsolutions.com](http://www.geospatialsolutions.com)

Date Created: April 26, 2004

1 inch equals 400 feet

**CLAIM OF BENEFICIAL USE  
Site Report**

#22

Transfer Number: T -9587

District Internal Notice Number (DINN): 6008

Landowner Name: FLERCHINGER

Property Address: 4200 POST CANYON ROAD

**Place of Use:**

*Enter one record for each portion of the taxlot that falls within a unique quarter-quarter. A single taxlot may have more than one legal description but may not if it falls entirely in a single quarter-quarter.*

USE	POD #	TWP	RNG	SEC	QQ	DLC	GOV'T LOT	TAX LOT	ACRES
IR	29	3N	10	34	SW/NW			1511	1.8

**District Conveyance System:**

Description of Delivery System:

Served by pressurized pipe 4" lateral from the intersection of Parson Road & Post Canyon Road.

Headgate Number: FRU7

Canal Name: FRUNK

**Beneficial Use:**

Description of Beneficial Use: Lawn and vineyard

Method Used to Apply Water: Sprinkler and drip

Method Used to Calculate Beneficial Use: On site check of irrigable areas, past use is evident. Overlaid the mapped area with aerial imagery and verified beneficial use.

- The water right user has been interviewed
- The water right in question has been beneficially used as authorized

Please describe the beneficial use if less than authorized under the transfer:

It appears the mapping may be off a little it overlaps an existing building, should be a little to the East. fixed during T-11189 process.

Inspected by: Rick Brock

Date: 3/14/2006

Company: Farmers Irrigation District

**RECEIVED**

FEB 22 2012

WATER RESOURCES DEPT  
SALEM, OREGON



# APPLICATION FOR WATER RIGHT TRANSFER

T3N. R10 SECTION 34      CB4 #22



## APPLICATION FOR DISTRICT PERMANENT WATER RIGHT TRANSFER

for  
**Flerchinger**  
**Lot 1511 - 1.8 Acres**  
**(Lot 1501 has been subdivided)**

**RECEIVED**

FEB 22 2012

WATER RESOURCES DEPT  
SALEM, OREGON



**Geo-Spatial Solutions, Inc.**

[www.geospatialolutions.com](http://www.geospatialolutions.com)

Date Created: August 03, 2004



1 inch equals 400 feet

**CLAIM OF BENEFICIAL USE  
Site Report**

# 23

Transfer Number: T -9587

District Internal Notice Number (DINN): 5821

Landowner Name: BEAMAN

Property Address: 3900 FAIRVIEW DRIVE, HOOD RIVER OR 97031

**Place of Use:**

*Enter one record for each portion of the taxlot that falls within a unique quarter-quarter. A single taxlot may have more than one legal description but may not if it falls entirely in a single quarter-quarter.*

USE	POD #	TWP	RNG	SEC	QQ	DLC	GOV'T LOT	TAX LOT	ACRES
IR	29	3N	10E	34	NWSE			03N10E34D00901	0.15

**District Conveyance System:**

Description of Delivery System:

Served by pressurized 1.5 inch mainline from the intersection of Fairview Drive &

Headgate Number: FA3

Canal Name: FAIRVIEW

**Beneficial Use:**

Description of Beneficial Use: Lawn Irrigation

Method Used to Apply Water: Sprinkler

Method Used to Calculate Beneficial Use: On site visit, inspected irrigable areas, past use is evident. Overlaid with aerial imagery and verified total water right acreage.

- The water right user has been interviewed
- The water right in question has been beneficially used as authorized

Please describe the beneficial use if less than authorized under the transfer:

Inspected by: Rick Brock

Date: 3/15/2006

Company: Farmers Irrigation District

***Instructions:*** Attach and label the corresponding final proof map

**RECEIVED**


FEB 22 2012

WATER RESOURCES DEPT  
SALEM, OREGON

# APPLICATION FOR WATER RIGHT TRANSFER

T3N. R10 SECTION 34

CBU #23

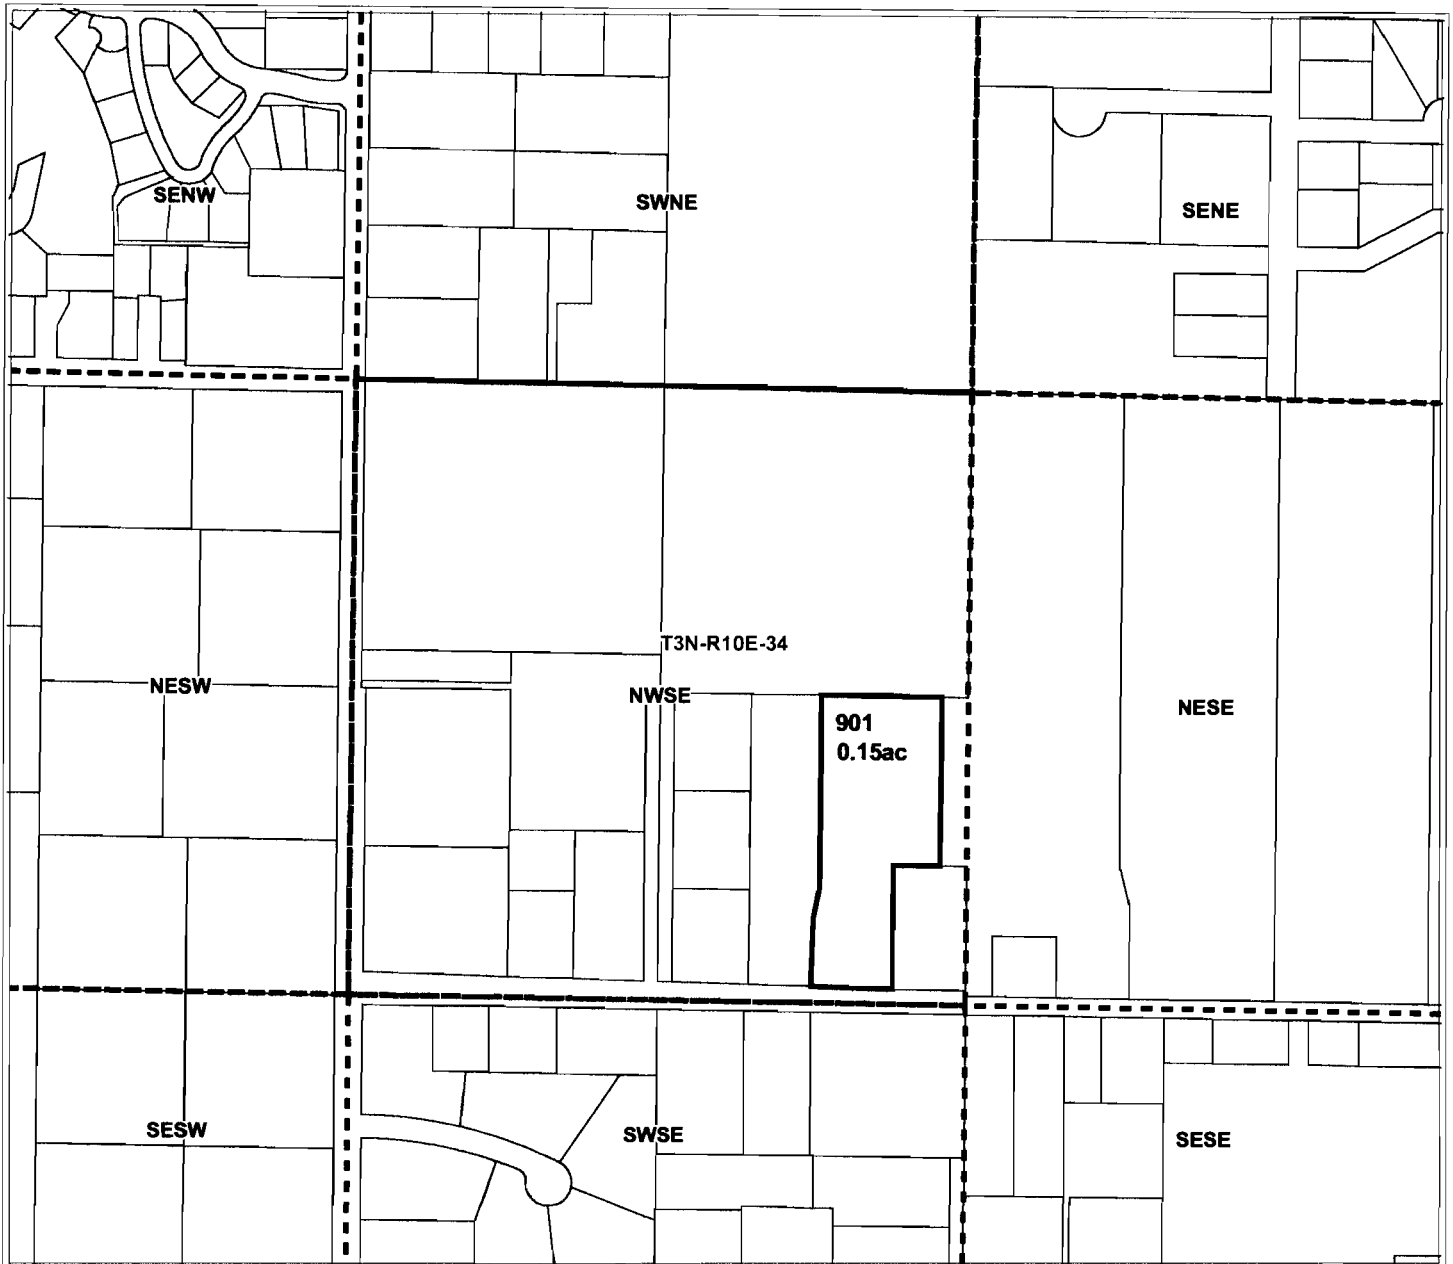

## APPLICATION FOR DISTRICT PERMANENT WATER RIGHT TRANSFER

for

Beaman

Tax Lot 901 - 0.15 Acres  
(Lot has been Consolidated)

**RECEIVED**

FEB 22 2012

WATER RESOURCES DEPT  
SALEM, OREGON



**Geo-Spatial Solutions, Inc.**

[www.geospatialolutions.com](http://www.geospatialolutions.com)

Date Created: August 03, 2004



1 inch equals 400 feet

**CLAIM OF BENEFICIAL USE  
Site Report**

#29

Transfer Number: T -9587

District Internal Notice Number (DINN): 5948

Landowner Name: GUTHRIE

Property Address: 3880 BELMONT DRIVE

**Place of Use:**

*Enter one record for each portion of the taxlot that falls within a unique quarter-quarter. A single taxlot may have more than one legal description but may not if it falls entirely in a single quarter-quarter.*

USE	POD #	TWP	RNG	SEC	QQ	DLC	GOV'T LOT	TAX LOT	ACRES
IR	29	3N	10	34	SW/SE			1900	.3

**District Conveyance System:**

Description of Delivery System:

Served by 1.5 inch line from the Henderson Line

Headgate Number: HE3

Canal Name: HENDERSON

**Beneficial Use:**

Description of Beneficial Use: Lawn Irrigation

Method Used to Apply Water: Sprinkler

Method Used to Calculate Beneficial Use: On site visit, Checked irrigable areas, past use is evident. Overlaid with aerial imagery and verified irrigated area.

- The water right user has been interviewed
- The water right in question has been beneficially used as authorized

Please describe the beneficial use if less than authorized under the transfer:

Inspected by: Rick Brock

Date: 3/13/2006

Company: Farmers Irrigation District

***Instructions:*** Attach and label the corresponding final proof map

**RECEIVED**


FEB 22 2012

WATER RESOURCES DEPT  
SALEM, OREGON

# APPLICATION FOR WATER RIGHT TRANSFER

T3N. R10 SECTION 34

CBU #24

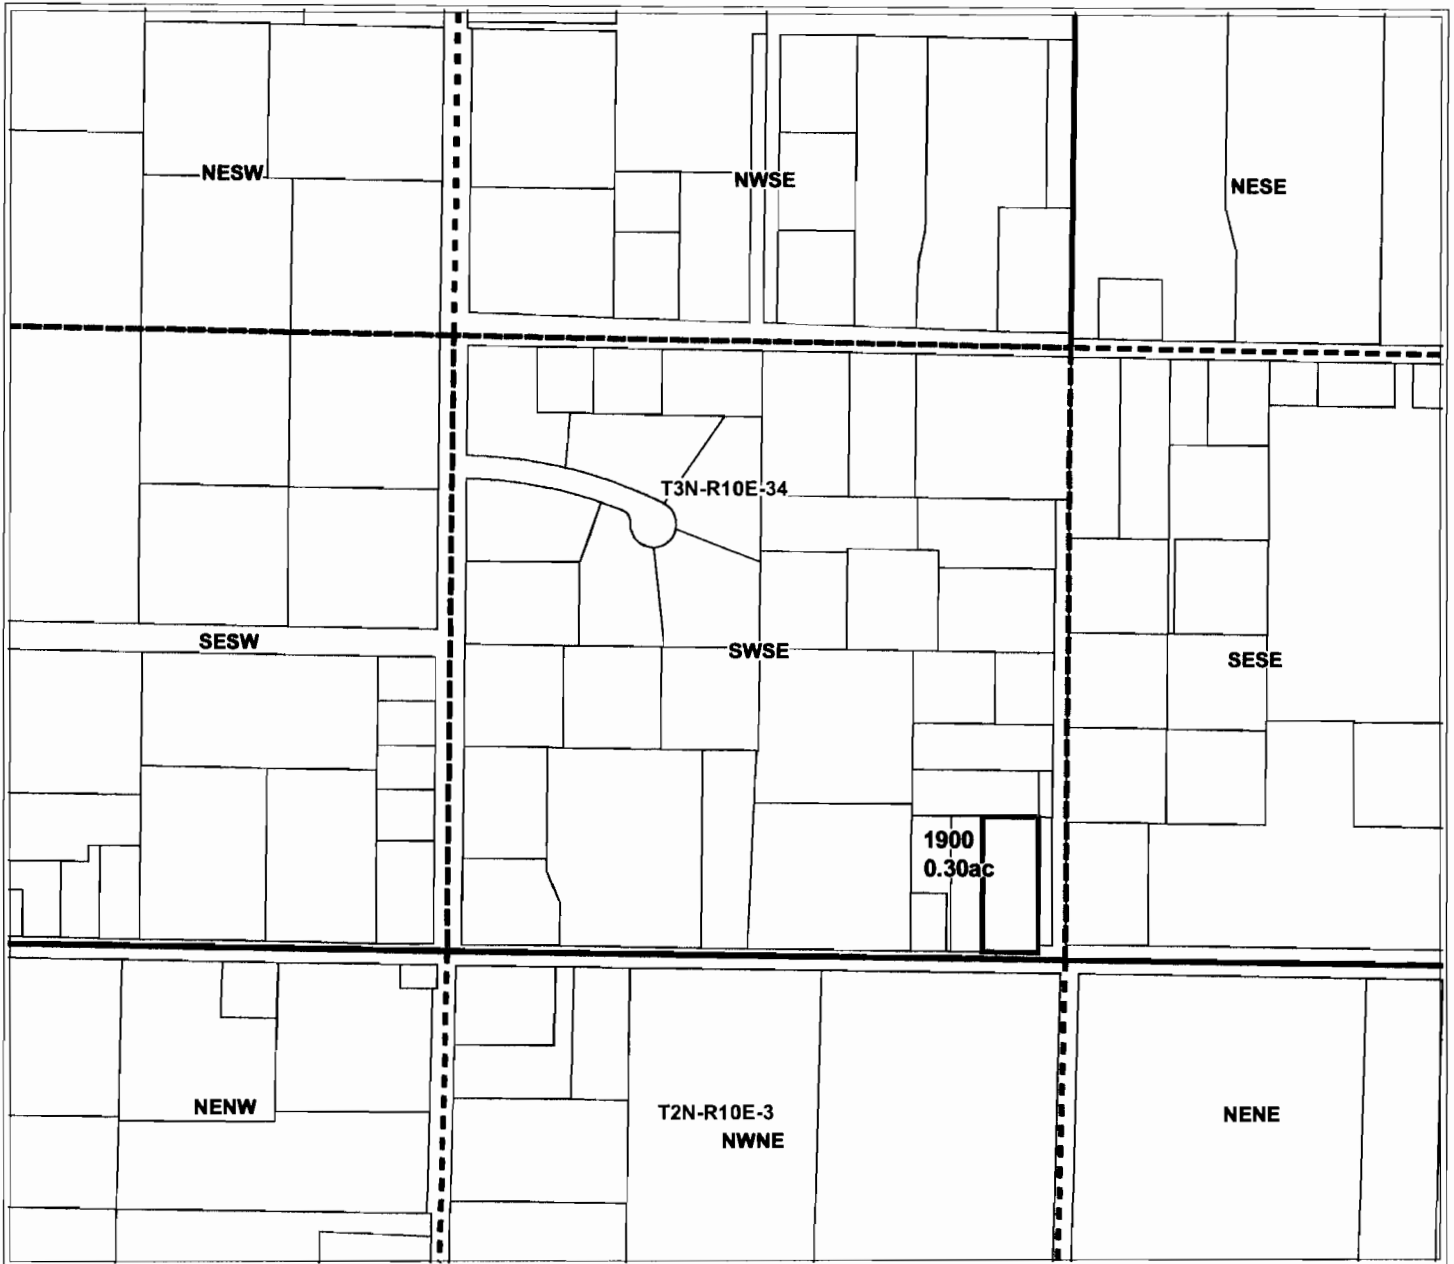

## APPLICATION FOR DISTRICT PERMANENT WATER RIGHT TRANSFER

for

Guthrie

Tax Lot 1900 - 0.30 Acres

**RECEIVED**

FEB 22 2012

WATER RESOURCES DEPT  
SALEM, OREGON



**Geo-Spatial Solutions, Inc.**

[www.geospatialolutions.com](http://www.geospatialolutions.com)

Date Created: August 02, 2004



1 inch equals 400 feet

# CLAIM OF BENEFICIAL USE

## Site Report

Transfer Number: T -9587

District Internal Notice Number (DINN): 5948 # 25

Landowner Name: GUTHRIE

Property Address: 3880 BELMONT DRIVE, HOOD RIVER OR 97031

**Place of Use:**

*Enter one record for each portion of the taxlot that falls within a unique quarter-quarter. A single taxlot may have more than one legal description but may not if it falls entirely in a single quarter-quarter.*

USE	POD #	TWP	RNG	SEC	QQ	DLC	GOV'T LOT	TAX LOT	ACRES
IR	29	3N	10	34	SW/SE			1907	.15

**District Conveyance System:**

Description of Delivery System:

Served by pressurized 1.5" line from the Henderson Line

Headgate Number: HE3

Canal Name: HENDERSON

**Beneficial Use:**

Description of Beneficial Use: Lawn

Method Used to Apply Water: Sprinkler

Method Used to Calculate Beneficial Use: On site visit, checked irrigable area, past use is evident. Overlaid with aerial imagery and verified irrigated area.

- The water right user has been interviewed
- The water right in question has been beneficially used as authorized

Please describe the beneficial use if less than authorized under the transfer:

Inspected by: Rick Brock

Date: 3/14/2006

Company: Farmers Irrigation District

***Instructions: Attach and label the corresponding final proof map***

**RECEIVED**


FEB 22 2012

WATER RESOURCES DEPT  
SALEM, OREGON

# APPLICATION FOR WATER RIGHT TRANSFER

T3N. R10 SECTION 34

CB4 #25

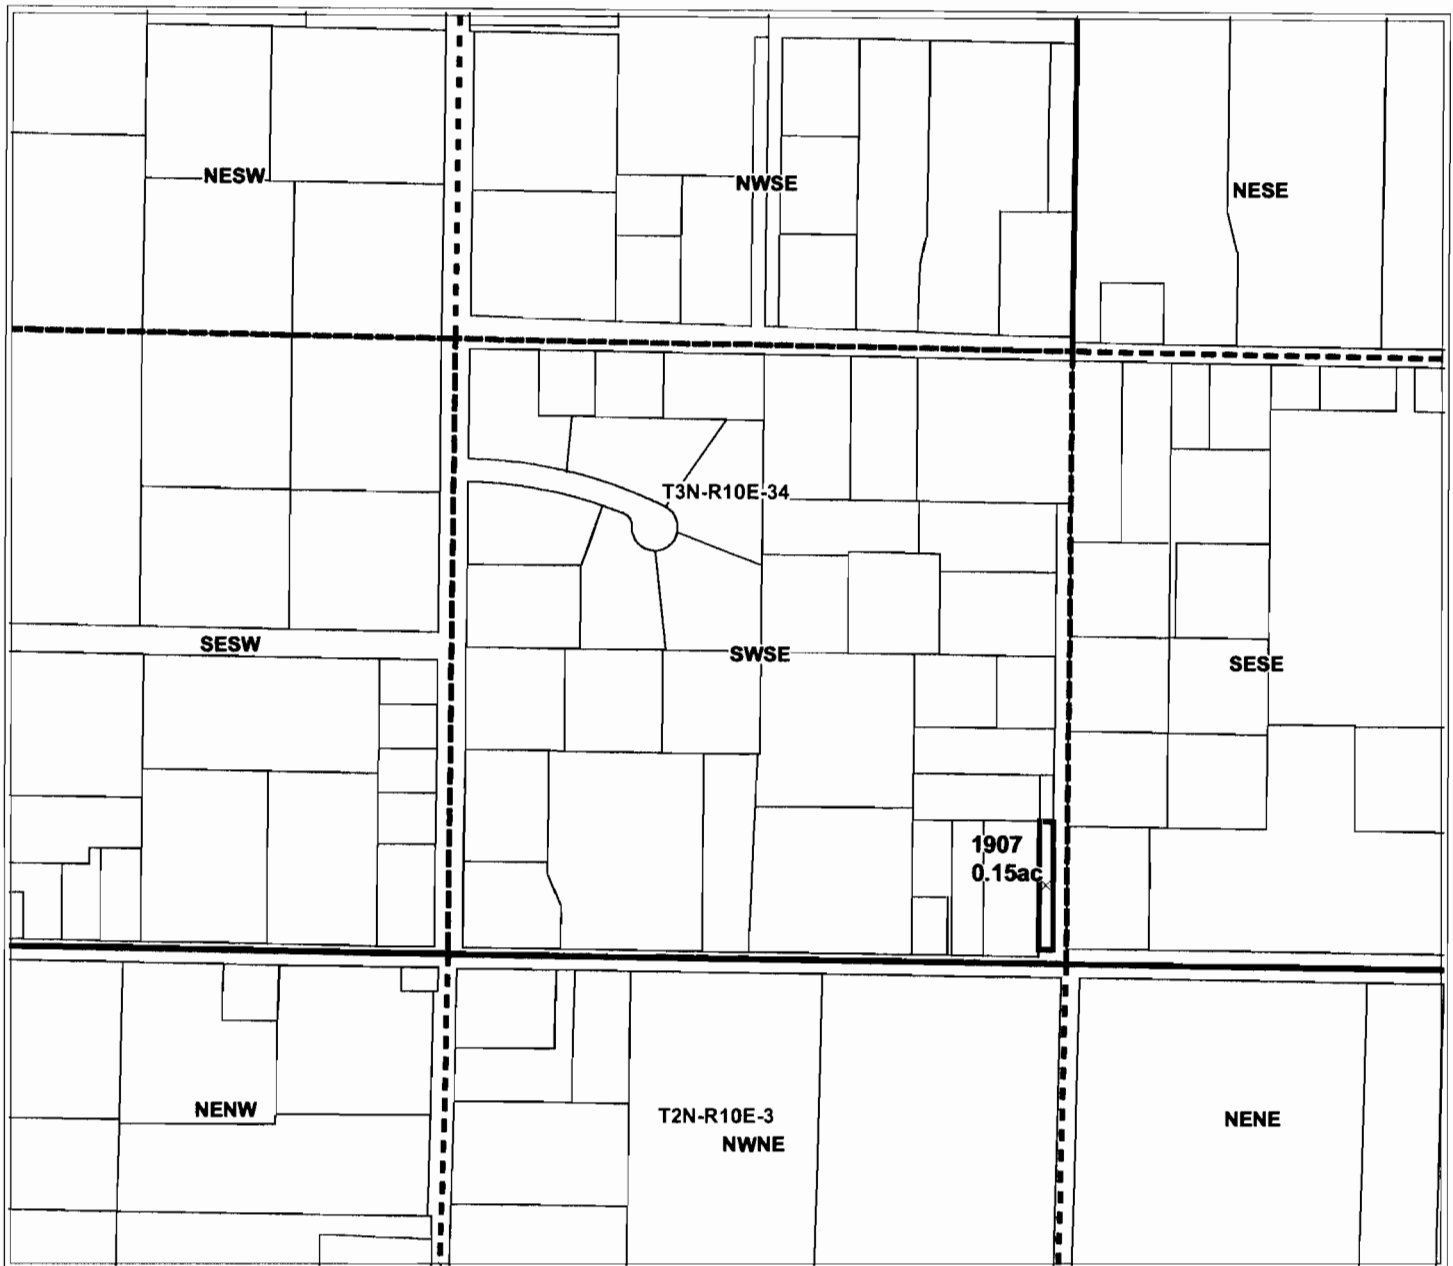

## APPLICATION FOR DISTRICT PERMANENT WATER RIGHT TRANSFER

for  
Guthrie

Tax Lot 1907 - 0.15 Acres

**RECEIVED**

FEB 22 2012

WATER RESOURCES DEPT  
SALEM, OREGON



**Geo-Spatial Solutions, Inc.**

[www.geospatialsolutions.com](http://www.geospatialsolutions.com)

Date Created: August 02, 2004



1 inch equals 400 feet

**CLAIM OF BENEFICIAL USE  
Site Report**

# 26

Transfer Number: T -9587

District Internal Notice Number (DINN): 5949

Landowner Name: HENDERSON

Property Address: NEAR 3840 BELMONT DRIVE, HOOD RIVER OR 97031

**Place of Use:**

*Enter one record for each portion of the taxlot that falls within a unique quarter-quarter. A single taxlot may have more than one legal description but may not if it falls entirely in a single quarter-quarter.*

USE	POD #	TWP	RNG	SEC	QQ	DLC	GOV'T LOT	TAX LOT	ACRES
IR	29	3N	10	34	SE/SE			2000	.75

**District Conveyance System:**

Description of Delivery System:

Served by pressurized pipe 4" lateral From the Henderson sub lateral

Headgate Number: HE5

Canal Name: HENDERSON

**Beneficial Use:**

Description of Beneficial Use: Orchard

Method Used to Apply Water: Sprinkler

Method Used to Calculate Beneficial Use: On site visit, past use is evident. Overlaid with aerial imagery and verified irrigated area.

- The water right user has been interviewed
- The water right in question has been beneficially used as authorized

Please describe the beneficial use if less than authorized under the transfer:

Inspected by: Rick Brock

Date: 3/15/2006

Company: Farmers Irrigation District

***Instructions: Attach and label the corresponding final proof map***

**RECEIVED**

FFB 2 2 2012


WATER RESOURCES DEPT  
SALEM, OREGON



# APPLICATION FOR WATER RIGHT TRANSFER

T3N. R10 SECTION 34

CBU #26

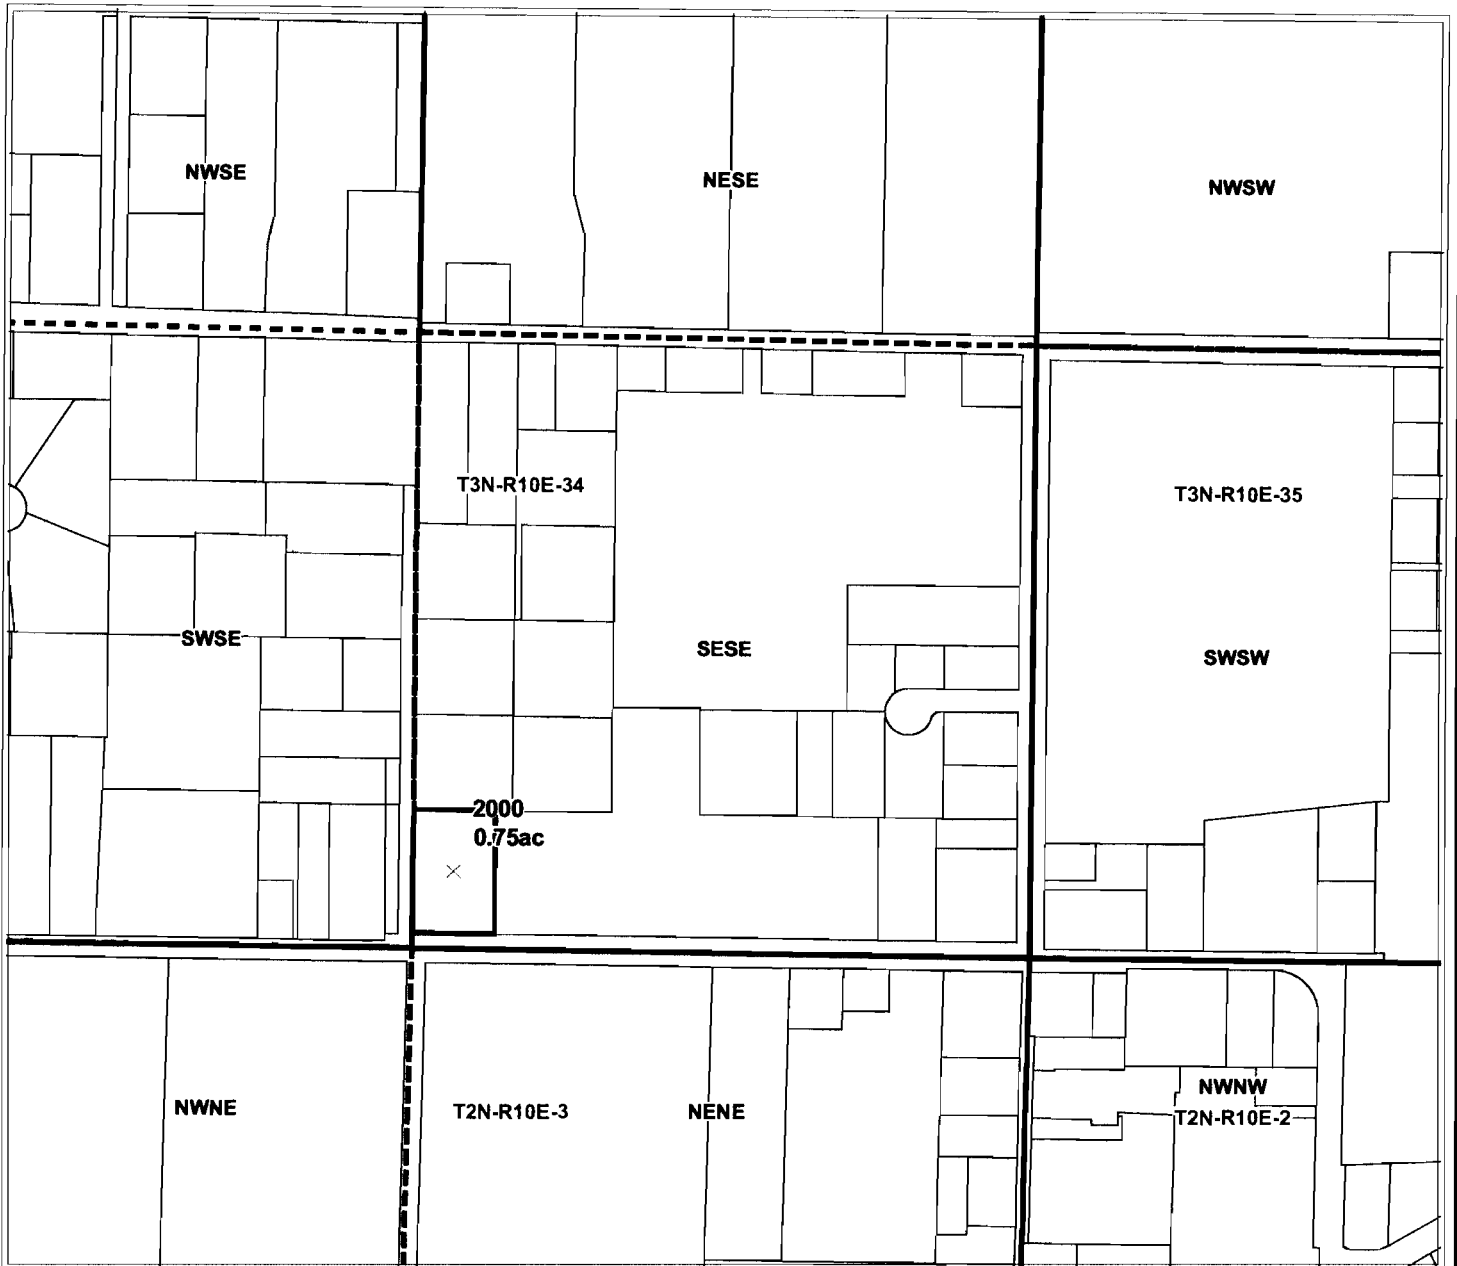

## APPLICATION FOR DISTRICT PERMANENT WATER RIGHT TRANSFER

for

Henderson

Tax Lot 2000 - 0.75 Acres

**RECEIVED**

FEB 22 2012

WATER RESOURCES DEPT  
SALEM, OREGON



**Geo-Spatial Solutions, Inc.**

[www.geospatialolutions.com](http://www.geospatialolutions.com)

Date Created: August 02, 2004

1 inch equals 400 feet

**CLAIM OF BENEFICIAL USE  
Site Report**

# 27

Transfer Number: T -9587

District Internal Notice Number (DINN): 5955

Landowner Name: SMITH

Property Address: 3670 BELMONT DRIVE, HOOD RIVER OR 97031

**Place of Use:**

*Enter one record for each portion of the taxlot that falls within a unique quarter-quarter. A single taxlot may have more than one legal description but may not if it falls entirely in a single quarter-quarter.*

USE	POD #	TWP	RNG	SEC	QQ	DLC	GOV'T LOT	TAX LOT	ACRES
IR	29	3N	10	34	SE/SE			2600	.6

**District Conveyance System:**

Description of Delivery System:

Served by 1.5" line from the May Street system

Headgate Number: MA7

Canal Name: MAY

**Beneficial Use:**

Description of Beneficial Use: Pasture grass

Method Used to Apply Water: Sprinkler

Method Used to Calculate Beneficial Use: On site inspection, past use is evident. Overlaid with aerial imagery and verified irrigated area.

- The water right user has been interviewed
- The water right in question has been beneficially used as authorized

Please describe the beneficial use if less than authorized under the transfer:

Inspected by: Rick Brock

Date: 3/15/2006

Company: Farmers Irrigation District

***Instructions: Attach and label the corresponding final proof map***

**RECEIVED**


FEB 22 2012

WATER RESOURCES DEPT  
SALEM, OREGON

# APPLICATION FOR WATER RIGHT TRANSFER

T3N. R10 SECTION 34

CBU #27

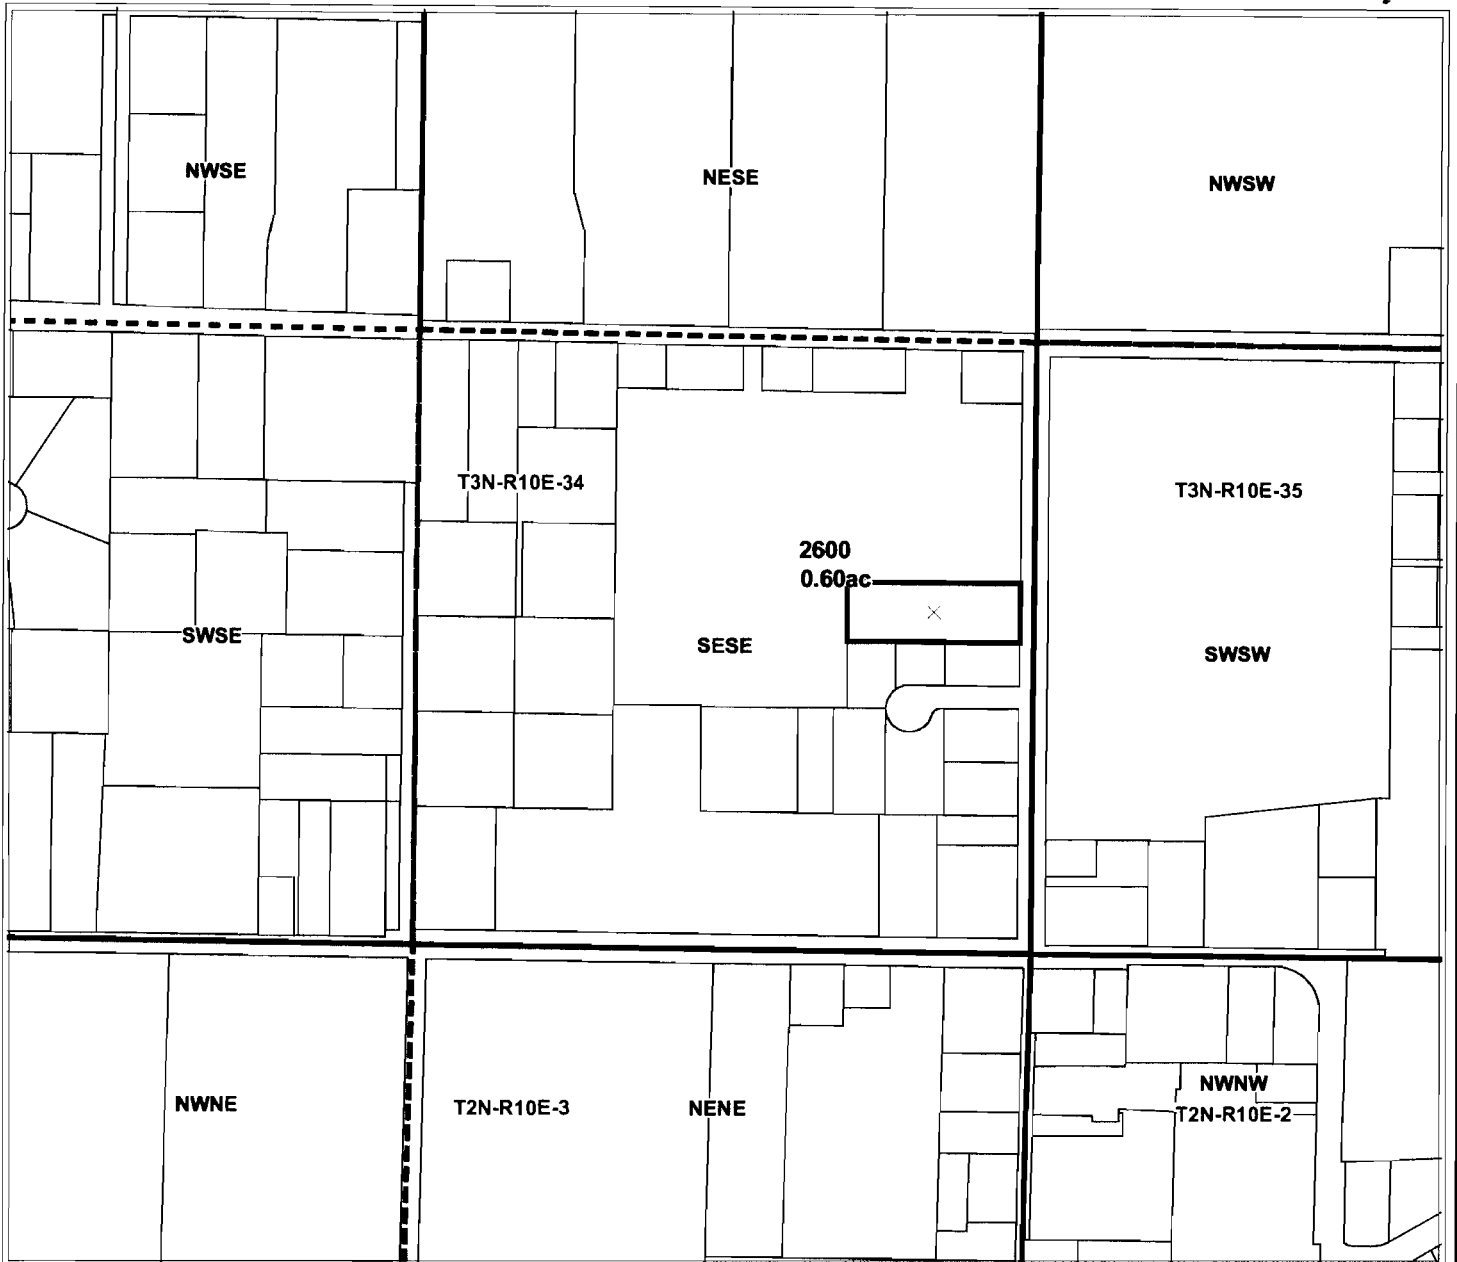

## APPLICATION FOR DISTRICT PERMANENT WATER RIGHT TRANSFER

for  
Smith  
Tax Lot 2600 - 0.60 Acres

**RECEIVED**

FEB 22 2012

WATER RESOURCES DEPT  
SALEM, OREGON



**Geo-Spatial Solutions, Inc.**

[www.geospatialolutions.com](http://www.geospatialolutions.com)

Date Created: August 02, 2004



1 inch equals 400 feet

**CLAIM OF BENEFICIAL USE  
Site Report**

Transfer Number: T -9587

District Internal Notice Number (DINN): 6042

# 28

Landowner Name: HENDERSON

Property Address: NEAR 3840 BELMONT DRIVE, HOOD RIVER OR 97031

**Place of Use:**

*Enter one record for each portion of the taxlot that falls within a unique quarter-quarter. A single taxlot may have more than one legal description but may not if it falls entirely in a single quarter-quarter.*

USE	POD #	TWP	RNG	SEC	QQ	DLC	GOV'T LOT	TAX LOT	ACRES
IR	29	3N	10	35	NE/SW			100	.2

**District Conveyance System:**

Description of Delivery System:

Served by pressurized pipe 1.5" From Avalon Drive

Headgate Number: AV11

Canal Name: AVALON

**Beneficial Use:**

Description of Beneficial Use: Lawn Irrigation

Method Used to Apply Water: Sprinkler

Method Used to Calculate Beneficial Use: On site visit, inspected irrigable area, past use is evident. Overlaid with aerial imagery and verified irrigated area.

- The water right user has been interviewed
- The water right in question has been beneficially used as authorized

Please describe the beneficial use if less than authorized under the transfer:

Inspected by: Rick Brock

Date: 3/15/2006

Company: Farmers Irrigation District

***Instructions:*** Attach and label the corresponding final proof map

**RECEIVED**


FEB 22 2012

WATER RESOURCES DEPT  
SALEM, OREGON

# APPLICATION FOR WATER RIGHT TRANSFER

T3N. R10 SECTION 35

CBU # 28

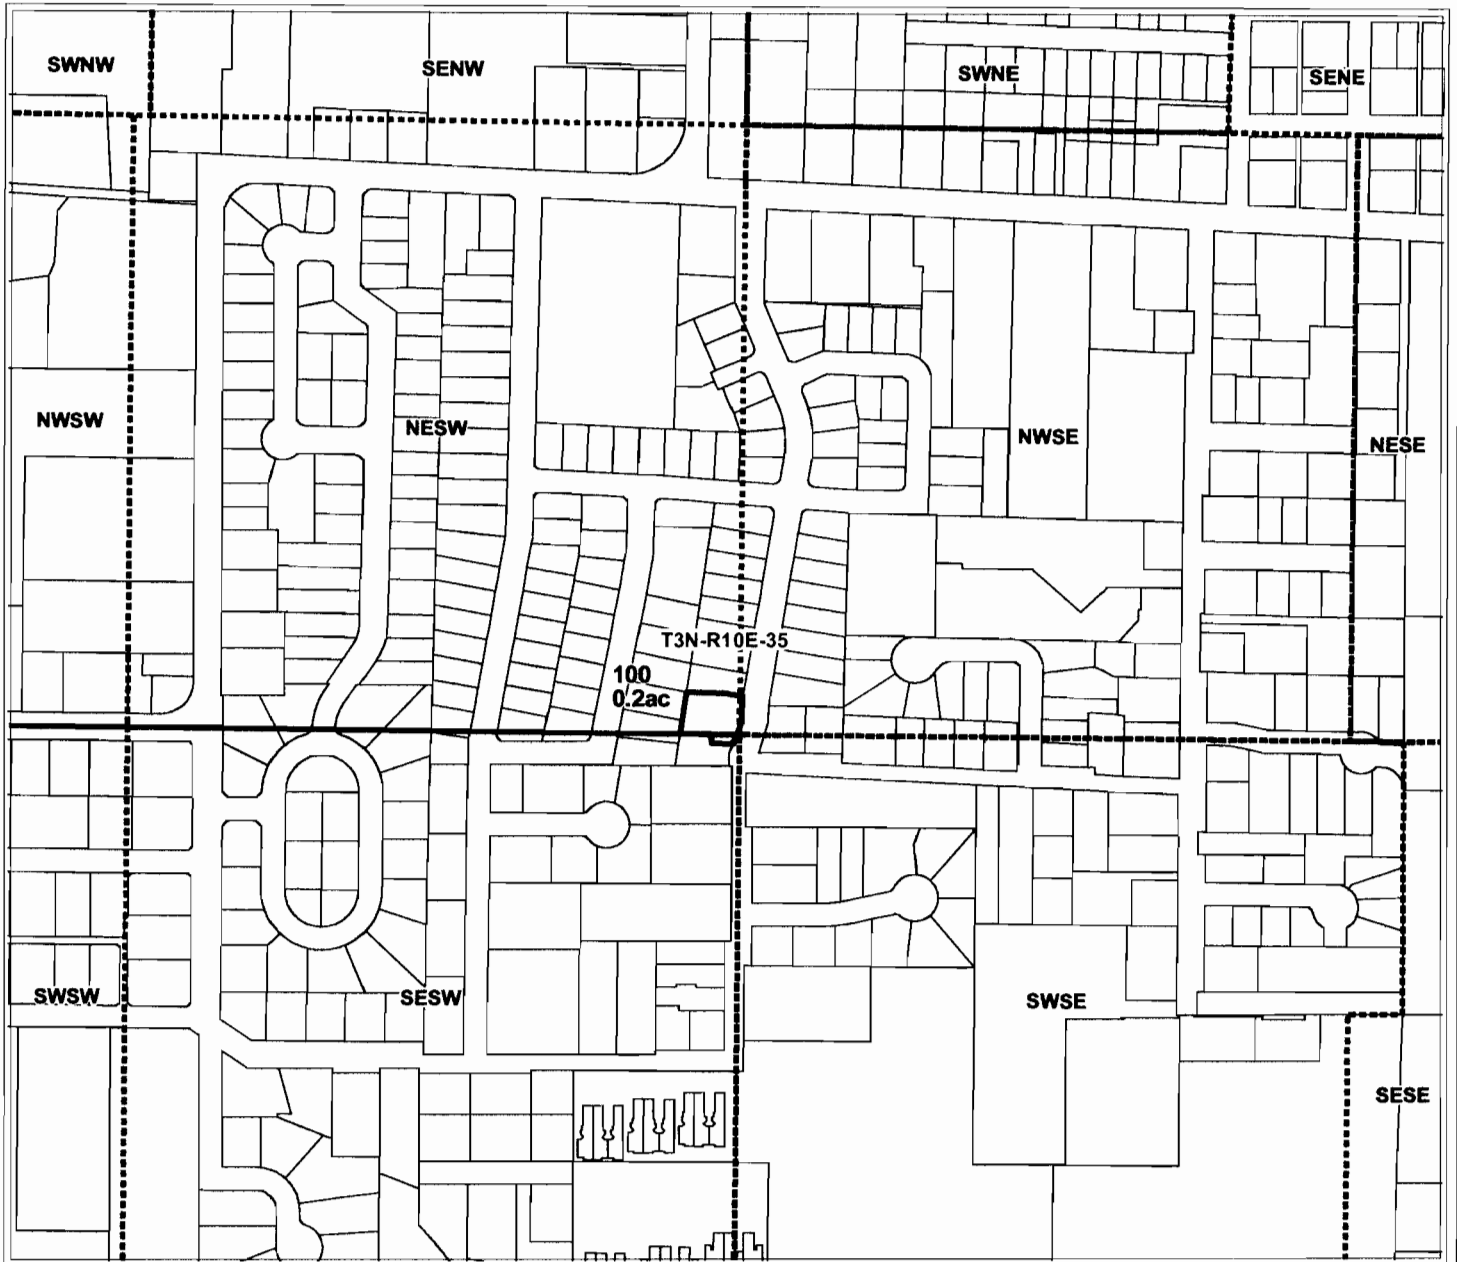

## APPLICATION FOR DISTRICT PERMANENT WATER RIGHT TRANSFER

for

Henderson

Lot 100 - 0.2 Acres

(Lot was previously listed as 93)

**RECEIVED**

FEB 22 2012

WATER RESOURCES DEPT  
SALEM, OREGON



**Geo-Spatial Solutions, Inc.**

[www.geospatialsolutions.com](http://www.geospatialsolutions.com)

Date Created: August 03, 2004



1 inch equals 400 feet

**CLAIM OF BENEFICIAL USE  
Site Report**

Transfer Number: T -9587

District Internal Notice Number (DINN): 6041

# 29

Landowner Name: MARQUEZ

Property Address: 1754 22<sup>ND</sup> STREET, HOOD RIVER OR 97031

**Place of Use:**

*Enter one record for each portion of the taxlot that falls within a unique quarter-quarter. A single taxlot may have more than one legal description but may not if it falls entirely in a single quarter-quarter.*

USE	POD #	TWP	RNG	SEC	QQ	DLC	GOV'T LOT	TAX LOT	ACRES
IR	29	3N	10	35	NE/SW			168	.1

**District Conveyance System:**

Description of Delivery System:

Served by pressurized pipe 1.5" pipe from the Avalon Drive pipe

Headgate Number: AV11

Canal Name: Avalon

**Beneficial Use:**

Description of Beneficial Use: Lawn Irrigation

Method Used to Apply Water: Sprinkler

Method Used to Calculate Beneficial Use: On site inspection of irrigable area, past use is evident. Overlaid with aerial imagery and verified irrigated area.

- The water right user has been interviewed
- The water right in question has been beneficially used as authorized

Please describe the beneficial use if less than authorized under the transfer:

Inspected by: Rick Brock

Date: 3/15/2006

Company: Farmers Irrigation District

***Instructions: Attach and label the corresponding final proof map***


**RECEIVED**

FEB 22 2012

WATER RESOURCES DEPT  
SALEM, OREGON

# APPLICATION FOR WATER RIGHT TRANSFER

T3N. R10 SECTION 35 CBU #29

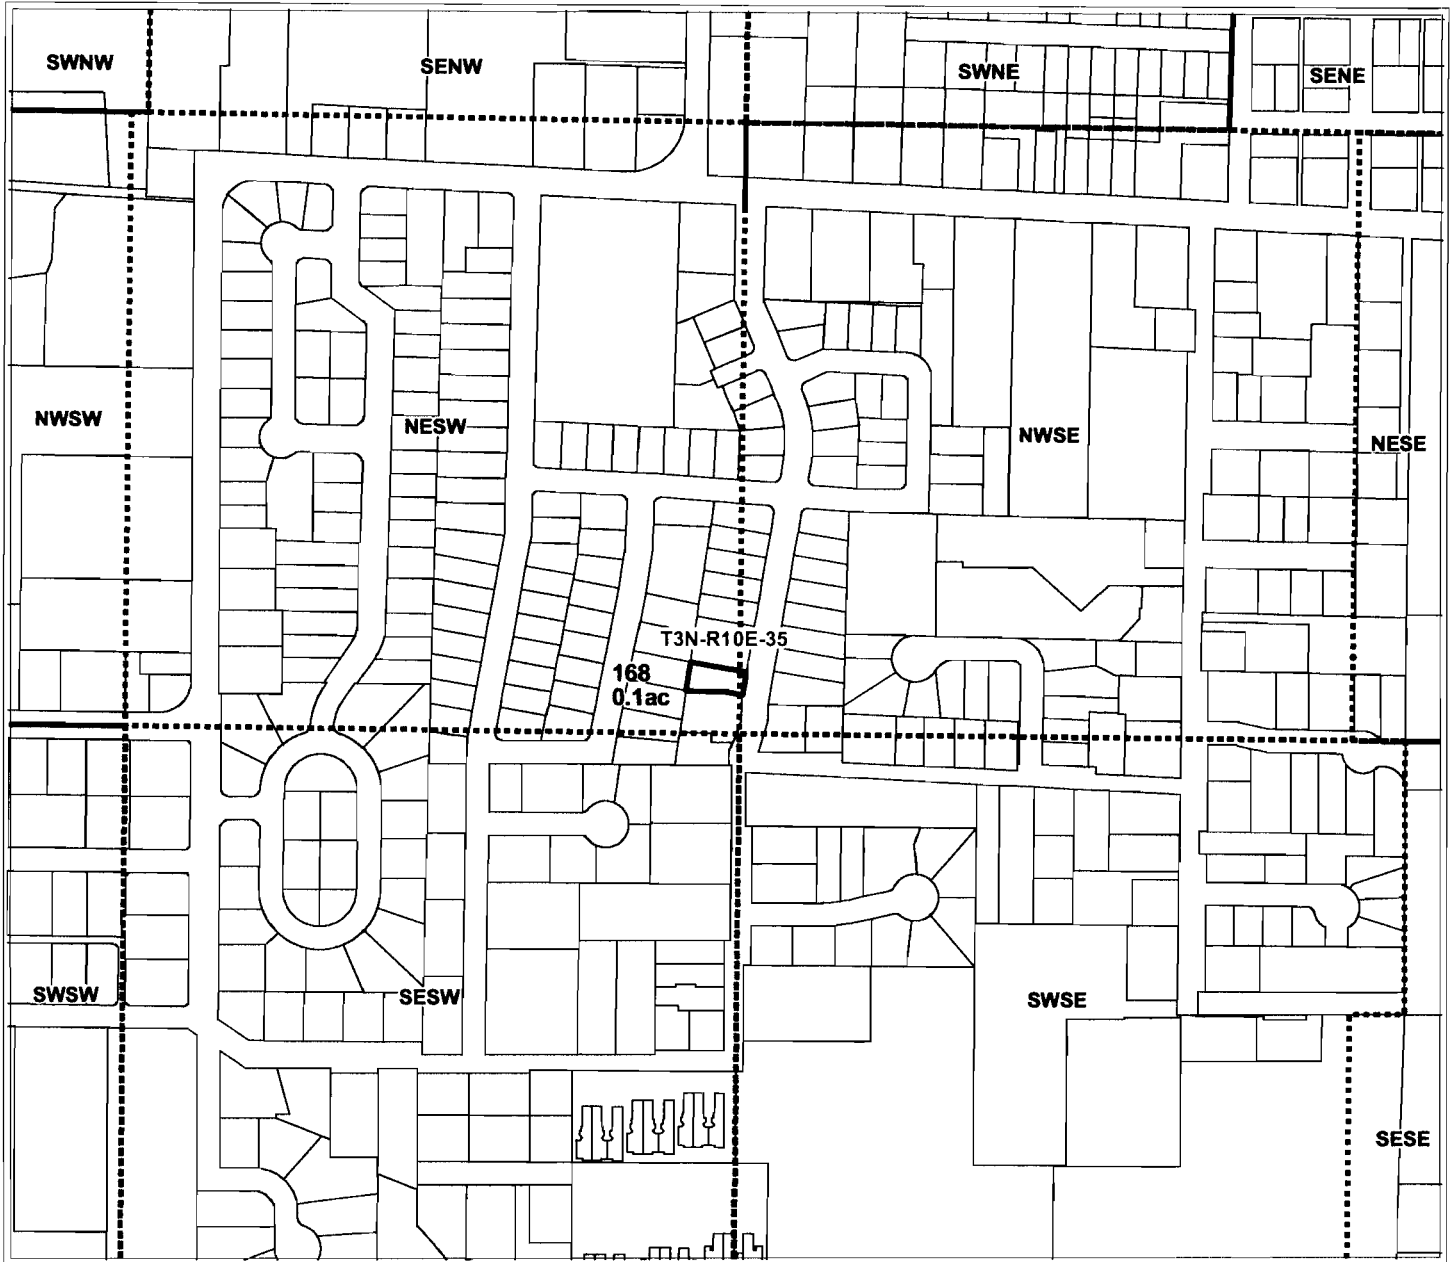

## APPLICATION FOR DISTRICT PERMANENT WATER RIGHT TRANSFER

for

Marquez

Lot 168 - 0.1 Acres

(Lot was previously listed as 94)

**RECEIVED**

FEB 22 2012

WATER RESOURCES DEPT  
SALEM, OREGON



**Geo-Spatial Solutions, Inc.**

[www.geospatialsolutions.com](http://www.geospatialsolutions.com)

Date Created: August 03, 2004



1 inch equals 400 feet

## CLAIM OF BENEFICIAL USE Site Report

Transfer Number: T -9587

District Internal Notice Number (DINN): 5956 #30

Landowner Name: MARSHALL

Property Address: 3461 AVALON DRIVE, HOOD RIVER OR 97031

**Place of Use:**

*Enter one record for each portion of the taxlot that falls within a unique quarter-quarter. A single taxlot may have more than one legal description but may not if it falls entirely in a single quarter-quarter.*

USE	POD #	TWP	RNG	SEC	QQ	DLC	GOV'T LOT	TAX LOT	ACRES
IR	29	3N	10	35	SW/SE			2200	.15

**District Conveyance System:**

Description of Delivery System:

Served by Pressurized 1.5" line from Avalon Drive

Headgate Number: AV7

Canal Name: AVALON

**Beneficial Use:**

Description of Beneficial Use: Lawn Irrigation

Method Used to Apply Water: Sprinkler

Method Used to Calculate Beneficial Use: On site inspection, past use is evident. Overlaid with aerial imagery and verified irrigated area.

- The water right user has been interviewed
- The water right in question has been beneficially used as authorized

Please describe the beneficial use if less than authorized under the transfer:

Inspected by: Rick Brock

Date: 3/15/2006

Company: Farmers Irrigation District

***Instructions:*** Attach and label the corresponding final proof map

**RECEIVED**


FEB 22 2012

WATER RESOURCES DEPT  
SALEM, OREGON



# APPLICATION FOR WATER RIGHT TRANSFER

T3N. R10 SECTION 35 CBU #30

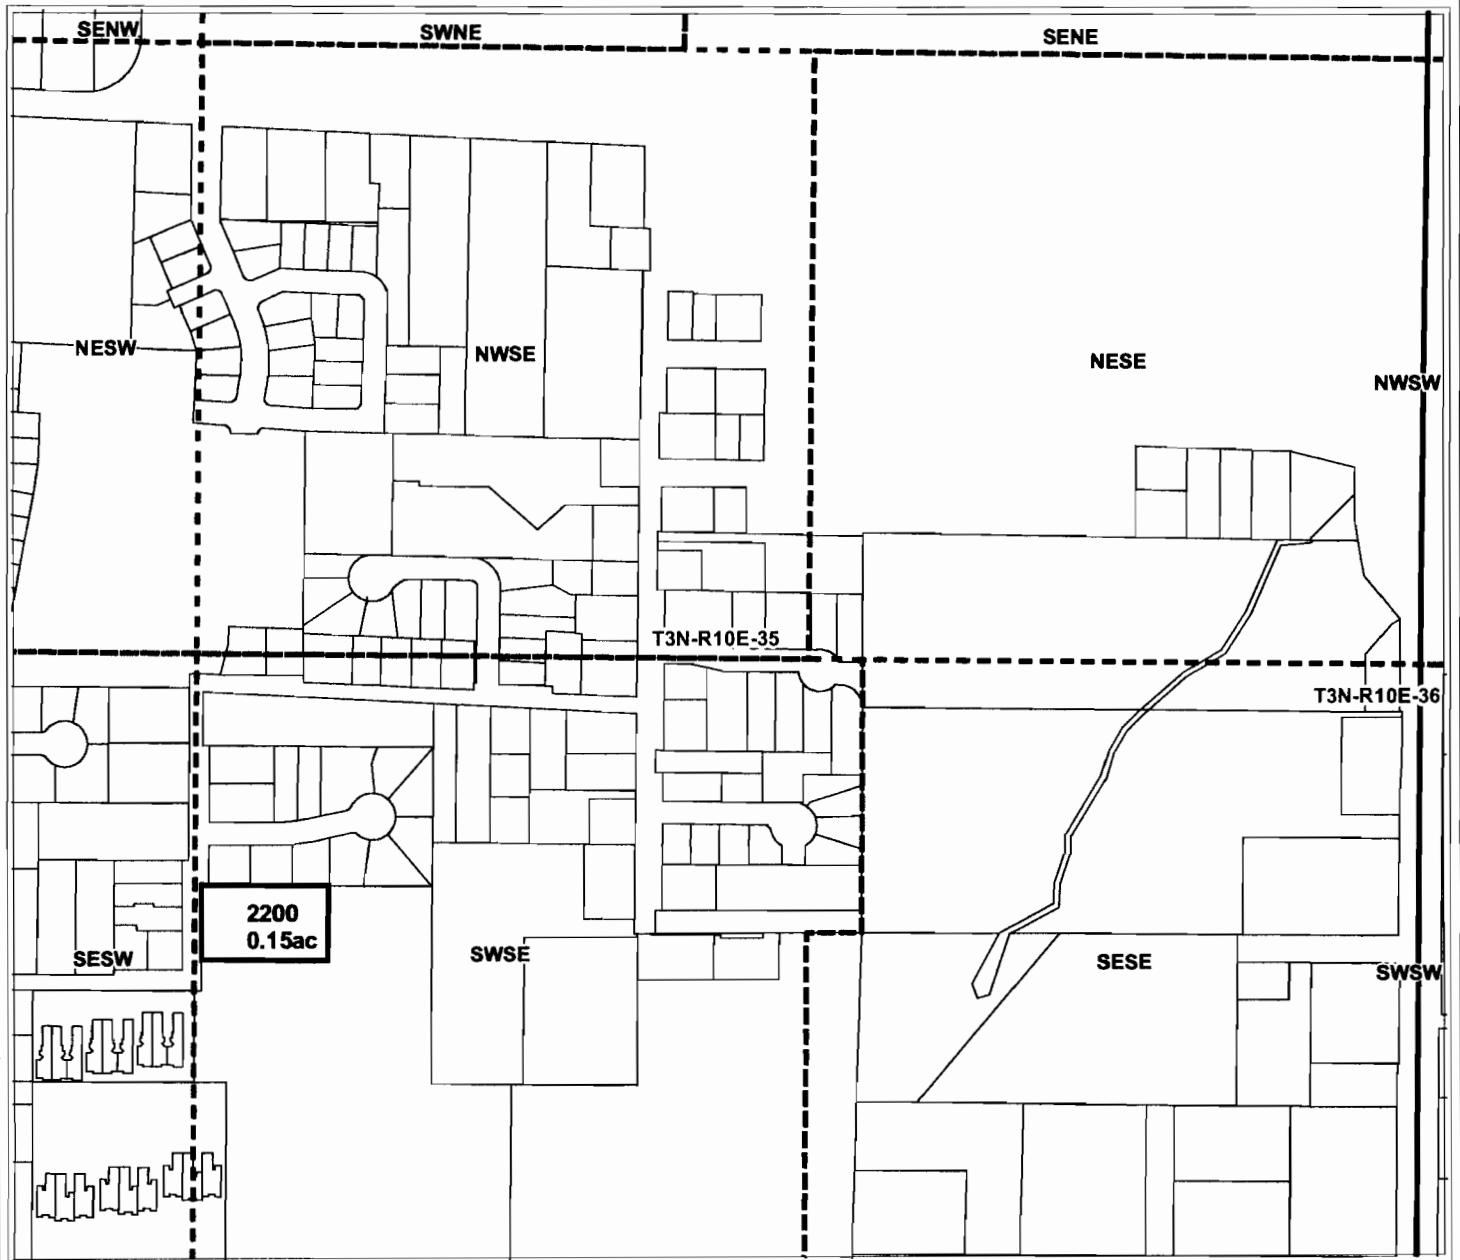

## APPLICATION FOR DISTRICT PERMANENT WATER RIGHT TRANSFER

for

Marshall

Tax Lot 2200 - 0.15 Acres

**RECEIVED**

FEB 22 2012

WATER RESOURCES DEPT  
SALEM, OREGON



**Geo-Spatial Solutions, Inc.**

[www.geospatialolutions.com](http://www.geospatialolutions.com)

Date Created: July 15, 2004



1 inch equals 400 feet