

AKA Well #1

GR-772

STATE ENGINEER  
Salem, Oregon

LINN  
4536

### Well Record

STATE WELL NO. 10/3W-6H(2)  
COUNTY Linn  
APPLICATION NO. GR-772

OWNER: Ardle Edwards


MAILING ADDRESS: Rt. 2, Box 350

LOCATION OF WELL: Owner's No. 1

CITY AND STATE: Albany, Oregon

SE 1/4 NE 1/4 Sec. 6 T. 10 N. S. R. 3 E. W.M.

Bearing and distance from section or subdivision corner 1825' S. & 20' W. of NE cor. Sec. 6

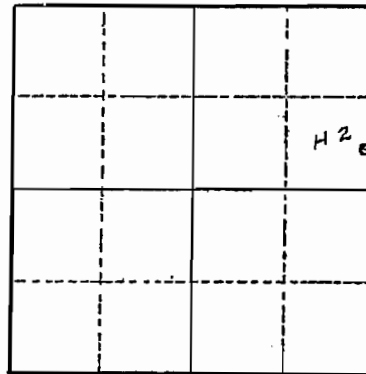

Altitude at well 180 ft. Interpolated

TYPE OF WELL: drilled Date Constructed April 1948

Depth drilled 22 ft. Depth cased 22 ft.

Section 6

CASING RECORD: 8 inch

FINISH:

AQUIFERS:

WATER LEVEL: 8 ft.

PUMPING EQUIPMENT: Type Fairbanks Morse electric centrifugal H.P. 10  
Capacity G.P.M.

WELL TESTS:  
Drawdown ft. after hours G.P.M.  
Drawdown ft. after hours G.P.M.

USE OF WATER irrigation Temp. °F. 19

SOURCE OF INFORMATION GR-772

DRILLER or DIGGER

ADDITIONAL DATA:

Log  Water Level Measurements  Chemical Analysis  Aquifer Test

REMARKS: Log: Sandy loam 0 to 6  
Gravel ?

**RECEIVED**

MAR 20 2012

WATER RESOURCES DEPT  
SALEM, OREGON

AKA Well #2

STATE ENGINEER  
Salem, Oregon

Linn  
3150

Well Record

STATE WELL NO. 9/3W-31R(1)  
COUNTY Linn  
APPLICATION NO. GR-773

OWNER: Ardle Edwards MAILING ADDRESS: Rt. 2, Box 350

LOCATION OF WELL: Owner's No. 2 CITY AND STATE: Albany, Oregon

SE 1/4 SE 1/4 Sec. 31 T. 9 S., R. 3 W., W.M.


Bearing and distance from section or subdivision  
corner 300' N. of SE cor. Sec. 31

Altitude at well 187 ft. Interpolated

TYPE OF WELL: drilled Date Constructed 4/1/50

Depth drilled 26 ft. Depth cased 26 ft.

CASING RECORD: 10 inch

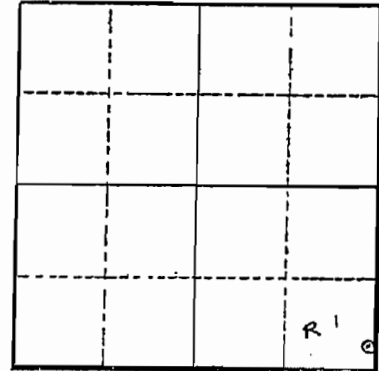

Section 31

FINISH:

AQUIFERS:

WATER LEVEL: 13 ft.

PUMPING EQUIPMENT: Type F. M. electric H.P. 20  
Capacity G.P.M.

WELL TESTS:  
Drawdown ft. after hours G.P.M.  
Drawdown ft. after hours G.P.M.

USE OF WATER Irrigation Temp. °F. 19

SOURCE OF INFORMATION GR-773

DRILLER or DIGGER

ADDITIONAL DATA:  
Log  Water Level Measurements \_\_\_\_\_ Chemical Analysis \_\_\_\_\_ Aquifer Test \_\_\_\_\_

REMARKS:

RECEIVED

MAR 20 2012

WATER RESOURCES DEPT  
SALEM, OREGON

STATE ENGINEER  
Salem, Oregon

*Linn*  
*3/6*

# AKA Well #3 Well Record

STATE WELL NO. 9/3W-32N(1)  
COUNTY Linn  
APPLICATION NO. GR-774

OWNER: Ardle Edwards

MAILING ADDRESS: Rt. 2, Box 350

LOCATION OF WELL: Owner's No. 3

CITY AND STATE: Albany, Oregon

SW  $\frac{1}{4}$  SW  $\frac{1}{4}$  Sec. 32 T. 9 <sup>N.</sup> S., R. 3 <sup>E.</sup> W., W.M.

Bearing and distance from section or subdivision corner 400' N. & 400' E. of SW cor. Sec. 32

<i>N</i>			
<i>⊙</i>			

Altitude at well 187 ft. Interpolated

TYPE OF WELL: drilled Date Constructed April, 1955

Depth drilled 26 ft. Depth cased 26 ft.

Section 32

CASING RECORD: 10 inch

FINISH:

AQUIFERS:

WATER LEVEL: 13 ft.

PUMPING EQUIPMENT: Type Fairbanks Morse electric H.P. 10  
Capacity \_\_\_\_\_ G.P.M.

WELL TESTS:

Drawdown \_\_\_\_\_ ft. after \_\_\_\_\_ hours \_\_\_\_\_ G.P.M.

Drawdown \_\_\_\_\_ ft. after \_\_\_\_\_ hours \_\_\_\_\_ G.P.M.

USE OF WATER irrigation Temp. \_\_\_\_\_ °F., 19\_\_\_\_

SOURCE OF INFORMATION GR-774

DRILLER or DIGGER Hamilton Drilling Co., Albany

ADDITIONAL DATA:

Log  Water Level Measurements \_\_\_\_\_ Chemical Analysis \_\_\_\_\_ Aquifer Test \_\_\_\_\_

REMARKS: Log: Sandy loam 0 to 5 ft.  
Sand & gravel ?  
(This location of land has spots of gravel)

**RECEIVED**

MAR 20 2012

WATER RESOURCES DEPT  
SALEM, OREGON

LINN 58218

AKA Well #4

STATE OF OREGON
WATER SUPPLY WELL REPORT
(as required by ORS 537.765 & OAR 690-205-0210)

WELL LABEL # L 92436
START CARD # 197219

(1) LAND OWNER
Owner Well I.D. 4929
First Name Bill Last Name Sabol
Company DJ Edwards Family LLC
Address P.O. Box 425
City St. Paul State OR Zip 97137

(2) TYPE OF WORK
[X] New Well [ ] Deepening [ ] Conversion
[ ] Alteration (repair/recondition) [ ] Abandonment

(3) DRILL METHOD
[X] Rotary Air [ ] Rotary Mud [ ] Cable [ ] Auger [ ] Cable Mud
[ ] Reverse Rotary [ ] Other

(4) PROPOSED USE
[ ] Domestic [X] Irrigation [ ] Community
[ ] Industrial/ Commercial [ ] Livestock [ ] Dewatering
[ ] Thermal [ ] Injection [ ] Other

(5) BORE HOLE CONSTRUCTION
Special Standard [ ] (Attach copy)
Depth of Completed Well 59 ft.

Table with columns: Dia, From, To, Material, SEAL, Amt, lbs. Row 1: 16, 0, 59, Bentonite, 0, 19, 90, S

How was seal placed: Method [ ] A [ ] B [ ] C [ ] D [ ] E
[X] Other Poured dry
Backfill placed from \_\_\_ ft. to \_\_\_ ft. Material \_\_\_
Filter pack from \_\_\_ ft. to \_\_\_ ft. Material \_\_\_ Size \_\_\_
Explosives used: [ ] Yes Type \_\_\_ Amount \_\_\_

(6) CASING/LINER
Casing Liner Dia + From To Gauge Stil Plstc Wld Thrd
[ ] [ ] 12 [X] 2 19 250 [ ] [ ] [X] [ ]
[ ] [ ] 14 [ ] 20 40 250 [ ] [ ] [X] [ ]
Shoe [ ] Inside [ ] Outside [ ] Other Location of shoe(s) \_\_\_
Temp casing [X] Yes Dia 16 From 1 To 60

(7) PERFORATIONS/SCREENS
Perforations Method Torch cut
Screens Type \_\_\_ Material \_\_\_
Perf/S Casing/ Screen Scm/slot Slot # of Tele/
green Liner Dia From To width length slots pipe size
Perf Casing 19 59 .438 10 400

(8) WELL TESTS: Minimum testing time is 1 hour
[ ] Pump [ ] Bailer [X] Air [ ] Flowing Artesian
Yield gal/min Drawdown Drill stem/Pump depth Duration (hr)
1,200 55 1
Temperature 54 °F Lab analysis [ ] Yes By \_\_\_
Water quality concerns? [ ] Yes (describe below)
From To Description Amount Units

(9) LOCATION OF WELL (legal description)
County LINN Twp 10 S N/S Range 3 W E/W WM
Sec 6 SE 1/4 of the NE 1/4 Tax Lot 102
Tax Map Number \_\_\_ Lot \_\_\_
Lat \_\_\_ or 0 DMS or DD
Long \_\_\_ or 0 DMS or DD
[ ] Street address of well [X] Nearest address
Next to 32633 Cooper Dr. NE, Albany, OR 97321

(10) STATIC WATER LEVEL
Date SWL(psi) + SWL(ft)
Existing Well / Predeepening \_\_\_ \_\_\_
Completed Well 03-07-2008 9
Flowing Artesian? [ ] Dry Hole? [ ]
WATER BEARING ZONES Depth water was first found 16
SWL Date From To Est Flow SWL(psi) + SWL(ft)
03-07-2008 16 60 1,200 9

(11) WELL LOG
Ground Elevation \_\_\_
Material From To
Sandy Loam 0 10
Cemented gravel 10 16
Gravel & sand 16 60
Allowed formation to naturally cave in around casing below 20'
RECEIVED
JONES DRILLING CO., INC. MAR 25 2008
29400 SANTIAM HWY.
LEBANON, OR 97355
541-367-2560 541-451-2686
1-800-915-8388
WATER RESOURCES DEPT
SALEM, OREGON

(unbonded) Water Well Constructor Certification
I certify that the work I performed on the construction, deepening, alteration, or abandonment of this well is in compliance with Oregon water supply well construction standards. Materials used and information reported above are true to the best of my knowledge and belief.
License Number 1411 Date 03-20-2008
Password: (if filing electronically)
Signed [Signature]
(bonded) Water Well Constructor Certification
I accept responsibility for the construction, deepening, alteration, or abandonment work performed on this well during the construction dates reported above. All work performed during this time is in compliance with Oregon water supply well construction standards. This report is true to the best of my knowledge and belief.
License Number 1684 Date 03-20-2008
Password: (if filing electronically)
Signed [Signature]
Contact Info (optional) Jones Drilling Co., Inc. 1-800-915-8388

LINN 58250

AKA Well #5

STATE OF OREGON
WATER SUPPLY WELL REPORT
(as required by ORS 537.765 & OAR 690-205-0210)

WELL LABEL # L 92439

START CARD # 198003

(1) LAND OWNER Owner Well I.D. 4933

First Name Bill Last Name Sabol
Company DJ Edwards Family LLC
Address P.O. Box 425
City St. Paul State OR Zip 97137

(2) TYPE OF WORK [X] New Well [ ] Deepening [ ] Conversion
[ ] Alteration (repair/recondition) [ ] Abandonment

(3) DRILL METHOD
[X] Rotary Air [ ] Rotary Mud [ ] Cable [ ] Auger [ ] Cable Mud
[ ] Reverse Rotary [ ] Other

(4) PROPOSED USE [ ] Domestic [X] Irrigation [ ] Community
[ ] Industrial/ Commercial [ ] Livestock [ ] Dewatering
[ ] Thermal [ ] Injection [ ] Other

(5) BORE HOLE CONSTRUCTION Special Standard [ ] (Attach copy)
Depth of Completed Well 60 ft.

Table with columns: Dia, From, To, Material, From, To, Amt, sacks/lbs. Row 1: 16, 0, 60, Bentonite, 0, 18, 30, S

How was seal placed: Method [ ] A [ ] B [ ] C [ ] D [ ] E

[X] Other Poured dry

Backfill placed from ft. to ft. Material

Filter pack from ft. to ft. Material Size

Explosives used: [ ] Yes Type Amount

(6) CASING/LINER

Table with columns: Casing, Liner, Dia, From, To, Gauge, Std, Plstc, Wld, Thrd. Row 1: 12, 2, 20, 250, 10, 10, 10, 10

Shoe [ ] Inside [ ] Outside [ ] Other Location of shoe(s)

Temp casing [X] Yes Dia 16 From 1 To 60

(7) PERFORATIONS/SCREENS

Perforations Method Torch cut

Screens Type Material

Table with columns: Perf/S, Casing, Screen, Dia, From, To, Scrn/slot width, Slot length, # of slots, Tele/pipe size. Row 1: 1, Casing, 20, 60, .438, 10, 10, 10

(8) WELL TESTS: Minimum testing time is 1 hour

Table with columns: Pump, Bailer, Air, Flowing Artesian, Yield gal/min, Drawdown, Drill stem/Pump depth, Duration (hr). Row 1: 1,000, 55, 2

Temperature 54 °F Lab analysis [ ] Yes By

Water quality concerns? [ ] Yes (describe below)

Table with columns: From, To, Description, Amount, Units

(9) LOCATION OF WELL (legal description)

County LINN Twp 9 S N/S Range 3 W E/W WM
Sec 32 SW 1/4 of the SW 1/4 Tax Lot 200
Tax Map Number Lot
Lat " or 0 DMS or DD
Long " or 0 DMS or DD
[ ] Street address of well [X] Nearest address

Cooper Dr., Albany, OR

(10) STATIC WATER LEVEL

Table with columns: Date, SWL(psi), + SWL(ft). Row 1: 04-18-2008, 1,000, 13

WATER BEARING ZONES

Depth water was first found 18

Table with columns: SWL Date, From, To, Est Flow, SWL(psi), + SWL(ft). Row 1: 04-18-2008, 18, 50, 1,000, 13

(11) WELL LOG

Ground Elevation

Table with columns: Material, From, To. Row 1: Brown sandy loam, 0, 10; Cemented gravel, 10, 18; Sand & gravel, 18, 50; Blue clay, 50, 60

Naturally caved in around 14" casing from 18' - 60'

RECEIVED

JONES DRILLING CO., INC.

29400 SANTIAM HWY.

LEBANON, OR 97355

541-367-2560 541-451-2686

1-800-915-8388

APR 23 2008

WATER RESOURCES DEPT SALEM, OREGON

Date Started 04-17-2008

Completed 04-18-2008

(unbonded) Water Well Constructor Certification

I certify that the work I performed on the construction, deepening, alteration, or abandonment of this well is in compliance with Oregon water supply well construction standards. Materials used and information reported above are true to the best of my knowledge and belief.

License Number 1411

Date 04-22-2008

Password: (if filing electronically)

Signed

(bonded) Water Well Constructor Certification

I accept responsibility for the construction, deepening, alteration, or abandonment of work performed on this well during the construction dates reported. All work performed during this time is in compliance with Oregon water supply well construction standards. This report is true to the best of my knowledge and belief.

License Number 1684

Date 04-22-2008

Password: (if filing electronically)

Signed

Contact Info (optional) Jones Drilling Co., Inc.

1-800-915-8388

WATER RESOURCES DEPT SALEM, OREGON

RECEIVED

ORIGINAL - WATER RESOURCES DEPARTMENT

THIS REPORT MUST BE SUBMITTED TO THE WATER RESOURCES DEPARTMENT WITHIN 30 DAYS OF COMPLETION OF WORK