

AKA Well #1

GR-772

STATE ENGINEER
Salem, Oregon

LINN
4536

Well Record


STATE WELL NO. 10/3W-6H(2)
COUNTY Linn
APPLICATION NO. GR-772

OWNER: Ardle Edwards MAILING ADDRESS: Rt. 2, Box 350

LOCATION OF WELL: Owner's No. 1 CITY AND STATE: Albany, Oregon

SE 1/4 NE 1/4 Sec. 6 T. 10 N. S. R. 3 E. W. W.M.

Bearing and distance from section or subdivision
corner 1825' S. & 20' W. of NE cor. Sec. 6

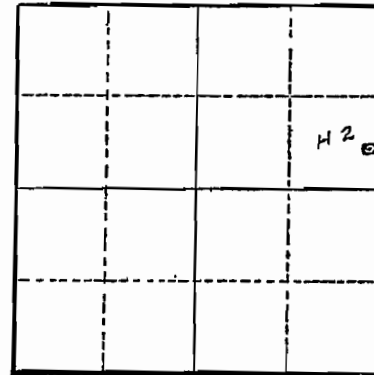

Altitude at well 180 ft. Interpolated

TYPE OF WELL: drilled Date Constructed April 1948

Depth drilled 22 ft. Depth cased 22 ft.

Section 6

CASING RECORD: 8 inch

FINISH:

AQUIFERS:

WATER LEVEL: 8 ft.

PUMPING EQUIPMENT: Type Fairbanks Morse electric centrifugal H.P. 10
Capacity G.P.M.

WELL TESTS:

Drawdown ft. after hours G.P.M.

Drawdown ft. after hours G.P.M.

USE OF WATER irrigation Temp. °F. 19

SOURCE OF INFORMATION GR-772

DRILLER or DIGGER

ADDITIONAL DATA:

Log Water Level Measurements Chemical Analysis Aquifer Test

REMARKS: Log: Sandy loam 0 to 6
Gravel ?

RECEIVED

MAR 20 2012

WATER RESOURCES DEPT
SALEM, OREGON

AKA Well #2

STATE ENGINEER
Salem, Oregon

Linn
3150

Well Record

STATE WELL NO. 9/3W-31R(1)
COUNTY Linn
APPLICATION NO. GR-773

OWNER: Ardle Edwards


MAILING ADDRESS: Rt. 2, Box 350

LOCATION OF WELL: Owner's No. 2

CITY AND STATE: Albany, Oregon

SE 1/4 SE 1/4 Sec. 31 T. 9 N. S. R. 3 E. W., W.M.

Bearing and distance from section or subdivision
corner 300' N. of SE cor. Sec. 31

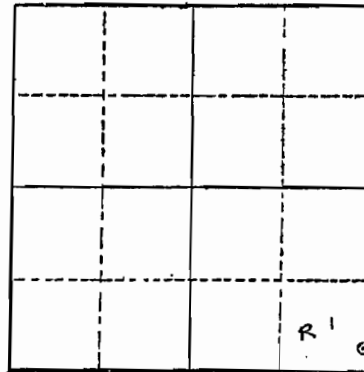

Altitude at well 187 ft. Interpolated

TYPE OF WELL: drilled Date Constructed 4/1/50

Depth drilled 26 ft. Depth cased 26 ft.

Section 31

CASING RECORD: 10 inch

FINISH:

AQUIFERS:

WATER LEVEL: 13 ft.

PUMPING EQUIPMENT: Type F. M. electric H.P. 20
Capacity G.P.M.

WELL TESTS:

Drawdown ft. after hours G.P.M.

Drawdown ft. after hours G.P.M.

USE OF WATER Irrigation Temp. °F., 19

SOURCE OF INFORMATION GR-773

DRILLER or DIGGER

ADDITIONAL DATA:

Log Water Level Measurements Chemical Analysis Aquifer Test

REMARKS:

RECEIVED

MAR 20 2012

WATER RESOURCES DEPT
SALEM, OREGON

STATE ENGINEER
Salem, Oregon

Linn
3161

AKA Well #3 Well Record

STATE WELL NO. 9/3W-32N(1)
COUNTY Linn
APPLICATION NO. GR-774

OWNER: Ardle Edwards

MAILING ADDRESS: Rt. 2, Box 350

LOCATION OF WELL: Owner's No. 3

CITY AND STATE: Albany, Oregon

SW 1/4 SW 1/4 Sec. 32 T. 9 N. S., R. 3 E. W., W.M.

Bearing and distance from section or subdivision corner 400' N. & 400' E. of SW cor. Sec. 32

Altitude at well 187 ft. Interpolated

TYPE OF WELL: drilled Date Constructed April, 1955

Depth drilled 26 ft. Depth cased 26 ft.

CASING RECORD: 10 inch

<u>N</u>			
<u>⊙</u>			

Section 32

FINISH:

AQUIFERS:

WATER LEVEL: 13 ft.

PUMPING EQUIPMENT: Type Fairbanks Morse electric H.P. 10
Capacity _____ G.P.M.

WELL TESTS:

Drawdown _____ ft. after _____ hours _____ G.P.M.
Drawdown _____ ft. after _____ hours _____ G.P.M.

USE OF WATER irrigation Temp. _____ °F. _____, 19____

SOURCE OF INFORMATION GR-774

DRILLER or DIGGER Hamilton Drilling Co., Albany

ADDITIONAL DATA:

Log Water Level Measurements _____ Chemical Analysis _____ Aquifer Test _____

REMARKS: Log: Sandy loam 0 to 5 ft.
Sand & gravel ?
(This location of land has spots of gravel)

RECEIVED

MAR 20 2012

WATER RESOURCES DEPT
SALEM, OREGON

LINN 58218

AKA Well #4

STATE OF OREGON
WATER SUPPLY WELL REPORT
(as required by ORS 537.765 & OAR 690-205-0210)

WELL LABEL # L 92436
START CARD # 197219

(1) LAND OWNER Owner Well I.D. 4929
First Name Bill Last Name Sabol
Company DJ Edwards Family LLC
Address P.O. Box 425
City St. Paul State OR Zip 97137

(2) TYPE OF WORK [X] New Well [] Deepening [] Conversion
[] Alteration (repair/recondition) [] Abandonment

(3) DRILL METHOD
[X] Rotary Air [] Rotary Mud [] Cable [] Auger [] Cable Mud
[] Reverse Rotary [] Other

(4) PROPOSED USE [] Domestic [X] Irrigation [] Community
[] Industrial/ Commercial [] Livestock [] Dewatering
[] Thermal [] Injection [] Other

(5) BORE HOLE CONSTRUCTION Special Standard [] (Attach copy)
Depth of Completed Well 59 ft.

Table with columns: Dia, From, To, Material, From, To, Amt, lbs. Row 1: 16, 0, 59, Bentonite, 0, 19, 90, S

How was seal placed: Method [] A [] B [] C [] D [] E
[X] Other Poured dry

Backfill placed from ft. to ft. Material
Filter pack from ft. to ft. Material Size
Explosives used: [] Yes Type Amount

(6) CASING/LINER
Table with columns: Casing, Liner, Dia, From, To, Gauge, Stl, Plstc, Wld, Thrd. Row 1: 12, 2, 19, 250, 2, 250, X

Shoe [] Inside [] Outside [] Other Location of shoe(s)
Temp casing [X] Yes Dia 16 From 1 To 60

(7) PERFORATIONS/SCREENS
Perforations Method Torch cut
Screens Type Material

Table with columns: Perf/S, Casing/Screen, Dia, From, To, Scm/slot width, Slot length, # of slots, Tel/pipe size. Row 1: 19, 59, 438, 10, 400

(8) WELL TESTS: Minimum testing time is 1 hour
[] Pump [] Bailer [X] Air [] Flowing Artesian
Yield gal/min Drawdown Drill stem/Pump depth Duration (hr)
1,200 55 1

Table with columns: From, To, Description, Amount, Units. Row 1: 54, Lab analysis, Yes

(9) LOCATION OF WELL (legal description)
County LINN Twp 10 S N/S Range 3 W E/W WM
Sec 6 SE 1/4 of the NE 1/4 Tax Lot 102
Tax Map Number Lot
Lat " or 0 DMS or DD
Long " or 0 DMS or DD
[] Street address of well [X] Nearest address
Next to 32633 Cooper Dr. NE, Albany, OR 97321

(10) STATIC WATER LEVEL
Date SWL(psi) + SWL(ft)
Existing Well / Predeepening
Completed Well 03-07-2008 9
Flowing Artesian? [] Dry Hole? []
WATER BEARING ZONES Depth water was first found 16
SWL Date From To Est Flow SWL(psi) + SWL(ft)
03-07-2008 16 60 1,200 9

(11) WELL LOG
Ground Elevation
Material From To
Sandy Loam 0 10
Cemented gravel 10 16
Gravel & sand 16 60
Allowed formation to naturally cave in around casing below 20'
RECEIVED
JONES DRILLING CO., INC.
29400 SANTIAM HWY.
LEBANON, OR 97355
541-367-2560 541-451-2686
1-800-915-8388
MAR 25 2008
WATER RESOURCES DEPT
SALEM, OREGON

Date Started 03-06-2008 Completed 03-07-2008

(unbonded) Water Well Constructor Certification
I certify that the work I performed on the construction, deepening, alteration, or abandonment of this well is in compliance with Oregon water supply well construction standards. Materials used and information reported above are true to the best of my knowledge and belief.

License Number 1411 Date 03-20-2008
Password: (if filing electronically)
Signed [Signature]

(bonded) Water Well Constructor Certification
I accept responsibility for the construction, deepening, alteration, or abandonment work performed on this well during the construction dates reported above. All work performed during this time is in compliance with Oregon water supply well construction standards. This report is true to the best of my knowledge and belief.

License Number 1684 Date 03-20-2008
Password: (if filing electronically)
Signed [Signature]
Contact Info (optional) Jones Drilling Co., Inc. 1-800-915-8388

LINN 58250

AKA Well #5

STATE OF OREGON
WATER SUPPLY WELL REPORT
(as required by ORS 537.765 & OAR 690-205-0210)

WELL LABEL # L 92439

START CARD # 198003

(1) LAND OWNER Owner Well I.D. 4933
First Name Bill Last Name Sabol
Company DJ Edwards Family LLC
Address P.O. Box 425
City St. Paul State OR Zip 97137

(2) TYPE OF WORK [X] New Well [] Deepening [] Conversion
[] Alteration (repair/recondition) [] Abandonment

(3) DRILL METHOD
[X] Rotary Air [] Rotary Mud [] Cable [] Auger [] Cable Mud
[] Reverse Rotary [] Other

(4) PROPOSED USE [] Domestic [X] Irrigation [] Community
[] Industrial/ Commercial [] Livestock [] Dewatering
[] Thermal [] Injection [] Other

(5) BORE HOLE CONSTRUCTION Special Standard [] (Attach copy)
Depth of Completed Well 60 ft.

Table with columns: Dia, From, To, Material, SEAL, Amt, lbs. Row 1: 16, 0, 60, Bentonite, 0, 18, 30, S

How was seal placed: Method [] A [] B [] C [] D [] E

[X] Other Poured dry

Backfill placed from ft. to ft. Material

Filter pack from ft. to ft. Material Size

Explosives used: [] Yes Type Amount

(6) CASING/LINER

Table with columns: Casing Liner, Dia, From, To, Gauge, Std, Plstc, Wld, Thrd. Row 1: 12, 2, 20, 250, Std, Plstc, Wld, Thrd

Shoe [] Inside [] Outside [] Other Location of shoe(s)

Temp casing [X] Yes Dia 16 From 1 To 60

(7) PERFORATIONS/SCREENS

Perforations Method Torch cut

Screens Type Material

Table with columns: Perf/S, Casing/Screen, Dia, From, To, Scrm/slot width, Slot length, # of slots, Tele/pipe size

(8) WELL TESTS: Minimum testing time is 1 hour

[] Pump [] Bailer [X] Air [] Flowing Artesian

Table with columns: Yield gal/min, Drawdown, Drill stem/Pump depth, Duration (hr). Row 1: 1,000, 55, 2

Temperature 54 °F Lab analysis [] Yes By

Water quality concerns? [] Yes (describe below)

Table with columns: From, To, Description, Amount, Units

(9) LOCATION OF WELL (legal description)

County LINN Twp 9 S N/S Range 3 W E/W WM
Sec 32 SW 1/4 of the SW 1/4 Tax Lot 200
Tax Map Number Lot
Lat " or 0 DMS or DD
Long " or 0 DMS or DD
[] Street address of well [X] Nearest address

Cooper Dr., Albany, OR

(10) STATIC WATER LEVEL

Table with columns: Date, SWL(psi), SWL(ft). Row 1: 04-18-2008, 13

Flowing Artesian? [] Dry Hole? []

WATER BEARING ZONES

Depth water was first found 18

Table with columns: SWL Date, From, To, Est Flow, SWL(psi), SWL(ft). Row 1: 04-18-2008, 18, 50, 1,000, 13

(11) WELL LOG

Ground Elevation

Table with columns: Material, From, To. Row 1: Brown sandy loam, 0, 10

Naturally caved in around 14" casing from 18' - 60'

RECEIVED

JONES DRILLING CO., INC.
29400 SANTIAM HWY.
LEBANON, OR 97355
541-367-2560 541-451-2686
1-800-915-8388

APR 23 2008

WATER RESOURCES DEPT
SALEM, OREGON

Date Started 04-17-2008 Completed 04-18-2008

(unbonded) Water Well Constructor Certification

I certify that the work I performed on the construction, deepening, alteration, or abandonment of this well is in compliance with Oregon water supply well construction standards. Materials used and information reported above are true to the best of my knowledge and belief.

License Number 1411

Date 04-22-2008

Password: (if filing electronically)

Signed

(bonded) Water Well Constructor Certification

I accept responsibility for the construction, deepening, alteration, or abandonment work performed on this well during the construction dates reported above. All work performed during this time is in compliance with Oregon water supply well construction standards. This report is true to the best of my knowledge and belief.

License Number 1684

Date 04-22-2008

Password: (if filing electronically)

Signed

Contact Info (optional) Jones Drilling Co., Inc. 1-800-915-8388

RECEIVED
WATER RESOURCES DEPT
SALEM, OREGON
APR 20 2008

ORIGINAL - WATER RESOURCES DEPARTMENT

THIS REPORT MUST BE SUBMITTED TO THE WATER RESOURCES DEPARTMENT WITHIN 30 DAYS OF COMPLETION OF WORK

Form Version: 0.89