



Sec 7 4N-29

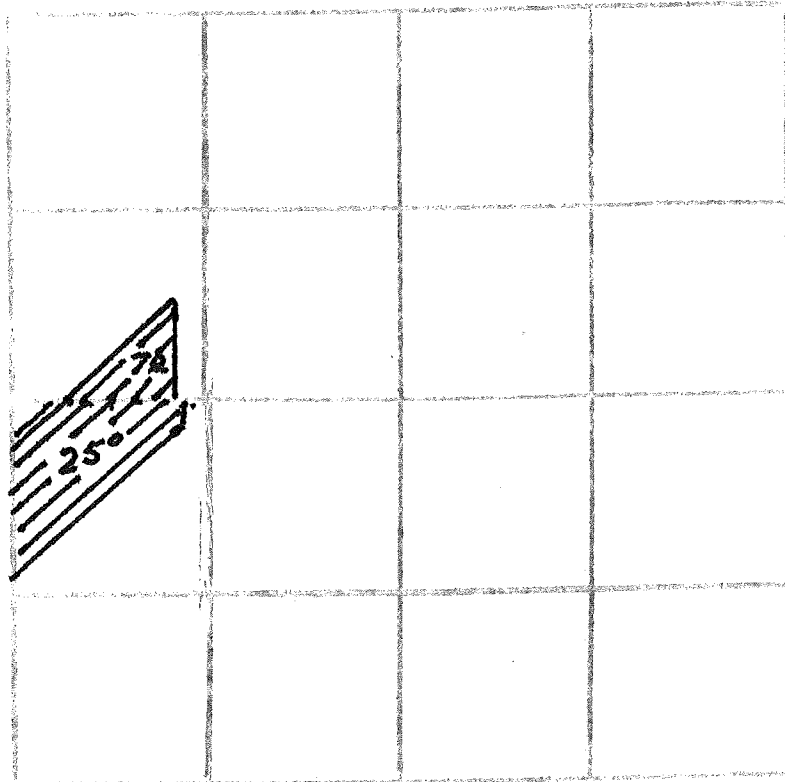

FROM

T-3183

NW 1/4 SEC 17-4N-29

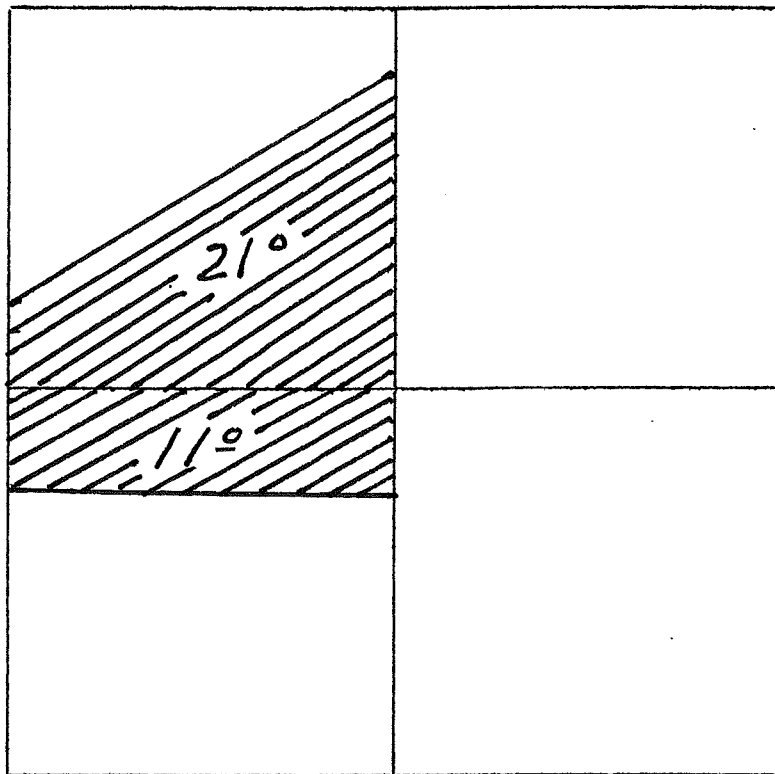

To:

T-3183