

#3

LAKE 51764

amended
Lake 51764

STATE OF OREGON
WATER SUPPLY WELL REPORT
(as required by ORS 937.765)

WELL I.D.# 87845

START CARD # W17193

Instructions for completing this report are on the last page of this form.


Well Number

(2) TYPE OF WORK New Well
 Deepening Alteration (repair/maintenance) Abandonment Conversion

(3) DRILL METHOD
 Rotary Air Rotary Mud Cable Auger Cable Mud
 Other

(4) PROPOSED USE
 Domestic Community Industrial Irrigation
 Thermal Injection Livestock Other

(5) BORE HOLE CONSTRUCTION Special Construction: Yes No
Depth of Completed Well 325 ft.
Explosives used: Yes No Type _____ Amount _____

BORE HOLE			SEAL		
Diameter	From	To	Material	From	To
12.4	0	37	Water Tight Top	37	325
15.4	37	325			
10.4	325	325			

How was seal placed: Method A B C D E
 Other _____
Backfill placed from _____ ft. to _____ ft. Material _____
Gravel placed from _____ ft. to _____ ft. Size of gravel _____

Casing	Diameter	From	To	Gauge	Steel	Plastic		
						Walled	Threaded	
18" Top	18"	0	37	3/4"	<input checked="" type="checkbox"/>	<input type="checkbox"/>	<input type="checkbox"/>	<input type="checkbox"/>

Drive Shoe used Inside Outside None
Final location of shoe(s) _____

(7) PERFORATIONS/SCREENS

Perforations Method _____
 Screens Type _____ Material _____

From	To	Slot Size	Number	Diameter	Telegraph	Casing	Liner
						<input type="checkbox"/>	<input type="checkbox"/>

(8) WELL TESTS: Minimum testing time is 1 hour
 Pump Bailor Air Flowing Artesian

Yield gal/min	Drawdown	Drill stem at	Time
2000	-	400	2 hrs

Temperature of water _____ Depth Artesian Flow Found _____
Was a water analysis done? Yes By whom _____
Did any strata contain water not suitable for intended use? To little
 Salty Muddy Odor Colored Other _____
Depth of strata: _____

(9) LOCATION OF WELL (legal description)
Section 33 1/4 1/4 1/4

Lat _____ or _____ (degrees or decimal)
Long _____ or _____ (degrees or decimal)

Street Address of Well (or nearest address) Plainsville Rd

(10) STATIC WATER LEVEL
31 1/2 ft. below land surface. Date 4-12-06
31 ft. below land surface. Date 4-13-06
Artesian pressure _____ ft. per square inch Date _____

(11) WATER BEARING ZONES
Depth at which water was first found 95

From	To	Estimated Flow Rate	SWL
25	115		
275	325		
437	460		

(12) WELL LOG

Material	From	To	SWL
Top soil	Surface	3	
Yellowish Clay	3	115	
Yellow Clay	115	161	
Rock	161	212	
Black Sand Pumice	212		
Hard Sand	375	410	
Clay	410	437	
Black Sand Rock	437	460	

Helper Deanne E. Hardy

Date Started 4-10-06 Completed 4-13-06

(Unbonded) Water Well Constructor Certification
I certify that the work I performed on the construction, deepening, alteration, or abandonment of this well is in compliance with Oregon water supply well construction standards. Materials used and information reported above are true to the best of my knowledge and belief.

WWC Number _____ Date 5-10-06
Signed Alan Park

(Bonded) Water Well Constructor Certification
I accept responsibility for the construction, deepening, alteration, or abandonment work performed on this well during the construction dates reported above. All work performed during this time is in compliance with Oregon water supply well construction standards. This report is true to the best of my knowledge and belief.

WWC Number _____ Date _____
Signed _____

RECEIVED
MAY 30 2006
FIRST COPY - CONSTRUCTOR
WATER RESOURCES DEPT.
SALEM, OREGON

ORIGINAL WITH RESOURCES DEPARTMENT
RECEIVED

OCT 11 2007
WATER RESOURCES DEPT.
SALEM, OREGON

RECEIVED BY OWRD
RECEIVED BY OWRD

RECEIVED BY OWRD

AUG 15 2012

JUL 23 2012

SALEM, OR

SALEM, OR

T011462

STATE OF OREGON
WATER SUPPLY WELL REPORT
(as required by ORS 537.765)

LAKE 51764

Lake 51764

WELL I.D. # L 87845

START CARD # W187193

Instructions for completing this report are on the last page of this form.

(1) LAND OWNER Well Number
Name The Poplars Ranch Inc - ALAN PARKS
Address 59234 Four Rock Rd
City SILVER LAKE State OR Zip 97638

(2) TYPE OF WORK New Well
 Deepening Alteration (repair/recondition) Abandonment Conversion

(3) DRILL METHOD
 Rotary Air Rotary Mud Cable Auger Cable Mud
 Other

(4) PROPOSED USE
 Domestic Community Industrial Irrigation
 Thermal Injection Livestock Other

(5) BORE HOLE CONSTRUCTION Special Construction: Yes No
Depth of Completed Well 460 ft.
Explosives used: Yes No Type _____ Amount _____

BORE HOLE			SEAL			
Diameter	From	To	Material	From	To	Sacks or Pounds
24	Surface	38	Hole Plug Top	38	45	45
15 1/4	38	235				
10 1/2	235	460				

How was seal placed: Method A B C D E
 Other

Backfill placed from _____ ft. to _____ ft. Material _____
Gravel placed from _____ ft. to _____ ft. Size of gravel _____

(6) CASING/LINER

Diameter	From	To	Gauge	Steel	Plastic	Welded	Threaded
Casing: 18"	Top	38	1/4"	<input checked="" type="checkbox"/>	<input type="checkbox"/>	<input type="checkbox"/>	<input type="checkbox"/>
Liner:				<input type="checkbox"/>	<input type="checkbox"/>	<input type="checkbox"/>	<input type="checkbox"/>

Drive Shoe used Inside Outside None
Final location of shoe(s) _____

(7) PERFORATIONS/SCREENS
 Perforations Method _____
 Screens Type _____ Material _____

From	To	Slot Size	Number	Diameter	Tele/pipe size	Casing	Liner
						<input type="checkbox"/>	<input type="checkbox"/>
						<input type="checkbox"/>	<input type="checkbox"/>
						<input type="checkbox"/>	<input type="checkbox"/>

(8) WELL TESTS: Minimum testing time is 1 hour
 Pump Bailor Air Flowing Artesian

Yield gal/min	Drawdown	Drill stem at	Time
2000+	-	400	2 hrs

Temperature of water _____ Depth Artesian Flow Found _____
Was a water analysis done? Yes By whom _____
Did any strata contain water not suitable for intended use? Too little
 Salty Muddy Odor Colored Other _____
Depth of strata: _____

(9) LOCATION OF WELL (legal description)
County LAKE
Tax Lot 4400 Lot _____
Township 26 S N or S Range 15 E E or W WM
Section 33 NW 1/4 NW 1/4

Lat _____ " or _____ (degrees or decimal)
Long _____ " or _____ (degrees or decimal)

Street Address of Well (or nearest address) Plainview Rd

(10) STATIC WATER LEVEL
31 1/2 ft. below land surface. Date 4-12-06
31 ft. below land surface. Date 4-13-06
Artesian pressure _____ lb. per square inch Date _____

(11) WATER BEARING ZONES
Depth at which water was first found 95

From	To	Estimated Flow Rate	SWL
95	115		
213	388		
438	460		

(12) WELL LOG

Material	From	To	SWL
Topsoil	Surface	3	
Hardpan Clay	3	115	
HARD CLAY	115	161	
ROCK	161	212	
Black Sand, Pumice and Green Clay	212	388	
HARD ROCK 1	388	410	
SLAY	410	438	
BLACK LAVA ROCK	438	460	

Date Started 4-10-06 Completed 4-13-06

(unbonded) Water Well Constructor Certification
I certify that the work I performed on the construction, deepening, alteration, or abandonment of this well is in compliance with Oregon water supply well construction standards. Materials used and information reported above are true to the best of my knowledge and belief.

WWC Number _____ Date 5-10-06

Signed Alan Parks

(bonded) Water Well Constructor Certification
I accept responsibility for the construction, deepening, alteration, or abandonment work performed on this well during the construction dates reported above. All work performed during this time is in compliance with Oregon water supply well construction standards. This report is true to the best of my knowledge and belief.

WWC Number _____ Date _____

RECEIVED
Signed _____

ORIGINAL - WATER RESOURCES DEPARTMENT

FIRST COPY - CONSTRUCTOR

SECOND COPY - WATER RESOURCES DEPARTMENT 06/14/2006

RECEIVED BY OWRD

WATER RESOURCES DEPT
SALEM, OREGON

RECEIVED BY OWRD

AUG 15 2012

SALEM, OR

T011462

JUL 23 2012

SALEM, OR

STATE ENGINEER
Salem, Oregon

OBSERVATION WELL

Well Record

STATE WELL NO. 27/15-4G(1)
COUNTY Lake
APPLICATION NO. GR-347
6-10917


OWNER: M. Y. Parks

MAILING ADDRESS:
CITY AND STATE:

LOCATION OF WELL: Owner's No. Fort Rock, Oregon

SW 1/4 NE 1/4 Sec. 4 T. 27 N. S., R. 15 E. W., W.M.

Bearing and distance from section or subdivision corner

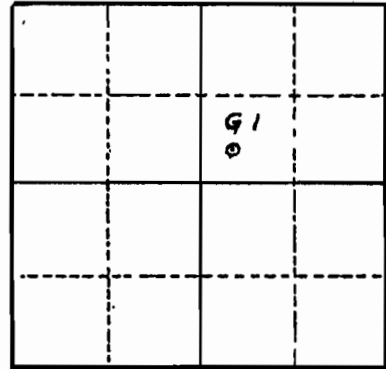

Section 4

Altitude at well 4.335

TYPE OF WELL: drilled Date Constructed 1922

Depth drilled 257 Depth cased 14

CASING RECORD:

FINISH: Open hole below casing

AQUIFERS: coarse agglomerate

WATER LEVEL: 38.70 ft. below land surface, Sept. 4, 1932

PUMPING EQUIPMENT: Type turbine H.P.
Capacity 1500 G.P.M.

WELL TESTS:
Drawdown 3.45 ft. after 50 min. hours pumping 1100 G.P.M.
Drawdown ft. after hours G.P.M.

USE OF WATER Irrigation Temp. 62 °F. October 24, 1948

SOURCE OF INFORMATION USGS Report

DRILLER or DIGGER

ADDITIONAL DATA:

Log Water Level Measurements X Chemical Analysis X Aquifer Test

REMARKS: Test well constructed by State in 1922.

RECEIVED BY OWRD RECEIVED BY OWRD

AUG 15 2012

JUL 23 2012