
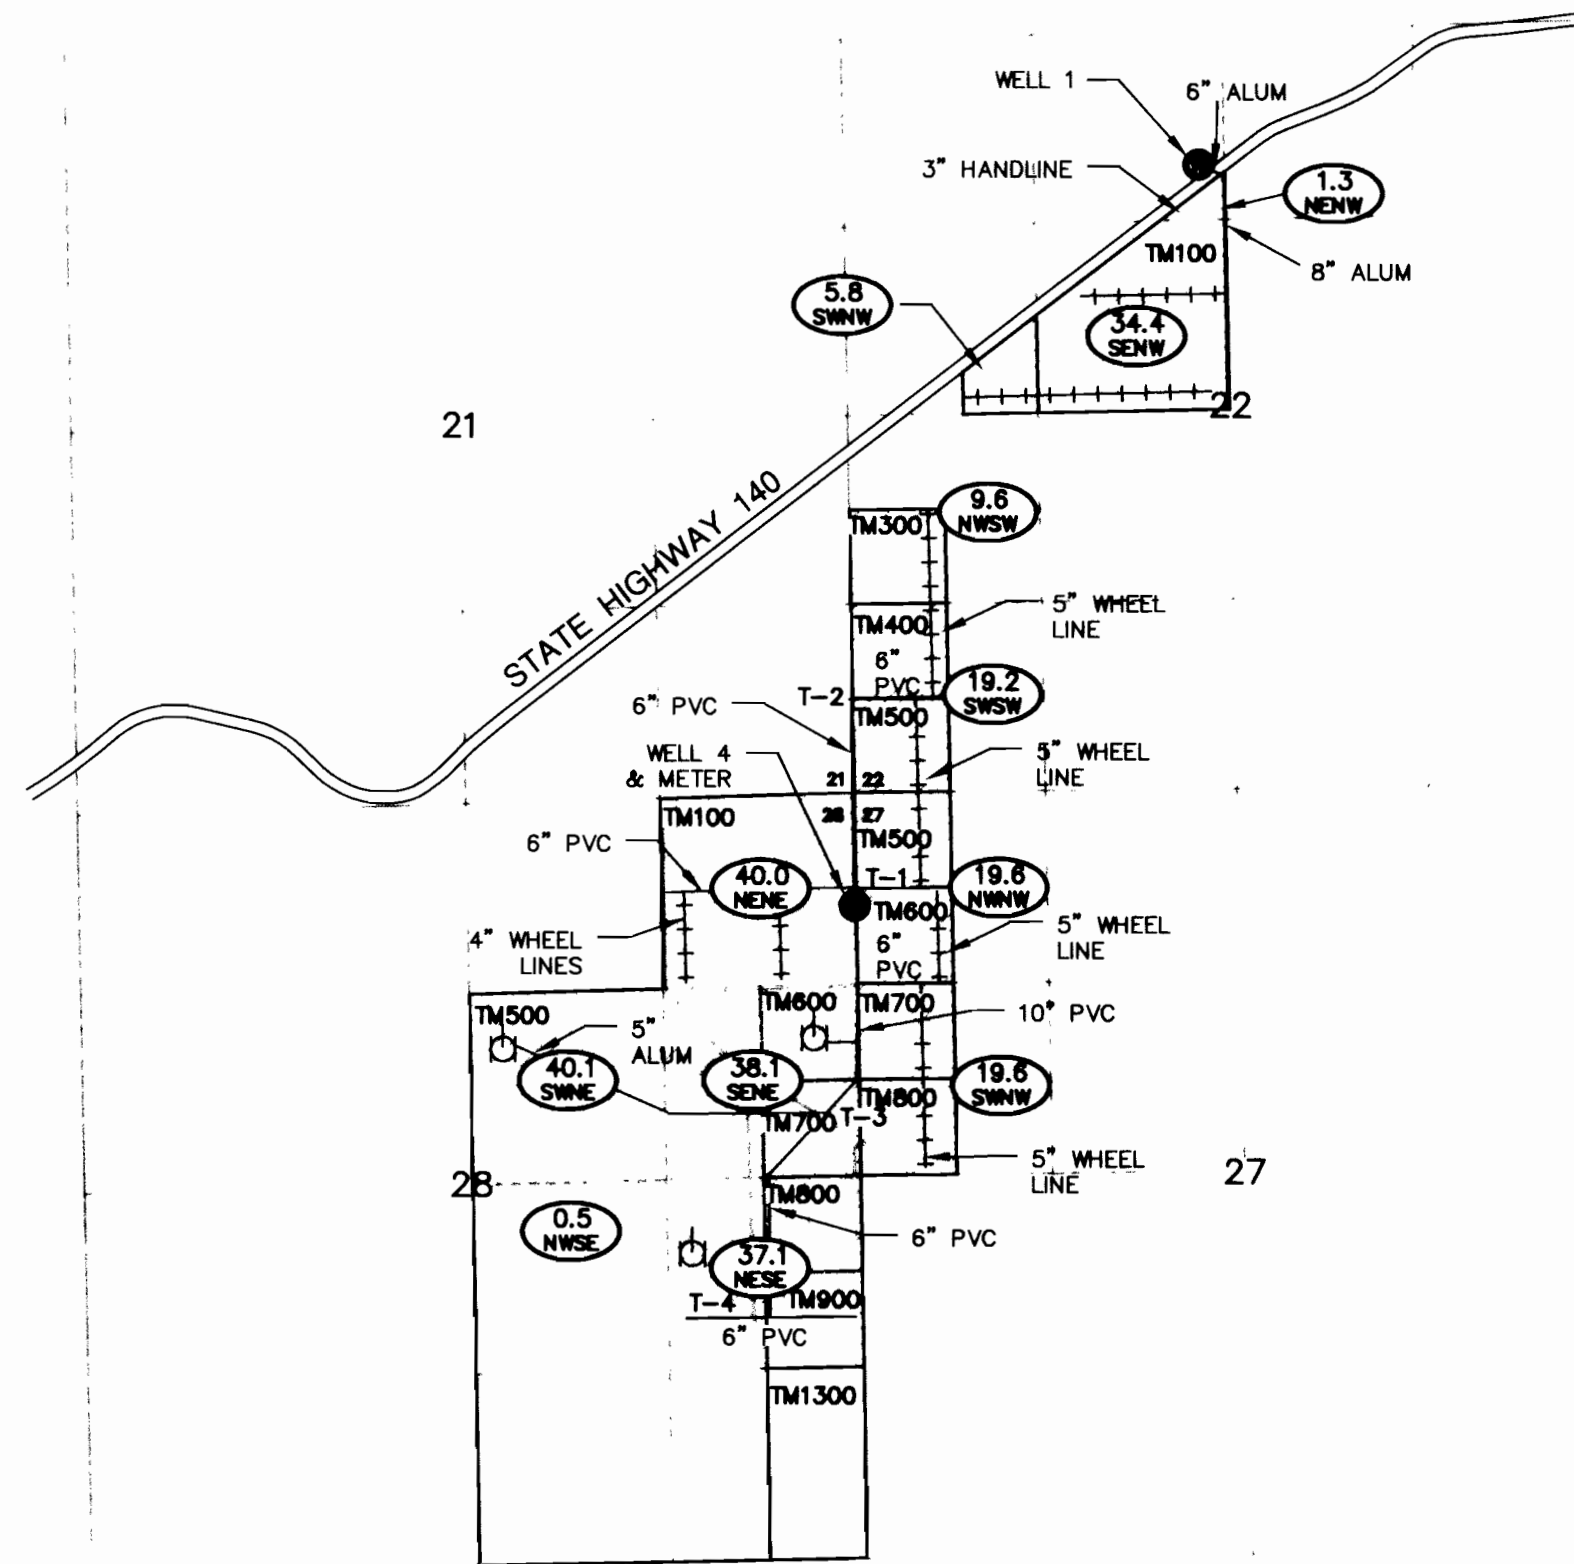


CLAIM OF BENEFICIAL USE AND FINAL PROOF MAP

FOR
LARRY J. AND JOAN A. SEES
T36S, R12E, Sec's 22, 27 & 28 W.M.
KLAMATH COUNTY, OREGON
PERMIT No. G-12527
PERMIT AMENDMENT No. T-10970

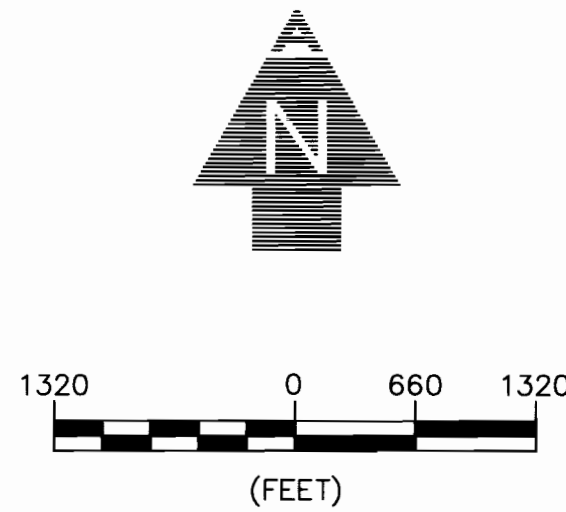

WELL 1 - KLAM 2081

TWP	RANGE	MER	SEC	Q-Q	TAX LOT NUMBER	PERMITTED ACRES	# IRRIGATED ACRES
36S	12E	WM	22	NE NW	100	1.3	1.3
				SW NW	100	6.5	5.8
				SE NW	100	35.41	34.4
						43.21	41.5

WELL TIES:

WELL 1 - KLAM 2081:
930' SOUTH AND 2430'
EAST FROM THE NW
CORNER SECTION 22.

WELL 4 - KLAM 10447


TWP	RANGE	MER	SEC	Q-Q	TAX LOT NUMBER	PERMITTED ACRES	# IRRIGATED ACRES
36S	12E	WM	22	NW SW	300	9.59	9.6
				SW SW	400	19.21	19.2
				500			
			27	NW NW	600	19.59	19.6
				SW NW	700	19.57	19.6
				800			
			28	NE NE	100	40.22	40.0
				SW NE	500	40.06	40.1
				SE NE	600		
				700			
				NE SE	500	36.80	37.1
				800			
				900			
				NW SE	500	0.46	0.5
						226.03	223.8

WELL 4 - KLAM 10447:
SOUTH 1'27'40" WEST 748'
FROM THE NORTHEAST
CORNER OF SECTION 28.



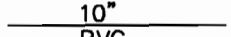
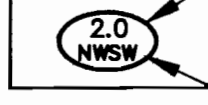

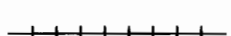
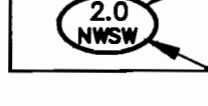
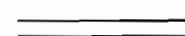




NOTES:

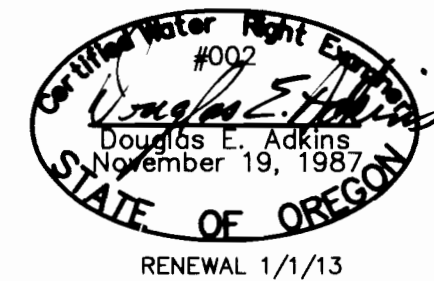- THIS MAP WAS PREPARED FROM FIELD MEASUREMENTS, NAIP 2005 AERIAL PHOTOGRAPH, KLAMATH COUNTY TAX MAPS 361222, 361222A, 361227, 361228 AND OREGON GLO MAPS.
- THE PURPOSE OF THIS MAP IS TO IDENTIFY THE LOCATION OF THE WATER RIGHT ONLY, AND IS NOT INTENDED TO PROVIDE DIMENSIONS OR LOCATION OF PROPERTY LINES.
- FOR TAX LOT INFORMATION, SEE TAX MAP INCLUDED WITH THIS APPLICATION.
- DATE OF PRIORITY FOR THIS APPLICATION IS APRIL 13, 1992.

TOTAL ACRES IRRIGATED: 269.24 265.3

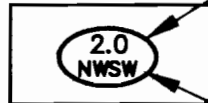

LEGEND

- | | | | | | |
|---|--|---|------------------|---|-----------------------------|
|  | TOTAL ACRES IRRIGATED PER 1/4 1/4 |  | SECTION LINES |  | MAIN LINE SIZE AND MATERIAL |
|  | IRRIGATED LANDS THIS CLAIM OF BENEFICIAL USE |  | 1/4 1/4 LINES |  | 4" WHEEL LINES |
|  | 1/4 1/4 SECTION |  | ROADS |  | PIVOT LINE |
| 7 | SECTION DESIGNATION |  | TAX LOT BOUNDARY |  | BIG GUN |
| TM | TAX MAP NUMBER | | | | |
|  | EXISTING WELL AND OWNERS WEL NUMBER | | | | |

Larry J. Sees
APPLICANT SIGNATURE
Joan A. Sees
APPLICANT SIGNATURE 8/14/12

ADKINS
CONSULTING ENGINEERING, L.L.C. Engineers ▲ Planners ▲ Surveyors
2950 Shasta Way · Klamath Falls, Oregon 97603 · (541) 884-4666 · FAX (541) 884-5335
Oregon · California