



State of Oregon
Water Resources Department
725 Summer Street NE, Suite A
Salem, Oregon 97301-1266
(503) 986-0900

Application for Instream Lease

A summary of review criteria and procedures that are generally applicable to these applications is available at www.wrd.state.or.us/OWRD/PUBS/forms.shtml.

Pursuant to ORS 537.348(2) and OAR 690-077

Optional Identification by Lessor/Lessee: Willow Creek CRP
Lease Application Number (assigned by WRD): 1L-1090

This Lease is between:

Lessor #1:

Name Stonecypher Ranch Inc
Mailing address PO Box 1072
City, State, Zip Code Langlois, OR 97450
Telephone number 541 290 5610
Email address onemikebrown@hotmail.com

Lessor #2, 3, etc.

The water right to be leased is located in Curry County.

Lessee (if different than Oregon Water Resources Department):

Name _____
Mailing address _____
City, State, Zip Code _____
Telephone number _____
Email address _____

RECEIVED
JUL 13 2010
WATER RESOURCES DEPT
SALEM, OREGON

Trustee:

Oregon Water Resources Department
725 Summer Street NE, Suite A
Salem, OR 97301-1266
(503) 986-0900

~I~ Water Right Holder and Water Right Information

1.1 Lessor #1 is the water right holder, or authorized agent for water right holder of the property located at: Township 31 N, Range 15 W, Section 15 and Tax Lot number 600. If the water right appurtenant to these lands is also appurtenant to lands owned by others who are not included in this application, then Attachment 1 (tax lot map), needs to be included.

- 1.2 Lessor #2 is the (Check one):
 Not applicable
 Official representative of _____, the irrigation district which conveys water to the subject water rights.
 Another party with an interest in the subject water rights representing _____.

- 1.3 For the water right(s) being leased, list all water rights appurtenant to the same lands. Indicate if there are any supplemental or overlying rights.

Certificate No. _____

- 1.4 Are some or all of the lands being leased part of a Conservation Reserve Enhancement Program. x Yes No

1.5 **Water Rights Proposed to be Leased Instream.**

The first right to be leased identified in Section 1.3 is further described as follows:

Certificate No.: 68427

Priority date: August 29, 1972 Type of use: irrigation

Legal Season of Use: Mar1-Oct31

Is the entire water right certificate being leased? Yes X No

If no, list the acres of the subject water right by legal description of township, range, section, and ¼ ¼ which will be dried up as part of this lease, and include a map (Attachment 2) showing the lands which will not receive water.

Place of use:

T 31 S, R 15 W, Section 15, ne¼ ne¼ - 6.2 acres to be leased

T 31 S, R 15 W, Section 15, nw¼ nw¼ - 4.2 acres to be leased

T 31 S, R 15 W, Section 15, se¼ se¼ - 4.2 acres to be leased

Enter additional places of use here, using format above:

Page _____ (Identify page number of certificate, if certificate is greater than 10 pages.)

Number of acres being leased, if for irrigation: 14.6

Acre-feet of storage, if applicable: n/a

Maximum rate associated with the right to be leased (cfs): .2345

(Use additional lines if there is more than one rate associated with the water right.)

Maximum duty associated with the right to be leased (ac-ft): 2.5

(Use additional lines if there is more than one duty associated with the water right.)

Conditions or other limitations, if any: _____

Certificate No.: 68426

Priority date: April 12, 1978 Type of use: irrigation

Legal Season of Use: Mar1-Oct31

Is the entire water right certificate being leased? Yes X No

If no, list the acres of the subject water right by legal description of township, range, section, and ¼ ¼ which will be dried up as part of this lease, and include a map (Attachment 2) showing the lands which will not receive water.

RECEIVED

JUL 1 3 2010

WATER RESOURCES DEPT
SALEM, OREGON

Place of use:

T 31 S, R 15 W, Section 15, se¹/₄ se¹/₄ - 8.0 acres to be leased

Page _____ (Identify page number of certificate, if certificate is greater than 10 pages.)

Number of acres being leased, if for irrigation: 8.0

Acre-feet of storage, if applicable: n/a

Maximum rate associated with the right to be leased (cfs): .0999

(Use additional lines if there is more than one rate associated with the water right.)

Maximum duty associated with the right to be leased (ac-ft): 2.5

(Use additional lines if there is more than one duty associated with the water right.)

Conditions or other limitations, if any: _____

1.6 Validity of rights. Lessor(s) attests (mark one) that:

- the water has been used over the past five years according to the terms and conditions of the water right certificate or as an instream water right or
- the water has not been used over the past five years according to the terms and conditions of the water right certificate, however the water right is not subject to forfeiture under ORS 540.610(2)()(include necessary supporting documentation as Attachment 3).

~II~ Instream Water Right Information

2.1 Public use. This lease will increase streamflows that will benefit:

- Conservation, maintenance and enhancement of aquatic and fish life, wildlife, and fish and wildlife habitat
- Pollution abatement
- Recreation and scenic attraction

2.2 Instream use created by lease. The instream use to be created is described as follows:

A portion of 68426

Willow Creek

Tributary to Floras Creek in the South Coast Basin.

RECEIVED

JUL 13 2010

WATER RESOURCES DEPT
SALEM, OREGON

Describe the point of diversion (POD) and any associated reach(es) of the instream use being created. If possible list the reach by river mile. If no reach is identified, and there is only one POD listed on the certificate, the lease may be processed to be protected at the POD. (If more than one POD is listed on the certificate, then the POD and any associated reach(es) must be identified): _____

Maximum volume in acre-feet: 2.5

Rate in cfs: .0999

(Use the section below to indicate a more restrictive period of use than allowed by the water right.)

Conditions to prevent injury, if any:

- None
- X The instream flow will be allocated on a daily average basis up to the described rate from June 23 through Sept 30.
- Other (describe): _____

A portion of 68427

Willow Creek

Tributary to Floras Creek in the South Coast Basin.

Describe the point of diversion (POD) and any associated reach(es) of the instream use being created. If possible list the reach by river mile. If no reach is identified, and there is only one POD listed on the certificate, the lease may be processed to be protected at the POD. (If more than one POD is listed on the certificate, then the POD and any associated reach(es) must be identified): _____

Maximum volume in acre-feet: 2.5

Rate in cfs: .2345

(Use the section below to indicate a more restrictive period of use than allowed by the water right.)

Conditions to prevent injury, if any:

- None
- X The instream flow will be allocated on a daily average basis up to the described rate from June 23 through Sept 30.
- Other (describe): _____

2.3 Term of lease. This lease shall terminate on _____.

2.4 Flow protection. The Trustee will regulate use of water from the source, subject to prior appropriation and the agency enforcement guidance, to assure the water is delivered to the point of diversion, and through the reach past junior downstream users, so long as flow is sufficient to meet the demand under priority date of the new instream use (see Section 2.2). As part of regulation activities the watermaster or a designee has access to the point of diversion and place of use for the water rights involved in this lease. No party is required to continuously measure the flow of the waterway described in Section 2.2.

RECEIVED

JUL 13 2010

WATER RESOURCES DEPT
SALEM, OREGON

~III~ Other Information

3.1 Accuracy. The Undersigned Lessor(s) and Lessee(s) declare that, to the best of their knowledge and belief, the information contained in this application is true, correct and complete. If after the lease order is signed, any information is determined to be false, the lease order may be modified or terminated. The lease only exercises the water rights being leased, for the term of the lease. It shall not be construed to overcome any claim that the water right may otherwise be subject to forfeiture for nonuse pursuant to ORS 540.610 during the period of time prior to the execution of the lease.

3.2 Lease. Lessor(s) and Lessee(s) agree to lease the water rights listed in Section(s) 1.5 for instream use for the term of this lease through Lessee to the Trustee, the Oregon Water Resources Department, pursuant to the provisions of ORS 537.348(2) and OAR 690-077.


- 3.3 Precedent.** If a right which has been leased is later proposed to be leased again or transferred to an instream use under ORS 537.348 and OAR 690-077 a new injury review shall be required, and a prior lease shall not set a precedent for the amount of water to be leased or transferred instream.
- 3.4 Suspension of original use.** During the period of the lease, the water right holder agrees to suspend use of water allowed under the subject water rights and under any water right that is supplemental to the subject water rights.
- 3.5 Termination provision.**
 For multiyear leases, the Lessor(s) shall have the option of terminating the lease each year with written notice to the Department. The lease may be terminated at any time during the calendar year. However, if the termination request is received less than 30-days prior to the period of allowed instream use or after the period of allowed use has begun for the water right(s) being leased, water may not be used under the right(s) leased until the following calendar year, unless the Director determines that enlargement would not occur. The Department may also require:
 - Written notice to the Department with original signatures;
 - Consent by all parties to the lease; and/or
 - Written notice to the Watermaster's office. For multiyear leases, the lessor shall not have the option of terminating the lease, without consent by all parties to the lease.
- 3.6 Modification to prevent injury.** Allocation of water to the instream use described in Section 2.2 during the term of this lease is not reasonably expected to cause injury to other rights to use water from the same source. If injury is found after this lease is signed, the lease may be modified or terminated to prevent injury.
- 3.7 Fees.** Pursuant to ORS 536.050, the following fee is included:
 \$400 for an application with four or more landowners or four or more water rights.
 \$250 for all other applications.

Lessor #1: Michael Brown for: Date: July 10, 2010
Stonecypker Ranch INC.

For additional Lessors, type in space for signature and date

Lessee: _____ Date: JUL 13 2010
RECEIVED
WATER RESOURCES DEPT
SALEM, OREGON

Other Attachments as Needed:
Attachment 1: Tax Lot Map. (See instructions.)

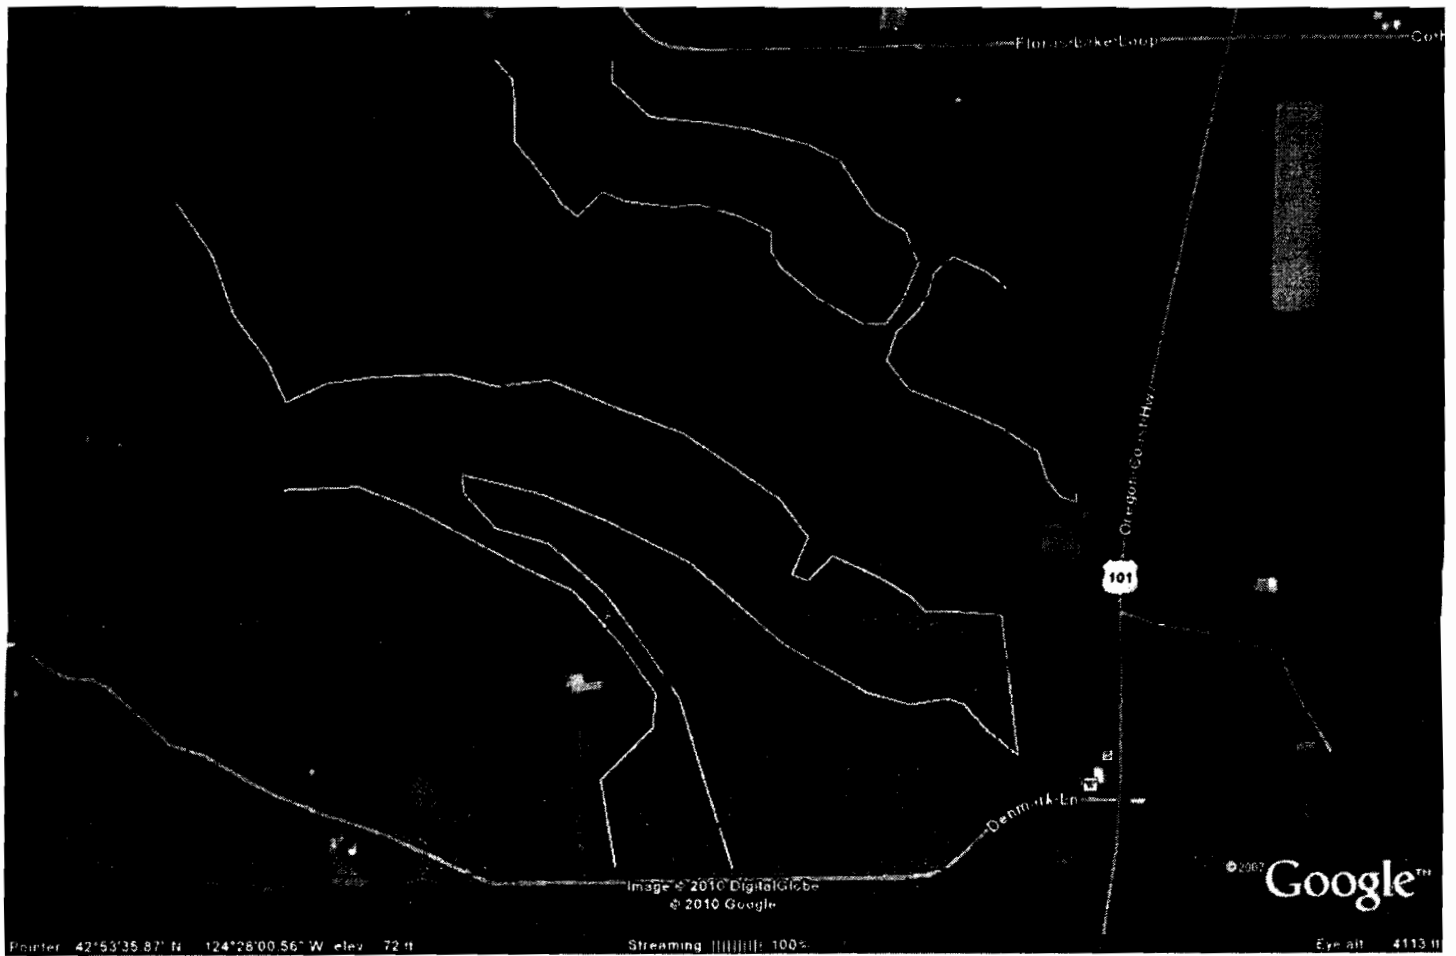

Attachment 2

Summary

Certificate # 68427

Total acres: 72.2

Acres in CRP: 14.6

Certificate # 68426

Total acres: 24.8

Acres in CRP: 8.0

RECEIVED

JUL 13 2010

WATER RESOURCES DEPT
SALEM, OREGON




Covered by permit # 37181 & Certificate # 68427 which superseded Certificate # 45266. Total of 92.8 acres & 1.16 cfs of which 72.2 acres & 0.90 cfs is on Stonecpher Ranch property or 2.5 ac. ft/acre/yr.



Covered by permit # 44510 & Certificate # 68426. 24.8 acres & 0.31 cfs for Stonecpher Ranch Property or 2.5 ac. ft/acre/yr.

Total for Stonecpher Ranch

- o 1.21 cfs or 544 gpm
- o Limit of 2.5 ac. ft/acre/yr or 30" / yr.

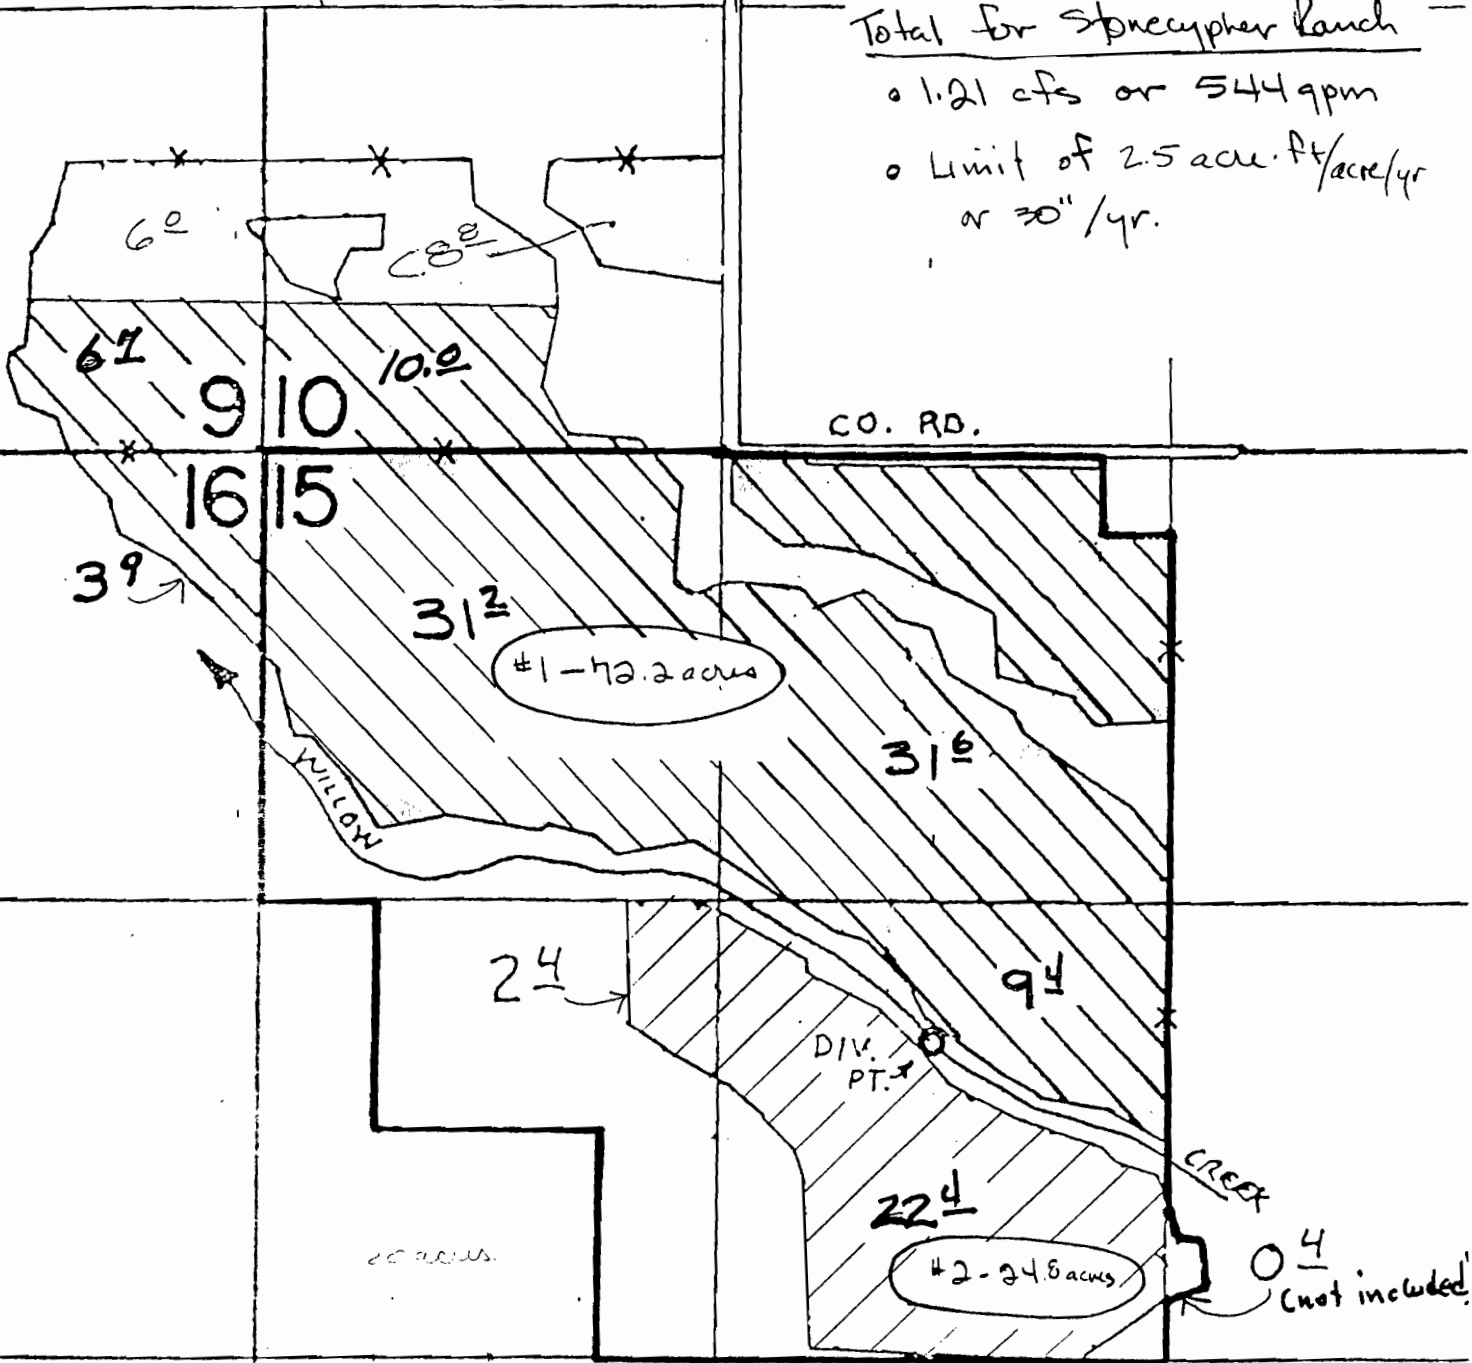

RECEIVED

JUL 18 2010

WATER RESOURCES DEPT
SALEM, OREGON