


T6S, R8W, WM

POLK COUNTY

RECEIVED

FEB 07 2011

WATER RESOURCES DEPT
SALEM, OREGON

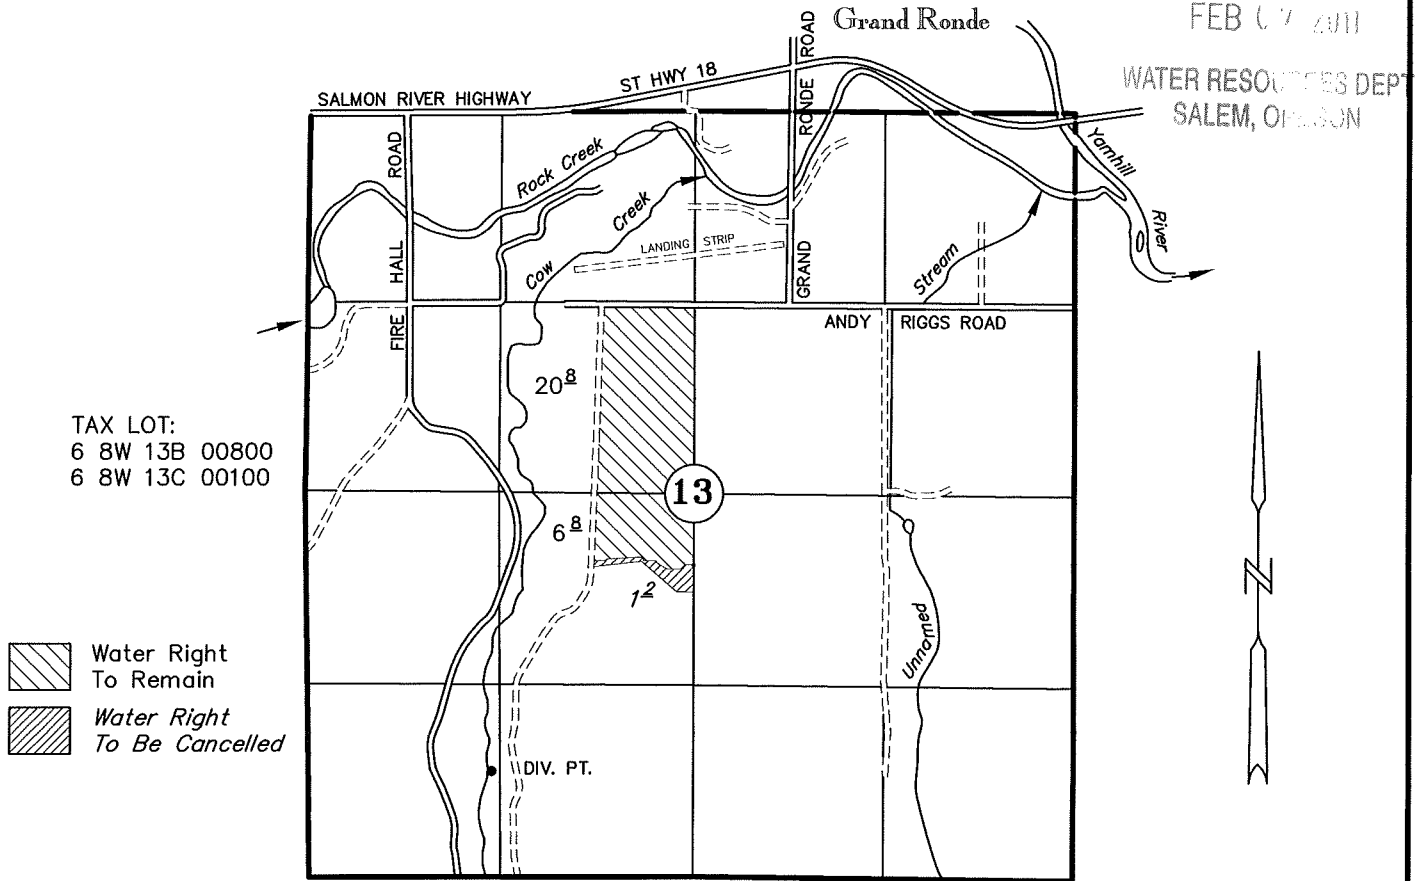

TAX LOT:
6 8W 13B 00800
6 8W 13C 00100

- Water Right To Remain
- Water Right To Be Cancelled

AUTHORIZED DIV PT: SW 1/4, SW 1/4. SECTION 13

Partial Cancellation of a Water Right Certificate

UNDER


Application No. 15498 Permit No. 11382 Certificate No. 15685

IN THE NAME OF

Grand Ronde Community Water Association

July 13, 2010

SCALE: 1" = 1320'

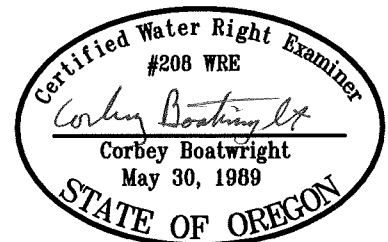

NOTE: This map is not intended to provide legal dimensions or locations of property ownership lines.

RENEWAL DATE 12-31-2011