

STATE ENGINEER  
Salem, Oregon

3063  
MARI.....


# Well Record

STATE WELL NO. 6/1W-7H (1)  
COUNTY Marlon  
APPLICATION NO. GR-638  
Also Appl. 4-7928

OWNER: J. N. Adams  
MAILING ADDRESS: Rt. 1, Box 929

LOCATION OF WELL: Owner's No. #1  
CITY AND STATE: Brooks, Oregon

SE 1/4 NE 1/4 Sec. 7 T. 6 N. S. R. 1 W., W.M.  
Bearing and distance from section or subdivision  
corner 1500 Feet S. & 1000 Feet W. from NE  
Cor. Sec. 7

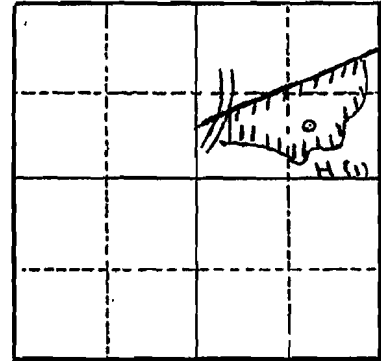

Altitude at well 155' Interpolated

TYPE OF WELL: Drilled Date Constructed April 1948

Depth drilled 137' Depth cased 137'

Section 7

### CASING RECORD:

8 inch

RECEIVED  
APR 11 2007  
WATER RESOURCES DEPT  
SALEM, OREGON

### FINISH:

### AQUIFERS:

### WATER LEVEL:

40'

PUMPING EQUIPMENT: Type Turbine Berkeley H.P. 7 1/2  
Capacity 300 G.P.M.

### WELL TESTS:

Drawdown ft. after hours G.P.M.  
Drawdown ft. after hours G.P.M.

USE OF WATER Irrigation 37 acres Temp. °F. 19

SOURCE OF INFORMATION GR-638

DRILLER or DIGGER Harder Bros., McMinnville, Oregon

### ADDITIONAL DATA:

Log Water Level Measurements Chemical Analysis Aquifer Test

### REMARKS:

RECEIVED

APR 05 2013

WATER RESOURCES DEPT  
SALEM, OREGON