


Sidney 1991 permit Certification

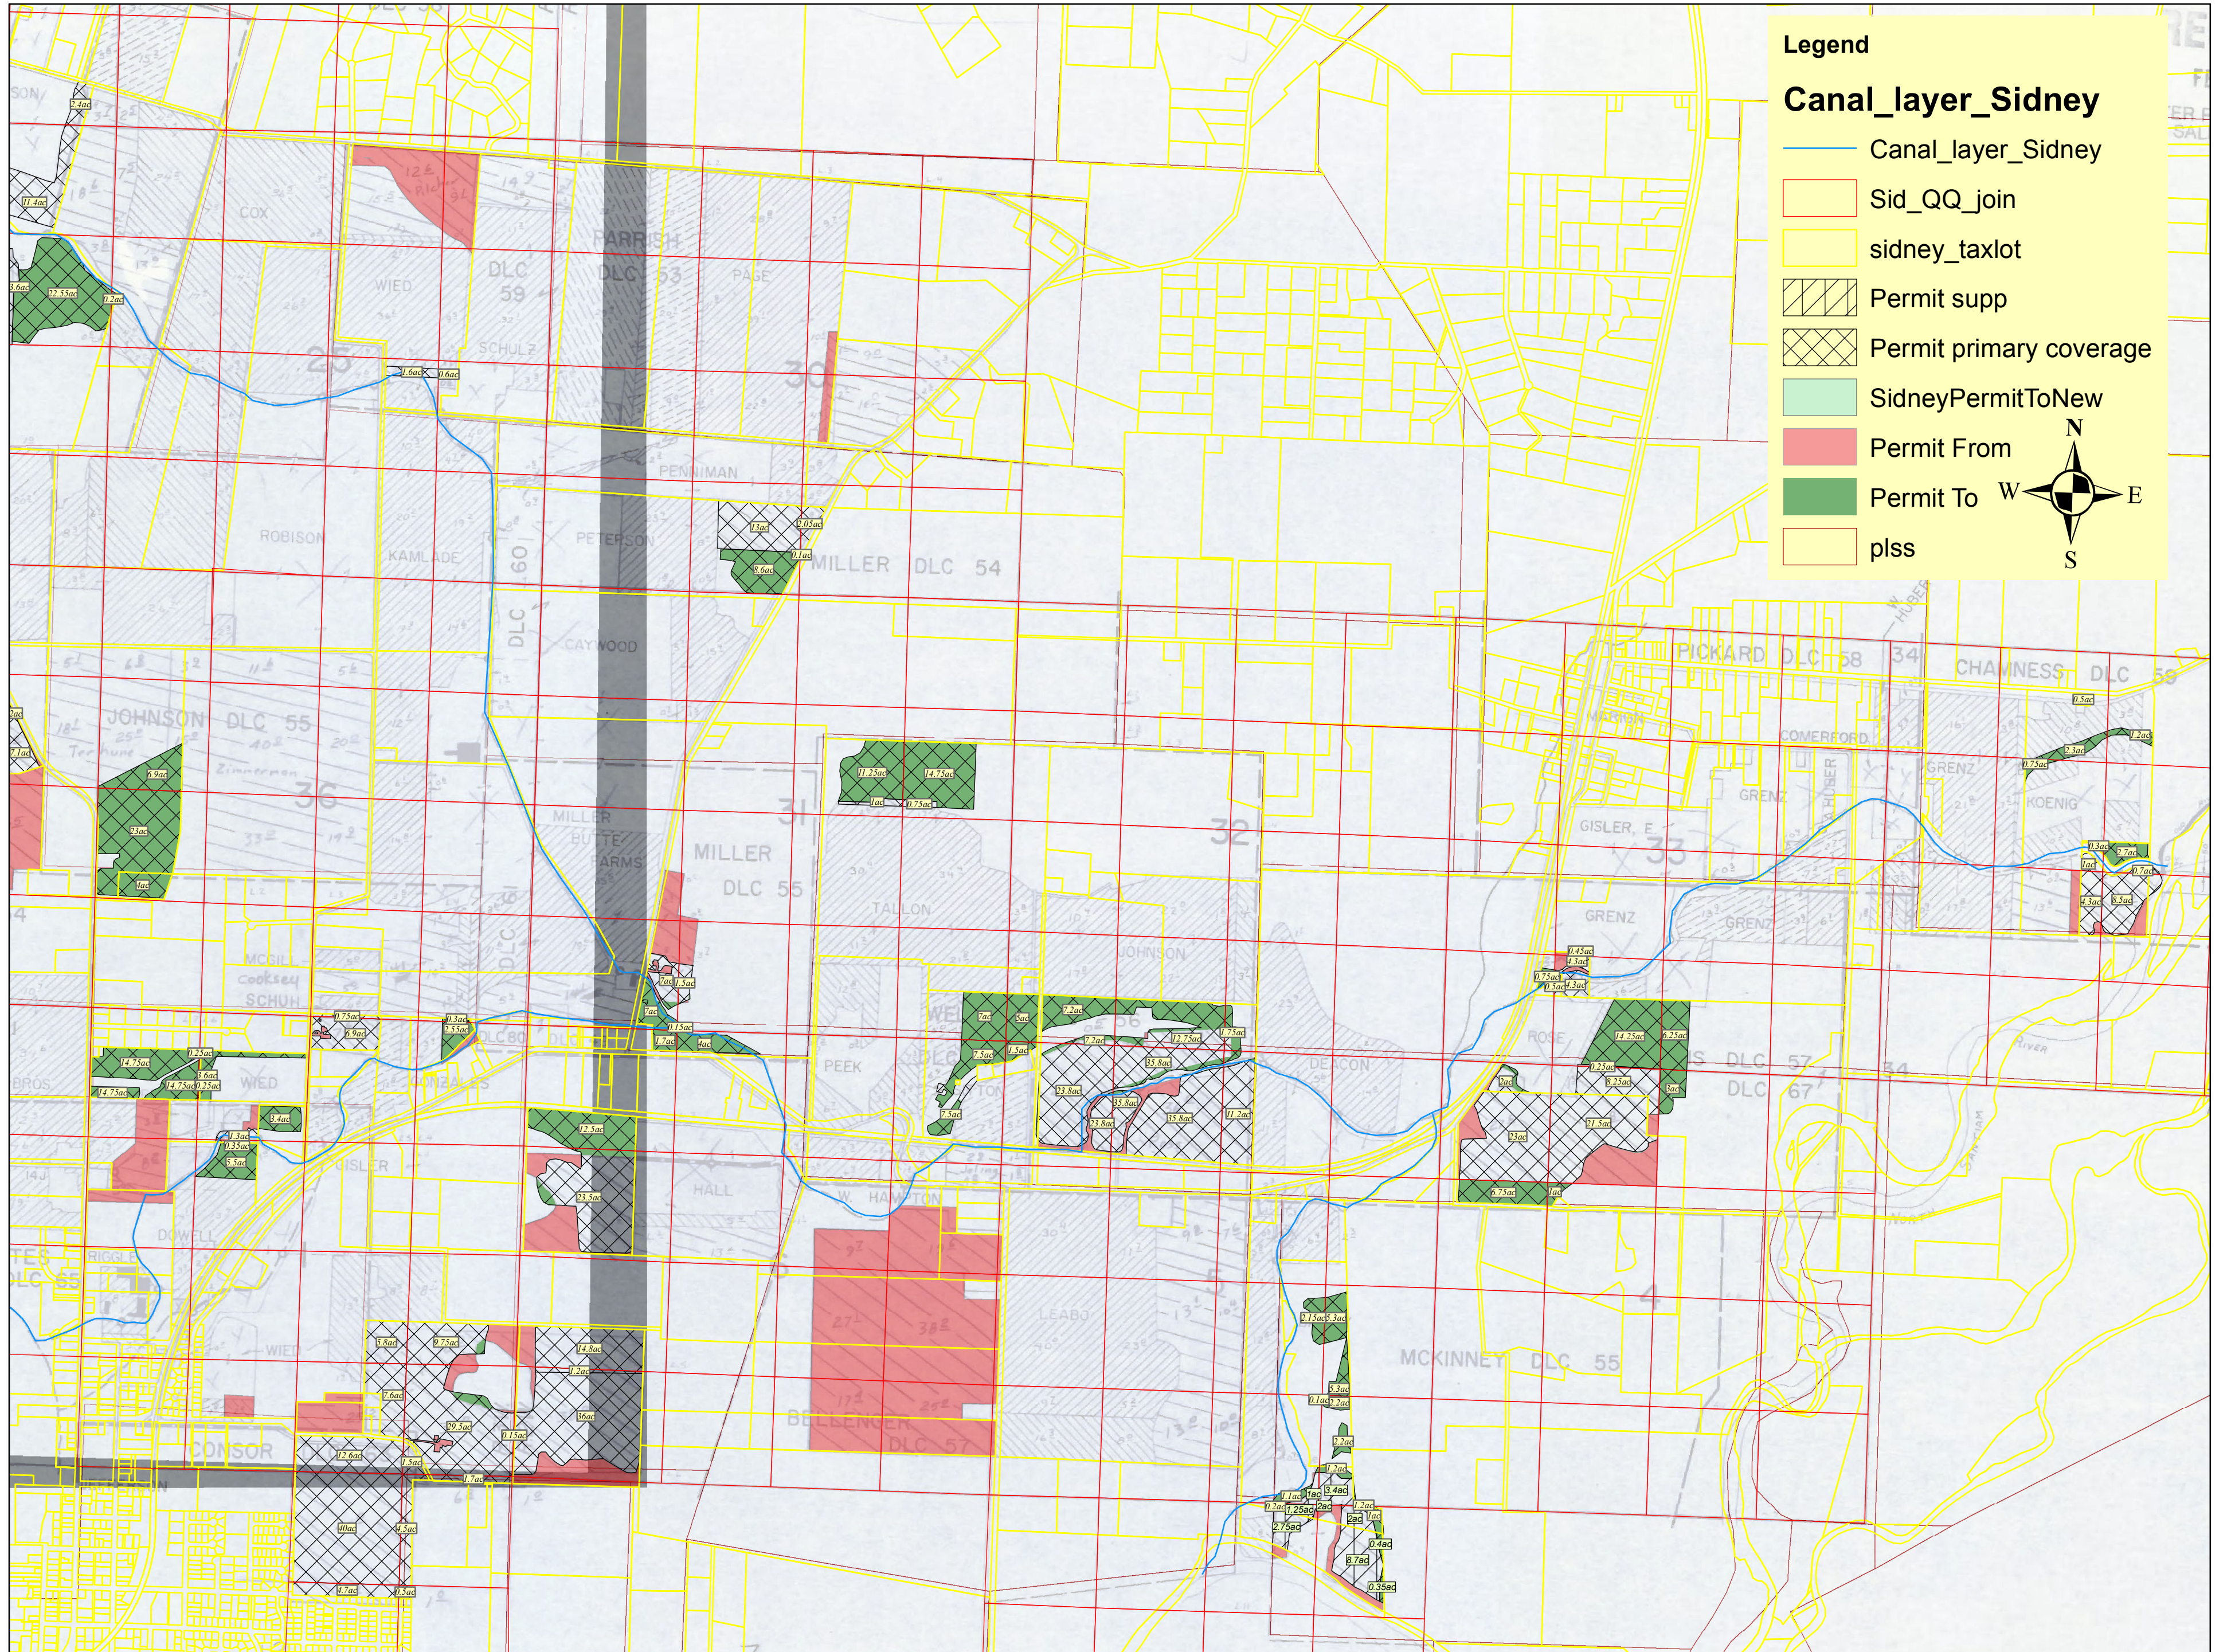

Legend

Canal_layer_Sidney

- Canal_layer_Sidney
- Sid_QQ_join
- sidney_taxlot
- Permit supp
- Permit primary coverage
- SidneyPermitToNew
- Permit From
- Permit To
- plss

