

LINN 60537

STATE OF OREGON
 WATER SUPPLY WELL REPORT
 (as required by ORS 537.765 & OAR 690-205-0210)

Revised

WELL LABEL # L 110124
 START CARD # 102045

(1) LAND OWNER Owner Well I.D. 5357
 First Name Thomas Last Name Avinelje
 Company Quiet Meadows Farm
 Address 38615 Densmore Rd
 City Jefferson State OR Zip 97352

(2) TYPE OF WORK New Well Deepening Conversion
 Alteration (repair/recondition) Abandonment

(3) DRILL METHOD
 Rotary Air Rotary Mud Cyclic Auger Cable Mud
 Reverse Rotary Other

(4) PROPOSED USE Domestic Irrigation Community
 Industrial/ Commercial Livestock Dewatering
 Thermal Injection Other

(5) BORE HOLE CONSTRUCTION Special Standard (Attach copy)
 Depth of Completed Well 59 ft.

BORE HOLE

Dia	From	To	Material	From	To	Am't	sacks/ lbs
16	1	59	Benonite	0	18	42	S

How was seal placed Method A B C D E

Other Poured dry

Backfill placed from 18 ft to 32 ft Material washed rock

Filter pack from 18 ft to 32 ft Material washed rock Size 3/4 & 1/2

Explosives used Yes Type Amount

(6) CASING/LINER

Casing/Liner	Dia	From	To	Gauge	Sil	Plstc	Wld	Thrd
<input checked="" type="checkbox"/>	12	1	59	250	<input checked="" type="checkbox"/>	<input checked="" type="checkbox"/>	<input checked="" type="checkbox"/>	<input checked="" type="checkbox"/>

Shoe Inside Outside Other Location of shoe(s)

Temp casing Yes Dia 16 From 0 To 59

(7) PERFORATIONS/SCREENS
 Perforations Method Torch cut
 Screens Type Material

Perf	Casing	Screen	Dia	From	To	Scrn/slot width	Slot length	# of slots	Tele/ pipe size
			12	32	59	438	10	325	

(8) WELL TESTS: Minimum testing time is 1 hour

Pump Bailer Air Flowing Artesian

Yield gal/min	Drawdown	Drill stem/Pump depth	Duration (hr)
600+		50	2

Temperature 53 °F Lab analysis Yes By

Water quality concerns? Yes (describe below)

From	To	Description	Amount	Units

(9) LOCATION OF WELL (legal description)
 County LINN Twp 10 S N/S Range 2 W F/W WM
 Sec 17 NW 1/4 of the SW 1/4 Tax Lot 360
 Tax Map Number Lot
 Lat or DMS or DD
 Long or DMS or DD
 Street address of well Nearest address
38615 Densmore Rd. Jefferson, OR 97352

(10) STATIC WATER LEVEL Date 09-03-2013 SWL (psi) + SWL (ft) 5
 Existing Well / Predeepening
 Completed Well
 Flowing Artesian? Dry Hole?

WATER BEARING ZONES Depth water was first found 20

SWL Date	From	To	Est Flow	SWL (psi)	+ SWL (ft)
09-03-2013	20	59	600+		5

(11) WELL LOG Ground Elevation

Material	From	To
Topsoil	0	2
Brown clay	2	15
Black sand	15	30
Sand & gravel	30	48
Gravel and sand cemented	48	54
Sand & Gravel	54	60
Naturally caved gravel pack rock from 32 + 59		

JONES DRILLING CO., INC.
 29400 SANTIAM HWY.
 LEBANON, OR 97355
 541-367-2560 541-451-2686
 1-800-915-8388

Date Started 08-30-2013 Completed 09-03-2013

(unbonded) Water Well Constructor Certification
 I certify that the work I performed on the construction, deepening, alteration, or abandonment of this well is in compliance with Oregon water supply well construction standards. Materials used and information reported above are true to the best of my knowledge and belief.

License Number 1888 Date 09-17-2013

Password: (if filing electronically)

Signed Kas Jellison

(bonded) Water Well Constructor Certification
 I accept responsibility for the construction, deepening, alteration, or abandonment work performed on this well during the construction dates reported above. All work performed during this time is in compliance with Oregon water supply well construction standards. This report is true to the best of my knowledge and belief.

License Number 1684 Date 09-17-2013

Password: (if filing electronically)

Signed

Contact Info (optional) Jones Drilling Co



ORIGINAL - WATER RESOURCES DEPARTMENT
 THIS REPORT MUST BE SUBMITTED TO THE WATER RESOURCES DEPARTMENT WITHIN 30 DAYS OF COMPLETION OF WORK Form Version: 0 95

MAR 07 2014

WATER RESOURCES DEPT
 SALEM, OREGON

62
917

STATE ENGINEER
Salem, Oregon

Linn
4167

Well Record


STATE WELL NO. 10/2W-17M
COUNTY Linn
APPLICATION NO. GR-917

OWNER: Frank E. Gates MAILING ADDRESS: Rt. 1, Box 415

LOCATION OF WELL: Owner's No. 1 CITY AND STATE: Albany, Oregon

NW ¼ SW ¼ Sec. 17 T. 10 N. S., R. 2 E. W., W.M.

Bearing and distance from section or subdivision corner S. 59° E. 8.5 chs. from NW cor. SW ¼ Sec. 17

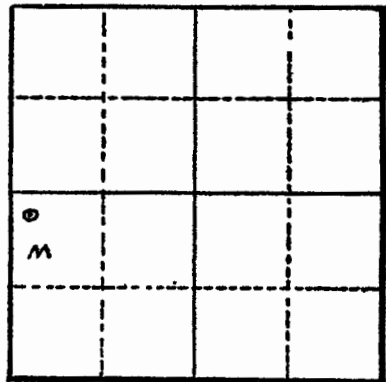

Section 17

Altitude at well 250 ft.

TYPE OF WELL: drilled Date Constructed Jan. 1947

Depth drilled 26 ft. Depth cased 26 ft.

CASING RECORD: 8 in. steel 0 to 26 ft.

FINISH: Slot perforations 14 to 26 ft.

AQUIFERS:

WATER LEVEL: 3 ft.

PUMPING EQUIPMENT: Type 3" centrifugal H.P. 20 elec.
Capacity 400 G.P.M.

WELL TESTS:
Drawdown 4 ft. after _____ hours 650 G.P.M.
Drawdown _____ ft. after _____ hours _____ G.P.M.

USE OF WATER irrigation Temp. _____ °F., 19 _____

SOURCE OF INFORMATION owner

DRILLER or DIGGER Marion West; Salem, Oregon

ADDITIONAL DATA:
Log _____ Water Level Measurements _____ Chemical Analysis _____ Aquifer Test _____

REMARKS:

RECEIVED

MAR 07 2014

WATER RESOURCES DEPT
SALEM, OREGON

#3

RECEIVED
MAR 23 1962

Linn
4165

10/2W-17D

File Original and First Copy with the STATE ENGINEER, SALEM, OREGON

STATE ENGINEER WATER WELL REPORT
STATE OF OREGON

State Well No. _____
State Permit No. _____

(1) OWNER:
Name Jessa Watkins
Address Jefferson One

(2) LOCATION OF WELL:
County Lincoln Owner's number, if any #3
N.W. ¼ N.W. ¼ Section 10 T. 10S R. 2W W.M.
Bearing and distance from section or subdivision corner
S. 58° 30' E. 13.5 CHAINS FROM THE NW CORNER OF S. 17, T. 10S, R. 2W.

(3) TYPE OF WORK (check):
New Well Deepening Reconditioning Abandon
If abandonment, describe material and procedure in Item 11.

(4) PROPOSED USE (check):
Domestic Industrial Municipal
Irrigation Test Well Other
(5) TYPE OF WELL:
Rotary Driven
Cable Jetted
Dug Bored

(6) CASING INSTALLED:
10" Diam. from 1' ft. to 27' ft. Gage 2-50

(7) PERFORATIONS:
Type of perforator used shots
SIZE of perforations 3/8" in. by 8 in.
25 perforations from 21 ft. to 26 ft.

(8) SCREENS:
Well screen installed Yes No
Manufacturer's Name _____
Type _____ Model No. _____

(9) CONSTRUCTION:
Was well gravel packed? Yes No Size of gravel: _____
Gravel placed from _____ ft. to _____ ft.
Was a surface seal provided? Yes No To what depth? _____ ft.
Material used in seal—
Did any strata contain unusable water? Yes No
Type of water? river Depth of strata 20-27'
Method of sealing strata off _____

(10) WATER LEVELS:
Static level 17' ft. below land surface Date 2-30-62
Artesian pressure _____ lbs. per square inch Date _____

Log Accepted by:
[Signed] Jessa Watkins Date March 22, 1962
(Owner)

(11) WELL TESTS:
Drawdown is amount water level is lowered below static level.
Was a pump test made? Yes No If yes, by whom? Drinker
Yield: 600 gal./min. with 3 ft. drawdown after 2 hrs.

(12) WELL LOG:
Diameter of well 10 inches.
Depth drilled 27 ft. Depth of completed well 27 ft.
Formation: Describe by color, character, size of material and structure, and show thickness of aquifers and the kind and nature of the material in each stratum penetrated, with at least one entry for each change of formation.

MATERIAL	FROM	TO
Surface + Chay	Top	6'
Yellow Chay + Gravel	6'	15'
" " gravel "	15'	20'
Gravel large	20'	27'

RECEIVED

MAR 07 2014

WATER RESOURCES DEPT
SALEM, OREGON

Work started 2-12-62 Completed 2-20-62

(13) PUMP:
Manufacturer's Name _____
Type: 3 IN CENT RIFOGAL H.P. 15

Well Driller's Statement:
This well was drilled under my jurisdiction and this report is true to the best of my knowledge and belief.

NAME Acc Drilling Co.
(2-part, firm, or corporation) (Type or print)
Address 1102 ANG One 914
Driller's well number _____
[Signed] Bill Hamilton
(Well Driller)
License No. 52 Date Feb 22, 1962

4

LINN 60537

STATE OF OREGON
WATER SUPPLY WELL REPORT
(as required by ORS 537.765 & OAR 690-205-0210)

Revised

WELL LABEL # L 110124

START CARD # 1020945

(1) LAND OWNER

Owner Well I.D. 5357 # 4

First Name Thomas Last Name Avinely
Company Quiet Meadows Farm
Address 38615 Densmore Rd.
City Jefferson State OR Zip 97352

(2) TYPE OF WORK

New Well Deepening Conversion
 Alteration (repair/recondition) Abandonment

(3) DRILL METHOD

Rotary Air Rotary Mud Cable Auger Cable Mud
 Reverse Rotary Other

(4) PROPOSED USE

Domestic Irrigation Community
 Industrial/ Commercial Livestock Dewatering
 Thermal Injection Other

(5) BORE HOLE CONSTRUCTION

Depth of Completed Well 59 ft. Special Standard Attach copy

BORE HOLE			SEAL			sacks/	
Dia	From	To	Material	From	To	Amt	lbs
16	1	59	Bentonite	0	18	42	S

How was seal placed: Method A B C D E

Other Poured dry

Backfill placed from ft. to ft. Material

Filter pack from 18 ft. to 32 ft. Material washed rock Size 3/4 & 1/2

Explosives used: Yes Type Amount

(6) CASING/LINER

Casing	Liner	Dia	From	To	Gauge	Stl	Plstc	Wld	Thrd
<input checked="" type="checkbox"/>	<input checked="" type="checkbox"/>	12	1	59	250	<input checked="" type="checkbox"/>	<input checked="" type="checkbox"/>	<input checked="" type="checkbox"/>	<input checked="" type="checkbox"/>
<input type="checkbox"/>	<input type="checkbox"/>					<input type="checkbox"/>	<input type="checkbox"/>	<input type="checkbox"/>	<input type="checkbox"/>
Shoe Inside Outside Other Location of shoe(s)

Temp casing Yes Dia 16 From 0 To 59

(7) PERFORATIONS/SCREENS

Perforations Method Torch cut
Screens Type Material

Perf/S	Casing/Screen	Liner	Dia	From	To	Scrm/slot width	Slot length	# of slots	Tele/ pipe size
Perf	Casing		12	32	59	438	10	325	

(8) WELL TESTS: Minimum testing time is 1 hour

	Pump	Bailer	Air	Flowing Artesian
Yield gal/min				
Drawdown				
Drill stem/Pump depth				
Duration (hr)				
	600+		50	2

Temperature 53 °F Lab analysis Yes By

Water quality concerns? Yes (describe below)

From	To	Description	Amount	Units

(9) LOCATION OF WELL (legal description)

County LINN Twp 10 S N/S Range 2 W E/W WM
Sec 17 NW 1/4 of the SW 1/4 Tax Lot 300
Tax Map Number Lot
Lat ° ' or DMS or DD
Long ° ' or DMS or DD
 Street address of well Nearest address

38615 Densmore Rd. Jefferson, OR 97352

(10) STATIC WATER LEVEL

Existing Well / Predeepening	Date	SWL(psi)	+ SWL(ft)
Completed Well	09-03-2013		5

Flowing Artesian? Dry Hole?

WATER BEARING ZONES

SWL Date	From	To	Est Flow	SWL(psi)	+ SWL(ft)
09-03-2013	20	59	600+		5

(11) WELL LOG

Material	From	To
Topsoil	0	2
Brown clay	2	15
Black sand	15	30
Sand & gravel	30	48
Gravel and sand cemented	48	54
Sand & Gravel	54	68
Naturally caved gravel pack rock from 32 + 59		

Ground Elevation

RECORDED
MAR 07 2014
WATER RESOURCES DEPT. SALEM, OREGON BY DWRI
JONES DRILLING CO., INC.
29400 SANTIAM HWY.
LEBANON, OR 97355
541-367-2560 541-451-2686
1-800-915-8388
SEP 18 2013
SALEM, OR

Date Started 08-30-2013 Completed 09-03-2013

(unbonded) Water Well Constructor Certification

I certify that the work I performed on the construction, deepening, alteration, or abandonment of this well is in compliance with Oregon water supply well construction standards. Materials used and information reported above are true to the best of my knowledge and belief.

License Number 1888 Date 09-17-2013

Password: (if filing electronically)
Signed Kas Hellett

(bonded) Water Well Constructor Certification

I accept responsibility for the construction, deepening, alteration, or abandonment work performed on this well during the construction dates reported above. All work performed during this time is in compliance with Oregon water supply well construction standards. This report is true to the best of my knowledge and belief.

License Number 1684 Date 09-17-2013

Password: (if filing electronically)
Signed
Contact Info (optional) jonesdrilling@hotmail.com