


T.29S. R.4W. W.M.

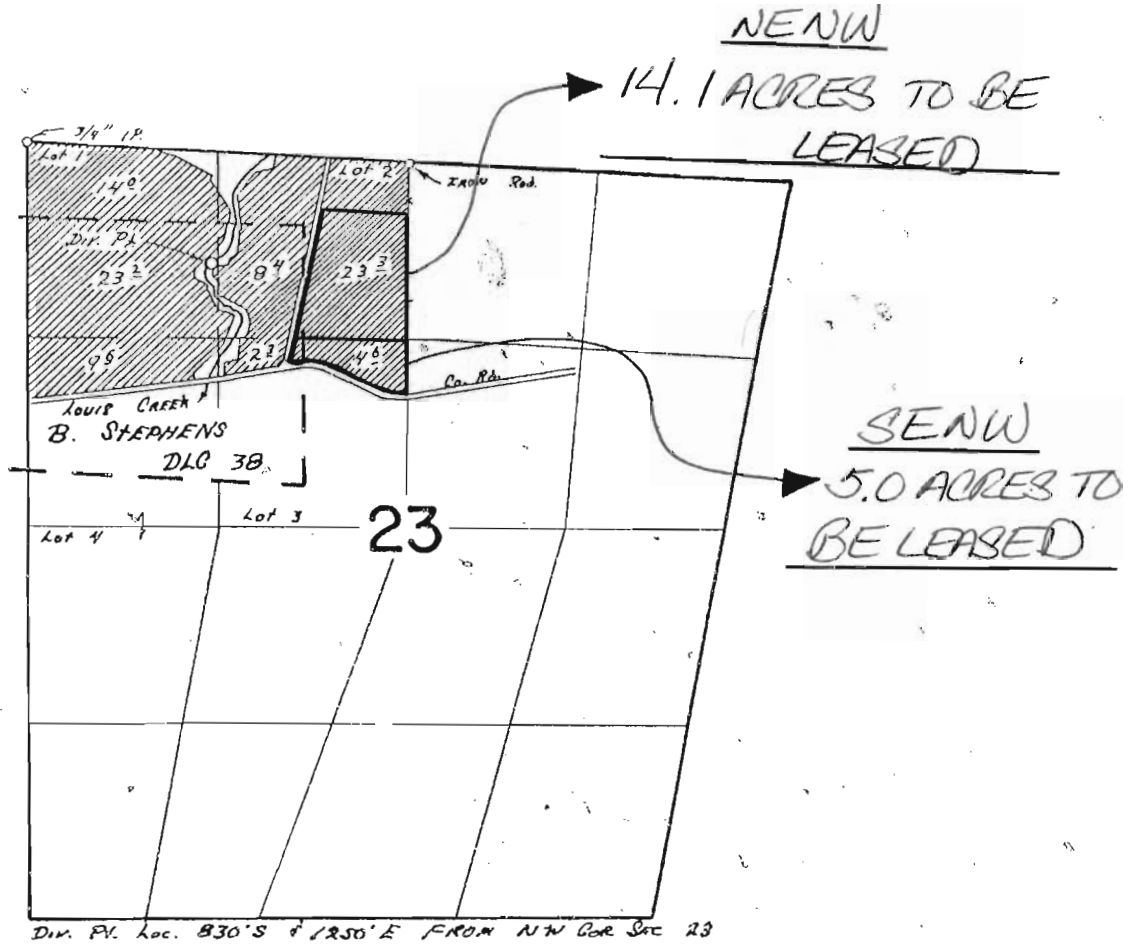

FINAL PROOF SURVEY
UNDER

TRANSFER No. M-123
Application No. _____ Permit No. 6647
IN NAME OF

MRS. F. A. MOAN

Surveyed Oct. 14, 1966, by V. BARNER

THIS MAP WAS PREPARED FOR
ASSESSMENT PURPOSE ONLY

SEC. 23 T.29S. R.4 W. W.M.
DOUGLAS COUNTY

1"=400'

REVISED ON
7-23-93

29 4 23



SEE MAP 29 4 26

4,217,000
29 4 23