


# TUMALO IRRIGATION DISTRICT IN-STREAM LEASED WATER RIGHTS SURVEY FOR Bend Metro Parks

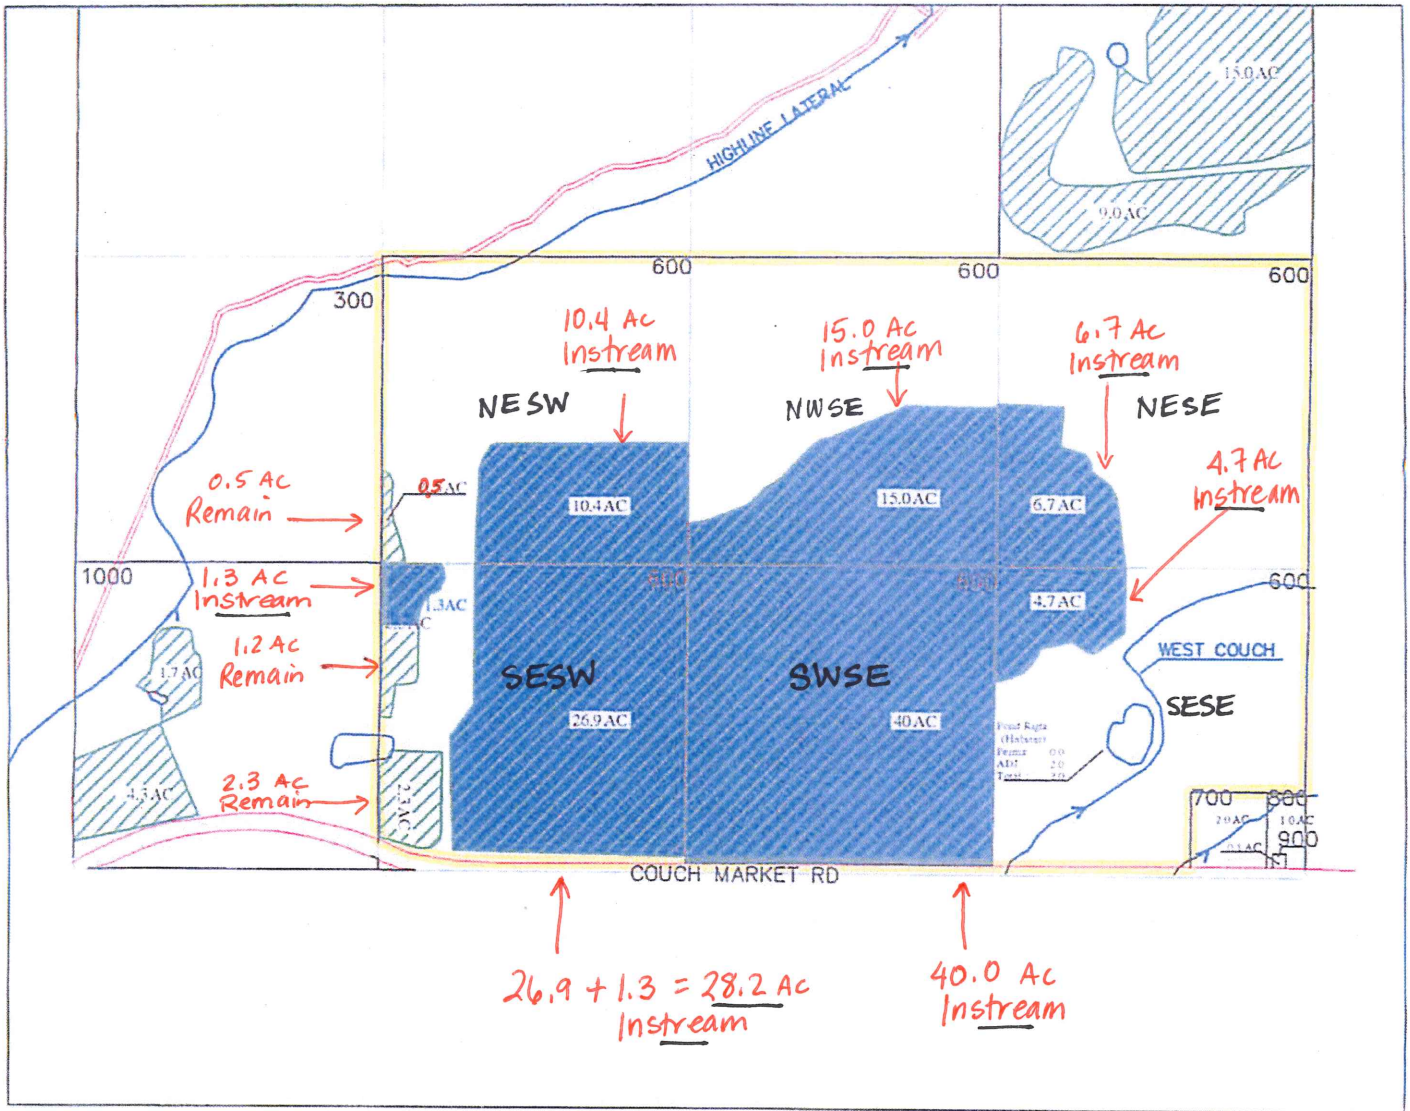

- Certificate #s  
74146, and 74147
- Certificate #  
76106
- JP-1997
- JP-1998
- In-Stream Lease

INITIAL:

LOCATED IN THE SOUTH 1/2  
OF SECTION 21, T. 16S., R. 11E., W.M.  
TAX LOTS # 600  
DESCHUTES COUNTY, OREGON



SCALE: 1" = 400'

Prepared By: Tumalo Irrigation District, 64697 Cook Ave, Bend, Oregon 97701 541-382-3053

D:\CAD\_Held\Drawings and Maps\_Drawings\Water Rights\161121\161121.dwg, 2/13/2009 2:29:30 PM