


Township 6N Range 35E, W.M.

North

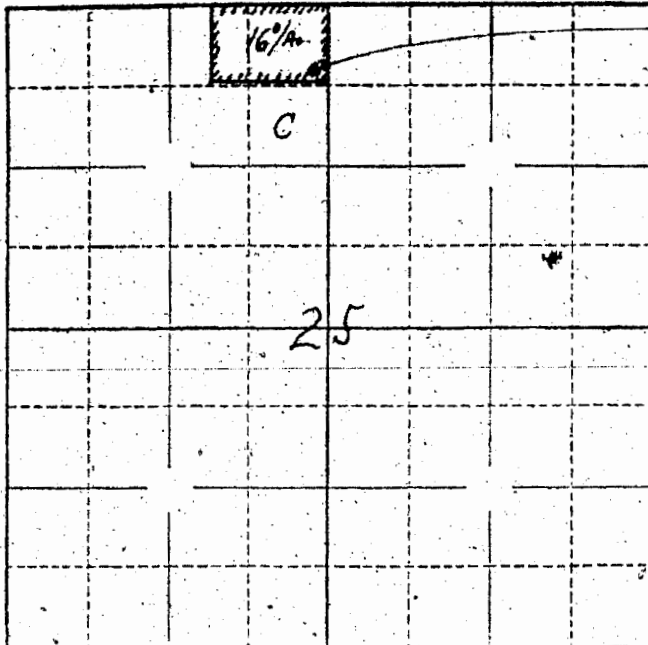

Well Location
100 feet West +
624 feet South of
N⁴ Corner of Sec 25

RECEIVED

MAY 20 2014

WATER RESOURCES DEPT
SALEM, OREGON

Locate well and acreage of irrigated land on plat.

Scale: $\frac{1}{4}$ " = 1 Mile

STATE OF OREGON

County of Umatilla } ss.

I, Paul A. Williams, being first duly sworn, do hereby certify that I have read the foregoing Registration Statement and that all of the items therein contained are true to the best of my knowledge and belief:

x Paul A. Williams
(Signature of Registrant)

Subscribed and sworn to before me this 31 day of July, 1958

My commission expires September 1959
(Notary Public)

(SEAL)

CERTIFICATE OF REGISTRATION

STATE OF OREGON

County of Marion } ss.

This is to certify that the foregoing Registration Statement was received in the office of the State Engineer on the 1st day of August, 1958, at 1:00 o'clock P. M. and has been duly recorded in said office in Book No. 15 of Registration Statements on page GR 3503

Witness my hand this 15th day of September, 1959

Russ A. Stanley
(State Engineer)

By _____ (Deputy)

\$15.00

GR 3503

WATER WELL REPORT
STATE OF OREGON

UMAT
4469

RECEIVED
SEP 15 1982
WATER RESOURCES DEPT.
SALEM, OREGON

State Well No. 6W/35E24cd
State Permit No. _____

(1) OWNER:
Name Mr Fredi Kaup
Address Rt # 3 Box 156
City Milton Freewater, OR State 97862

(2) TYPE OF WORK (check):
New Well Deepening Reconditioning Abandon
If abandonment, describe material and procedure in Item 12.

(3) TYPE OF WELL: (4) PROPOSED USE (check):
Rotary Air Driven Domestic Industrial Municipal
Mud Dug Irrigation Test Well Other
 Bored Thermal: Withdrawal ReInjection

(5) CASING INSTALLED: Steel Plastic
Threaded Welded
6" Diam. from 1 ft. to 78 ft. Gauge 0.250

LINER INSTALLED:
" Diam. from ft. to ft. Gauge

(6) PERFORATIONS: Perforated? Yes No
Type of perforator used _____
Size of perforations in. by in.
perforations from ft. to ft.
perforations from ft. to ft.
perforations from ft. to ft.

(7) SCREENS: Well screen installed? Yes No
Manufacturer's Name _____
Type _____ Model No. _____
Diam. Slot Size Set from ft. to ft.
Diam. Slot Size Set from ft. to ft.

(8) WELL TESTS: Drawdown is amount water level is lowered below static level
Is a pump test made? Yes No If yes, by whom?
Field: gal/min. with ft. drawdown after hrs.
Air test 150 gal/min. with drill stem at 103 ft. 1 hrs.
Bailer test gal/min. with ft. drawdown after hrs.
Artesian flow _____ g.p.m.
Temperature of water 56 Depth artesian flow encountered ft.

(9) CONSTRUCTION: Special standards: Yes No
Well seal—Material used Cement
Well sealed from land surface to 19 ft.
Diameter of well bore to bottom of seal 10 in.
Diameter of well bore below seal 6 in.
Number of sacks of cement used in well seal 8 sacks
How was cement grout placed? Pumped
Was pump installed? NO Type HP Depth _____ ft.
Was a drive shoe used? Yes No Plugs _____ Size: location _____ ft.
Did any strata contain unusable water? Yes No
Type of Water? _____ depth of strata _____
Method of sealing strata off _____
Was well gravel packed? Yes No Size of gravel: _____
Gravel placed from _____ ft. to _____ ft.

(10) LOCATION OF WELL:
County Umatilla Driller's well number _____
SE 1/4 SW 1/4 Section 24 T. 6N R. 35 E.W.M.
Tax Lot # _____ Lot _____ Blk _____ Subdivision _____
Address at well location: Same

(11) WATER LEVEL: Completed well.
Depth at which water was first found 15 ft.
Static level 10 ft. below land surface, Date 8-27-82
Artesian pressure _____ lbs. per square inch, Date _____

(12) WELL LOG: Diameter of well below casing 6
Depth drilled 105 ft. Depth of completed well 103 ft.
Formation: Describe color, texture, grain size and structure of materials; and show thickness and nature of each stratum and aquifer penetrated, with at least one entry for each change of formation. Report each change in position of Static Water Level and indicate principal water-bearing strata.

MATERIAL	From	To	SWL
Soil	0	5	
Soil Gravel & Boulders	5	8	
Clay Gravel & Boulders	8	15	
Gravel & Boulders	15	17	
Gravel Med	17	23	
Cement Gravel & Boulders	23	105	10 ft

RECEIVED BY OWRD

MAY 20 2014

SALEM, OR

Work started 8-26-82 19 Completed 8-27-82 19
Date well drilling machine moved off of well 8-27-82 19

Drilling Machine Operator's Certification:
This well was constructed under my direct supervision. Materials used and information reported above are true to my best knowledge and belief.
(Signed) _____ Date _____, 19____
(Drilling Machine Operator)

Drilling Machine Operator's License No. _____

Water Well Contractor's Certification:
This well was drilled under my jurisdiction and this report is true to the best of my knowledge and belief.

Name C.A.W. Summers Well Drilling
(Person, firm or corporation) (Type or print)
Address Rt # 3 Box 143 - A D M 7 F OR 97862

(Signed) [Signature]
(Water Well Contractor)

Contractor's License No. _____ Date 9-10-82, 19____

NOTICE TO WATER WELL CONTRACTOR
The original and first copy of this report are to be filed with the

WATER RESOURCES DEPARTMENT,
SALEM, OREGON 97310
within 30 days from the date of seal completion.

SP-12658-890

STATE ENGINEER
Salem, Oregon

UMAT
4607

Well Record

STATE WELL NO. 6N/35-250
COUNTY Umatilla
APPLICATION NO. GR-3846

OWNER: Paul A. & Ray W. Williams

MAILING ADDRESS: Route 3, Box 237A

LOCATION OF WELL: Owner's No. _____

CITY AND STATE: Milton-Freswater, Oregon

NE 1/4 NW 1/4 Sec. 25 T. 6 N. R. 35 E., W.M.

Bearing and distance from section or subdivision corner 100' W. & 624' S. of N.E. Cor. Sec. 25

		X	

Altitude at well _____

Section 25

TYPE OF WELL: Drilled 40' Date Constructed 1920

Dug 40'
Depth drilled 80 feet Depth cased 58 feet

CASING RECORD:

72 inch concrete from 0 to 8 feet
8 inch steel casing from 38 to 58 feet

FINISH:

AQUIFERS:

WATER LEVEL:

15 feet below surface

PUMPING EQUIPMENT: Type centrifugal H.P. 3
Capacity 400 G.P.M.

WELL TESTS:

Drawdown _____ ft. after _____ hours _____ G.P.M.

Drawdown _____ ft. after _____ hours _____ G.P.M.

USE OF WATER Irrigation Temp. _____ °F. _____, 19____

SOURCE OF INFORMATION Well Registration Statement Cert. # GR-3503

DRILLER or DIGGER _____

ADDITIONAL DATA:

Log _____ Water Level Measurements _____ Chemical Analysis _____ Aquifer Test _____

REMARKS:

RECEIVED BY OWRD

MAY 20 2014

SALEM, OR