


Split Season Lease Map - Certificate 36610

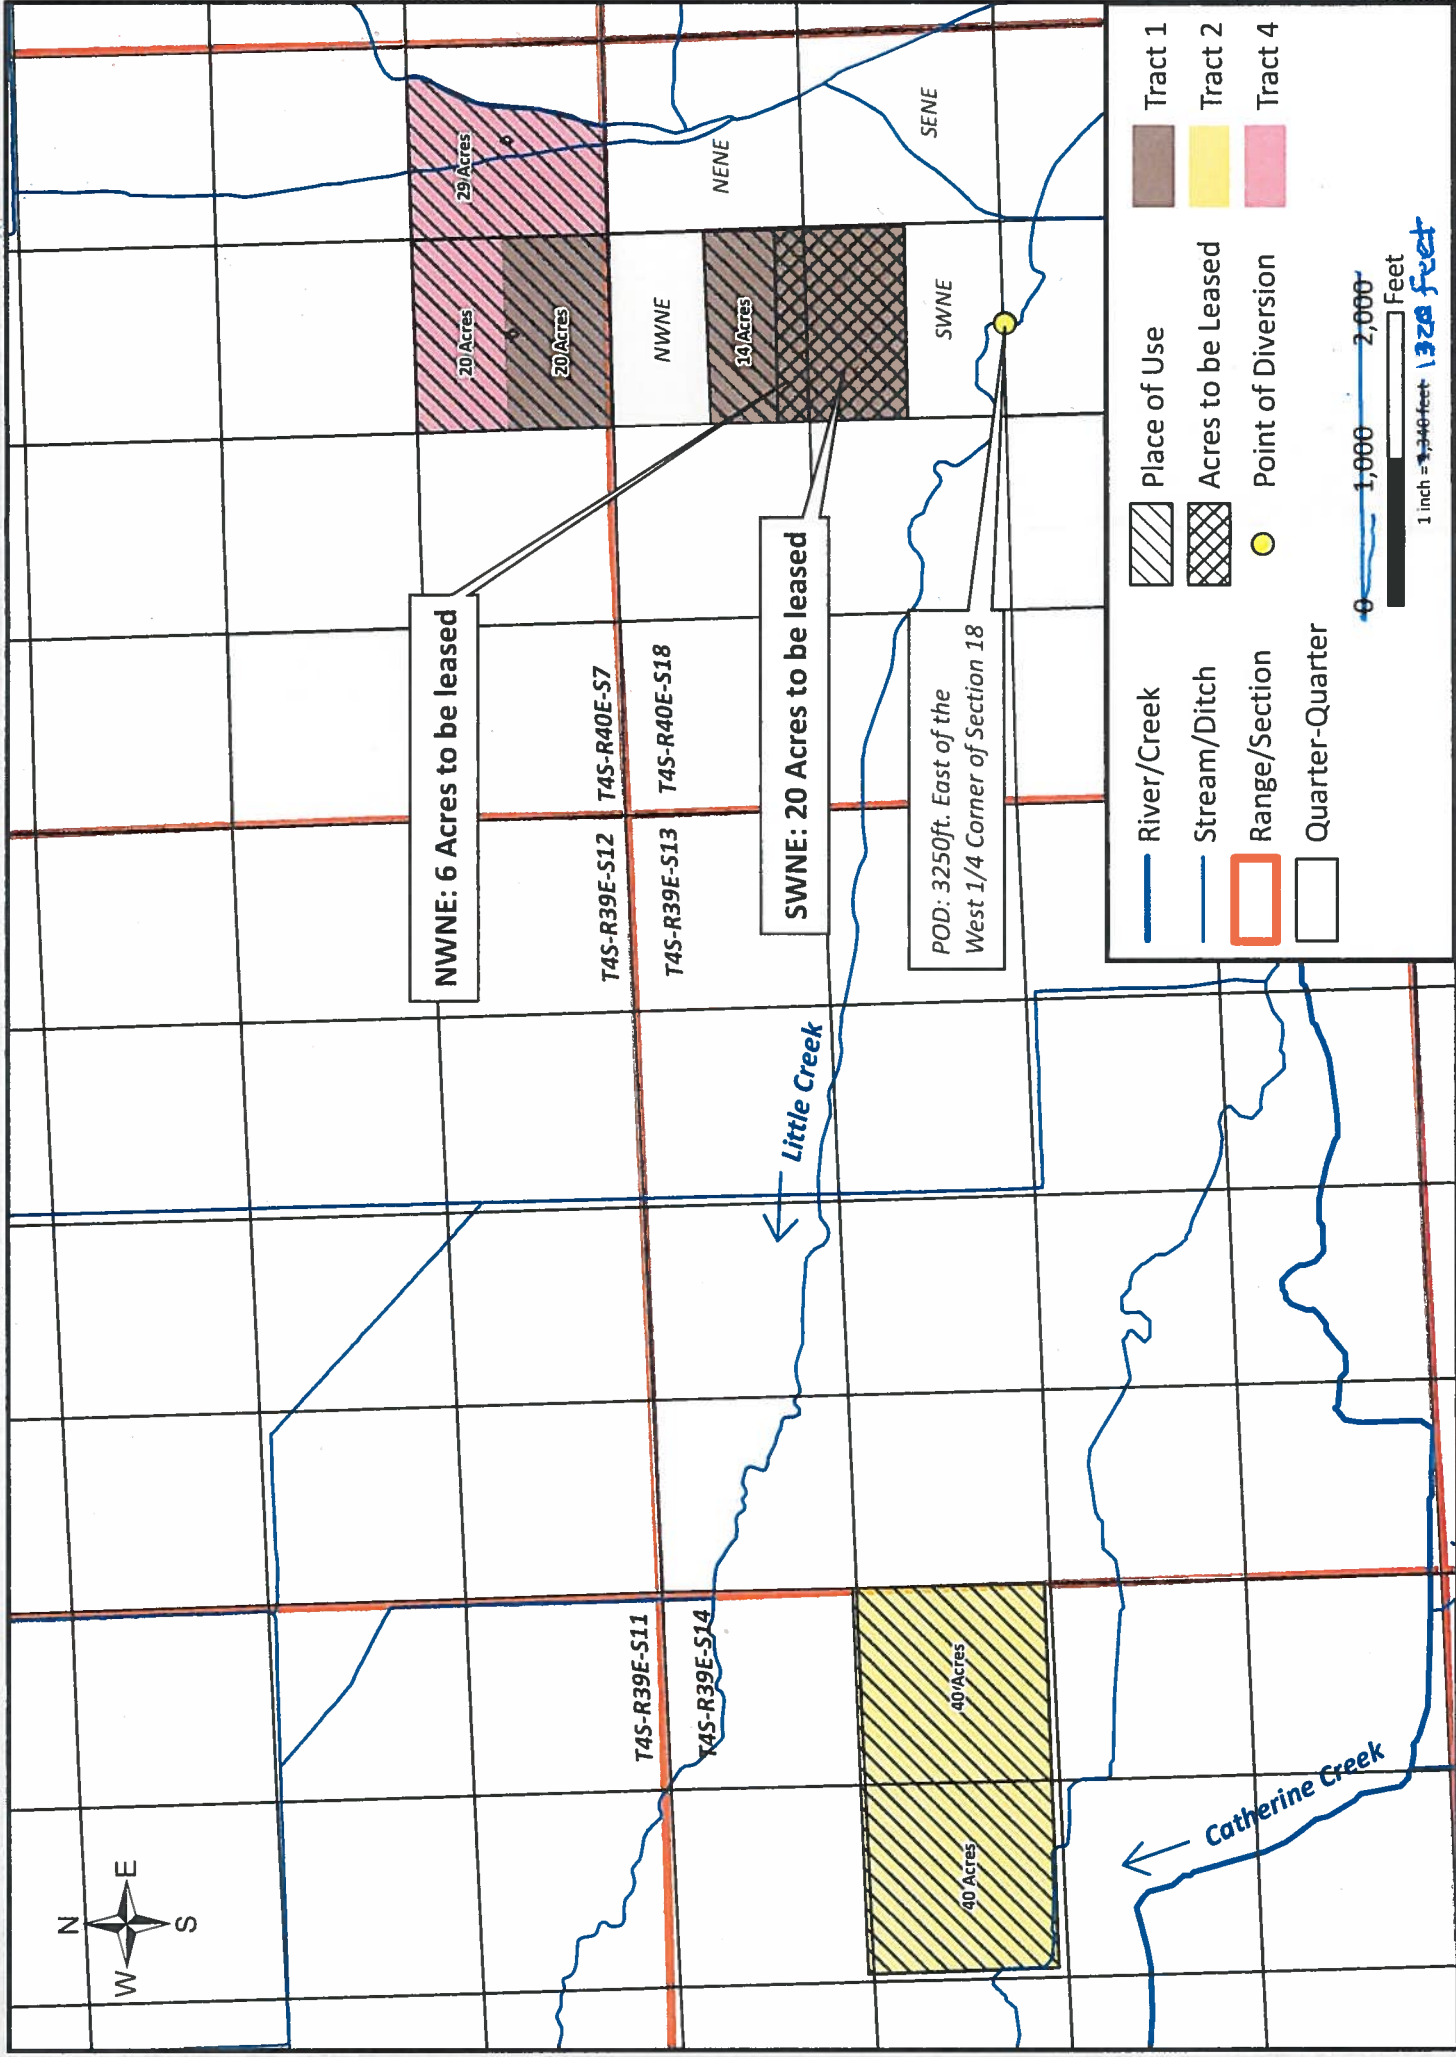

RECEIVED BY OWRD

MAY 30 2014

SALEM, OR