

RECEIVED BY OWRD

Three Sisters Irrigation District

AUG 12 2014

Legend

- Township Range
- Quarter Quarters
- Taxlots

Primary

Priority_Date


- 1889
- 1895

Wayne Cornick
 7.1 acres Instream - 1895
 Certificate 74135
 T15S R10E Sect 12
 Tax Lot 302
 NWNE 7.1 acres Instream
 3.9 acres transfered off - T8392
 Deschutes County

NWNE $\frac{1}{4}$ 4.1 ac off NENE
 T-8392

SALEM, OR



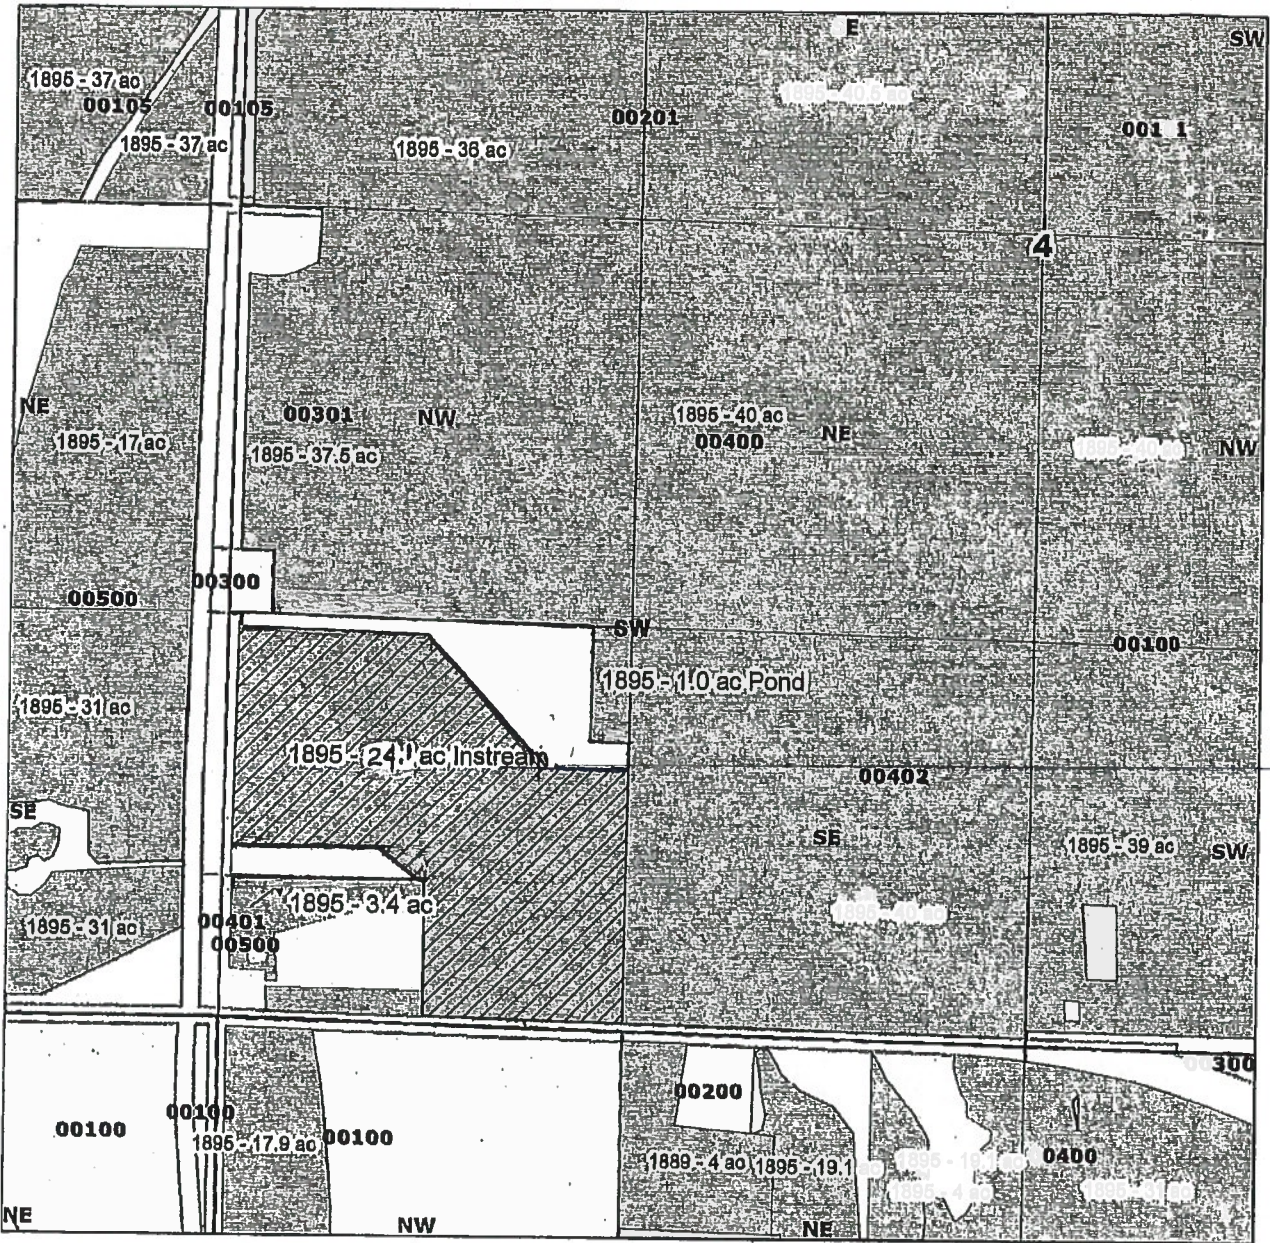

RECEIVED BY OWRD

Three Sisters Irrigation District

AUG 12 2014

SALEM, OR

Legend


- Township Range
- Quarter Quarters
- Taxlots


Primary

Priority_Date

- 1895
- 1895

James Enger
 24.1 acres Instream - 1895
 Certificate 74135
 T15S R11E Sect 04
 Tax Lot 401
 SWSW 24.1 acres Instream
 1.0 Pond remaining (Tax Lot 401)
 Deschutes County
 T-10900 removed 6.5 Ac

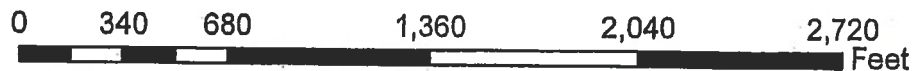

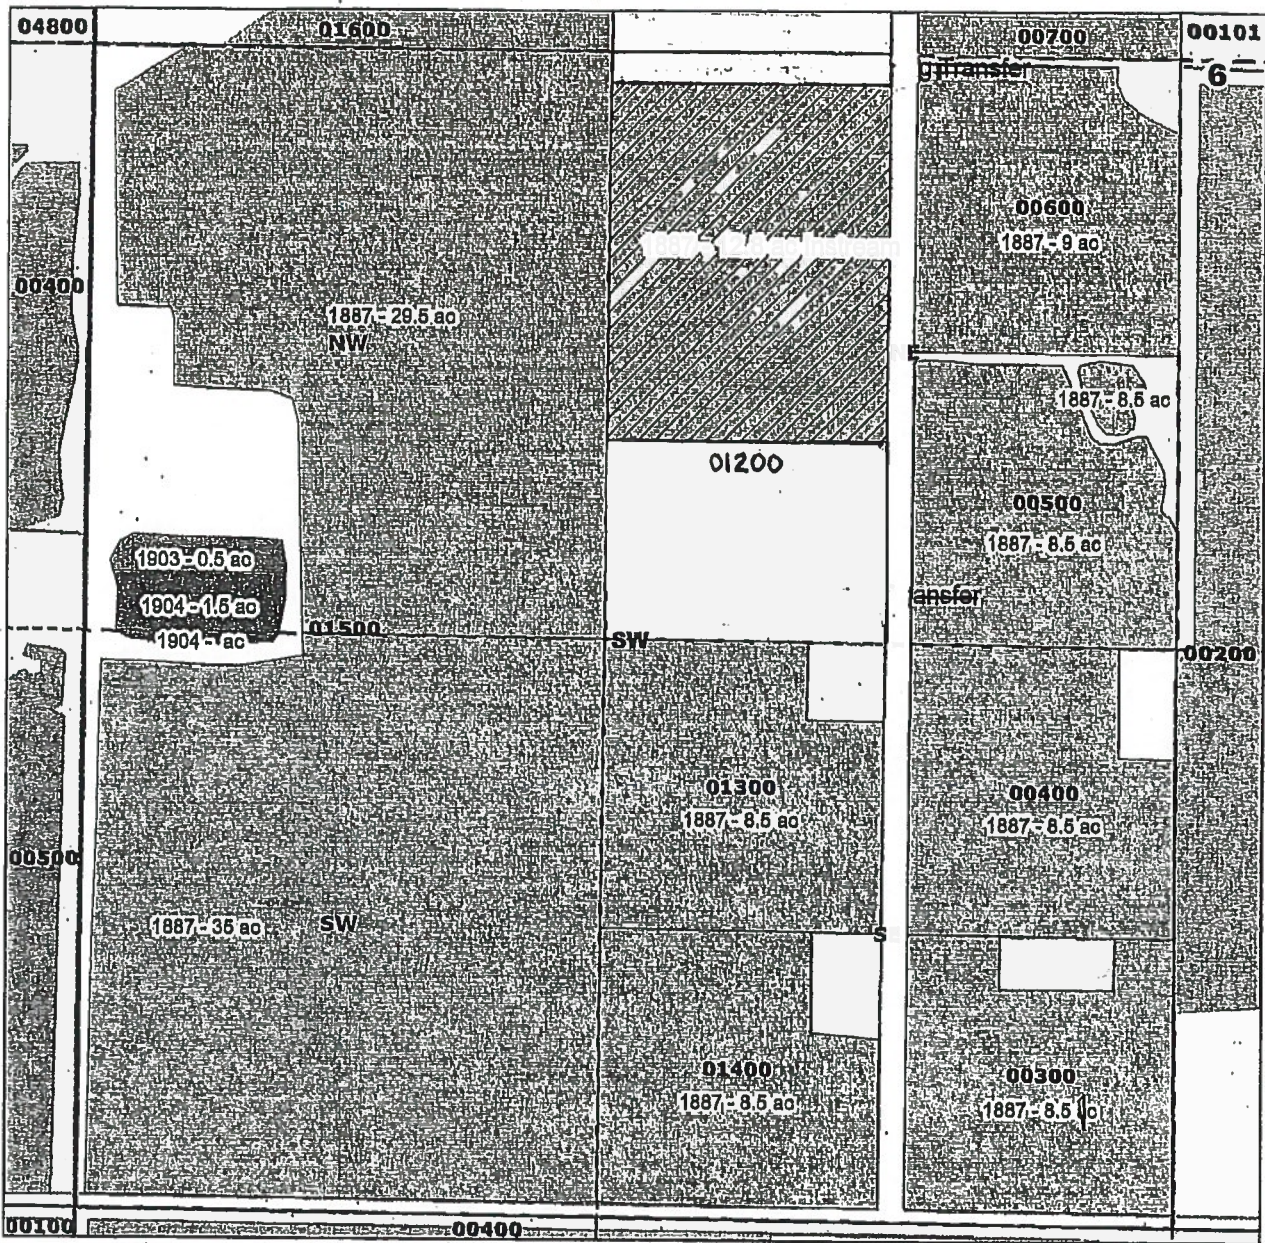

Legend

- SW Quarter Remaining
- Township Range
- Quarter Quarters
- Taxlots

Primary

Priority_Date

- 1887
- 1895
- 1903
- 1904

Three Sisters Irrigation District

RECEIVED BY OWRD

Jeffrey Fackler
 12.8 acres Instream - 1887
 Certificate 74135

AUG 12 2014

T15S R11E Sect 06
 Tax Lot 1200
 NESW

SALEM, OR

12.8 acres Instream

NESW < 4.7 ac C-74135-1887 off > T.10573
 1.0 ac C-74135-1895 off

