

1" = 400'


SEE MAP 39 7 22



1889 PRIORITY 1908 PRIORITY

SEE MAP 39 7 28

NW 1/4 SE 1/4 SEC. 22
T. 39 S. R. 7 W

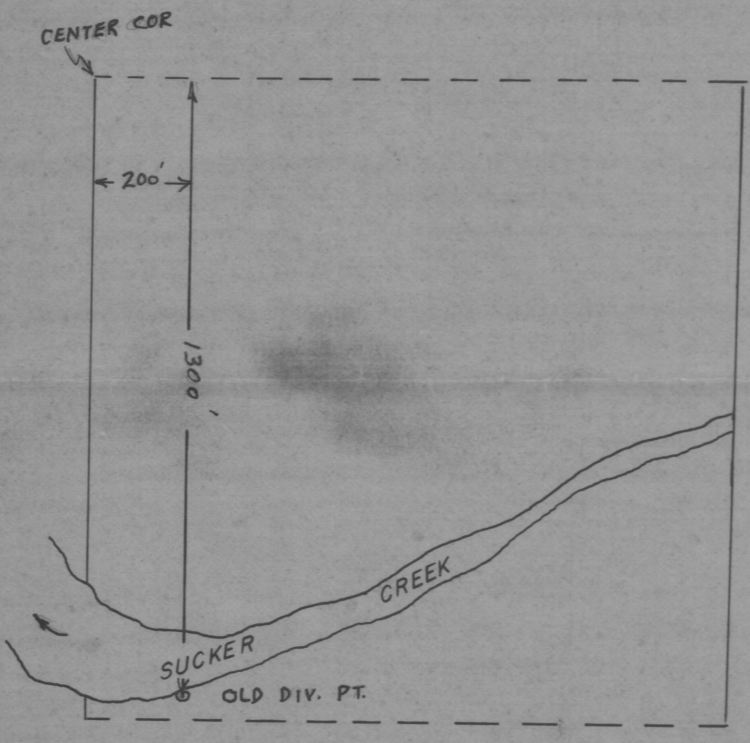

SEE MAP 39 7 34

RECEIVED
MAR 4 1980
WATER RESOURCES DEPT
SALEM, OREGON