

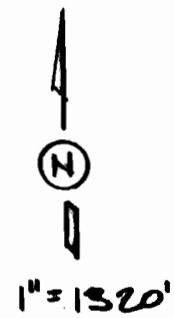


SECTION 2 & 3, T.1S., R.3W., W.M.

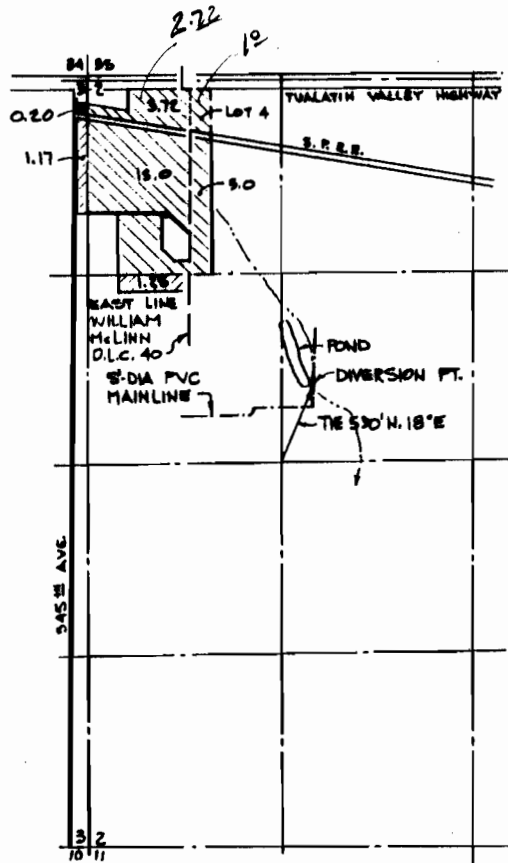

PREPARATION OF THIS MAP IS FOR THE PURPOSE OF IDENTIFYING THE LOCATION OF THE WATER RIGHT ONLY. THERE IS NO INTENT TO PROVIDE DIMENSIONS OR LOCATION OF PROPERTY OWNERSHIP LINES.

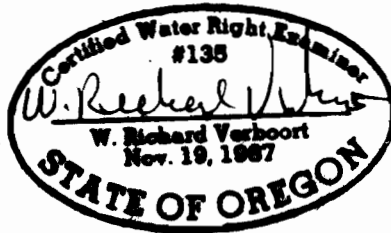

FINAL PROOF SURVEY UNDER

APPLICATION No. 69610 PERMIT No. 50740

SURVEYED JULY 3, 1991

REVISED 01.26.92

T 10265

VERBOORT ENGINEERING
 AGRICULTURE • CIVIL • WATER RESOURCES
 HILLSBORO, OREGON

by date
 designed WRV 7.7.91
 drawn JBR 7.7.91
 checked WRV 7.7.91
 drawing no. 91-A-11
 sheet no. 1/1

EDMUND DUYCK
 2020 S.W. 325 TH
 HILLSBORO, OR 97123