

STATE ENGINEER
Salem, Oregon

2881
MARI.....

Well Record

STATE WELL NO. 5/2W-36J(1)
COUNTY Marion
APPLICATION NO. GR-124

OWNER: Peter Prantl

MAILING ADDRESS:


LOCATION OF WELL: Owner's No. 1

CITY AND STATE:

Gervais, Oregon

NE 1/4 SE 1/4 Sec. 36 T. 5 N. S., R. 2 E. W., W.M.

Bearing and distance from section or subdivision corner 787' N. & 383' E. from SE cor. of NE 1/4 SE 1/4

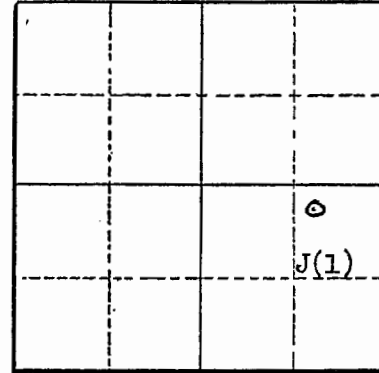

Section 36

Altitude at well 170' Interpolated

TYPE OF WELL: Drilled Date Constructed 3/1/52

Depth drilled 123 Depth cased 123

CASING RECORD:

10 inch casing set from 0 to 123 feet

FINISH:

8 perforations to the row 8" apart from 111 to 123 feet

AQUIFERS:

Sand and gravel from 111 to 123 feet

WATER LEVEL:

19 feet below land surface 4/3/52

PUMPING EQUIPMENT: Type Peerless turbine H.P. 15
Capacity 300 G.P.M.

WELL TESTS:

Drawdown 49 ft. after hours 250 G.P.M.

Drawdown 75 ft. after hours 350 G.P.M.

USE OF WATER Irrigation 63 acres Temp. °F, 19

SOURCE OF INFORMATION Registration Statement GR-124

DRILLER or DIGGER

ADDITIONAL DATA:

Log Water Level Measurements Chemical Analysis Aquifer Test

REMARKS:

RECEIVED

NOV 25 2014

WATER RESOURCES DEPT
SALEM, OREGON

STATE ENGINEER
Salem, Oregon

State Well No. 5/2W-36J(1)
County Marion
Application No. GR-124

Well Log

Owner: Peter Prantl Owner's No. 1

Driller: Roy Perkins Date Drilled 3/1/52

CHARACTER OF MATERIAL	(Feet below land surface)		Thickness (feet)
	From	To	
Top soil	0	53	53
Shale, blue gray	53	63	10
Sand and gravel, brown	63	68	5
Shale, blue	68	80	12
Shale, brown	80	102	22
Shale, blue	102	106	4
Gravel, brown, tight formation	106	111	5
Sand and gravel (water bearing)	111	112	1
Gravel, tight formation	112	113	1
Sand and gravel (water bearing)	113	123.5	10.5

RECEIVED
NOV 25 2014
WATER RESOURCES DEPT
SALEM, OREGON