


$1'' = 400'$

T-3197

SEE MAP 39 7 15

SEYFERTH DISTRICT IMPROVEMENT CO., INC.

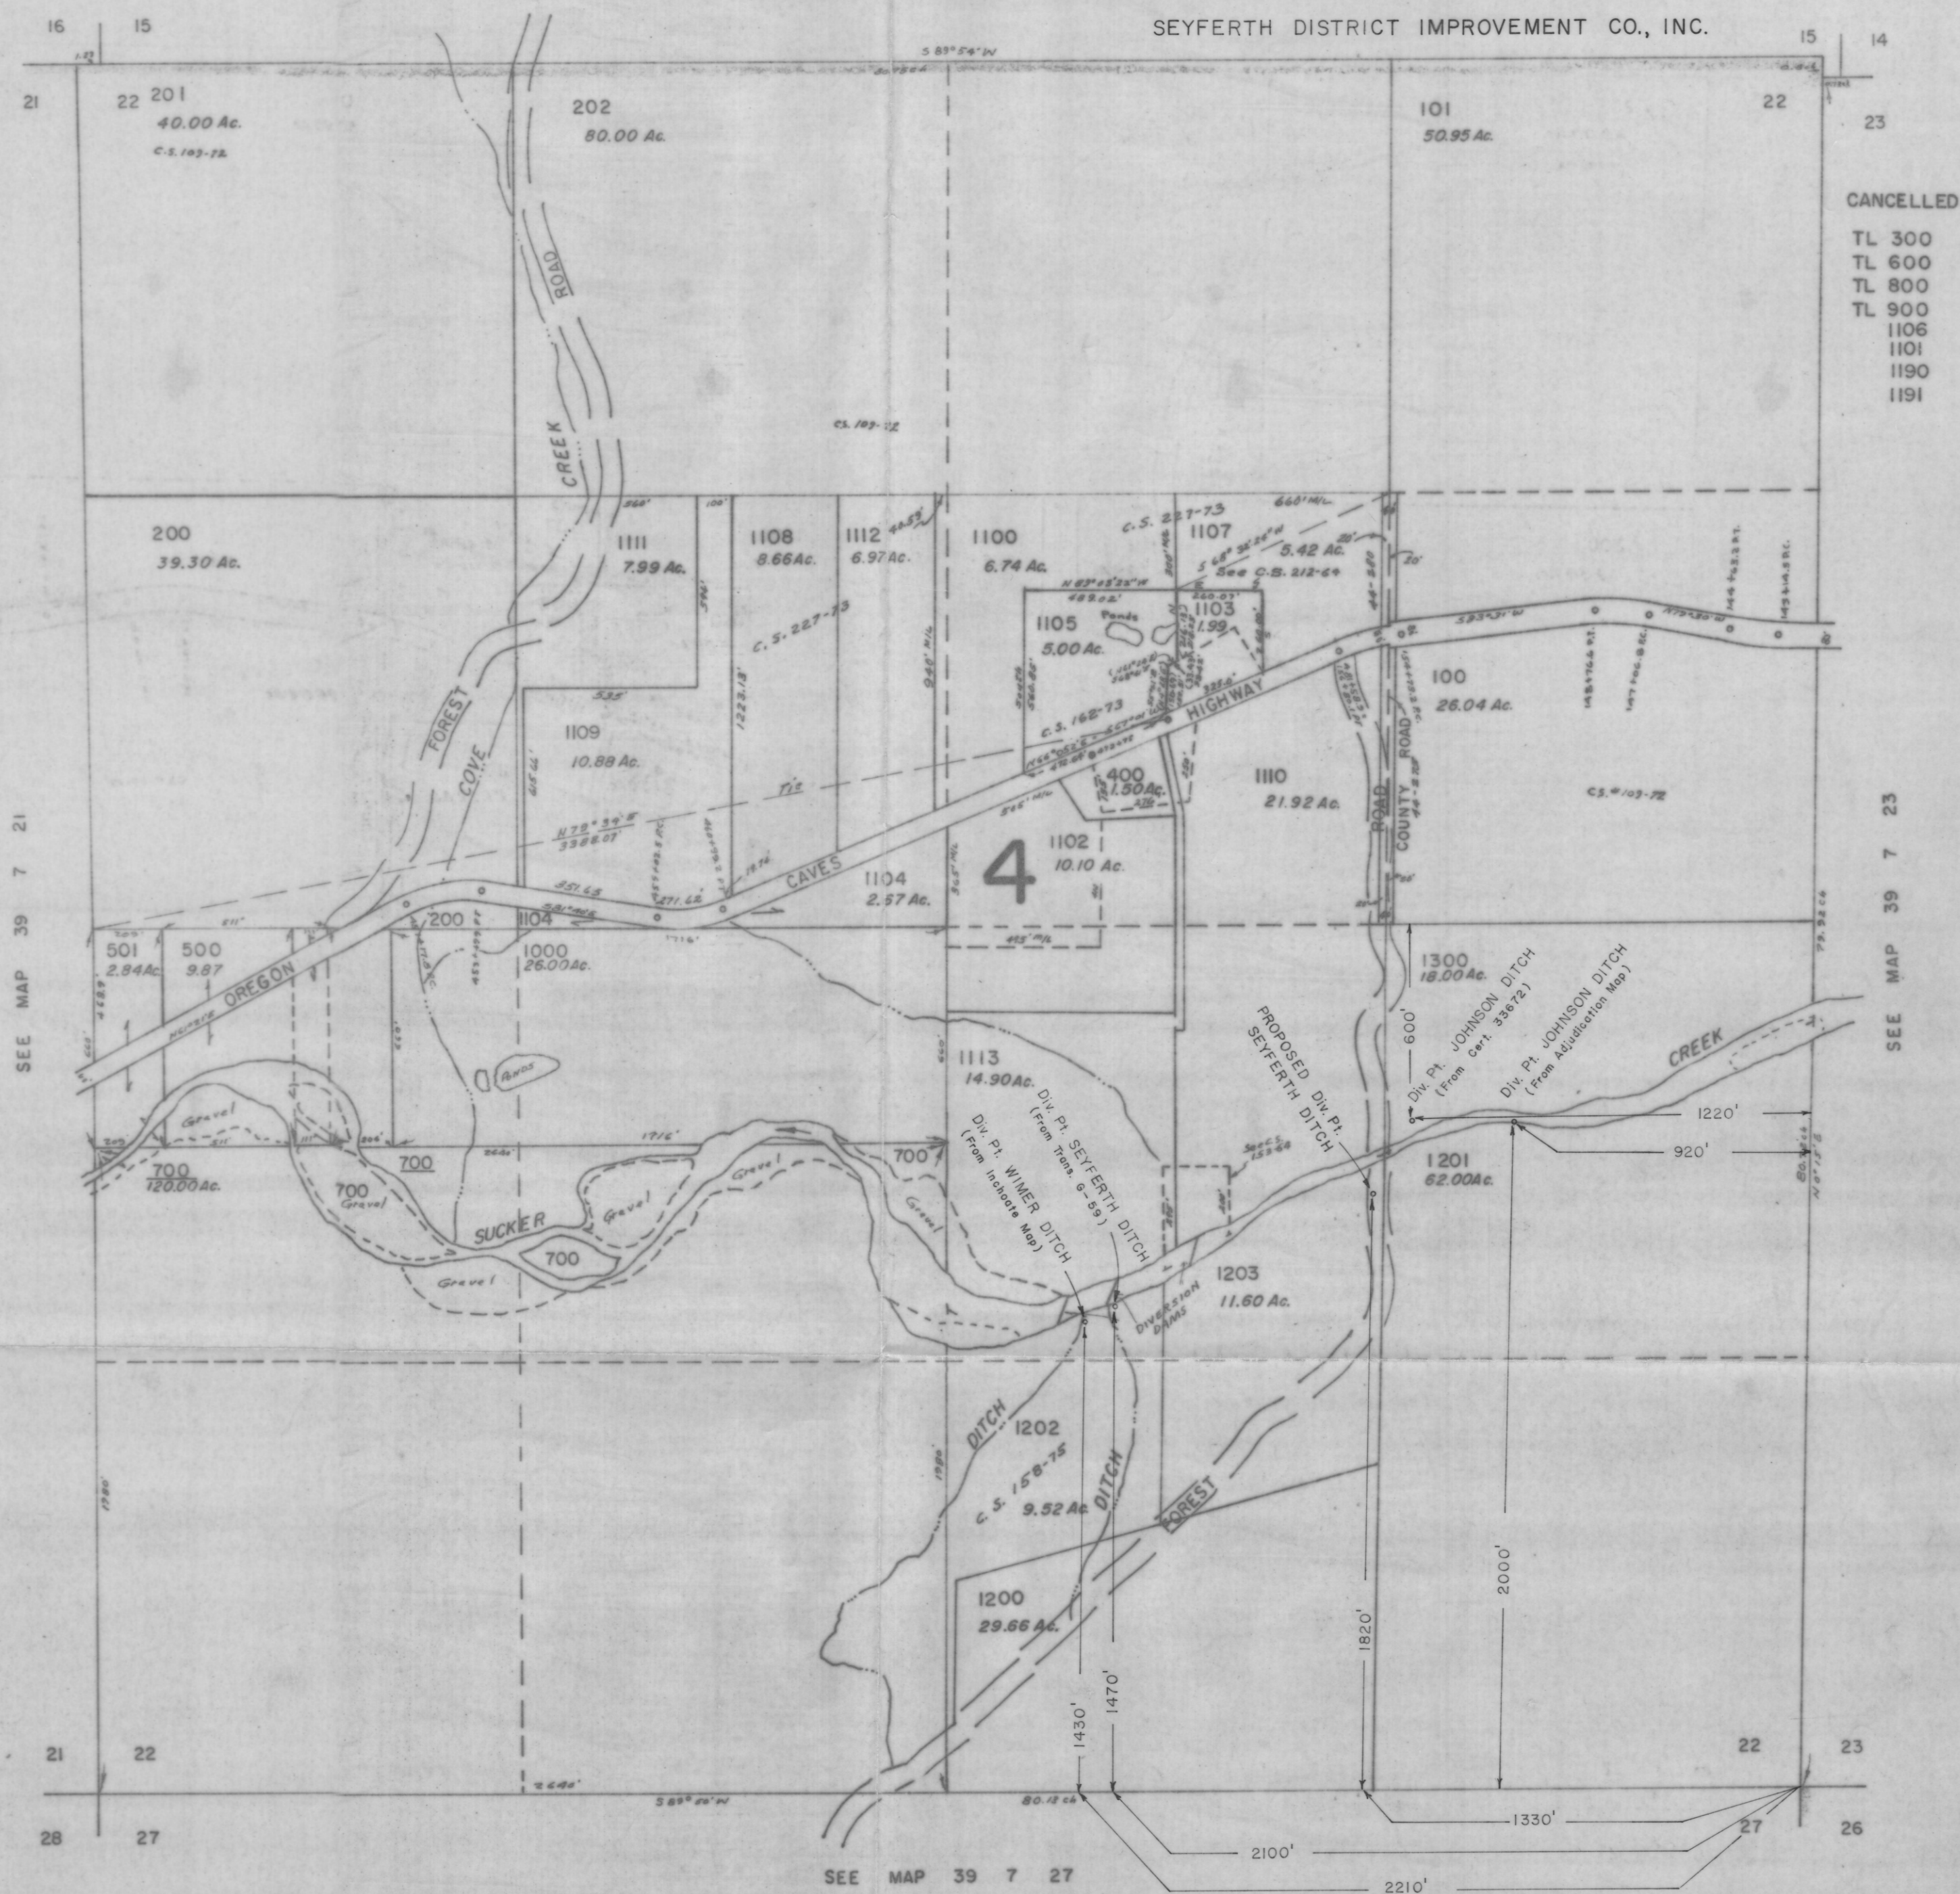

CANCELLED

TL 300
TL 600
TL 800
TL 900
1106
1101
1190
1191

SEE MAP 39 7 23


SEE MAP 39 7 27

$1'' = 400'$

T-3197

SEE MAP 39 7 21

SEYFERTH DISTRICT IMPROVEMENT CO., INC

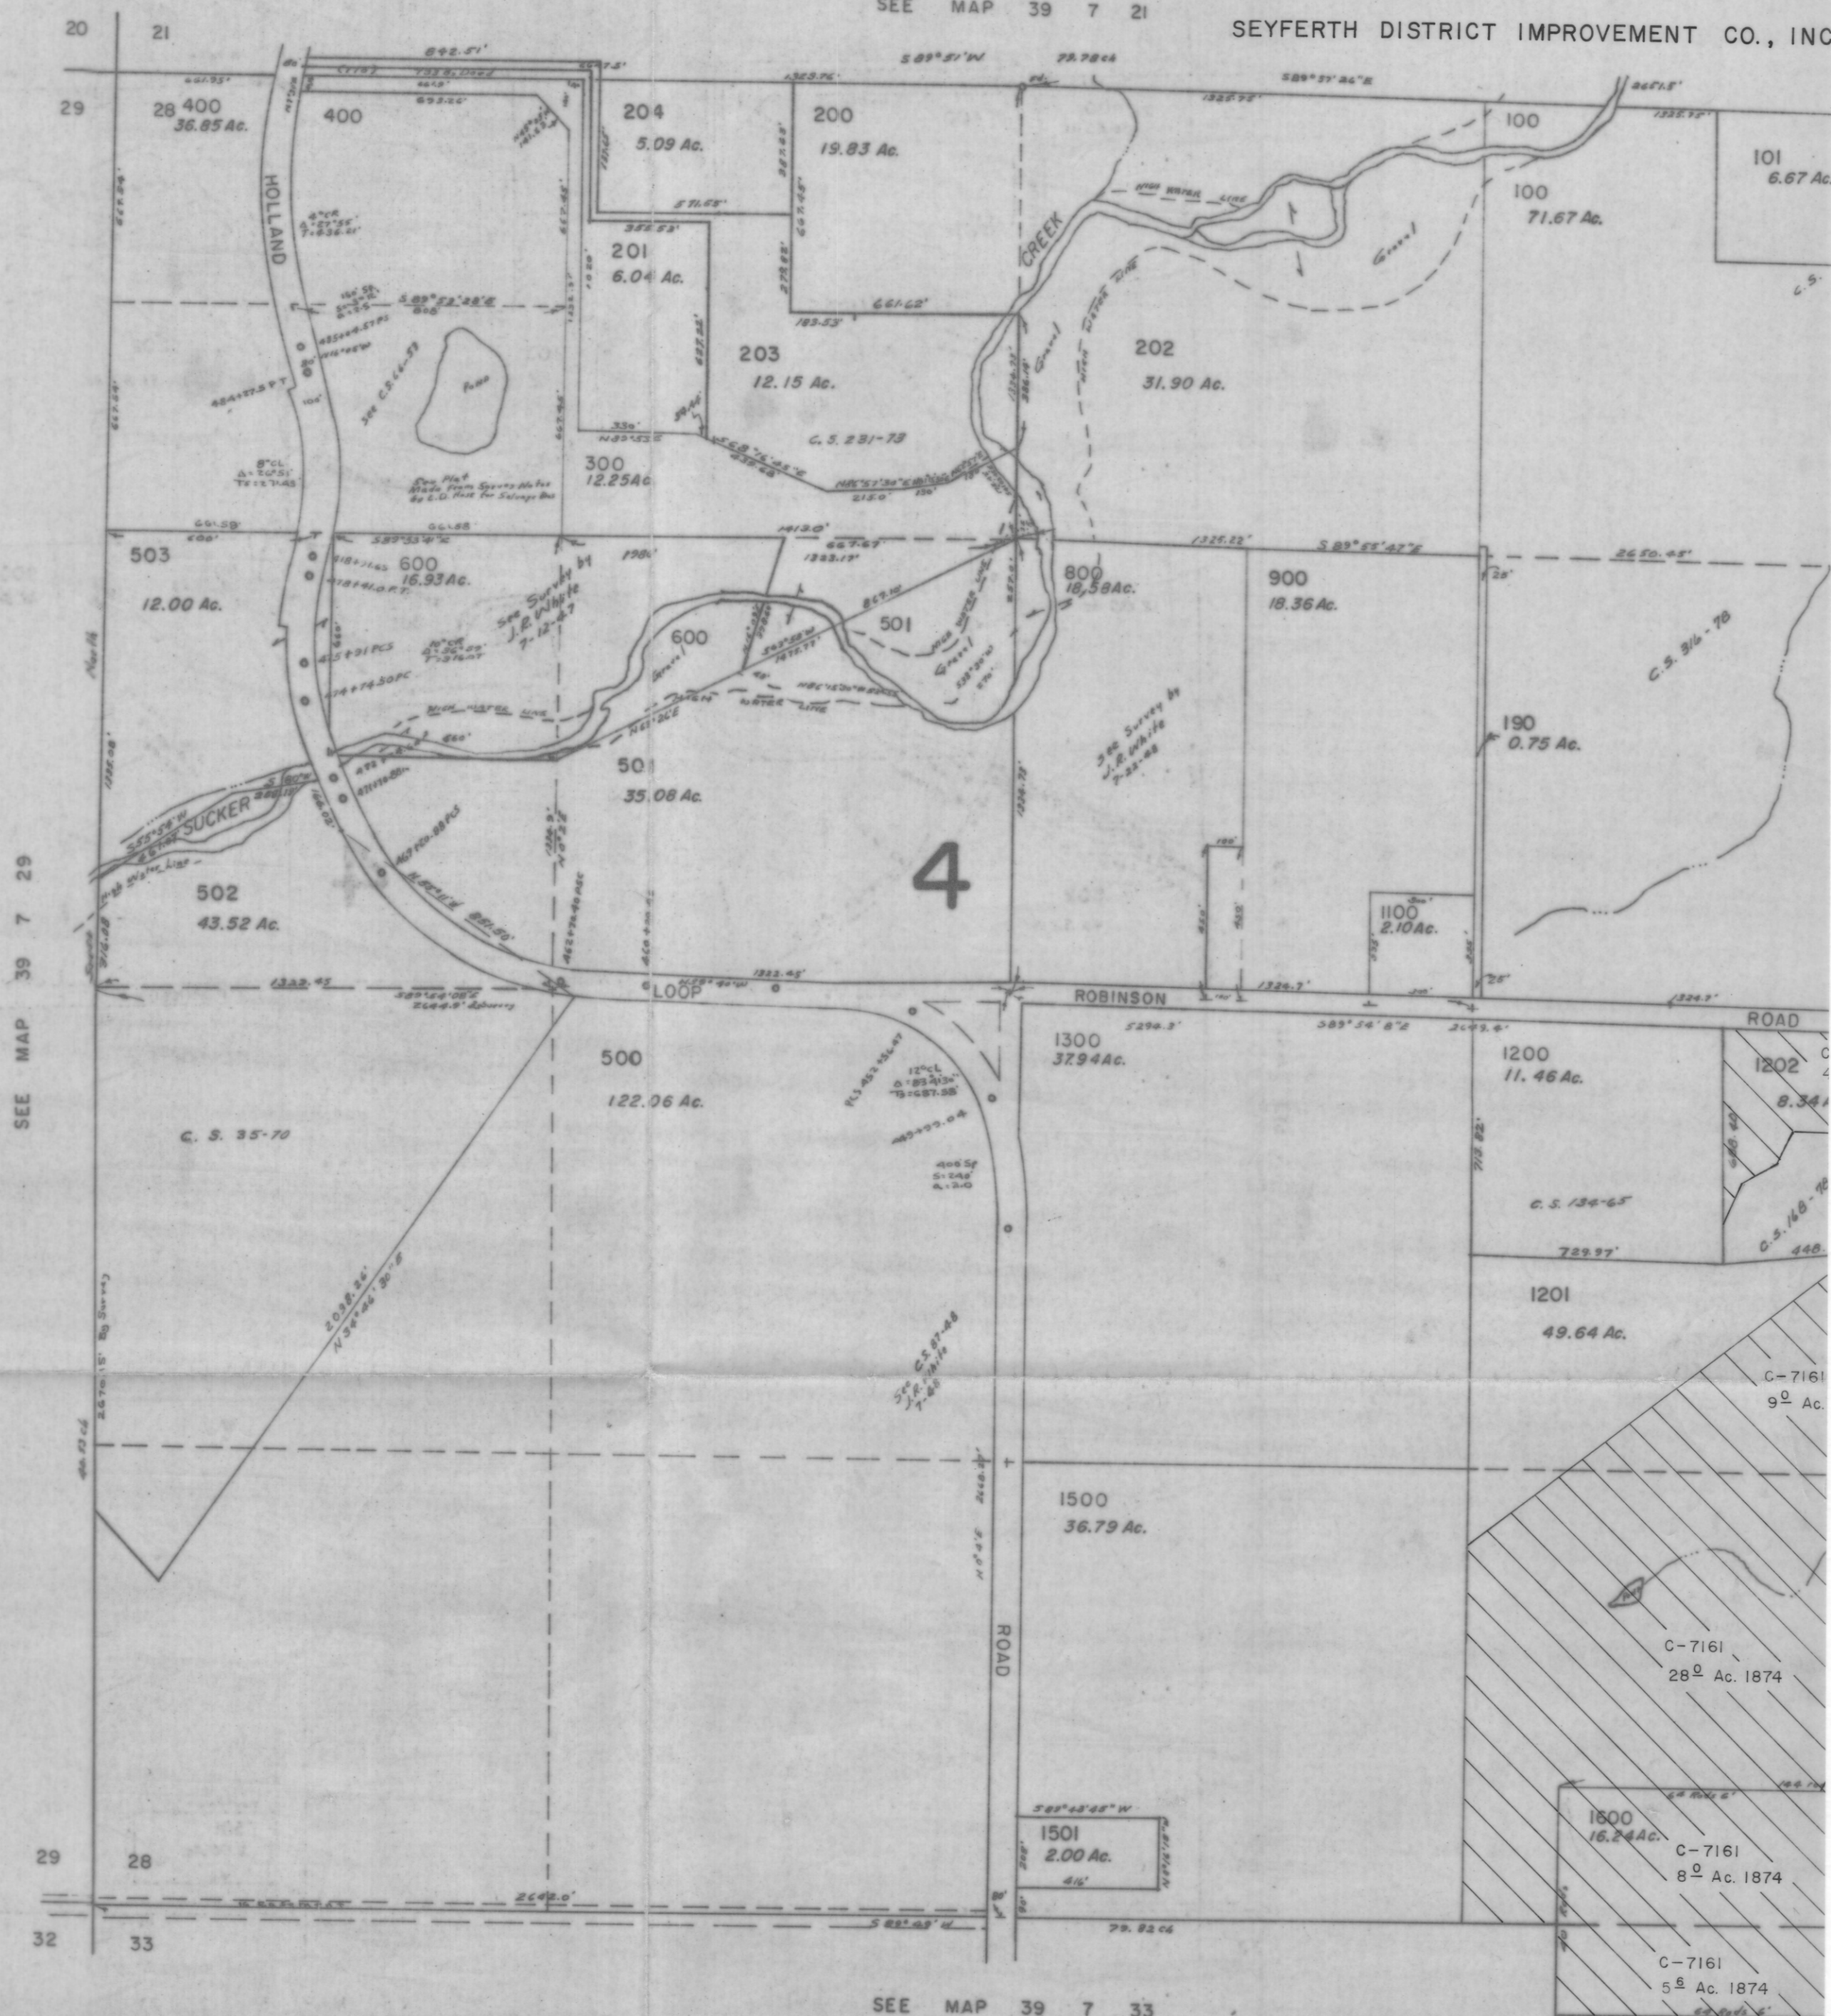


SEE MAP 39 7 33

1-3197

$1'' = 400'$

SEE MAP 39 7 15

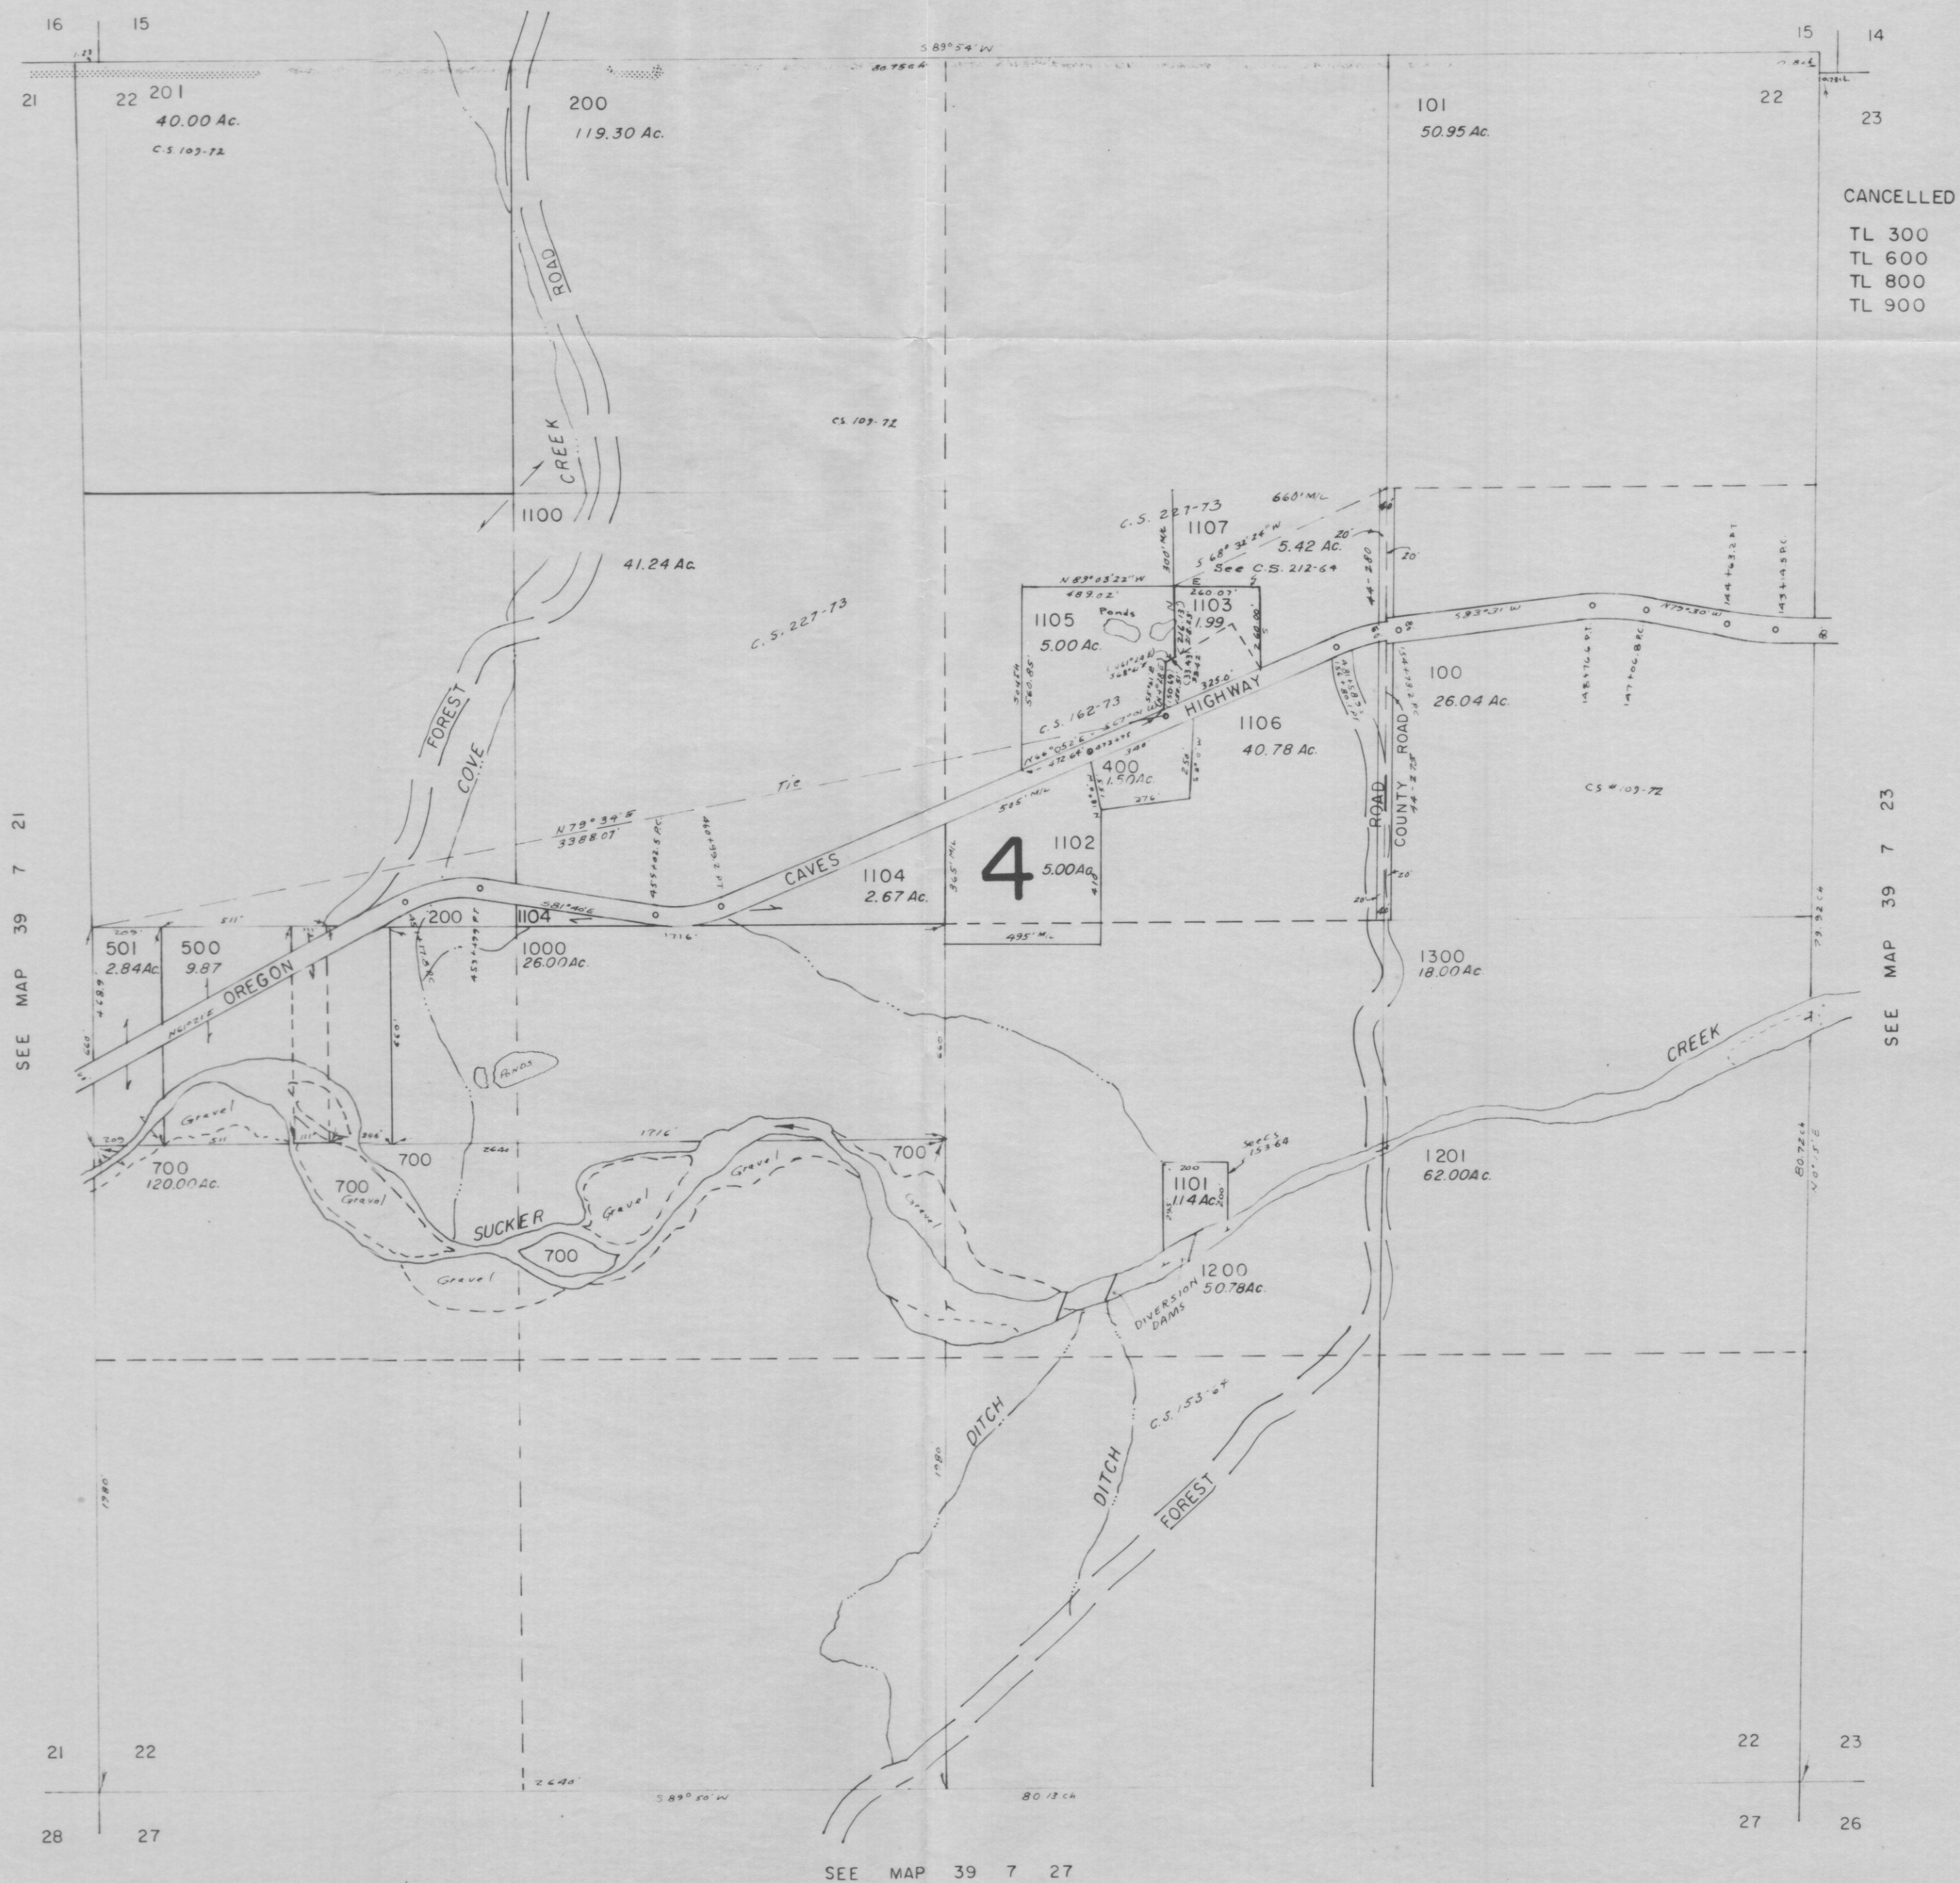


Rec'd from Bob Steimer

$1'' = 400'$

T-3197

SEE MAP 39 7 21

SEYFERTH DISTRICT IMPROVEMENT CO., INC

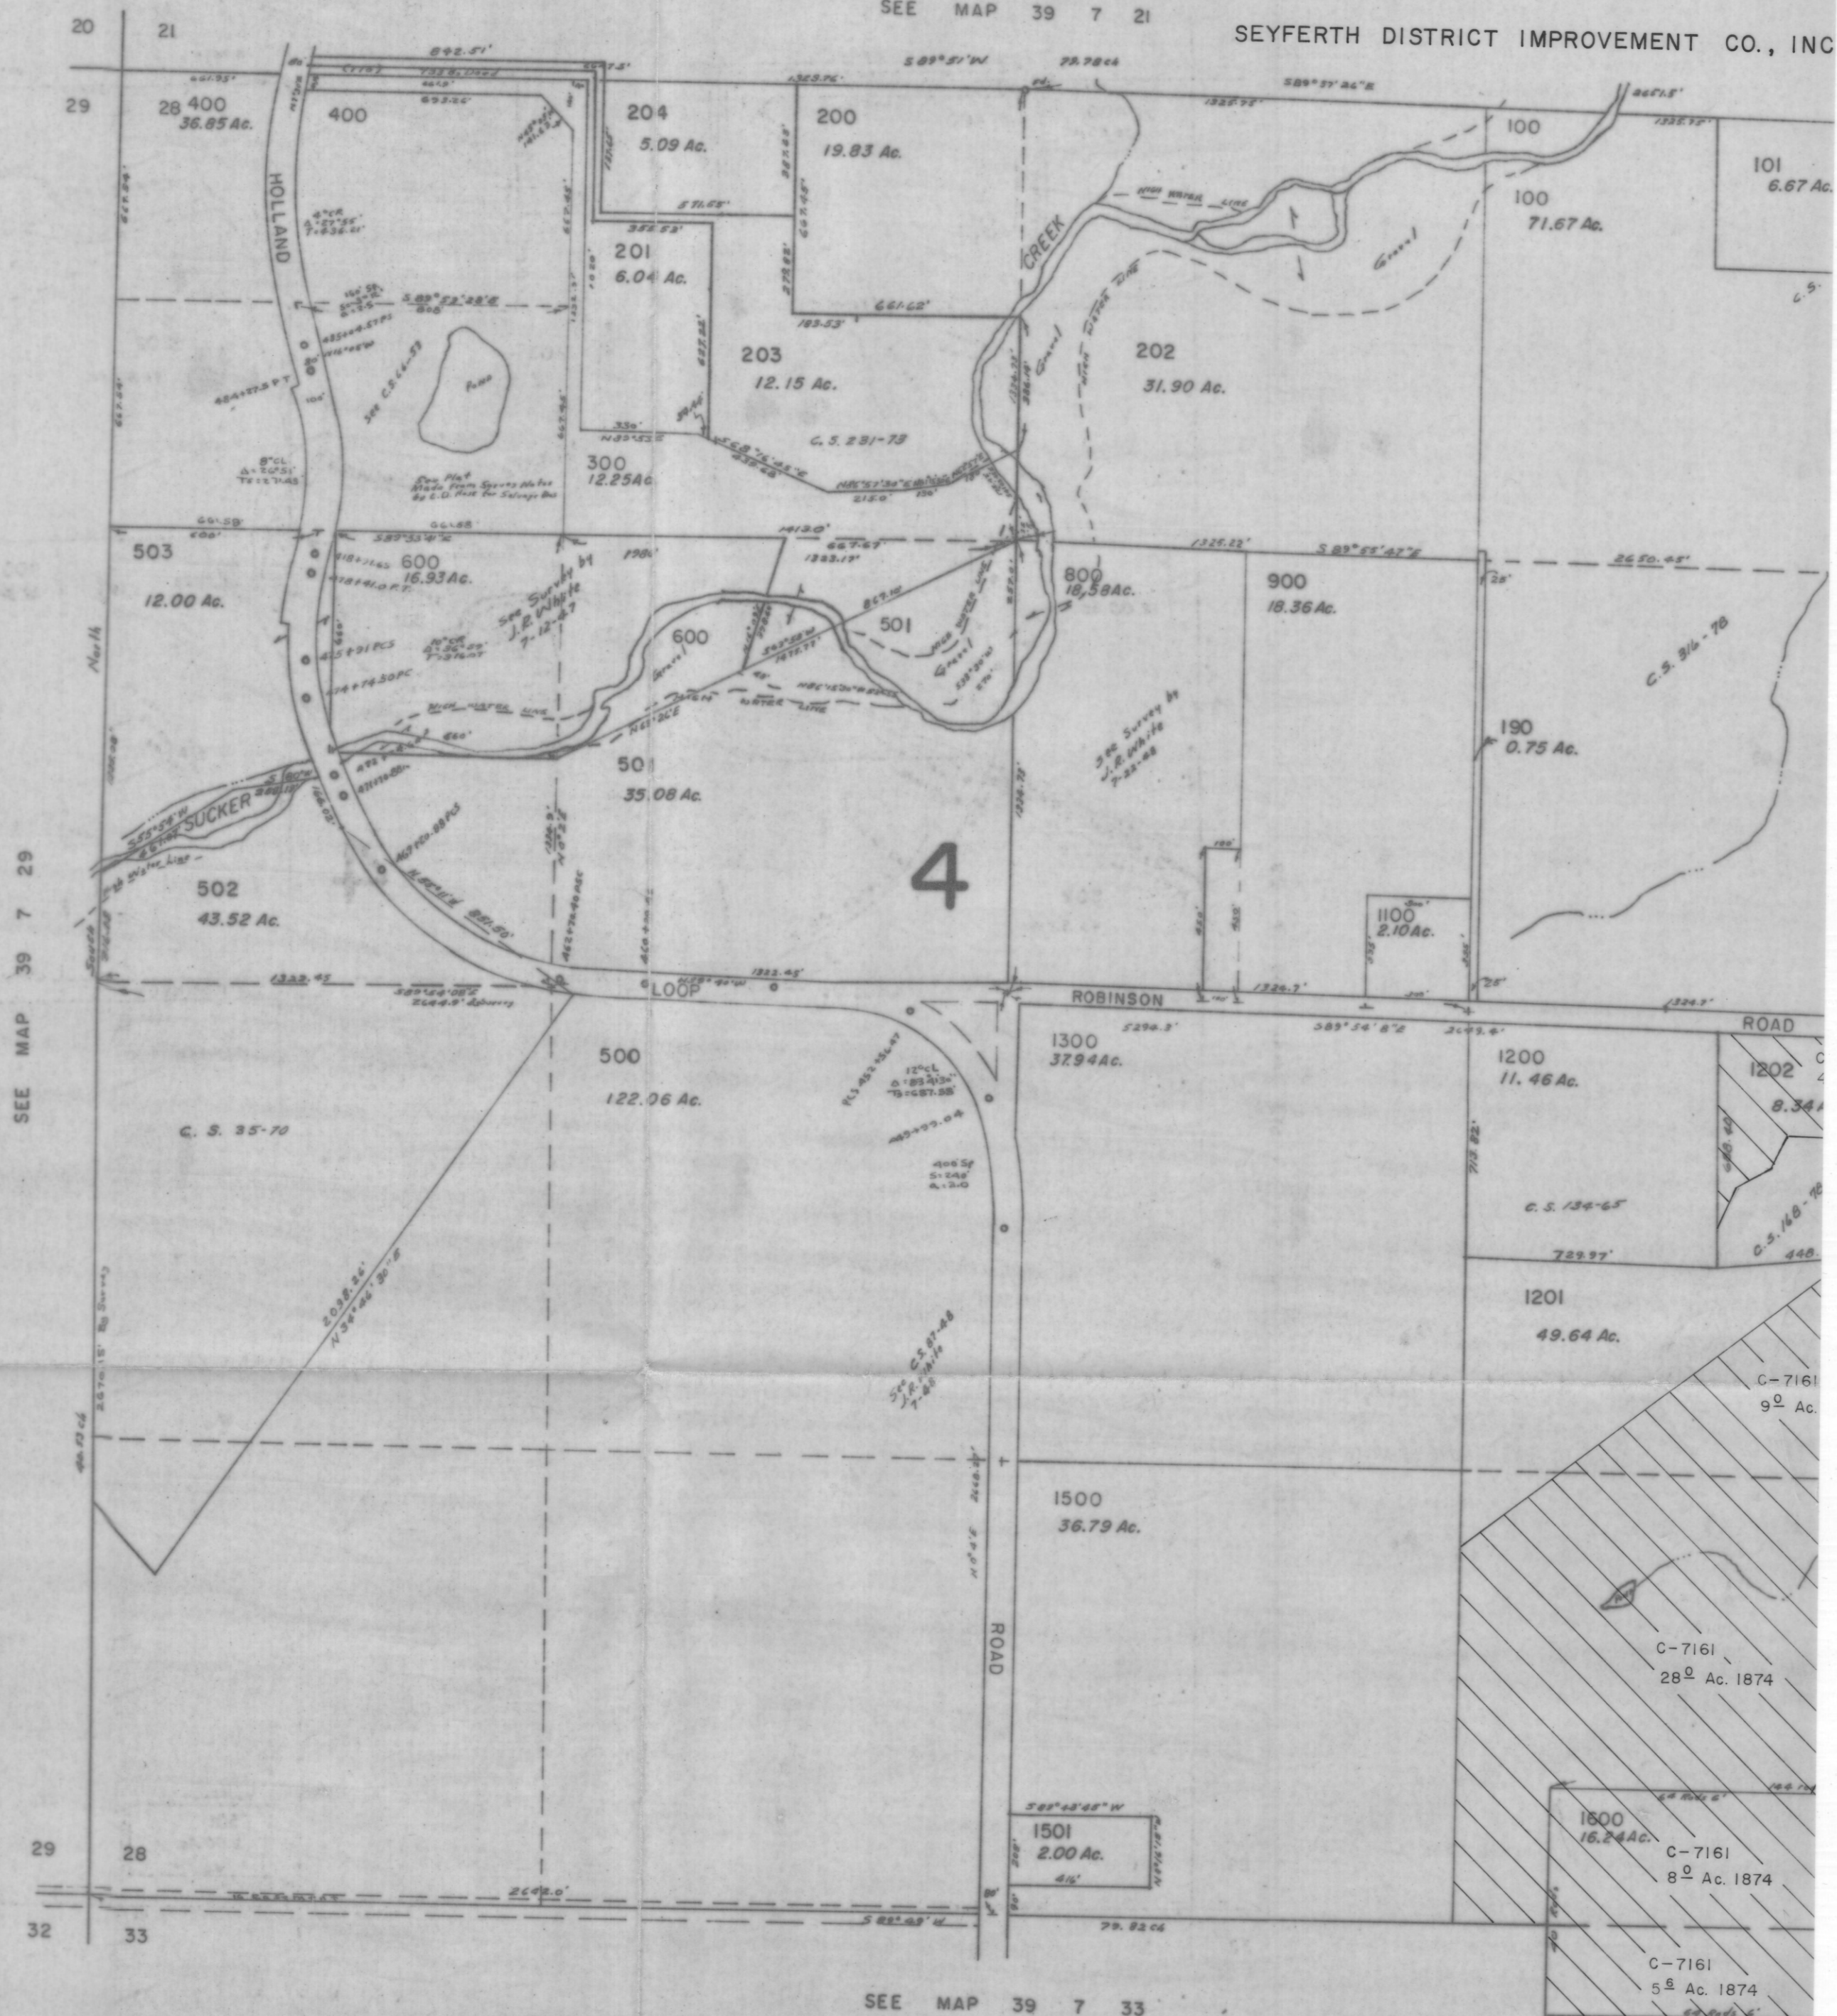

1-3197

T-3197


SEYFERTH DISTRICT IMPROVEMENT CO., INC.

