


T-3197

1"=400'

SEE MAP 39 7 15

SEYFERTH DISTRICT IMPROVEMENT CO., INC.

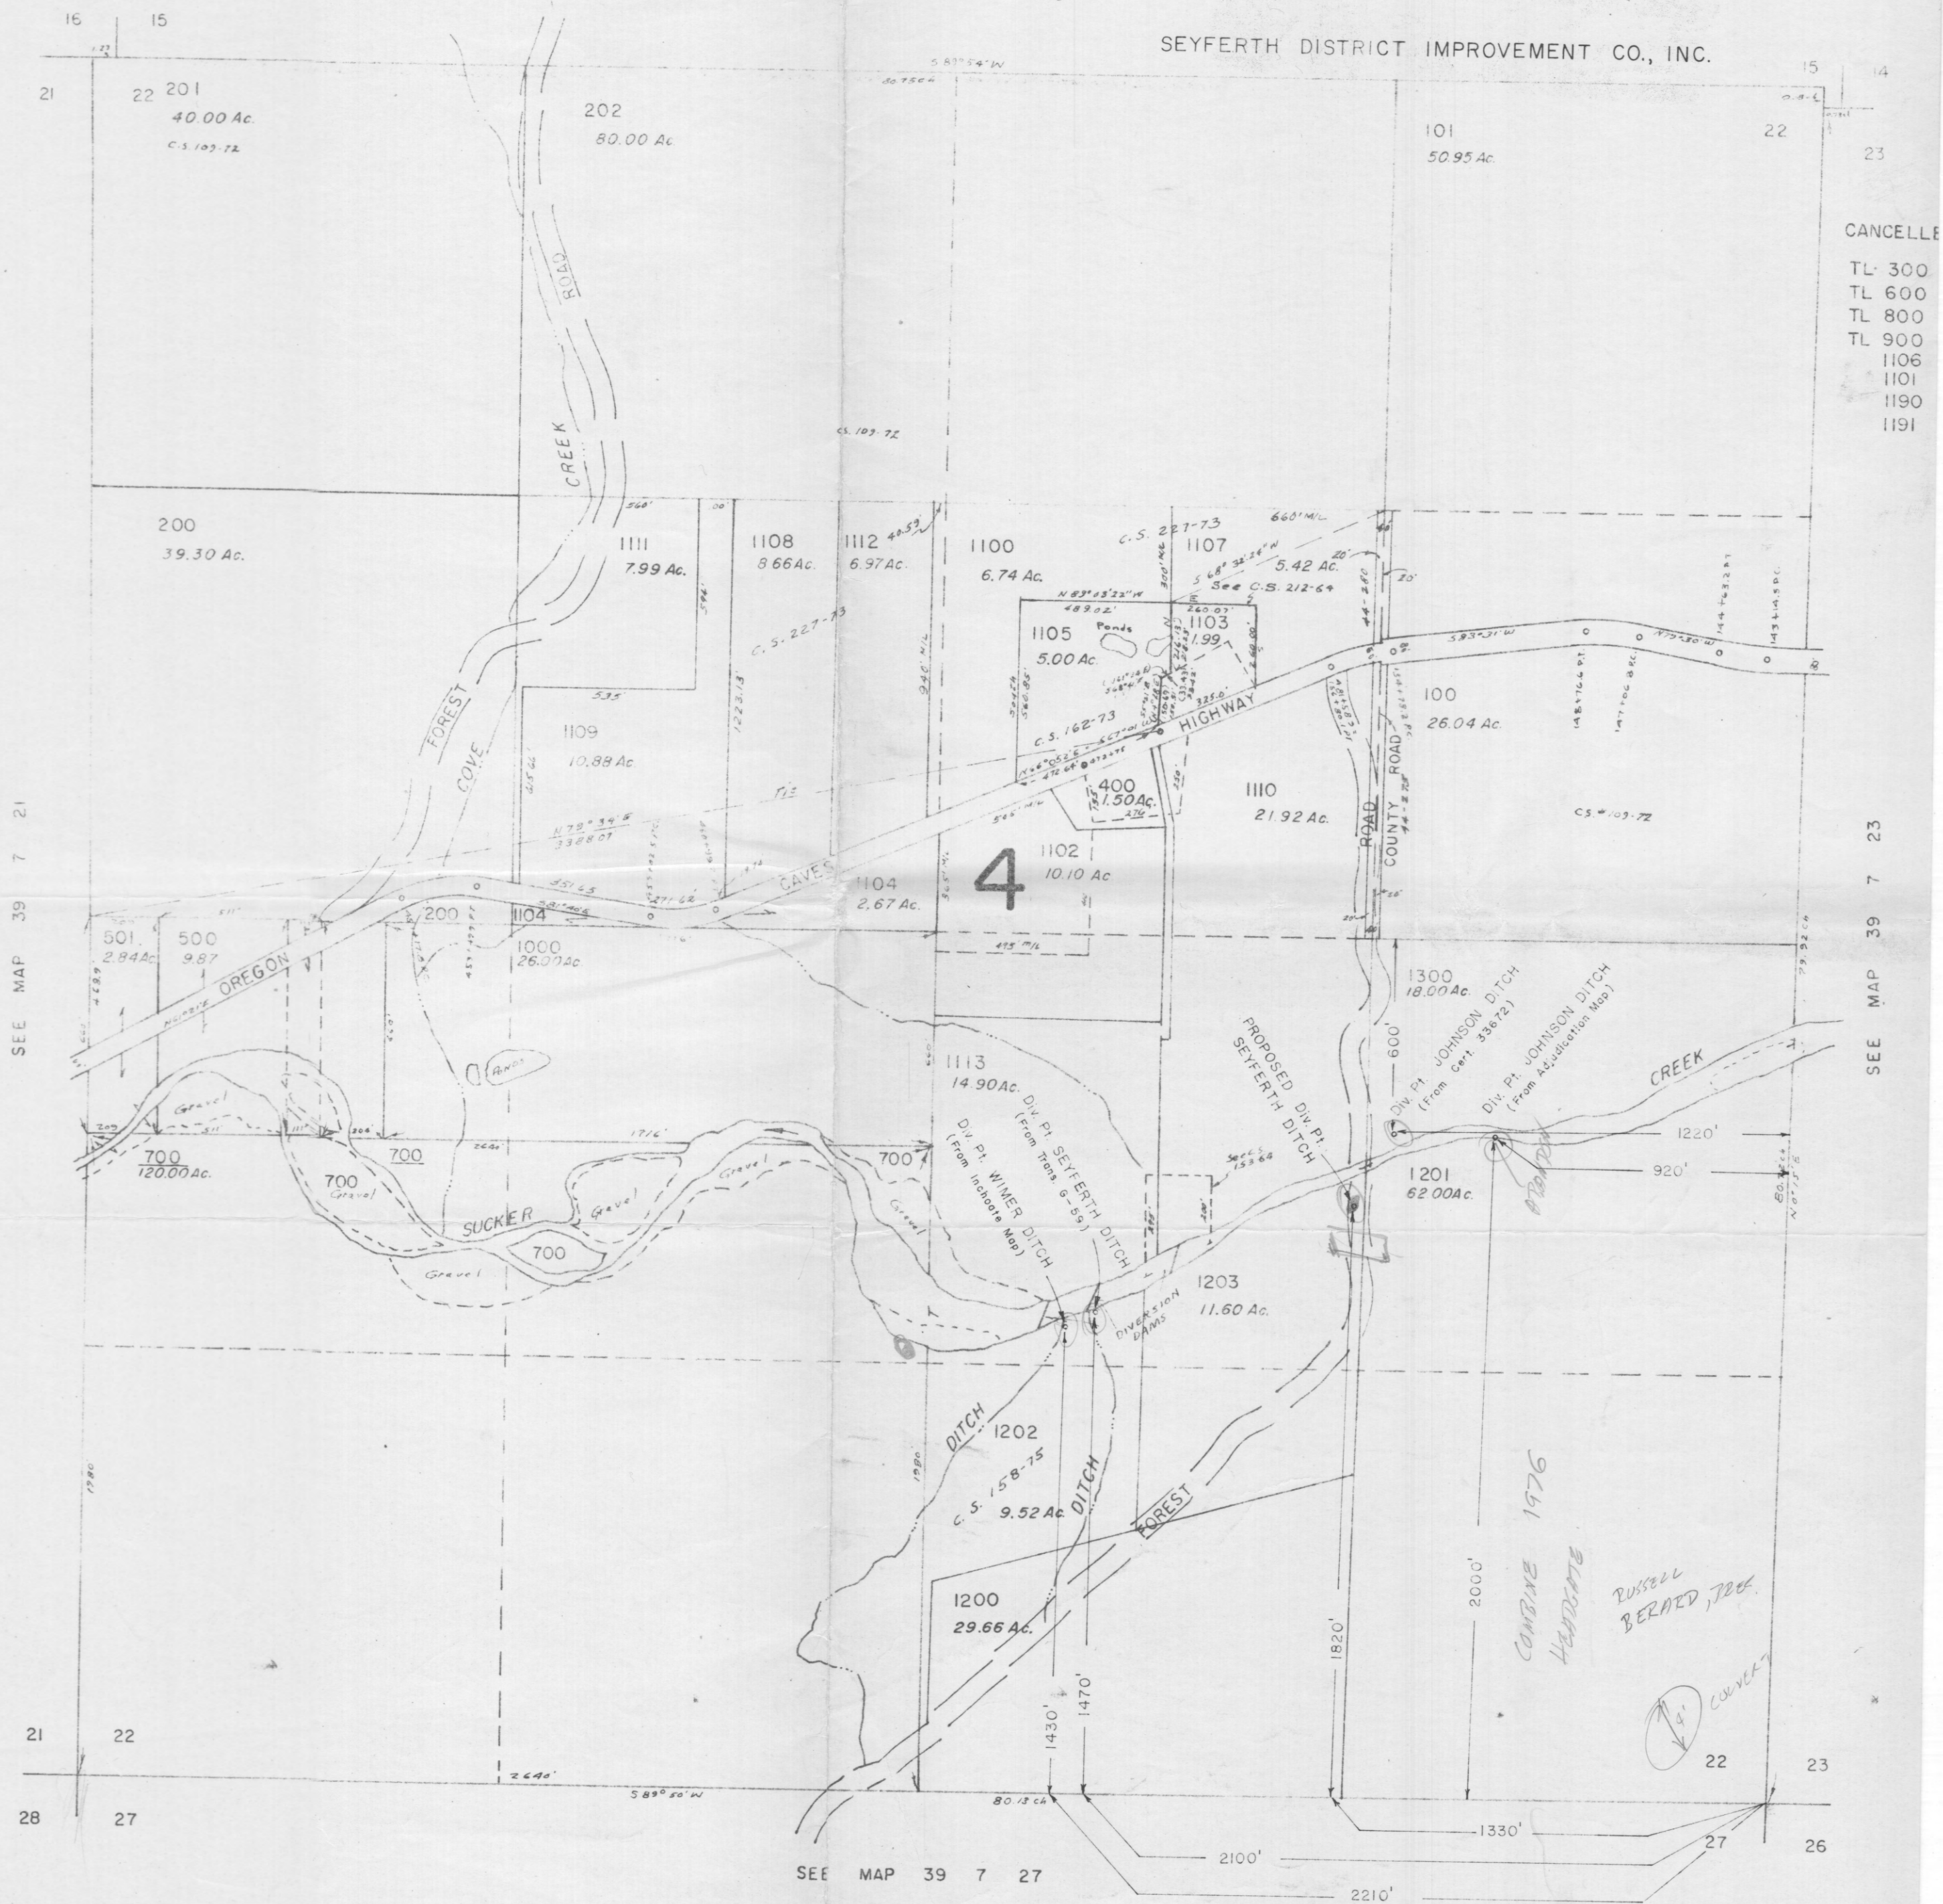

T-3197

$$1'' = 400'$$

SEE MAP 39 7 22

SEYFERTH DISTRICT IMPROVEMENT CO., INC.

22 | 23

27 26

34 35

39 7 27



SECTION 33 T.39S. R.7W. W.M.
JOSEPHINE COUNTY

1"=400'

T-3197

39 7 33

SEE MAP 39 7 28

SEYFERTH DISTRICT IMPROVEMENT CO., INC.

CANCELLED T.L.

1400
1900
1700
1800
1090
990
991
890

SEE MAP 39 7 34

SEE MAP 40 7 4

4 3

39 7 33

SECTION 34 T.39S. R.7W. W.M.
JOSEPHINE COUNTY

1" = 400'

39 7 34

T-3197

