

SCALE:
1" = 400'



Authorized place of use
per Certificate No. 36146
(Priority date = 1868)




Authorized place of use
per Certificate No. 36149
(Priority date = 1897)



Authorized place of use
Transfer from (15.4 Acres)



Proposed place of use
Transfer to (13.0 Acres)

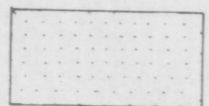

Proposed place of use
for Frost Protection
(45.5 Acres)

Existing Building

P.O.D. Point of Diversion

The Point of Diversion for Seyferth Ditch is located as follow:
NW 1/4 SE 1/4 Section 22, T.39 S., R.7 W., W.M.;
1820' N. and 1330' W. from SE Corner, Section

Point of Diversion No. 1 is located as follows:
SE 1/4 NE 1/4 Section 33, T.39 S., R.7 W., W.M.
370' N. and 280' W. from E 1/4 Corner, Section 33

Point of Diversion No. 2 is located as follows:
NE 1/4 SW 1/4 Section 34, T.39 S., R.7 W., W.M.;
270' S. and 2,380' E. from W 1/4 Corner, Section 34

The purposes of this application are:

1. To transfer 15.4 acres of water rights authorized per Certificate No. 36146 & 36149
2. To transfer 2.4 acres of water rights in the ponds to reservoir maintenance at 0.05 cfs for the Mulvaney Creek Reservoir
3. Apply for a new surface water permit for 45.5 acres for frost protection
4. Reservoir permit for the storage of winter surplus water for the two ponds and reservoir shown

This plat was prepared for the purpose of identifying the location of the water right only. There is no intent to provide dimension or locations of property ownership lines.

REVISED: MARCH 19, 1993


T 7035

PROJECT NO.
276-93-203

DRAWING NO.
133-18.24

DATE
JAN. 22, 1993

SCALE
1" = 400'

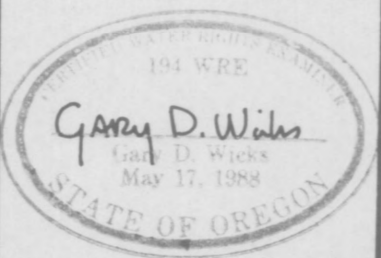

PREPARED FOR:

MR. RUSSELL BERARD
THREE CREEK RANCH
5871 HOLLAND LOOP ROAD
CAVE JUNCTION, OREGON 97523
TEL. 592-3750

PLAT OF WATER RIGHT TRANSFER & APPLICATION

LOCATED IN
E 1/2 OF SEC. 33 AND W 1/2 OF SEC. 34
T.39 S., R.7 W., W.M.
JOSEPHINE COUNTY, OREGON

PREPARED BY:


GARY D. WICKS, P.E., P.L.S.
CIVIL ENGINEER & LAND SURVEYOR
962 S.E. "N" STREET
GRANTS PASS, OREGON 97526-3250
TEL. 479-3436

RECEIVED
OCT 01 1993
WATER RESOURCES DEPT.
SALEM, OREGON


E 1/2 OF SEC. 33 & W 1/2 OF SEC. 34, T.39 S., R.7 W., W.M.




LEGEND:

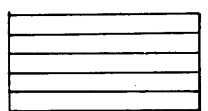


Authorized place of use
per Certificate No. 36146
(Priority date = 1868)

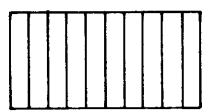


Authorized place of use
per Certificate No. 36149
(Priority date = 1897)

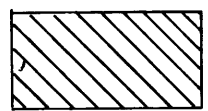

Authorized place of use
Transfer from (15.4 Acres)

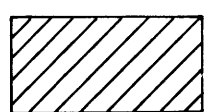

Proposed place of use
Transfer to (13.0 Acres)

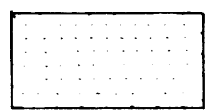

Proposed place of use
for Frost Protection
(45.5 Acres)



Existing Building

P.O.D.

Point of Diversion

The Point of Diversion for Seyferth Ditch is located as follows:
NW 1/4 SE 1/4 Section 22, T.39 S., R.7 W., W.M.;
1820' N. and 1330' W. from SE Corner, Section

Point of Diversion No. 1 is located as follows:
SE 1/4 NE 1/4 Section 33, T.39 S., R.7 W., W.M.
370' N. and 280' W. from E 1/4 Corner, Section 33

Point of Diversion No. 2 is located as follows:
NE 1/4 SW 1/4 Section 34, T.39 S., R.7 W., W.M.;
270' S. and 2,380' E. from W 1/4 Corner, Section 34

The purposes of this application are:

1. To transfer 15.4 acres of water rights
authorized per Certificate No. 36146 & 36149
2. To transfer 2.4 acres of water rights
in the ponds to reservoir maintenance
at 0.05 cfs for the Mulvaney Creek Reservoir
3. Apply for a new surface water permit
for 45.5 acres for frost protection
4. Reservoir permit for the storage of
winter surplus water for the two ponds
and reservoir shown

This plat was prepared for the purpose of
identifying the location of the water right only.
There is no intent to provide dimension or
locations of property ownership lines.

REVISED: MARCH 19, 1993

PROJECT NO.
276-93-203

DRAWING NO.
133-18.24

DATE
JAN. 22, 1993

SCALE
1" = 400'

Gary D. Wicks

PREPARED FOR: MR. RUSSELL BERARD
THREE CREEK RANCH
5871 HOLLAND LOOP ROAD
CAVE JUNCTION, OREGON 97523
TEL. 592-3750

PLAT OF WATER RIGHT TRANSFER & APPLICATION


LOCATED IN
E 1/2 OF SEC. 33 AND W 1/2 OF SEC. 34
T.39 S., R.7 W., W.M.
JOSEPHINE COUNTY, OREGON

PREPARED BY: GARY D. WICKS, P.E., P.L.S.
CIVIL ENGINEER & LAND SURVEYOR
962 S.E. "N" STREET
GRANTS PASS, OREGON 97526-3250
TEL. 479-3436


RECEIVED
OCT 01 1993
WATER RESOURCES DEPT.
SALEM, OREGON

T7035

E 1/2 OF SEC. 33 & W 1/2 OF SEC. 34, T.39 S., R.7 W., W.M.

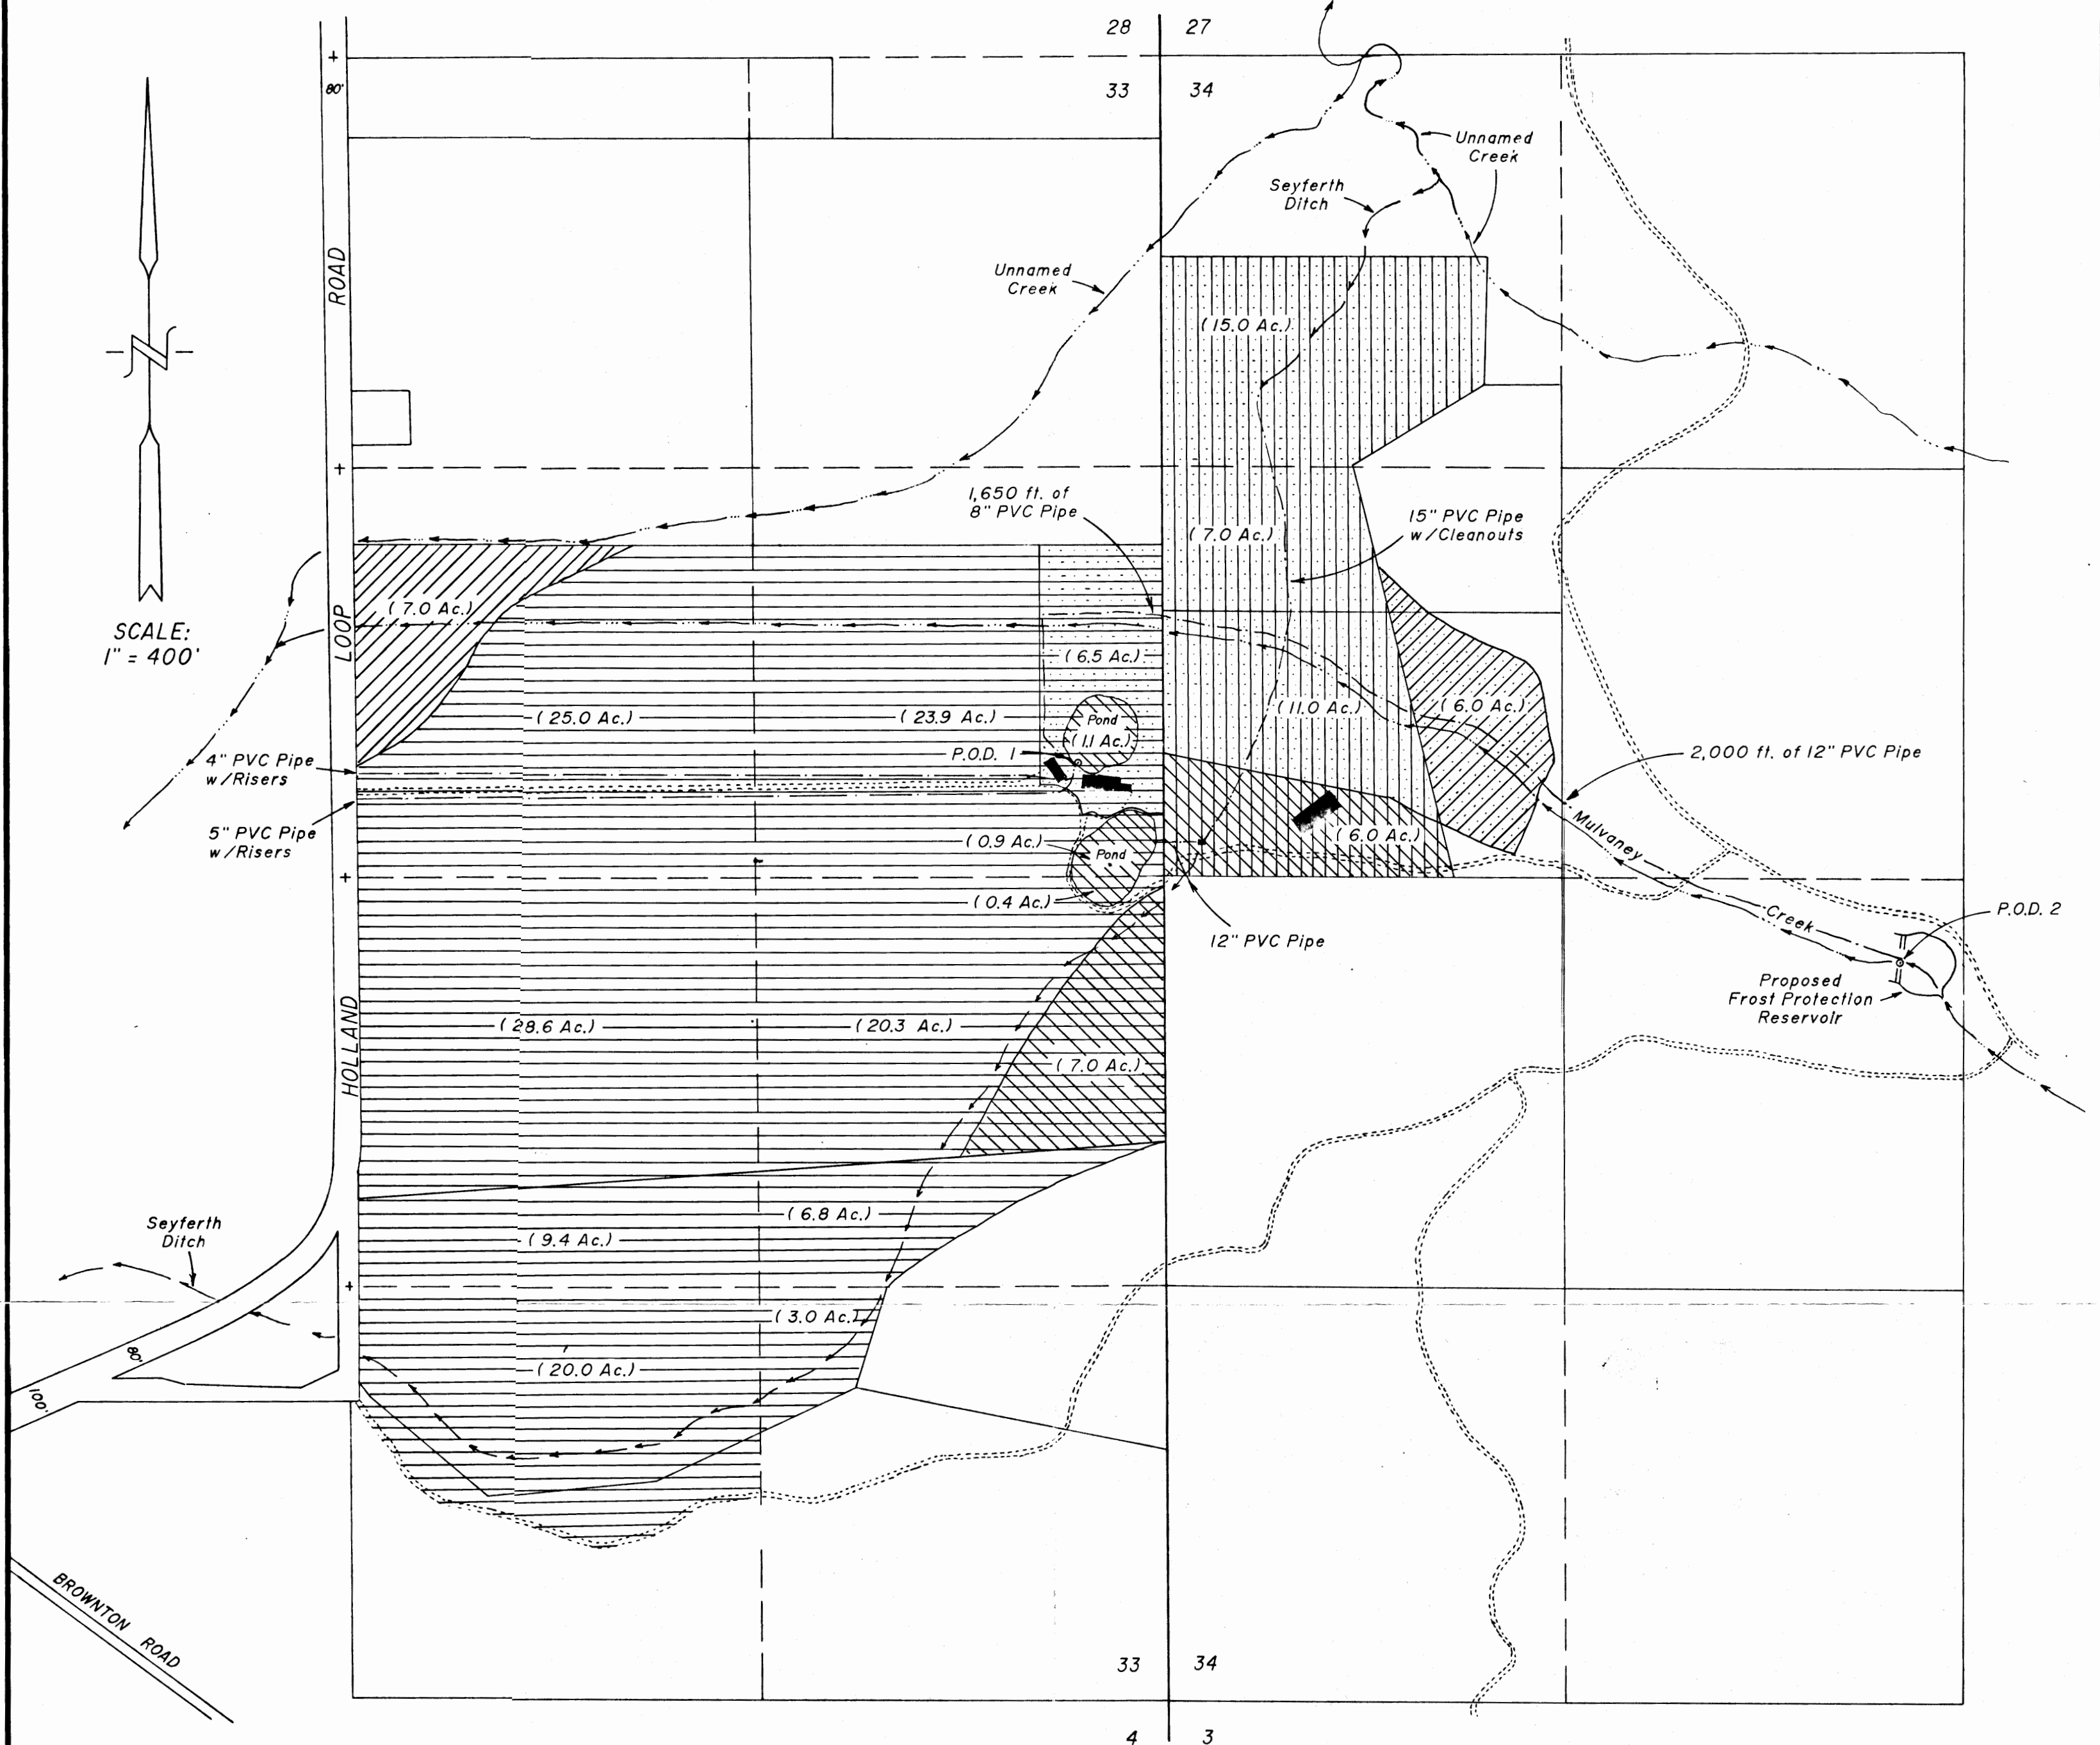


LEGEND:

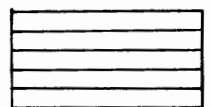


Authorized place of use
per Certificate No. 36146
(Priority date = 1868)




Authorized place of use
per Certificate No. 36149
(Priority date = 1897)

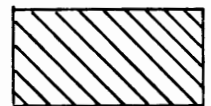

Authorized place of use
Transfer from (15.4 Acres)

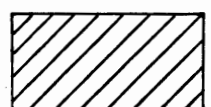

Proposed place of use
Transfer to (13.0 Acres)

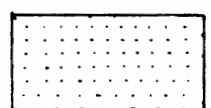

Proposed place of use
for Frost Protection
(45.5 Acres)

Existing Building

P.O.D. Point of Diversion

The Point of Diversion for Seyferth Ditch is located as follows:
NW 1/4 SE 1/4 Section 22, T.39 S., R.7 W., W.M.;
1820' N. and 1330' W. from SE Corner, Section

Point of Diversion No. 1 is located as follows:
SE 1/4 NE 1/4 Section 33, T.39 S., R.7 W., W.M.
370' N. and 280' W. from E 1/4 Corner, Section 33

Point of Diversion No. 2 is located as follows:
NE 1/4 SW 1/4 Section 34, T.39 S., R.7 W., W.M.;
270' S. and 2,380' E. from W 1/4 Corner, Section 34

The purposes of this application are:

1. To transfer 15.4 acres of water rights
authorized per Certificate No. 36146 & 36149
2. To transfer 2.4 acres of water rights
in the ponds to reservoir maintenance
at 0.05 cfs for the Mulvaney Creek Reservoir
3. Apply for a new surface water permit
for 45.5 acres for frost protection
4. Reservoir permit for the storage of
winter surplus water for the two ponds
and reservoir shown

This plat was prepared for the purpose of
identifying the location of the water right only.
There is no intent to provide dimension or
locations of property ownership lines.

RECEIVED

AUG 30 1993

WATER RESOURCES DEPT.
SALEM, OREGON

RECEIVED

AUG - 9 1993

WATER RESOURCES DEPT.
SALEM, OREGON

REVISED: MARCH 19, 1993

PROJECT NO.
276-93-203

DRAWING NO.
133-18.24

DATE
JAN. 22, 1993

SCALE
1" = 400'



T-7035


PREPARED FOR:
MR. RUSSELL BERARD
THREE CREEK RANCH
5871 HOLLAND LOOP ROAD
CAVE JUNCTION, OREGON 97523
TEL. 592-3750

PLAT OF WATER RIGHT TRANSFER & APPLICATION


LOCATED IN
E 1/2 OF SEC. 33 AND W 1/2 OF SEC. 34
T.39 S., R.7 W., W.M.
JOSEPHINE COUNTY, OREGON

PREPARED BY:
GARY D. WICKS, P.E., P.L.S.
CIVIL ENGINEER & LAND SURVEYOR
962 S.E. "N" STREET
GRANTS PASS, OREGON 97526-3250
TEL. 479-3436


E 1/2 OF SEC. 33 & W 1/2 OF SEC. 34, T.39 S., R.7 W., W.M.

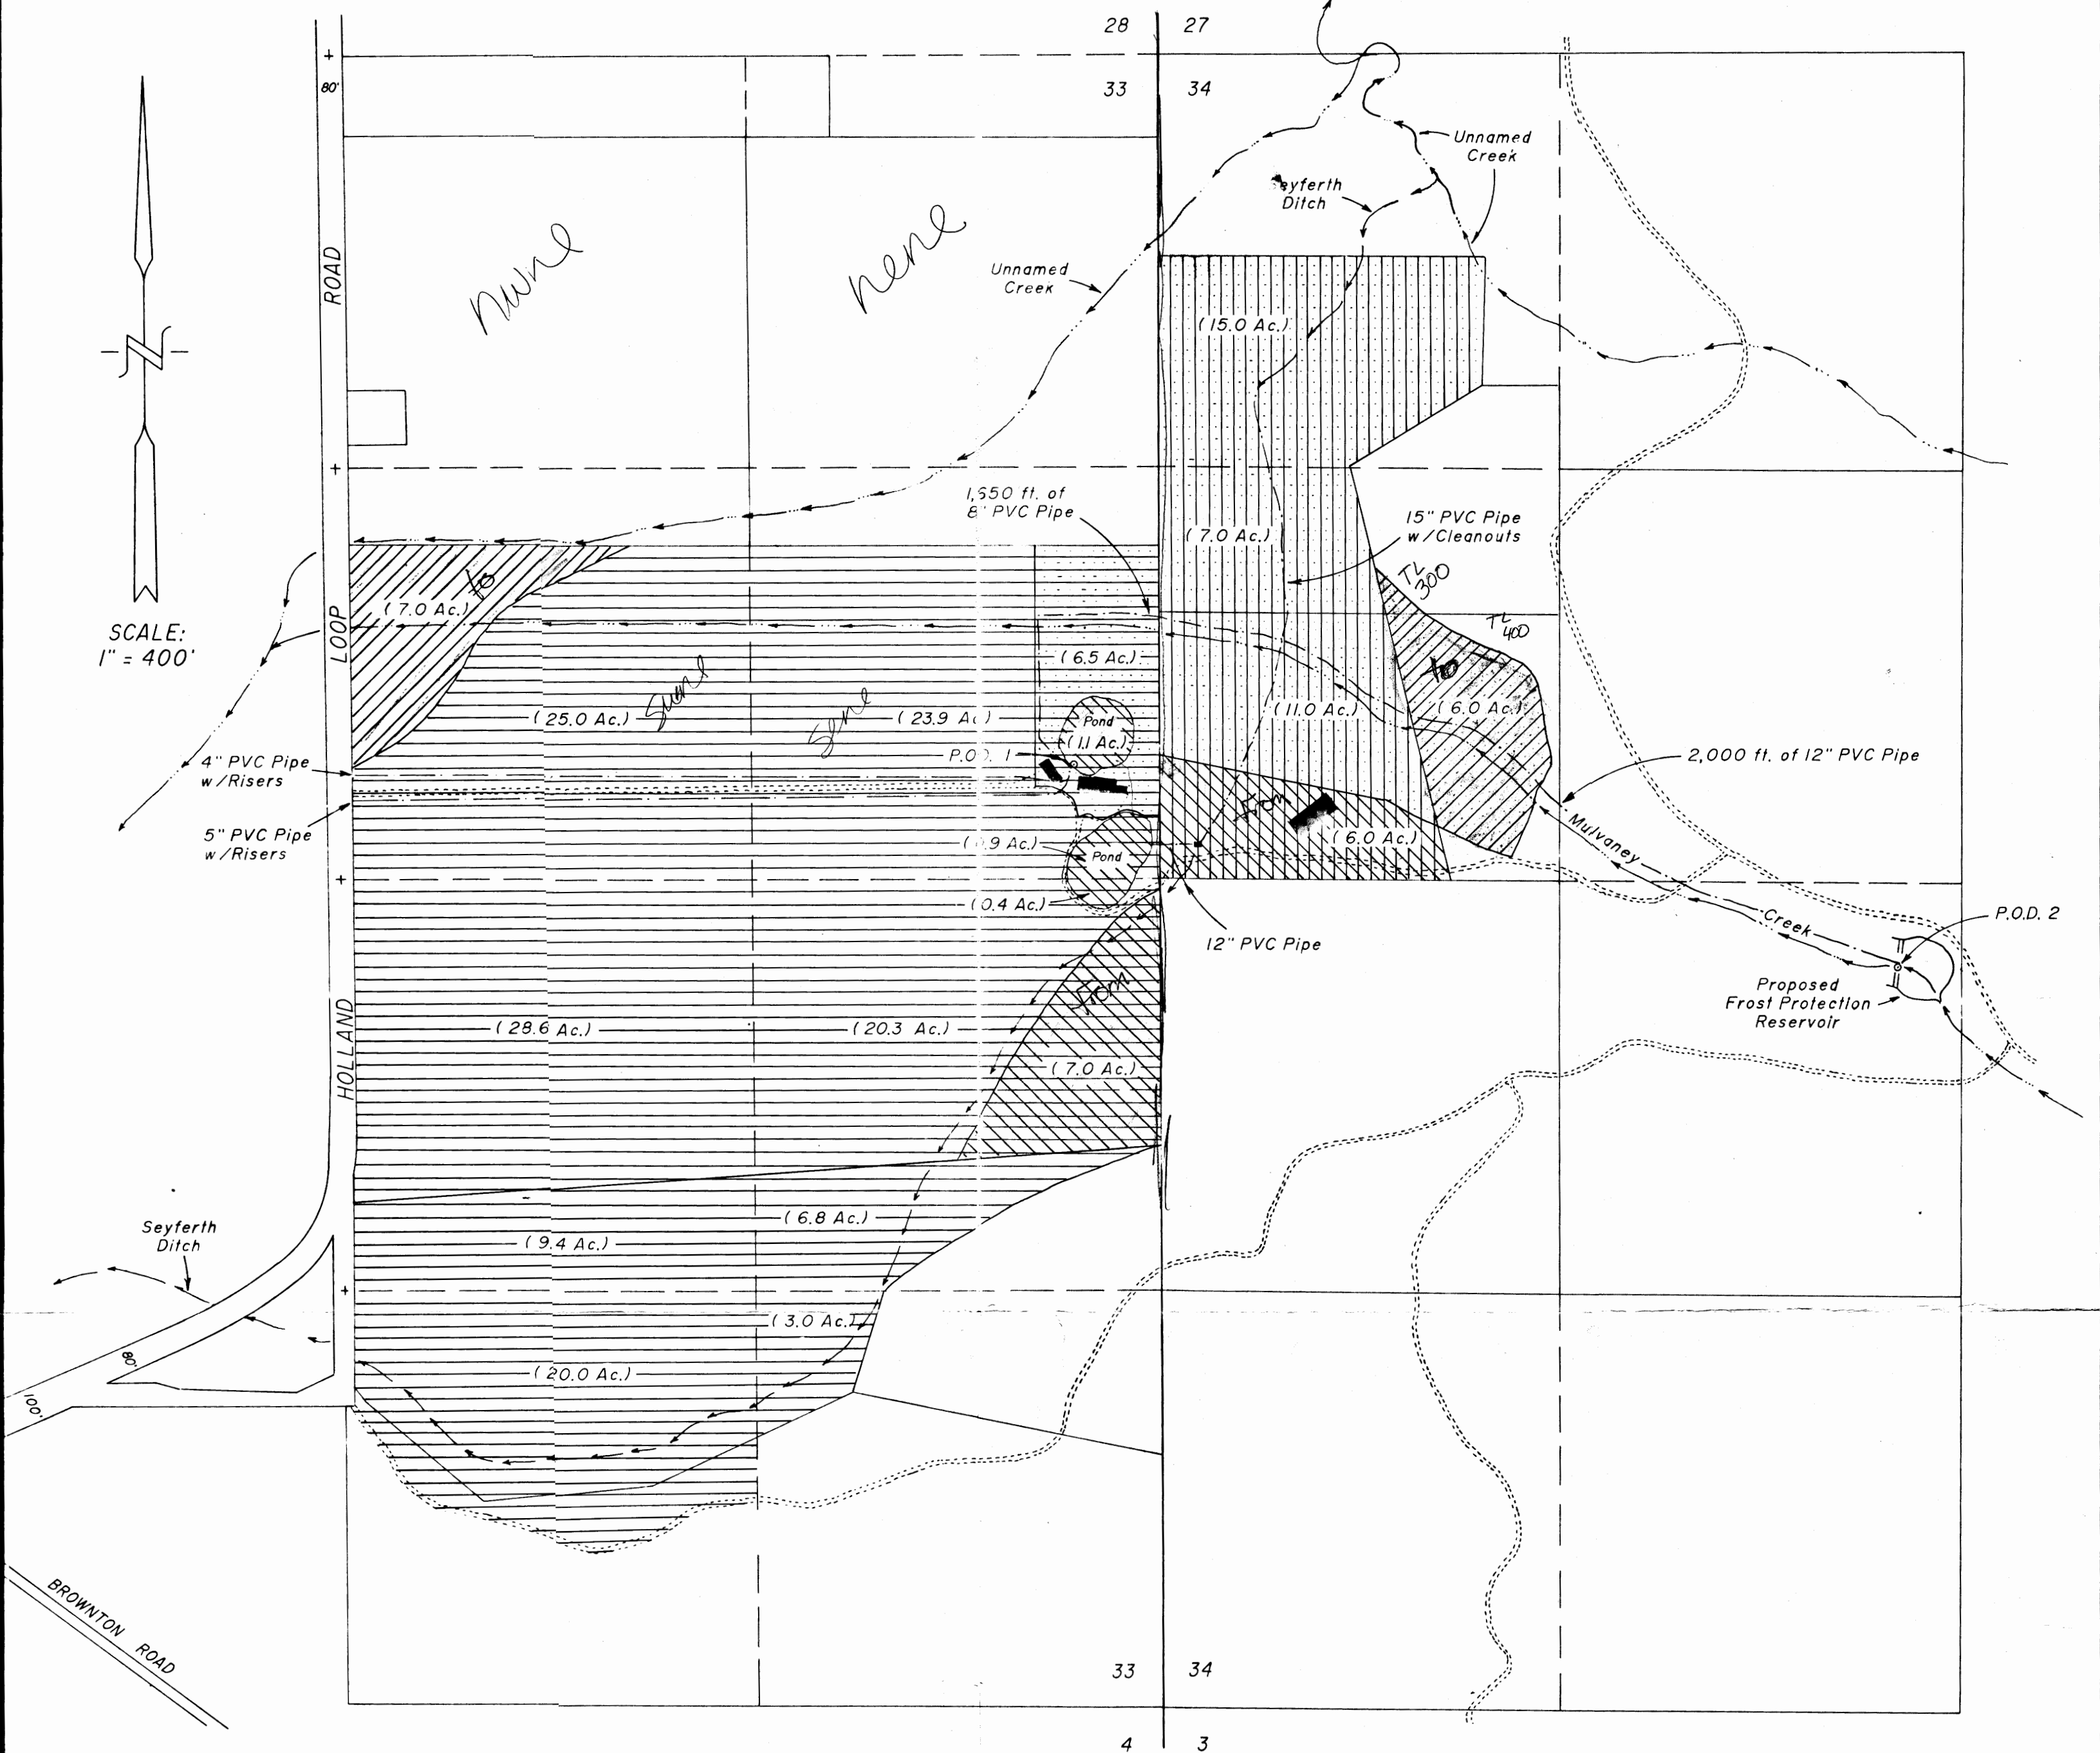


LEGEND:

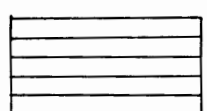


Authorized place of use
per Certificate No. 36146
(Priority date = 1868)

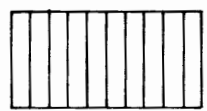


Authorized place of use
per Certificate No. 36149
(Priority date = 1897)

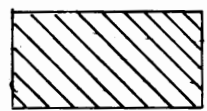

Authorized place of use
Transfer from (15.4 Acres)

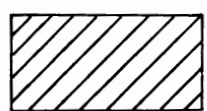

Proposed place of use
Transfer to (13.0 Acres)

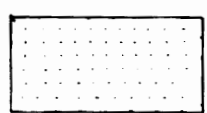

Proposed place of use
for Frost Protection
(45.5 Acres)



Existing Building

P.O.D.

Point of Diversion

The Point of Diversion for Seyferth Ditch is located as follows:
NW 1/4 SE 1/4 Section 22, T.39 S., R.7 W., W.M.;
1820' N. and 1330' W. from SE Corner, Section

Point of Diversion No. 1 is located as follows:
SE 1/4 NE 1/4 Section 33, T.39 S., R.7 W., W.M.;
370' N. and 280' W. from E 1/4 Corner, Section 33

Point of Diversion No. 2 is located as follows:
NE 1/4 SW 1/4 Section 34, T.39 S., R.7 W., W.M.;
270' S. and 2,380' E. from W 1/4 Corner, Section 34

The purposes of this application are:

1. To transfer 15.4 acres of water rights
authorized per Certificate No. 36146 & 36149
2. To transfer 2.4 acres of water rights
in the ponds to reservoir maintenance
at 0.05 cfs for the Mulvaney Creek Reservoir
3. Apply for a new surface water permit
for 45.5 acres for frost protection
4. Reservoir permit for the storage of
winter surplus water for the two ponds
and reservoir shown

This plat was prepared for the purpose of
identifying the location of the water right only.
There is no intent to provide dimension or
locations of property ownership lines.

RECEIVED

OCT 01 1993

WATER RESOURCES DEPT.
SALEM, OREGON

REVISED: MARCH 19, 1993

T 7035

PROJECT NO.
276-93-203

DRAWING NO.
133-18.24

DATE
JAN. 22, 1993

SCALE
1" = 400'



PREPARED FOR:
MR. RUSSELL BERARD
THREE CREEK RANCH
5871 HOLLAND LOOP ROAD
CAVE JUNCTION, OREGON 97523
TEL. 592-3750

PLAT OF WATER RIGHT TRANSFER & APPLICATION


LOCATED IN
E 1/2 OF SEC. 33 AND W 1/2 OF SEC. 34
T.39 S., R.7 W., W.M.
JOSEPHINE COUNTY, OREGON

PREPARED BY:
GARY D. WICKS, P.E., P.L.S.
CIVIL ENGINEER & LAND SURVEYOR
962 S.E. "N" STREET
GRANTS PASS, OREGON 97526-3250
TEL. 479-3436

E 1/2 OF SEC. 33 & W 1/2 OF SEC. 34, T.39 S., R.7 W., W.M.




LEGEND:

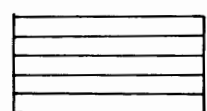


Authorized place of use
per Certificate No. 36146
(Priority date = 1868)




Authorized place of use
per Certificate No. 36149
(Priority date = 1897)

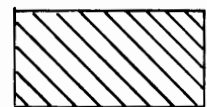

Authorized place of use
Transfer from (15.4 Acres)

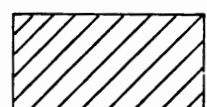

Proposed place of use
Transfer to (13.0 Acres)

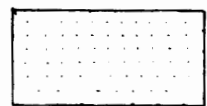

Proposed place of use
for Frost Protection
(45.5 Acres)

Existing Building

P.O.D. Point of Diversion

The Point of Diversion for Seyferth Ditch is located as follows:
NW 1/4 SE 1/4 Section 22, T.39 S., R.7 W., W.M.;
1820' N. and 1330' W. from SE Corner, Section

Point of Diversion No. 1 is located as follows:
SE 1/4 NE 1/4 Section 33, T.39 S., R.7 W., W.M.;
370' N. and 280' W. from E 1/4 Corner, Section 33

Point of Diversion No. 2 is located as follows:
NE 1/4 SW 1/4 Section 34, T.39 S., R.7 W., W.M.;
270' S. and 2,380' E. from W 1/4 Corner, Section 34

The purposes of this application are:

1. To transfer 15.4 acres of water rights
authorized per Certificate No. 36146 & 36149
2. To transfer 2.4 acres of water rights
in the ponds to reservoir maintenance
at 0.05 cfs for the Mulvaney Creek Reservoir
3. Apply for a new surface water permit
for 45.5 acres for frost protection
4. Reservoir permit for the storage of
winter surplus water for the two ponds
and reservoir shown

This plat was prepared for the purpose of
identifying the location of the water right only.
There is no intent to provide dimension or
locations of property ownership lines.

RECEIVED

OCT 07 1993

WM. DIST. 14
GRANTS PASS, ORE.

RECEIVED

OCT 01 1993

WATER RESOURCES DEPT.
SALEM, OREGON

REVISED: MARCH 19, 1993

T 7035

PROJECT NO.
276-93-203

DRAWING NO.
133-18.24

DATE
JAN. 22, 1993

SCALE
1" = 400'



PREPARED FOR:
MR. RUSSELL BERARD
THREE CREEK RANCH
5871 HOLLAND LOOP ROAD
CAVE JUNCTION, OREGON 97523
TEL. 592-3750

PLAT OF WATER RIGHT TRANSFER & APPLICATION

LOCATED IN
E 1/2 OF SEC. 33 AND W 1/2 OF SEC. 34
T.39 S., R.7 W., W.M.
JOSEPHINE COUNTY, OREGON

PREPARED BY:
GARY D. WICKS, P.E., P.L.S.
CIVIL ENGINEER & LAND SURVEYOR
962 S.E. "N" STREET
GRANTS PASS, OREGON 97526-3250
TEL. 479-3436