


6459 Instream Lease Application Map

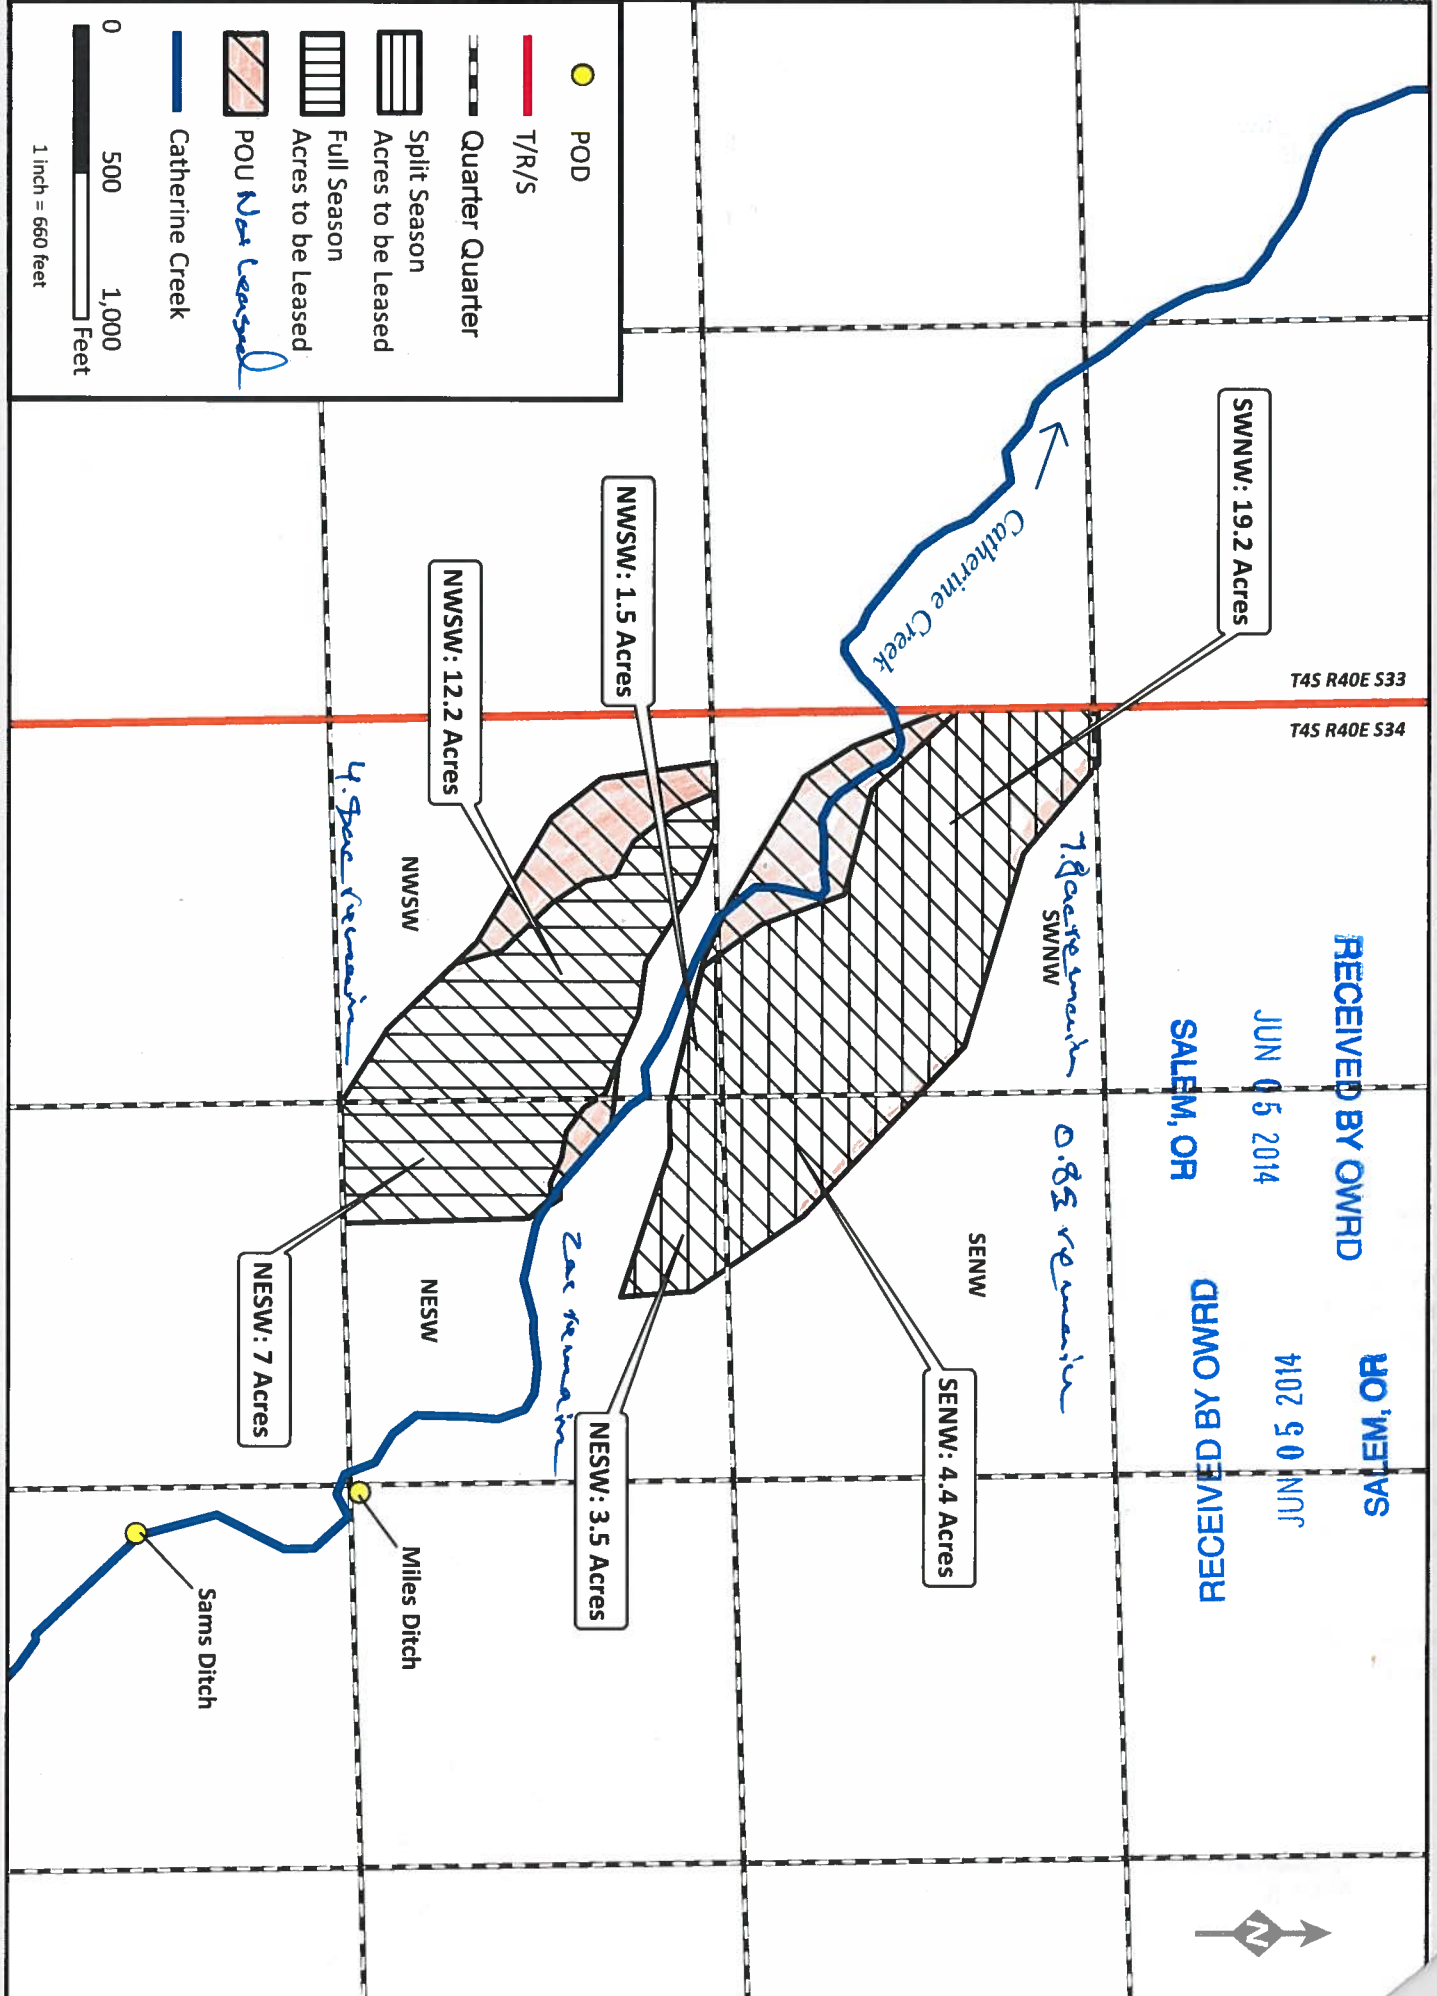

RECEIVED BY OWRD
 JUN 05 2014
 SALEM, OR

RECEIVED BY OWRD
 4107 50 NUT
 SALEM, OR



T4S R40E S33
 T4S R40E S34