



Oregon Water Resources Department
 725 Summer Street NE, Suite A
 Salem, Oregon 97301-1266
 (503) 986-0900
 www.wrd.state.or.us

District Permanent Water Right Transfer Claim of Beneficial Use

1. APPLICANT INFORMATION

District: Hermiston Irrigation District

Contact Person: Annette Kirkpatrick

Phone: 541-567-3024

Mailing Address: 366 E Hurlburt Ave

City: Hermiston State: OR

Zip: 97838

E-Mail address:

hid@eoni.com

Transfer Number: T - 11695

RECEIVED BY OWRD

JUL 13 2015

SALEM, OR

2. WATER RIGHT(S)

Pursuant to OAR Chapter 690, Division 385, the district is submitting to the Water Resources Department this claim of beneficial use, with the appropriate fee, for the following water right(s):

PERMIT NUMBER	CERTIFICATE NUMBER	DECREE (name, volume, and page)	PRIMARY (P) OR SOFT (S)
-	89006	Umatilla River Sept. 6, 1905 Vol. 3 Pg. 242	<input checked="" type="checkbox"/> P <input type="checkbox"/> S
-			<input type="checkbox"/> P <input type="checkbox"/> S
-			<input type="checkbox"/> P <input type="checkbox"/> S
-			<input type="checkbox"/> P <input type="checkbox"/> S

3. AUTHORIZED POINT(S) OF DIVERSION (POD) / APPROPRIATION (POA)

The authorized point(s) of diversion / appropriation for the water right modified by the transfer are as follows:

PERMIT NUMBER	DECREE or CERTIFICATE	POD / POA #	SOURCE	LOCATION - MEASURED DISTANCES
-	89006		A-Line	A-Line Canal 1490 ft S and 2840 ft. E from NW Corner of Sec. 3 SE 1/4 NW 1/4 Sec. 3, T4N R29E, WM
-				
-				
-				

4. AUTHORIZED PLACE OF USE

The summary of the perfected change in place of use authorized by the final order approving the water right transfer is listed in Table 1.

CERTIFICATE DECREE or PERMIT	POD/ POA #	PERMIT DATE	USE	LEGAL DESCRIPTION							ACRES	USER NAME	
				TWP	RNG	SEC	QQ	DLC	GOVT LOT	TAX			
	A-Line	9/6/1905	IR	4 N	28 E	20	SE SE				1300	4.43	Brandon Christensen
TOTAL:											4.43		

5. MAP AND SITE REPORT

Attached is a map and site report for each water right listed in Table 1 that satisfies the requirements of OAR 690-385-7400.

RECEIVED BY OWRD

JUL 13 2015

July 2013

SALEM, OR

6. SIGNATURES

The district certifies that it has inspected the place of use listed in Table I, and confirms the change in place of use has been completed consistent with the terms and conditions of the final order approving the transfer.

Annette Kirkpatrick
Signature of District Manager
or District Board Chairperson

7-9-15
Date

Annette KIRKPATRICK
Type or Print Name of District Manager
or District Board Chairperson

RECEIVED BY OWRD

JUL 13 2015

SALEM, OR

CLAIM OF BENEFICIAL USE Site Report

Transfer Number: T - 11695 District Internal Notice #: 2013-001

User Name: Brandon Christensen

Place of Use:

USE	POD #	TWP	RNG	SEC	QQ	DLC	GOV'T LOT	TAX LOT	ACRES
IR		4N	28E	20	NWSE			1300	4.43

District Conveyance System:

Description of Delivery System: Open canal A-Line to pump and pipe line

Headgate: _____ Canal: A-Line

Beneficial Use:

Description of Beneficial Use: Irrigation of corn

Method Used to Apply Water: Sprinklers

RECEIVED BY OWRD

JUL 13 2015

Method Used to Calculate Beneficial Use: VISUAL INSPECTION

SALEM, OR

User Interviewed: () Yes (X) No

Beneficial Use Made as Authorized: (X) Yes () No

Description of Beneficial Use if Less than Authorized:


Inspected By: *Cynthia K. Patrick* Date: 7-9-15

Instructions: Attach and label the corresponding final proof map.

UIMA ILLA COUNTY
SCALE 1"=200'
HOD

See Map 4N 28 20A

TD
4/13/2015

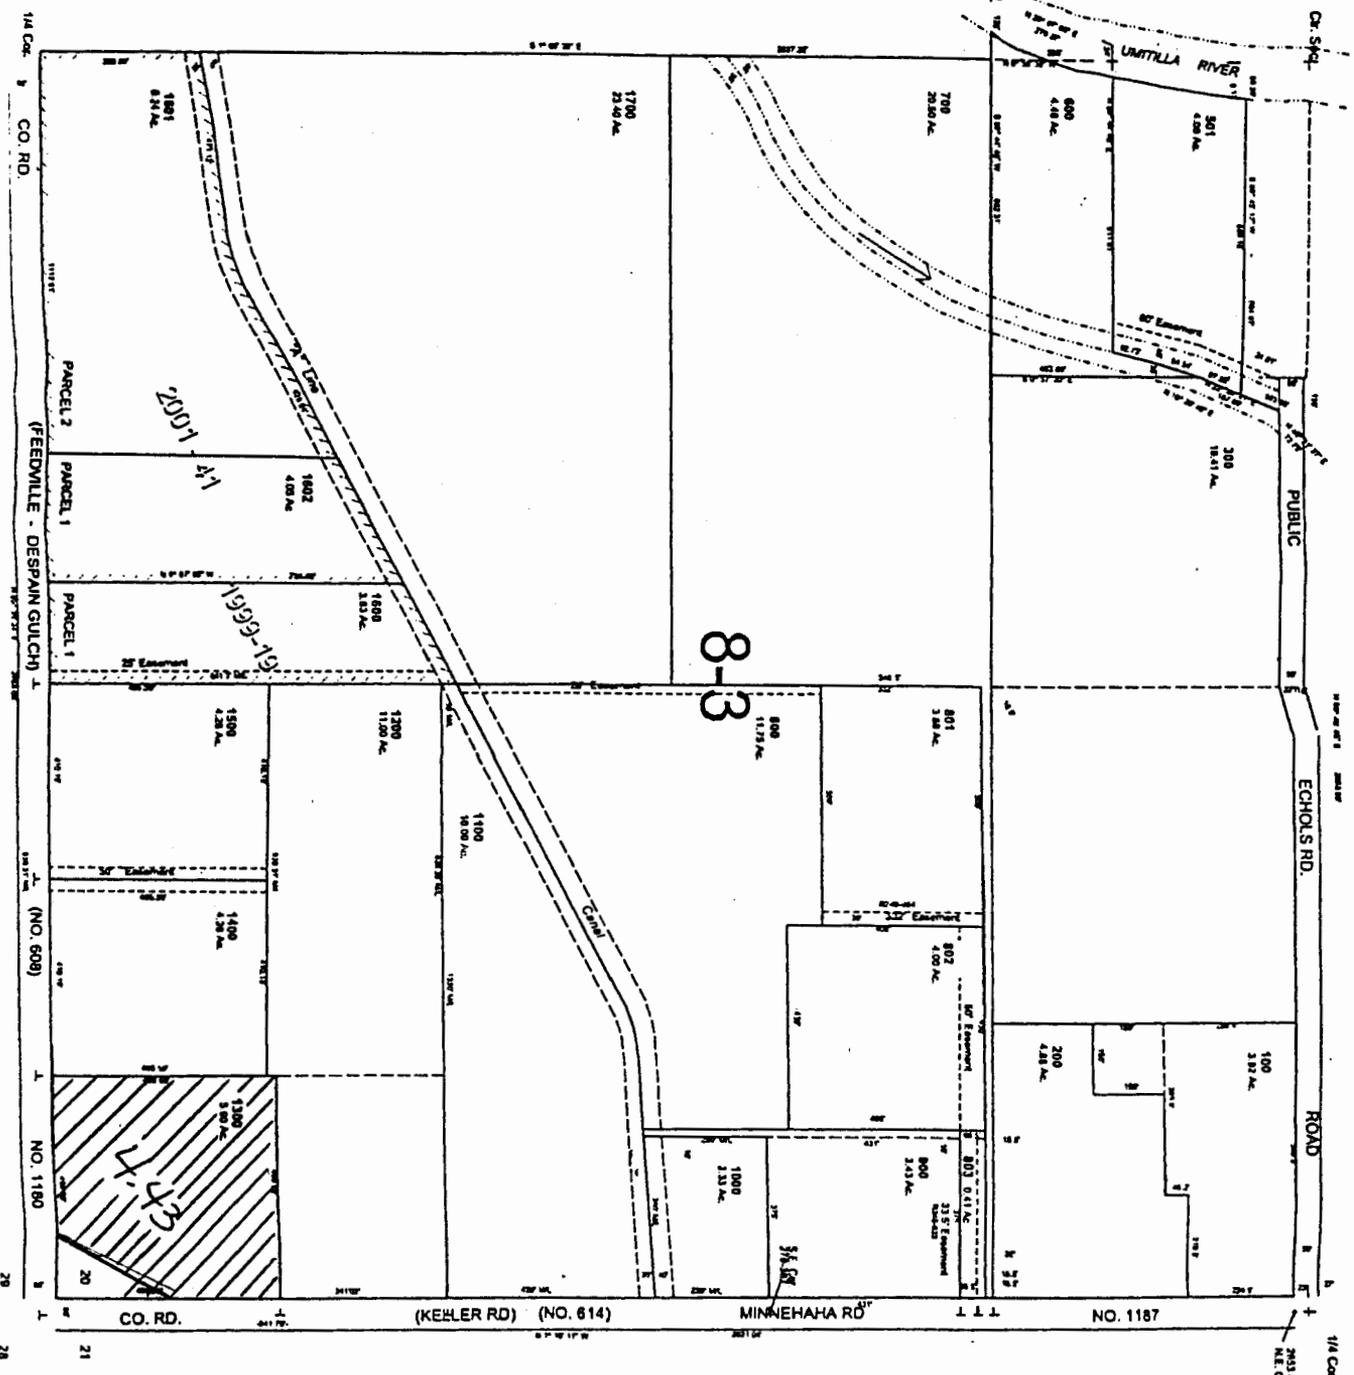

CANCELLED
7/1/2008

RECEIVED BY OWRD

JUL 13 2015

SALEM, OR

