


T. 20S. R. 39E.W.M.

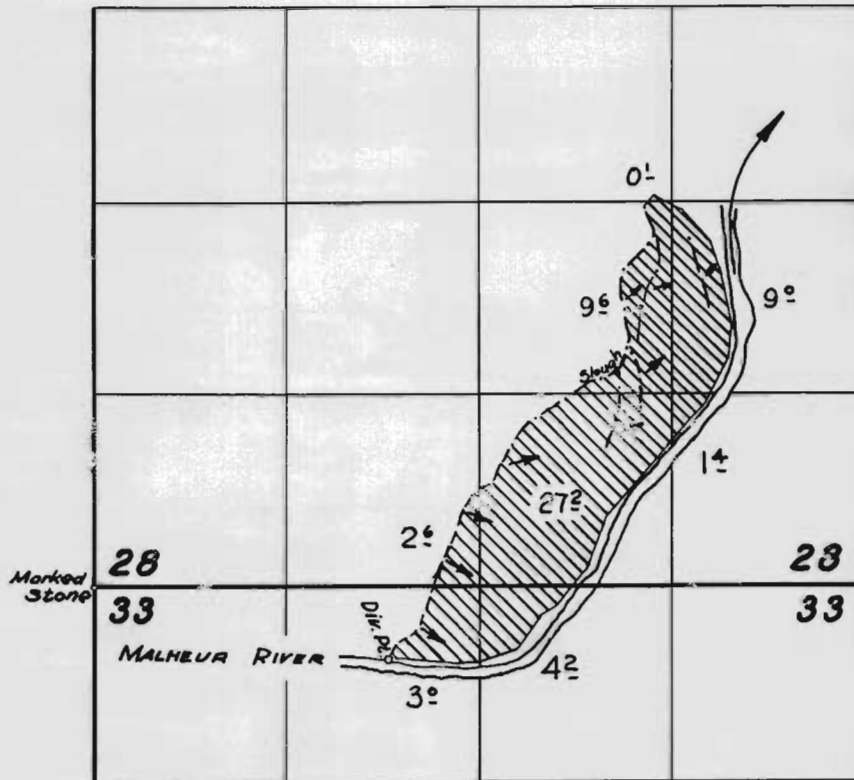

FINAL PROOF SURVEY
UNDER

TRANSFER NUMBER J-27
IN NAME OF

D. E. JONES

Surveyed 24 Oct. 1958, by C. O. Bartels