


T. 15., R. 38 & 39 E. W.M.

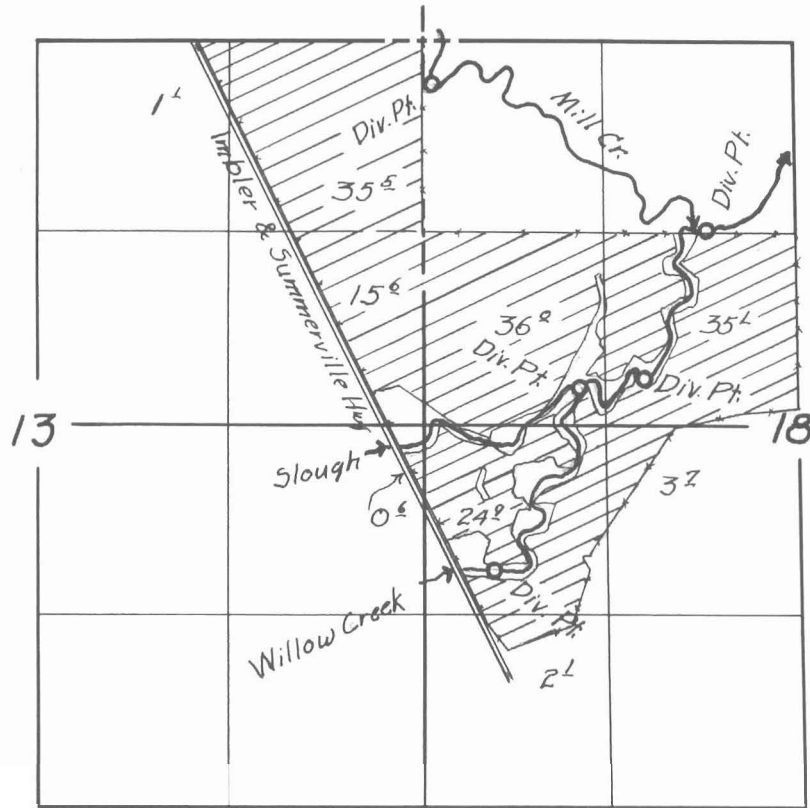

## FINAL PROOF SURVEY

UNDER

Application No. 23956 Permit No. 18909

IN NAME OF

KIETH GLENN

Surveyed 25 October 1955, by Robert H. Reed