

PERMIT # G-14026

Table 1. Location of Authorized and Proposed Point(s) of Diversion (POD) or Appropriation (POA)
(Note: If the POD/POA name is not specified in the permit, assign it a name or number here.)

POD/POA Name or Number	Is this POD/POA Authorized by the permit or is it Proposed?	If POA, OWRD Well Log ID# (or Well ID Tag # L-____)	Twp	Rng	Sec	¼ ¼	Tax Lot, DLC or Gov't Lot	Measured Distances (from a recognized survey corner)
#1	☐ Authorized ☒ Proposed	HARN 1668	33 S	31 E	9	NE NE	1100	1320' South & 1200' West from the NE cor, Sec 9
#2	☐ Authorized ☒ Proposed	HARN 1677-51860	33 S	31 E	3	SE NW	1100	60' North & 1340' West from the W ¼ cor, Sec 3
#3	☐ Authorized ☒ Proposed	HARN 50623	33 S	31 E	4	NW SE	1100	1225' South & 1412' West from the E ¼ cor, Sec 4
#4	☒ Authorized ☐ Proposed	HARN 50481	33 S	31 E	4	SE NE	1100	60' North & 1320' West from the E ¼ cor, Sec 4
#5	☒ Authorized ☐ Proposed	HARN 1844	33 S	31 E	10	NE NW	1100	1300' South & 1330' East from the NW cor, Sec 10
#6	☒ Authorized ☐ Proposed	HARN 1843	33 S	31 E	10	SE SW	1100	1320' North & 1330' East from SW cor, Sec 10
#8	☐ Authorized ☒ Proposed	HARN 51939	33 S	31 E	3	SW NW	1100	735' North & 30' East from W ¼ cor, Sec 3
#9	☐ Authorized ☒ Proposed	HARN 900/910	33 S	31 E	8	SW NE	1100	2650' South & 1320' East from the N ¼ cor, Sec 8
#11	☐ Authorized ☒ Proposed	HARN 51959	33 S	31 E	9	SW NW	1100	2730' North & 800' East from the SW cor, Sec 9
#12	☐ Authorized ☒ Proposed	HARN 51938	33 S	31 E	10	NW NW	1100	0' South & 860' East from the NW cor, Sec 10

Check all type(s) of change(s) proposed below (change "CODES" are provided in parentheses):

- | | |
|---|--|
| ☐ Place of Use (POU) | ☐ Point of Appropriation/Well (POA) |
| ☐ Point of Diversion (POD) | ☒ Additional Point of Appropriation (APOA) |
| ☐ Additional Point of Diversion (APOD) | ☐ Surface water POD to Ground Water POA (SW/GW) |

Will all of the proposed changes affect the entire water use permit?

- ☒ Yes Complete only the proposed ("to" lands) section of Table 2 on the next page. Use the "CODES" listed above to describe the proposed changes.
- ☐ No Complete all of Table 2 to describe the portion of the permit to be changed.

PERMIT AMENDMENT MAP


FOR GROUND WATER PERMIT

APPLICATION G-15165

WHITBY BROTHERS FARMS


TOWNSHIP 33 SOUTH, RANGE 31 EAST, SECTIONS 3, 4, 8, 9, & 10, W.M.

TAX LOT: 1100

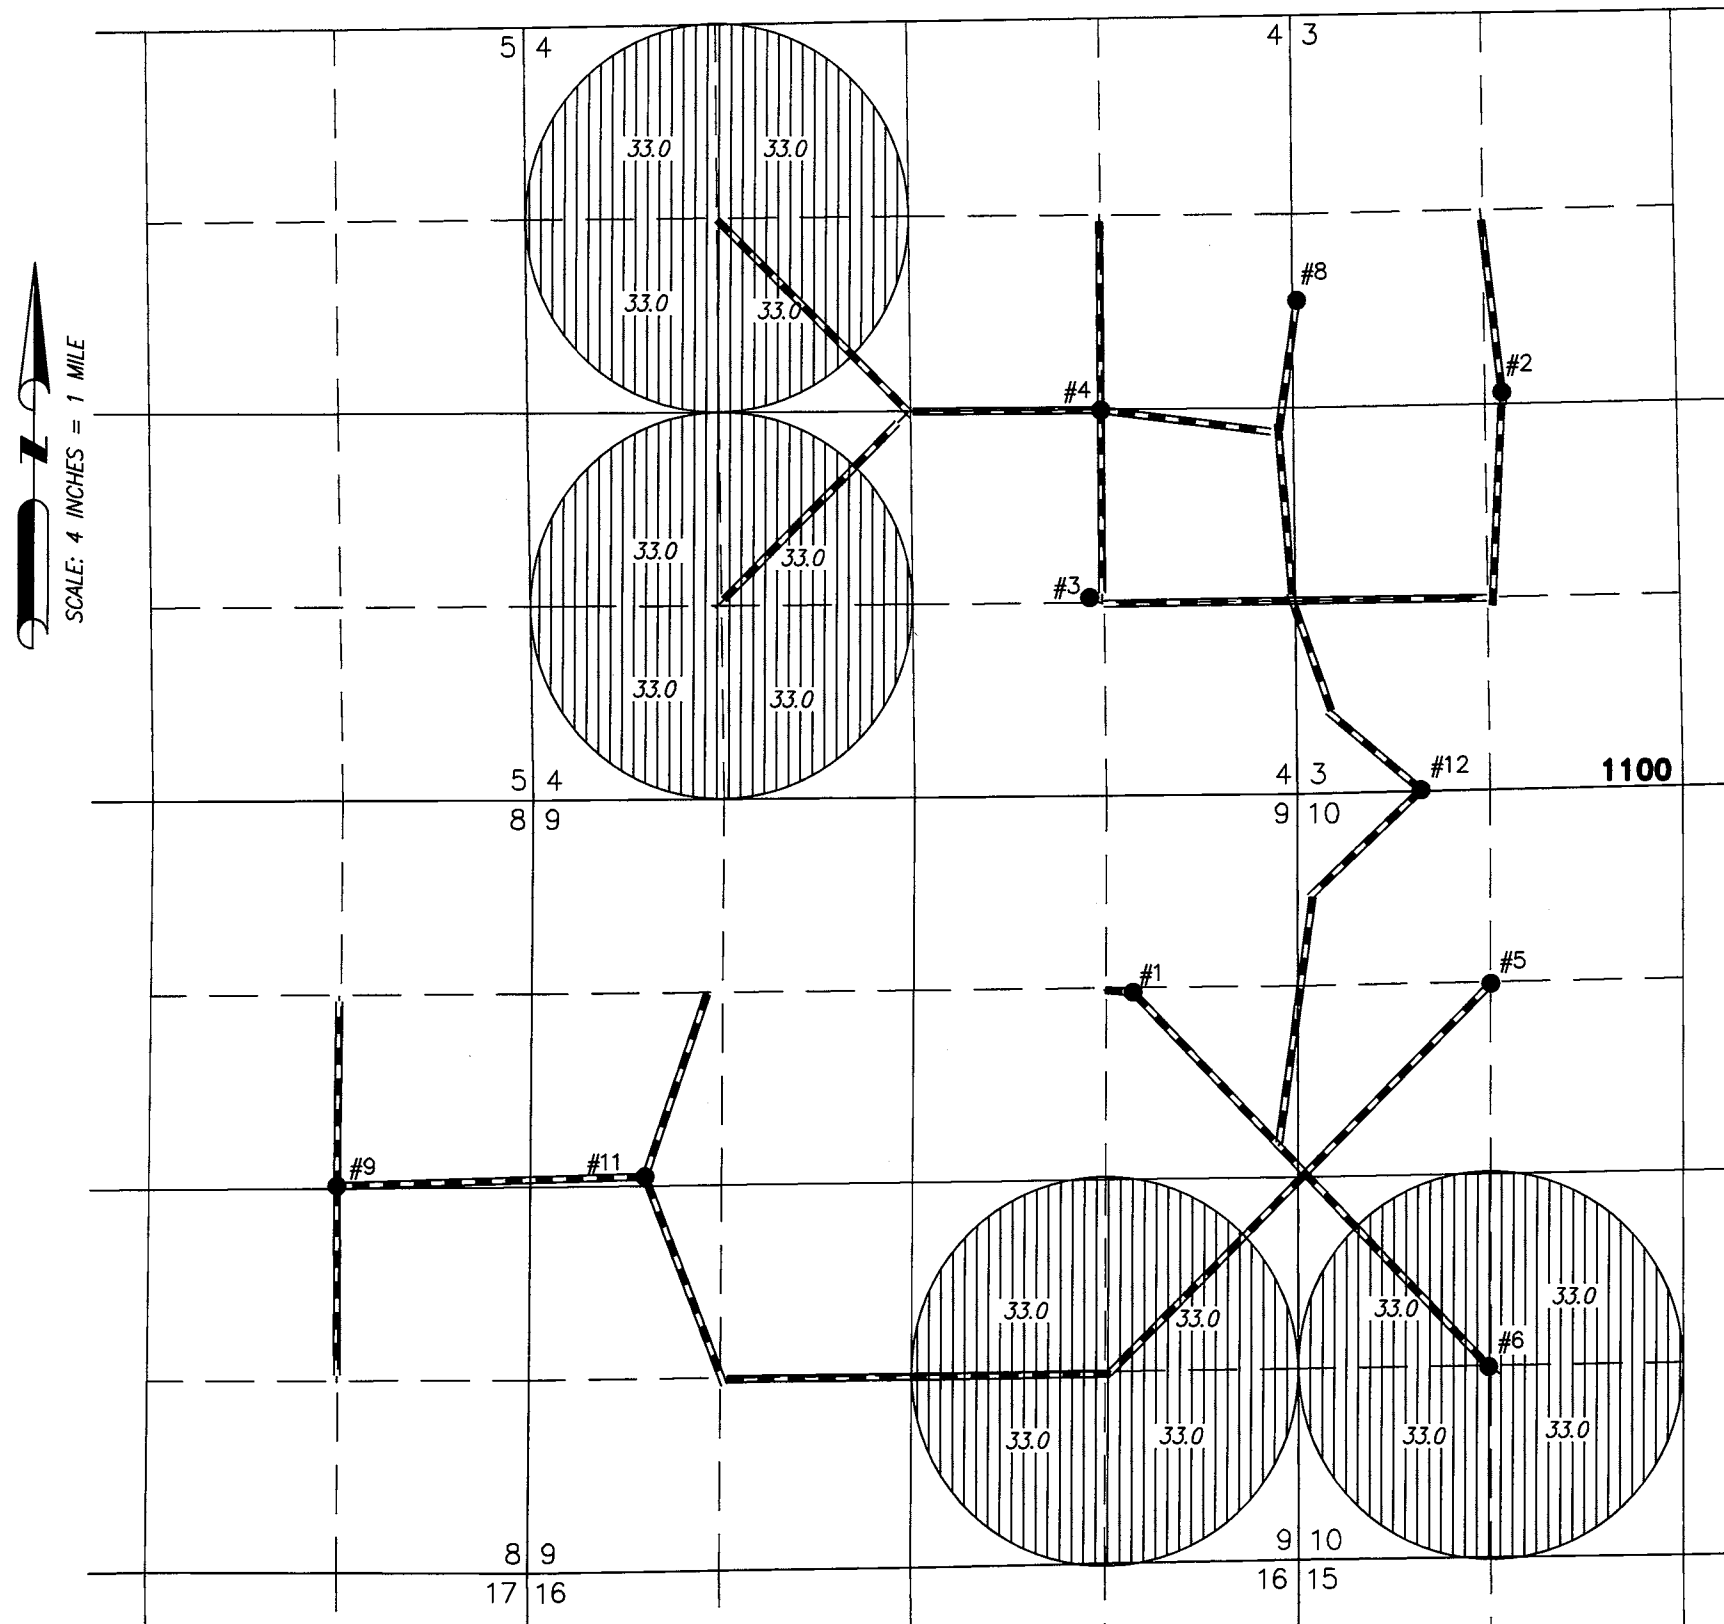

- POA 1 (HARN 1668)
EXISTING WELL PROPOSED FOR G-14026 LOCATED IN THE NE 1/4 OF THE NE 1/4 OF SECTION 9 & 1320 FEET SOUTH & 1200 FEET WEST FROM THE NE CORNER.
- POA 2 (HARN 1677-51860)
EXISTING WELL PROPOSED FOR G-14026 IN THE SE 1/4 OF THE NW 1/4 OF SECTION 3 & LOCATED 60 FEET NORTH & 1340 FEET WEST FROM THE W 1/4 CORNER.
- POA 3 (HARN 50623)
EXISTING WELL PROPOSED FOR G-14026 LOCATED IN THE NW 1/4 OF THE SE 1/4 OF SECTION 4 & 1225 FEET SOUTH AND 1412 FEET WEST FROM THE E 1/4 CORNER.
- POA 4 (HARN 50481)
EXISTING WELL AUTHORIZED BY G-14026 IN THE SE 1/4 OF THE NE 1/4 OF SECTION 4 & LOCATED 60 FEET NORTH & 1320 FEET WEST FROM THE E 1/4 CORNER.
- POA 5 (HARN 1844)
EXISTING WELL AUTHORIZED BY G-14026 LOCATED IN THE NE 1/4 OF THE NW 1/4 OF SECTION 10 & 1300 FEET SOUTH AND 1330 FEET EAST FROM THE NW CORNER.
- POA 6 (HARN 1843)
EXISTING WELL AUTHORIZED BY G-14026 IN THE SE 1/4 OF THE SW 1/4 OF SECTION 10 & LOCATED 1320 FEET NORTH & 1330 FEET EAST FROM THE SW CORNER.
- POA 8 (HARN 51939)
EXISTING WELL PROPOSED FOR G-14026 LOCATED IN THE SW 1/4 OF THE NW 1/4 OF SECTION 3 & 735 FEET NORTH & 30 FEET EAST FROM THE W 1/4 CORNER.
- POA 9 (HARN 900/910)
EXISTING WELL PROPOSED FOR G-14026 LOCATED IN THE SW 1/4 OF THE NE 1/4 OF SECTION 8 & 2650 FEET SOUTH & 1320 FEET EAST FROM THE N 1/4 CORNER.
- POA 11 (HARN 51959)
EXISTING WELL PROPOSED FOR G-14026 IN THE SW 1/4 OF THE NW 1/4 OF SECTION 9 & LOCATED 2730 FEET NORTH & 800 FEET EAST FROM THE SW CORNER.
- POA 12 (HARN 51938)
EXISTING WELL PROPOSED FOR G-14026 LOCATED IN THE NW 1/4 OF THE NW 1/4 OF SECTION 10 & 0 FEET SOUTH AND 860 FEET EAST FROM THE NW CORNER.

--- BURIED PIPE

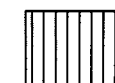

528.0 ACRES PRIMARY IRRIGATION FROM
PERMIT G14026, AS SHOWN

THIS MAP IS FOR THE PURPOSE OF DESIGNING AN
IRRIGATION SYSTEM PLAN AND HAS NO INTENT TO PROVIDE
LEGAL DIMENSIONS OR THE LOCATION OF PROPERTY LINES

ALL POINTS ENGINEERING
& SURVEYING, INC.




P.O. BOX 767
TERREBONNE, OREGON 97760
(541) 548-5833 PH
Scott@APEandS.com
www.APEandS.com

PROJECT No. 15-079

PREPARED AT THE REQUEST OF:

JEB WHITBY
62 W JUNIPER RD
MESA, WA 99343

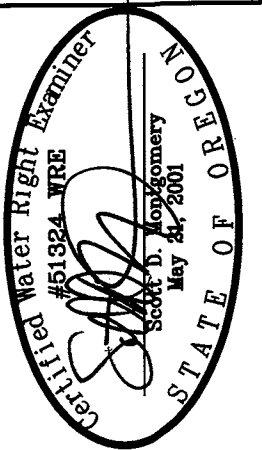

RENEWAL DATE: 12/31/2016