

TOWNSHIP 1 SOUTH
RANGE 9 WEST, W.M.




RECEIVED
APR 08 2016
By _____

NOTE: MAP IS FOR SOLE PURPOSE
OF IDENTIFYING LOCATION OF WATER
RIGHT AND HAS NO INTENT TO DIMENSION
OR LOCATE ANY PROPERTY OWNERSHIP LINES

WATER USE AREA- 


APPLICATION G-1220
PERMIT G-1115
CERTIFICATE 30205


SCALE: 1" = 2640' 0"

EXISTING WELL #1 IS 2,119'-3" NORTH AND 2,712'-6" WEST
OF THE SE CORNER OF T1S, R9W, SECTION 29.

EXISTING WELL #2 (TO BE ABANDONED) IS 1,892'-8" NORTH AND
2,570'-2" WEST OF THE SE CORNER OF T1S, R9W, SECTION 29.

PROPOSED WELL #2 IS 1,684'-3" NORTH AND 240'-6" WEST
OF THE SE CORNER OF T1S, R9W, SECTION 29.

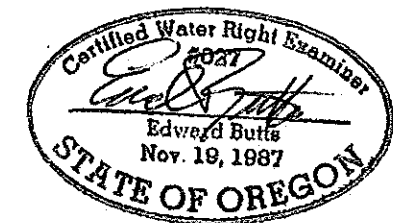

FAIRVIEW WATER DISTRICT
WATER RIGHTS MAP
APRIL 8, 2016